

REHAB. DROP INLETS, CATCH BASINS, OR MANHOLES, CLASS I OR CLASS II

STA. 82+20 LT ✓
 STA. 83+14 RT ✓
 STA. 84+75 RT ✓
 STA. 84+83 LT ✓
 STA. 86+08 RT ✓
 STA. 86+11 LT ✓
 STA. 84+45 RT ✓

CHANGING ELEVATION OF SEWER MANHOLES

STA. 82+12 RT ✓
 STA. 83+14 RT ✓
 STA. 83+23 LT ✓
 STA. 84+83 CL ✓
 STA. 86+29 LT ✓

CHANGING ELEVATION OF DROP INLETS, CATCH BASINS, OR MANHOLES

STA. 86+37 LT "DMH"

ADJUST ELEVATION OF VALVE BOX

STA. 82+11 RT "WSV"
 STA. 85+18 RT "WSV"

COMMON EXCAVATION

STA. 84+29 - STA. 84+35 RT
 STA. 84+30 - STA. 84+35 LT
 STA. 86+08 - STA. 86+14 LT
 STA. 86+09 - STA. 86+15 RT

PORTLAND CEMENT CONCRETE SIDEWALK, 5 INCH

STA. 84+29 - STA. 84+35 RT ✓
 STA. 84+30 - STA. 84+35 LT ✓
 STA. 86+08 - STA. 86+14 LT ✓
 STA. 86+09 - STA. 86+15 RT ✓
 STA. 83+50 - STA. 83+58 RT
 STA. 83+25 - STA. 83+30 RT

SUBBASE OF CRUSHED GRAVEL, FINE GRADED

STA. 84+29 - STA. 84+35 RT
 STA. 84+30 - STA. 84+35 LT
 STA. 86+08 - STA. 86+14 LT
 STA. 86+09 - STA. 86+15 RT

REMOVE AND RESET CURB

STA. 84+19 - STA. 84+45 RT
 STA. 84+19 - STA. 84+44 LT
 STA. 85+98 - STA. 86+13 LT
 STA. 85+99 - STA. 86+25 RT

DETECTABLE WARNING SURFACES

STA. 84+32 LT (8 SF) ✓
 STA. 84+32 RT (8 SF) ✓
 STA. 86+10 LT (8 SF) ✓
 STA. 86+12 RT (8 SF) ✓
 STA. 83+55 RT (8 SF)
 STA. 83+30 RT (8 SF)

DURABLE 4 INCH WHITE LINE, TYPE I TAPE

STA. 81+75 - STA. 87+25 (SOLID LT & RT)
 (WITH EDGELINE BREAKS AT SIDEROADS)

DURABLE 4 INCH YELLOW LINE, TYPE I TAPE

STA. 81+75 - STA. 87+25 (SOLID LT & RT)
 (WITH CENTERLINE BREAKS AT SIDEROADS)

TEMPORARY 4 INCH WHITE LINE, PAINT

STA. 81+75 - STA. 87+25 (SOLID LT & RT)
 (WITH EDGELINE BREAKS AT SIDEROADS)

TEMPORARY 4 INCH YELLOW LINE, PAINT

STA. 81+75 - STA. 87+25 (SOLID LT & RT)
 (WITH CENTERLINE BREAKS AT SIDEROADS)

DURABLE 8 INCH WHITE LINE, TYPE I TAPE

STA. 84+07 - STA. 84+27 (HATCH LT & RT)
 STA. 84+37 - STA. 84+57 (HATCH LT & RT)

TEMPORARY 8 INCH WHITE LINE, PAINT

STA. 84+07 - STA. 84+27 (HATCH LT & RT)
 STA. 84+37 - STA. 84+57 (HATCH LT & RT)


900.640 SPECIAL PROVISION (DURABLE CROSSWALK MARKING, IMPRINTED/COLORIZED)

STA. 84+32 LT & RT
 STA. 86+13 LT & RT

TEMPORARY CROSSWALK MARKING, PAINT

STA. 84+32 LT & RT
 STA. 86+13 LT & RT

REMOVING SIGNS
 AS SHOWN - 5

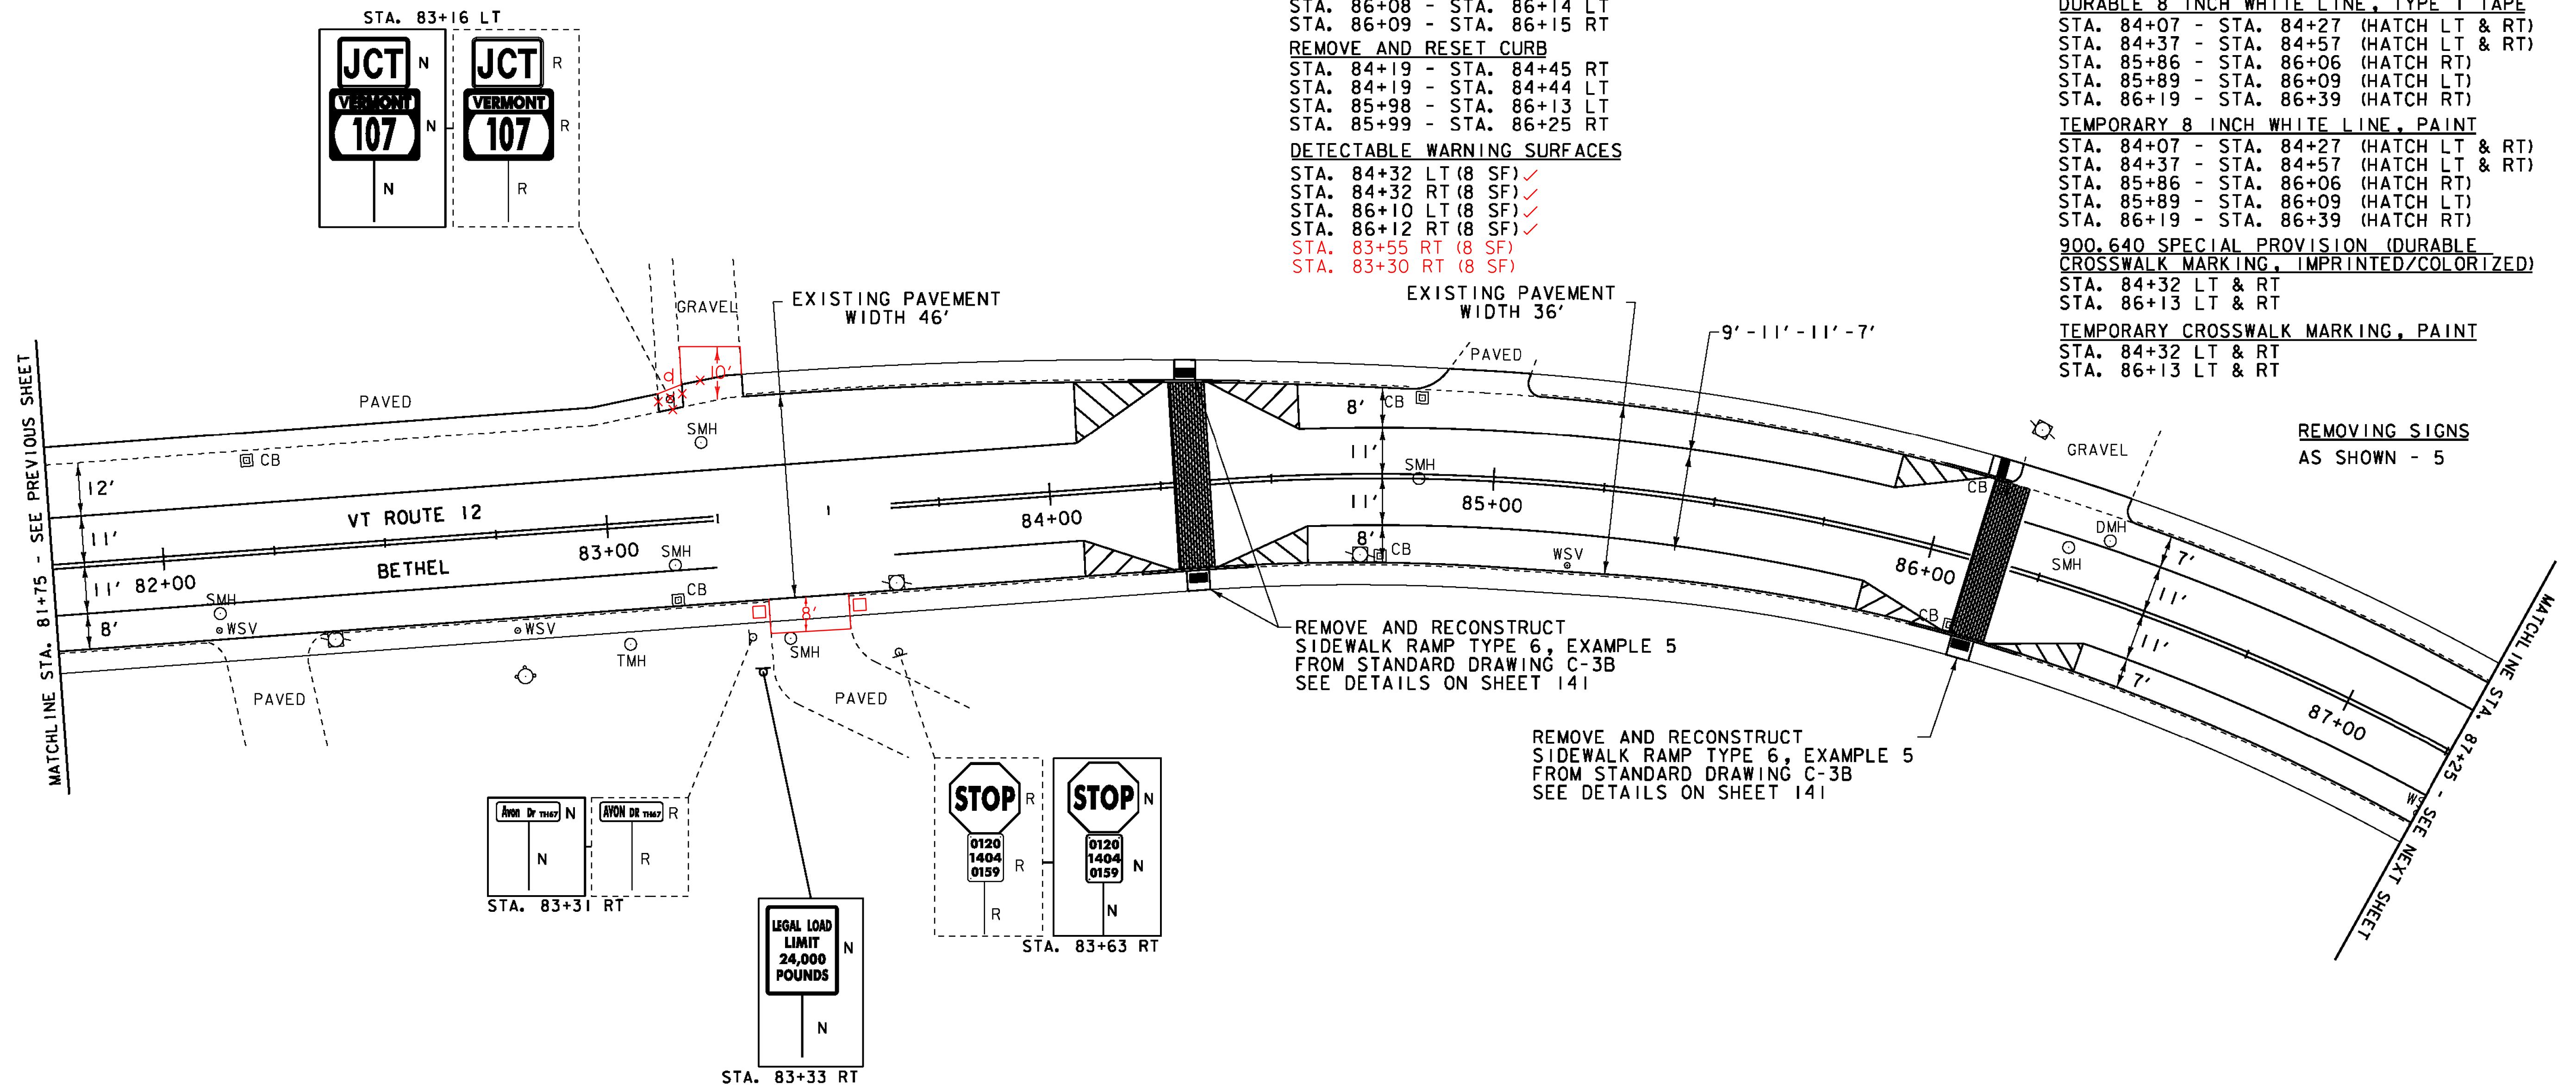

- LEGEND**
- SIGN
 - HYDRANT
 - MANHOLE
 - VALVE
 - GAS PIPELINE MARKER
 - CATCH BASIN / DROP INLET
 - CURB INLET
 - ☒ TRAFFIC CONTROL BOX
 - ⊙ PARKING METER
 - ⊙ UTILITY POLE
 - DETECTABLE WARNINGS
 - LIGHT POLE
 - ▨ EX. DETECTABLE WARNINGS
 - JUNCTION BOX
 - ⊙ PED BUTTON
 - ⊙ ELECTRICAL BOX
 - ⊙ SIGNAL
 - ⊙ PEDESTAL POST
 - ⊙ STRAIN POLE
 - CAMERA
 - VDZ VIDEO DETECTION ZONE

- SIGN LEGEND**
- R = REMOVE
 - R&S = REMOVE AND SALVAGE
 - RET = RETAIN
 - S = SALVAGE
 - N = NEW
 - B-B = BACK TO BACK

PROJECT LAYOUT SHEET 2	PROJECT NAME: BETHEL-NORTHFIELD	PLOT DATE: 1/3/13
	PROJECT NUMBER: STP 2922(I)	DRAWN BY: JBG
	FILE NAME: piOC246.dgn	CHECKED BY: CDL
	DESIGNED BY: SJL	SHEET 21 OF 149
	PLOT FILE: piOC246_21.i	

NOT TO SCALE