

REHAB. DROP INLETS, CATCH BASINS, OR MANHOLES, CLASS I OR CLASS II  
 STA. 91+10 RT ✓  
 STA. 93+55 RT ✓

CHANGING ELEVATION OF SEWER MANHOLES  
 STA. 91+66 LT ✓  
 STA. 95+05 RT ✓

DURABLE 4 INCH WHITE LINE, TYPE I TAPE  
 STA. 90+75 - STA. 96+25 (SOLID LT & RT)  
 (WITH BREAKS AT SIDEROADS & CROSSWALKS)  
 STA. 90+84 RT (EDGELINES TH #358)

DURABLE 4 INCH YELLOW LINE, TYPE I TAPE  
 STA. 90+75 - STA. 96+25 (SOLID LT & RT)  
 (WITH BREAKS AT SIDEROADS & CROSSWALKS)  
 STA. 90+84 RT (CENTERLINE TH #358)

DURABLE 24 INCH STOP BAR, TYPE I TAPE  
 STA. 90+84 - STA. 90+98 RT

DURABLE LETTER OR SYMBOL, TYPE I TAPE  
 STA. 90+89 RT "STOP"

DURABLE CROSSWALK MARKING, TYPE I TAPE  
 STA. 90+75 - STA. 90+86 LT & RT  
 STA. 90+75 - STA. 91+01 RT


TEMPORARY 4 INCH WHITE LINE, PAINT  
 STA. 90+75 - STA. 96+25 (SOLID LT & RT)  
 (WITH BREAKS AT SIDEROADS & CROSSWALKS)  
 STA. 90+84 RT (EDGELINES TH #358)

TEMPORARY 4 INCH YELLOW LINE, PAINT  
 STA. 90+75 - STA. 96+25 (SOLID LT & RT)  
 (WITH BREAKS AT SIDEROADS & CROSSWALKS)  
 STA. 90+84 RT (CENTERLINE TH #358)

TEMPORARY 24 INCH STOP BAR, PAINT  
 STA. 90+84 - STA. 90+98 RT

TEMPORARY LETTER OR SYMBOL, PAINT  
 STA. 90+89 RT "STOP"

TEMPORARY CROSSWALK MARKING, PAINT  
 STA. 90+75 - STA. 90+86 LT & RT  
 STA. 90+75 - STA. 91+01 RT

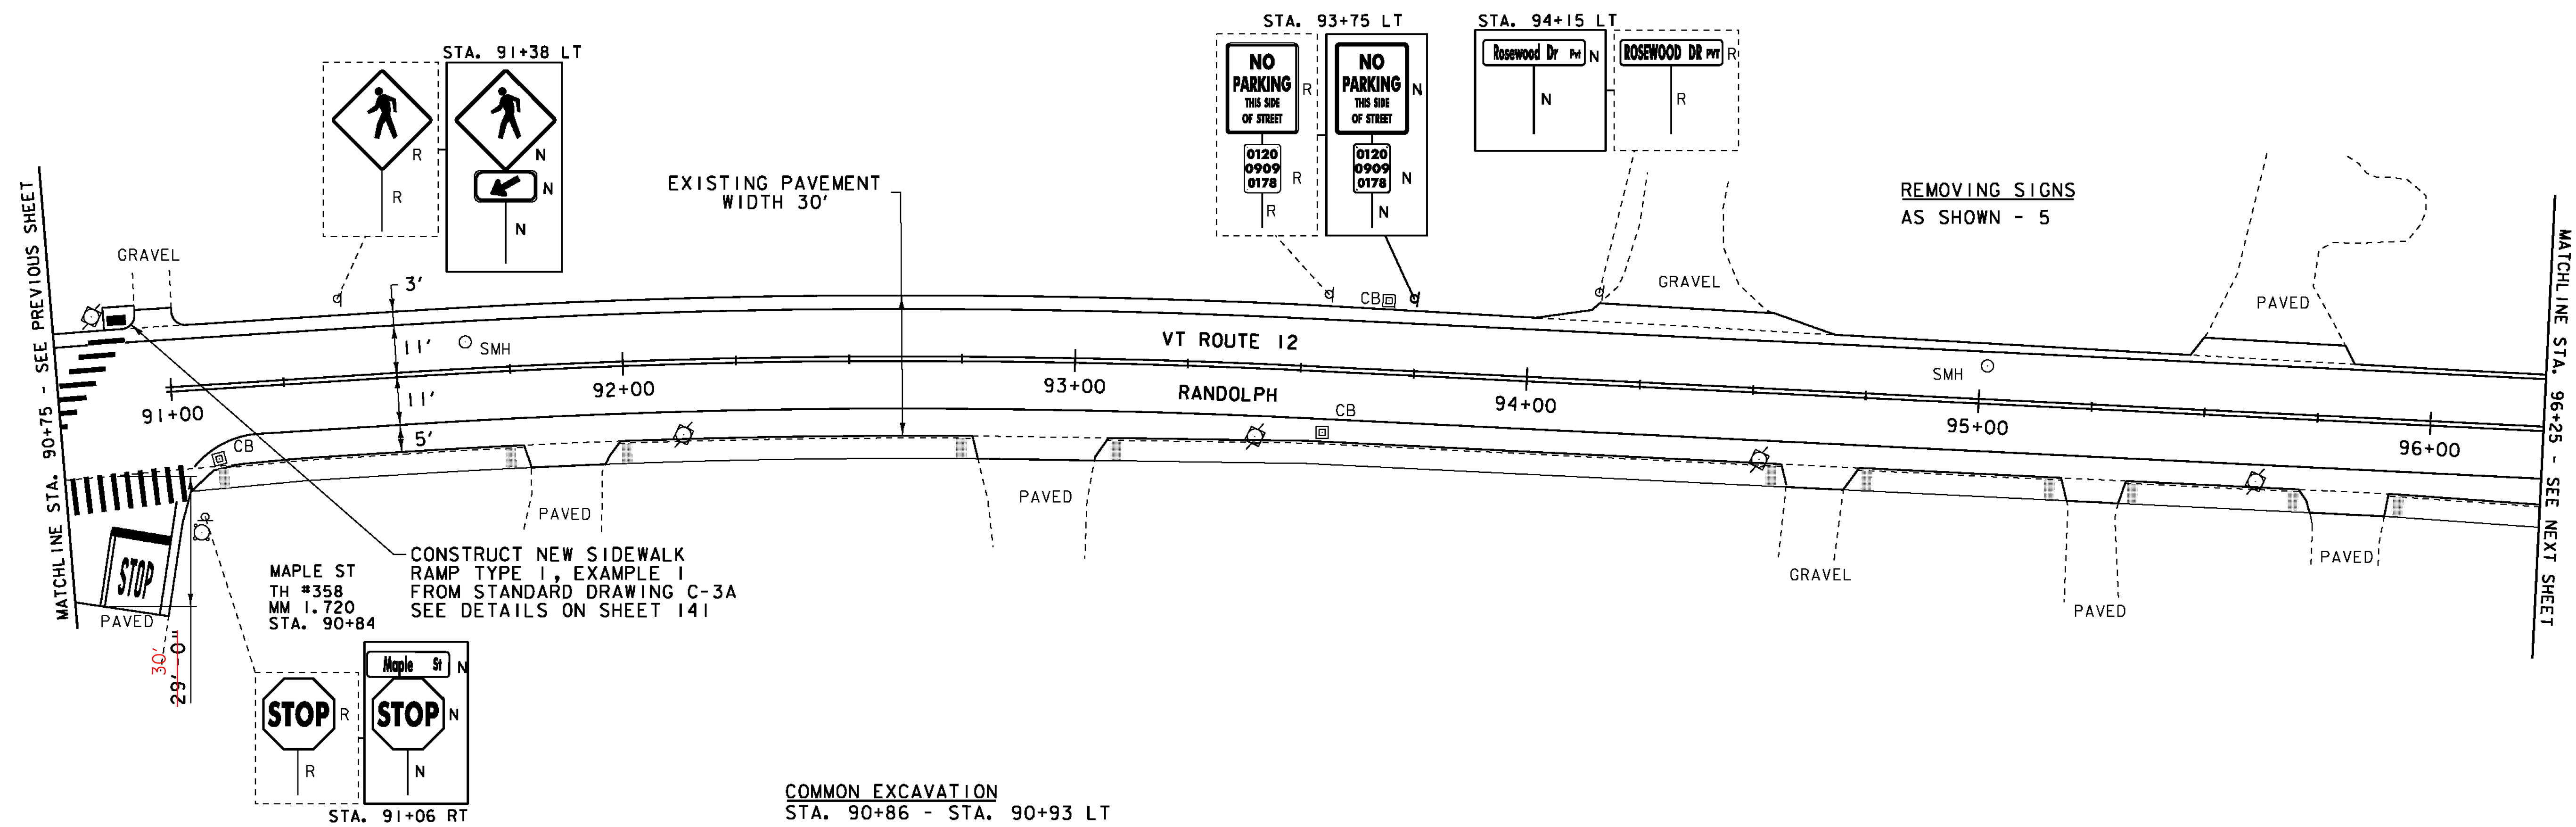

- LEGEND**
- SIGN
  - HYDRANT
  - MANHOLE
  - VALVE
  - GAS PIPELINE MARKER
  - CATCH BASIN / DROP INLET
  - CURB INLET
  - TRAFFIC CONTROL BOX
  - PARKING METER
  - UTILITY POLE
  - LIGHT POLE
  - EX. DETECTABLE WARNINGS
  - JUNCTION BOX
  - PED BUTTON
  - ELECTRICAL BOX
  - SIGNAL
  - PEDESTAL POST
  - DETECTABLE WARNINGS

**SIGN LEGEND**

R = REMOVE  
 R&S = REMOVE AND SALVAGE  
 RET = RETAIN  
 S = SALVAGE  
 N = NEW  
 B-B = BACK TO BACK

COMMON EXCAVATION  
 STA. 90+86 - STA. 90+93 LT

PORTLAND CEMENT CONCRETE SIDEWALK, 5 INCH  
 STA. 90+86 - STA. 90+93 LT

SUBBASE OF CRUSHED GRAVEL, FINE GRADED  
 STA. 90+86 - STA. 90+93 LT

CAST-IN-PLACE CONCRETE CURB, TYPE B  
 STA. 90+86 - STA. 90+93 LT

DETECTABLE WARNING SURFACES  
 STA. 90+89 LT

NOT TO SCALE

**PROJECT LAYOUT SHEET 13**

PROJECT NAME: BETHEL-NORTHFIELD  
 PROJECT NUMBER: STP 2922(I)

FILE NAME: piOC246.dgn  
 PROJECT LEADER: CDL  
 DESIGNED BY: SJL  
 PLOT FILE: piOC246\_32.i

PLOT DATE: 1/3/13  
 DRAWN BY: JBG  
 CHECKED BY: CDL  
 SHEET 32 OF 149