

NOT DONE PER R.E.

REHAB. DROP INLETS, CATCH BASINS, OR MANHOLES, CLASS I OR CLASS II

- STA. 108+16 LT ✓
- STA. 108+28 RT ✓
- STA. 108+84 LT ✓
- STA. 109+12 RT ✓
- STA. 110+28 LT ✓
- STA. 110+54 RT ✓
- STA. 111+32 RT ✓
- STA. 112+23 LT ✓
- STA. 110+80 RT ✓

ADJUST ELEVATION OF VALVE BOX

- STA. 109+76 RT "WSV"
- STA. 109+85 LT "WSV"
- STA. 110+35 LT "WSV"
- STA. 110+35 LT "MONITOR WELL"
- STA. 110+42 LT "WSV"
- STA. 110+75 RT "WSV"

CHANGING ELEVATION OF SEWER MANHOLES

- STA. 111+60 RT
- STA. 111+86 LT

CHANGING ELEVATION OF DROP INLETS, CATCH BASINS, OR MANHOLES

- STA. 111+36 RT "DMH"

COMMON EXCAVATION

- STA. 108+85 - STA. 108+90 LT
- STA. 109+20 - STA. 109+27 LT
- STA. 109+43 - STA. 109+49 RT
- STA. 109+43 - STA. 109+51 LT
- STA. 109+58 - STA. 109+64 RT
- STA. 109+66 - STA. 109+70 RT
- STA. 109+74 - STA. 109+79 LT
- STA. 109+81 - STA. 109+85 RT
- STA. 110+34 - STA. 110+43 LT
- STA. 110+37 - STA. 110+47 RT
- STA. 110+49 - STA. 110+55 RT
- STA. 110+88 - STA. 110+97 RT
- STA. 111+03 - STA. 111+11 LT
- STA. 111+12 - STA. 111+21 RT

SUBBASE OF CRUSHED GRAVEL, FINE GRADED

- STA. 108+85 - STA. 108+90 LT
- STA. 109+20 - STA. 109+27 LT
- STA. 109+43 - STA. 109+49 RT
- STA. 109+43 - STA. 109+51 LT
- STA. 109+58 - STA. 109+64 RT
- STA. 109+66 - STA. 109+70 RT
- STA. 109+74 - STA. 109+79 LT
- STA. 109+81 - STA. 109+85 RT
- STA. 110+34 - STA. 110+43 LT
- STA. 110+37 - STA. 110+47 RT
- STA. 110+49 - STA. 110+55 RT
- STA. 110+88 - STA. 110+97 RT
- STA. 111+03 - STA. 111+11 LT
- STA. 111+12 - STA. 111+21 RT

PORTLAND CEMENT CONCRETE SIDEWALK, 5 INCH

- STA. 108+85 - STA. 108+90 LT ✓
- STA. 109+20 - STA. 109+27 LT ✓
- STA. 109+43 - STA. 109+49 RT ✓
- STA. 109+43 - STA. 109+51 LT ✓
- STA. 109+58 - STA. 109+64 RT ✓
- STA. 109+66 - STA. 109+70 RT ✓
- STA. 109+74 - STA. 109+79 LT ✓
- STA. 109+81 - STA. 109+85 RT ✓
- STA. 110+34 - STA. 110+43 LT ✓
- STA. 110+37 - STA. 110+47 RT ✓
- STA. 110+49 - STA. 110+55 RT ✓
- STA. 110+88 - STA. 110+97 RT ✓
- STA. 111+03 - STA. 111+11 LT ✓
- STA. 111+12 - STA. 111+21 RT ✓

REMOVING AND RESETTING CURB

- STA. 108+87 - STA. 108+90 LT
- STA. 109+20 - STA. 109+30 LT
- STA. 109+34 - STA. 109+49 RT
- STA. 109+37 - STA. 109+51 LT
- STA. 109+58 - STA. 109+69 RT
- STA. 109+63 - STA. 109+84 LT
- STA. 109+69 - STA. 109+71 RT
- STA. 109+80 - STA. 109+92 RT
- STA. 110+27 - STA. 110+56 RT
- STA. 110+27 - STA. 110+46 LT
- STA. 110+84 - STA. 111+02 RT
- STA. 111+00 - STA. 111+13 LT
- STA. 111+07 - STA. 111+27 RT

DETECTABLE WARNING SURFACES

- STA. 108+87 LT (8 SF) ✓
- STA. 109+24 LT (8 SF) ✓
- STA. 109+45 RT (8 SF) ✓
- STA. 109+46 LT (8 SF) ✓
- STA. 109+62 RT (8 SF) ✓
- STA. 109+68 RT (8 SF) ✓
- STA. 109+77 LT (8 SF) ✓
- STA. 109+82 RT (8 SF) ✓
- STA. 110+39 LT (8 SF) ✓
- STA. 110+41 RT (8 SF) ✓
- STA. 110+52 RT (8 SF) ✓
- STA. 110+92 RT (10 SF) ✓
- STA. 111+06 LT (8 SF) ✓
- STA. 111+18 LT (8 SF) ✓

DURABLE 4 INCH WHITE LINE, TYPE I TAPE

- STA. 107+25 - STA. 112+75 (SOLID LT & RT)
- (WITH BREAKS AT SIDEROADS, RR TRACKS & CROSSWALKS)
- STA. 107+25 - STA. 108+60 (PARKING LT)
- STA. 109+83 - STA. 110+25 (PARKING RT)
- STA. 110+60 LT (LANE LINES)
- STA. 110+32 - STA. 110+58 (PARKING LT)
- STA. 111+13 - STA. 112+75 (PARKING RT)
- STA. 111+43 - STA. 112+04 (PARKING LT)

TEMPORARY 4 INCH WHITE LINE, PAINT

- STA. 107+25 - STA. 112+75 (SOLID LT & RT)
- (WITH BREAKS AT SIDEROADS, RR TRACKS & CROSSWALKS)
- STA. 107+25 - STA. 108+60 (PARKING LT)
- STA. 109+83 - STA. 110+25 (PARKING RT)
- STA. 110+60 LT (LANE LINES)
- STA. 110+32 - STA. 110+58 (PARKING LT)
- STA. 111+13 - STA. 112+75 (PARKING RT)
- STA. 111+43 - STA. 112+04 (PARKING LT)

DURABLE 8 INCH WHITE LINE, TYPE I TAPE

- STA. 111+15 - STA. 111+40 (HATCH RT)
- STA. 111+35 - STA. 111+57 (HATCH RT)

TEMPORARY 8 INCH WHITE LINE, PAINT


- STA. 111+15 - STA. 111+40 (HATCH RT)
- STA. 111+35 - STA. 111+57 (HATCH RT)

DURABLE 4 INCH YELLOW LINE, TYPE I TAPE

- STA. 107+25 - STA. 112+75 (SOLID LT & RT)
- (WITH BREAKS AT SIDEROADS, RR TRACKS & CROSSWALKS)
- STA. 110+74 LT (CENTERLINE SIDEROAD)

TEMPORARY 4 INCH YELLOW LINE, PAINT

- STA. 107+25 - STA. 112+75 (SOLID LT & RT)
- (WITH BREAKS AT SIDEROADS, RR TRACKS & CROSSWALKS)
- STA. 110+74 LT (CENTERLINE SIDEROAD)

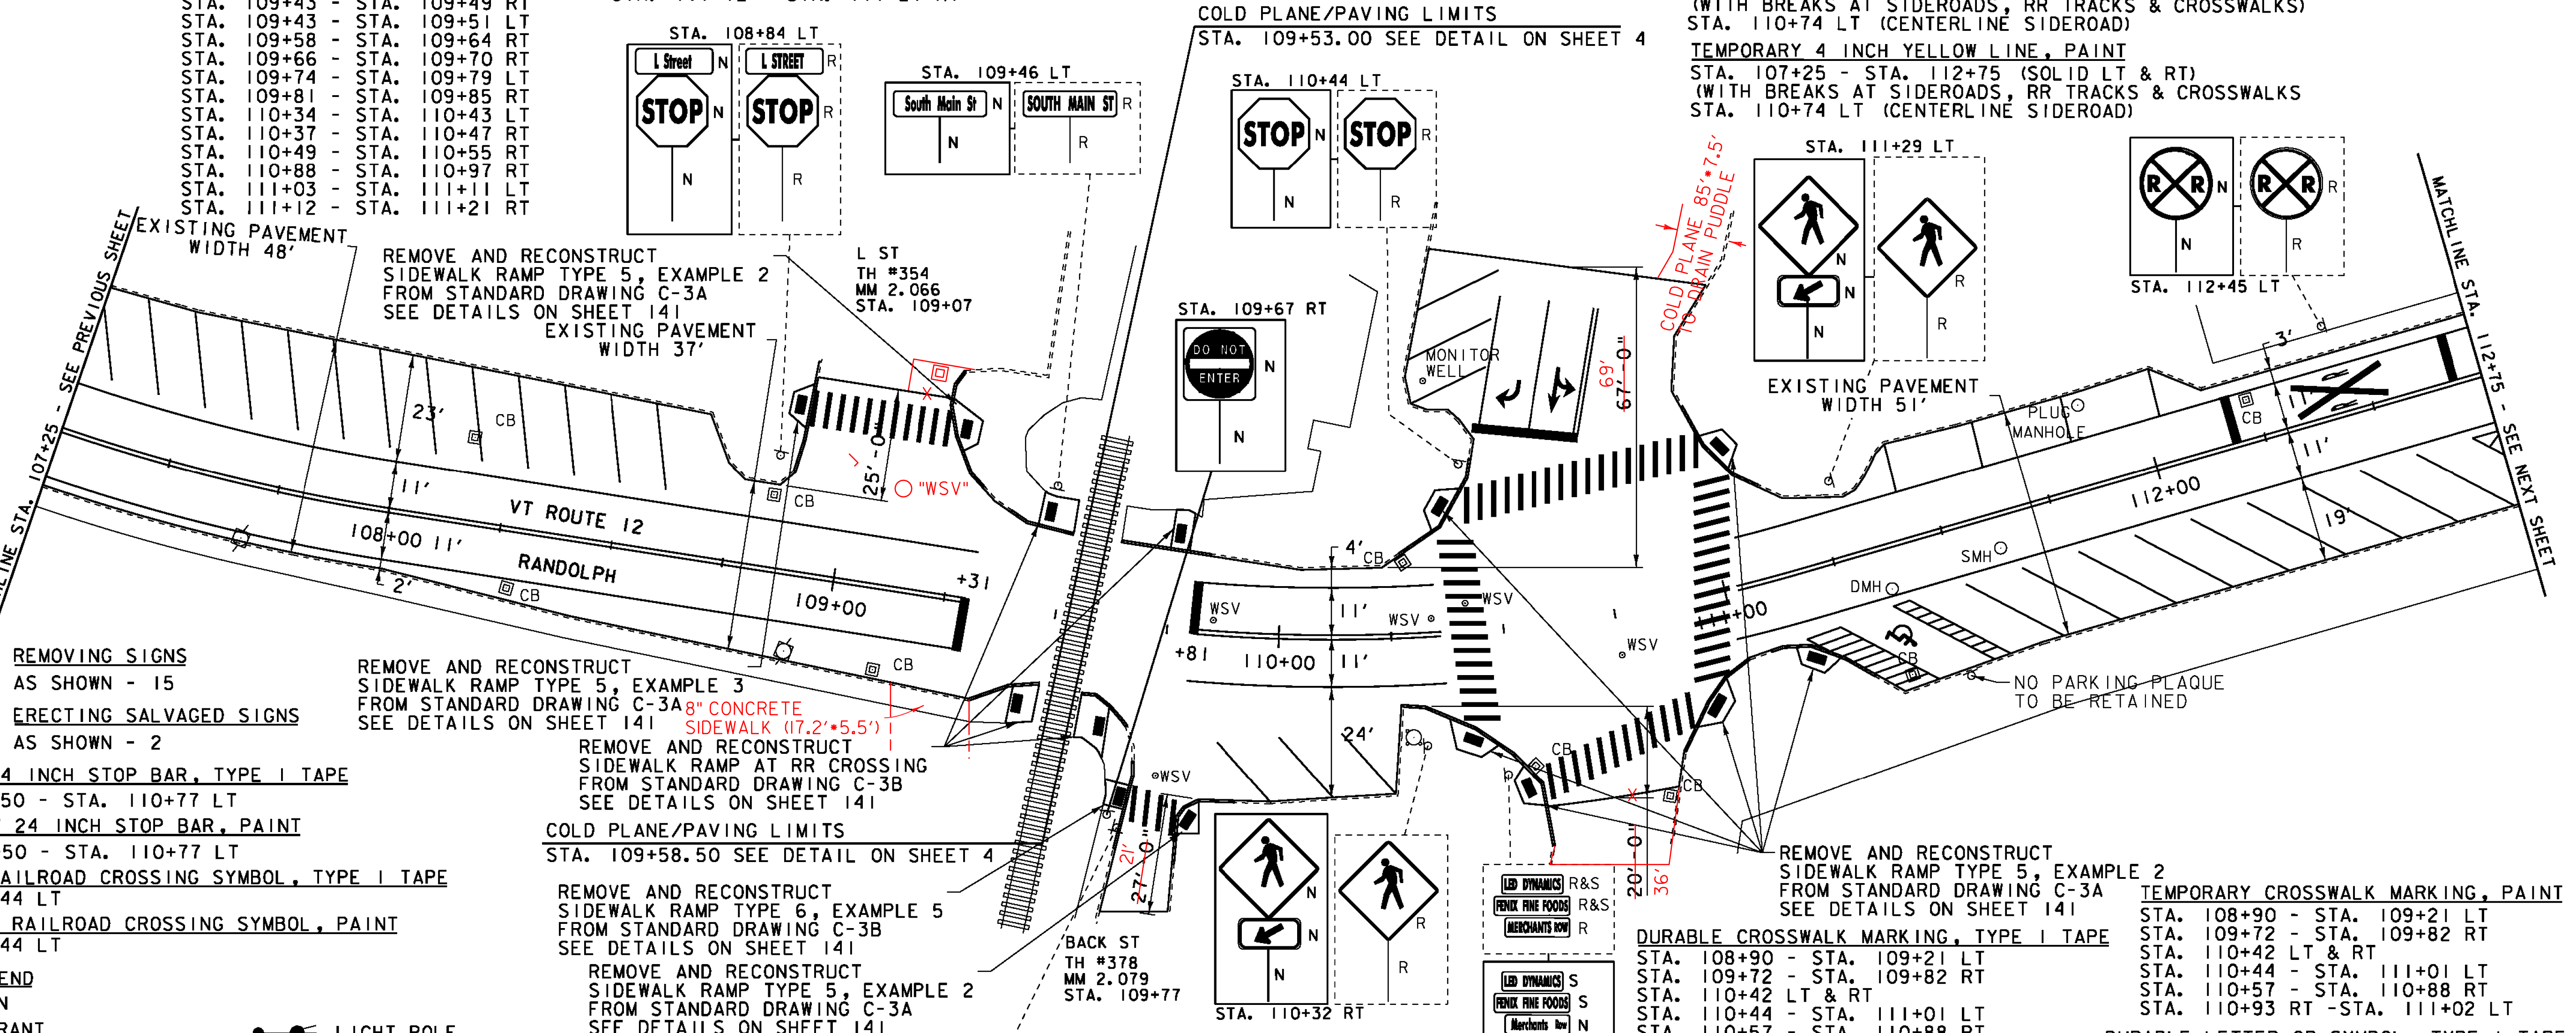

REMOVING SIGNS AS SHOWN - 15
ERECTING SALVAGED SIGNS AS SHOWN - 2

DURABLE 24 INCH STOP BAR, TYPE I TAPE
STA. 110+50 - STA. 110+77 LT
TEMPORARY 24 INCH STOP BAR, PAINT
STA. 110+50 - STA. 110+77 LT
DURABLE RAILROAD CROSSING SYMBOL, TYPE I TAPE
STA. 112+44 LT
TEMPORARY RAILROAD CROSSING SYMBOL, PAINT
STA. 112+44 LT

REMOVE AND RECONSTRUCT SIDEWALK RAMP TYPE 5, EXAMPLE 2 FROM STANDARD DRAWING C-3A SEE DETAILS ON SHEET 141
EXISTING PAVEMENT WIDTH 37'

REMOVE AND RECONSTRUCT SIDEWALK RAMP TYPE 5, EXAMPLE 3 FROM STANDARD DRAWING C-3A SEE DETAILS ON SHEET 141
8" CONCRETE SIDEWALK (17.2'x5.5')

REMOVE AND RECONSTRUCT SIDEWALK RAMP AT RR CROSSING FROM STANDARD DRAWING C-3B SEE DETAILS ON SHEET 141

COLD PLANE/PAVING LIMITS
STA. 109+58.50 SEE DETAIL ON SHEET 4

REMOVE AND RECONSTRUCT SIDEWALK RAMP TYPE 6, EXAMPLE 5 FROM STANDARD DRAWING C-3B SEE DETAILS ON SHEET 141


REMOVE AND RECONSTRUCT SIDEWALK RAMP TYPE 5, EXAMPLE 2 FROM STANDARD DRAWING C-3A SEE DETAILS ON SHEET 141

- LEGEND
- SIGN
 - HYDRANT
 - MANHOLE
 - VALVE
 - GAS PIPELINE MARKER
 - CATCH BASIN / DROP INLET
 - CURB INLET
 - ⊗ TRAFFIC CONTROL BOX
 - ⊗ PARKING METER
 - ⊗ UTILITY POLE
 - DETECTABLE WARNINGS

- LIGHT POLE
- EX. DETECTABLE WARNINGS
- JUNCTION BOX
- PED BUTTON
- ELECTRICAL BOX
- SIGNAL
- PEDESTAL POST
- STRAIN POLE
- CAMERA
- VIZ VIDEO DETECTION ZONE

SIGN LEGEND

- R = REMOVE
- R&S = REMOVE AND SALVAGE
- RET = RETAIN
- S = SALVAGE
- N = NEW
- B-B = BACK TO BACK

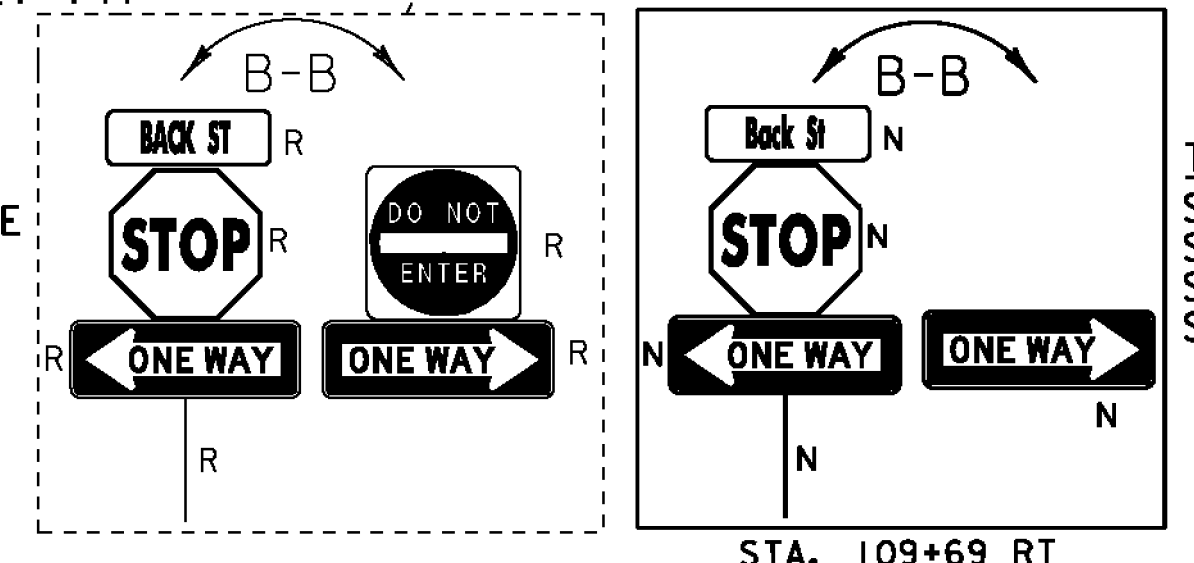

TEMPORARY LETTER OR SYMBOL, PAINT

- STA. 110+61 LT "ARROW"
- STA. 110+70 LT "ARROW"
- STA. 110+70 LT "ARROW"
- STA. 111+35 RT HANDICAP SYMBOL

REMOVE AND RECONSTRUCT SIDEWALK RAMP TYPE 5, EXAMPLE 2 FROM STANDARD DRAWING C-3A SEE DETAILS ON SHEET 141

DURABLE CROSSWALK MARKING, TYPE I TAPE

- STA. 108+90 - STA. 109+21 LT
- STA. 109+72 - STA. 109+82 RT
- STA. 110+42 LT & RT
- STA. 110+44 - STA. 111+01 LT
- STA. 110+57 - STA. 110+88 RT
- STA. 110+93 RT - STA. 111+02 LT

TEMPORARY CROSSWALK MARKING, PAINT

- STA. 108+90 - STA. 109+21 LT
- STA. 109+72 - STA. 109+82 RT
- STA. 110+42 LT & RT
- STA. 110+44 - STA. 111+01 LT
- STA. 110+57 - STA. 110+88 RT
- STA. 110+93 RT - STA. 111+02 LT

DURABLE LETTER OR SYMBOL, TYPE I TAPE

- STA. 110+61 LT "ARROW"
- STA. 110+70 LT "ARROW"
- STA. 110+70 LT "ARROW"
- STA. 111+35 RT HANDICAP SYMBOL

PROJECT LAYOUT SHEET 16

NOT TO SCALE

PROJECT NAME:	BETHEL-NORTHFIELD
PROJECT NUMBER:	STP 2922(I)
FILE NAME:	p10C246.dgn
PROJECT LEADER:	CDL
DESIGNED BY:	SJL
PLOT FILE:	p10C246_35.1
PLOT DATE:	1/3/13
DRAWN BY:	JBG
CHECKED BY:	CDL
SHEET	35 OF 149