

REHAB, DROP INLETS, CATCH  
BASINS, OR MANHOLES, CLASS I OR CLASS II  
STA. 142+80 LT ✓  
STA. 145+32 LT ✓

CHANGING ELEVATION OF SEWER MANHOLES  
STA. 143+49 RT ✓  
STA. 144+95 RT ✓

ADJUST ELEVATION OF VALVE BOX  
STA. 143+01 LT "WSV"

DURABLE 4 INCH WHITE LINE, TYPE I TAPE  
STA. 140+50 - STA. 146+25 (SOLID LT & RT)

DURABLE 4 INCH YELLOW LINE, TYPE I TAPE  
STA. 140+50 - STA. 146+25 (SOLID LT & RT)


DURABLE LETTER OR SYMBOL, TYPE I TAPE  
STA. 142+42 RT "SCHOOL"

TEMPORARY 4 INCH WHITE LINE, PAINT  
STA. 140+50 - STA. 146+25 (SOLID LT & RT)

TEMPORARY 4 INCH YELLOW LINE, PAINT  
STA. 140+50 - STA. 146+25 (SOLID LT & RT)

TEMPORARY LETTER OR SYMBOL, PAINT  
STA. 142+42 RT "SCHOOL"

REMOVING SIGNS  
AS SHOWN - 1

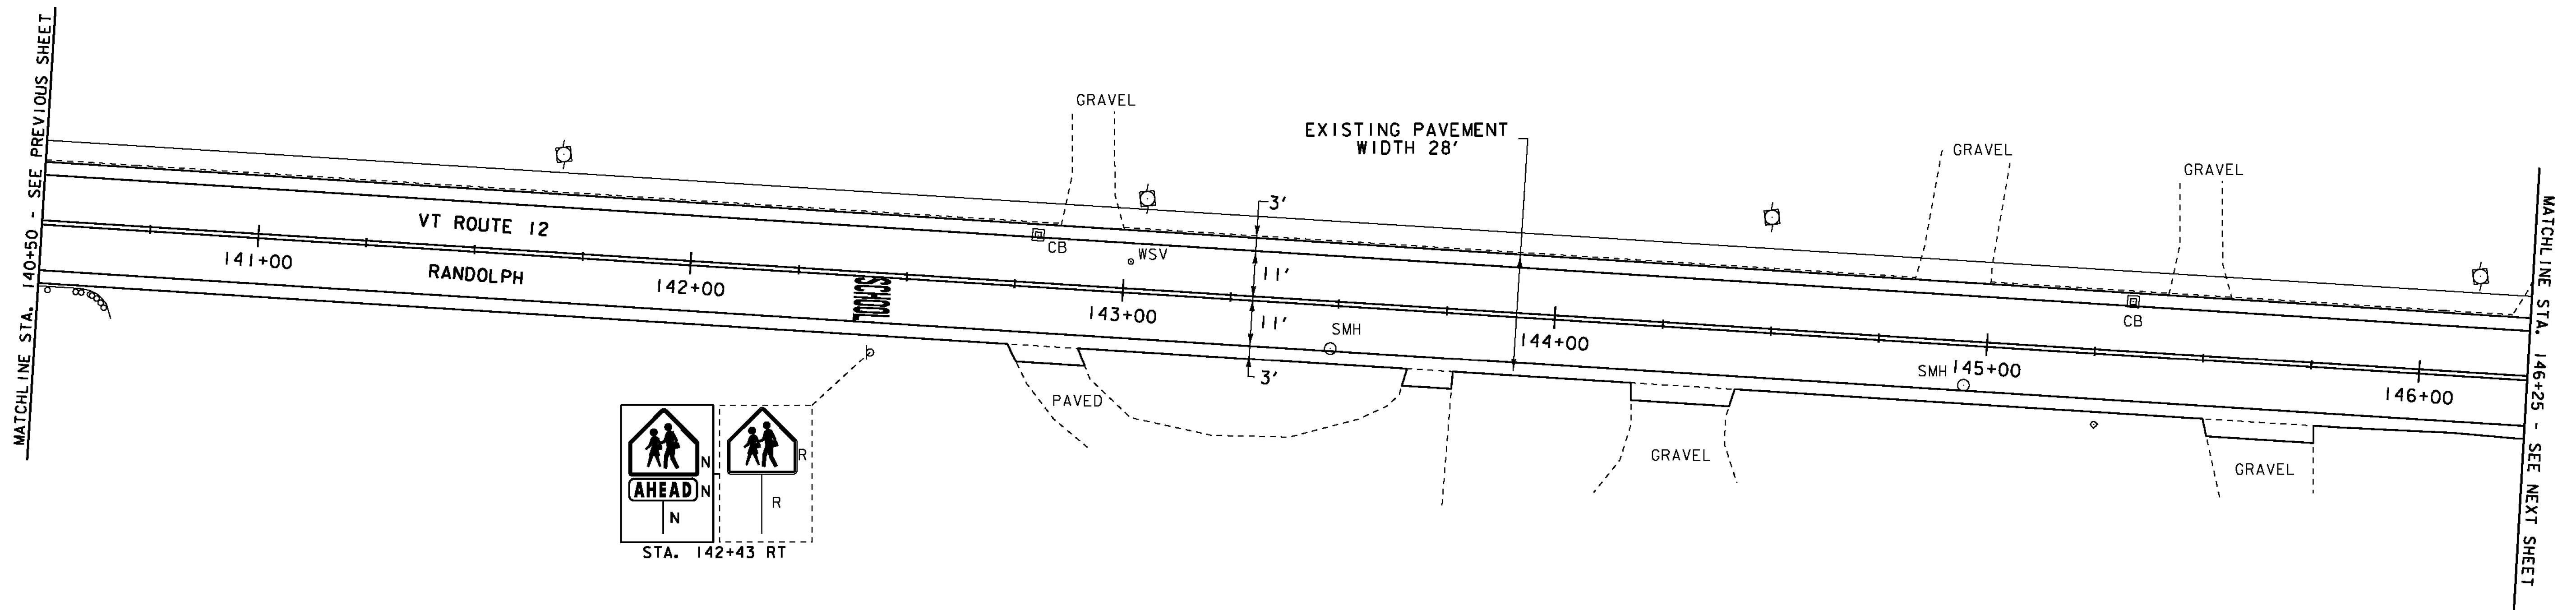

- LEGEND**
- SIGN
  - HYDRANT
  - MANHOLE
  - VALVE
  - GAS PIPELINE MARKER
  - CATCH BASIN / DROP INLET
  - CURB INLET
  - ⊠ TRAFFIC CONTROL BOX
  - ⊠ PARKING METER
  - ⊠ UTILITY POLE
  - DETECTABLE WARNINGS
  - LIGHT POLE
  - EX. DETECTABLE WARNINGS
  - JUNCTION BOX
  - ⊠ PED BUTTON
  - ⊠ ELECTRICAL BOX
  - ⊠ SIGNAL
  - ⊠ PEDESTAL POST
  - STRAIN POLE
  - CAMERA
  - VDZ VIDEO DETECTION ZONE

- SIGN LEGEND**
- R = REMOVE
  - R&S = REMOVE AND SALVAGE
  - RET = RETAIN
  - S = SALVAGE
  - N = NEW
  - B-B = BACK TO BACK

NOT TO SCALE

**PROJECT LAYOUT SHEET 22**

PROJECT NAME: BETHEL-NORTHFIELD  
PROJECT NUMBER: STP 2922(I)

FILE NAME: piOC246.dgn  
PROJECT LEADER: CDL  
DESIGNED BY: SJL  
PLOT FILE: piOC246\_41.i

PLOT DATE: 1/3/13  
DRAWN BY: JBG  
CHECKED BY: CDL  
SHEET 41 OF 149