

REHAB. DROP INLETS, CATCH BASINS, OR MANHOLES, CLASS I OR CLASS II
 STA. 146+72 LT ✓
 STA. 150+11 LT ✓
 STA. 151+22 LT ✓

CHANGING ELEVATION OF SEWER MANHOLES
 STA. 149+06 RT ✓ STA. 147+22 RT
 STA. 150+24 RT ✓

ADJUST ELEVATION OF VALVE BOX
 STA. 146+45 LT "WSV" ✓

COMMON EXCAVATION
 STA. 149+09 - STA. 149+15 LT
 PORTLAND CEMENT CONCRETE SIDEWALK, 5 INCH
 STA. 149+09 - STA. 149+15 LT

SUBBASE OF CRUSHED GRAVEL, FINE GRADED
 STA. 149+09 - STA. 149+15 LT

REMOVAL OF EXISTING CURB
 STA. 149+01 - STA. 149+24 LT

CAST-IN-PLACE CONCRETE CURB, TYPE B
 STA. 149+01 - STA. 149+24 LT

DETECTABLE WARNING SURFACES
 STA. 149+12 LT (8SF)

DURABLE 4 INCH WHITE LINE, TYPE I TAPE
 STA. 146+25 - STA. 151+75 (SOLID LT & RT)
 (WITH BREAKS AT CROSSWALKS AND SCHOOL DRIVES)

DURABLE 4 INCH YELLOW LINE, TYPE I TAPE
 STA. 146+25 - STA. 151+75 (SOLID LT & RT)
 (WITH BREAKS AT CROSSWALKS AND SCHOOL DRIVES)


TEMPORARY 4 INCH WHITE LINE, PAINT
 STA. 146+25 - STA. 151+75 (SOLID LT & RT)
 (WITH BREAKS AT CROSSWALKS AND SCHOOL DRIVES)

TEMPORARY 4 INCH YELLOW LINE, PAINT
 STA. 146+25 - STA. 151+75 (SOLID LT & RT)
 (WITH BREAKS AT CROSSWALKS AND SCHOOL DRIVES)

DURABLE CROSSWALK MARKING, TYPE I TAPE
 STA. 149+13 LT & RT

TEMPORARY CROSSWALK MARKING, PAINT
 STA. 149+13 LT & RT

REMOVING SIGNS
 AS SHOWN - 8

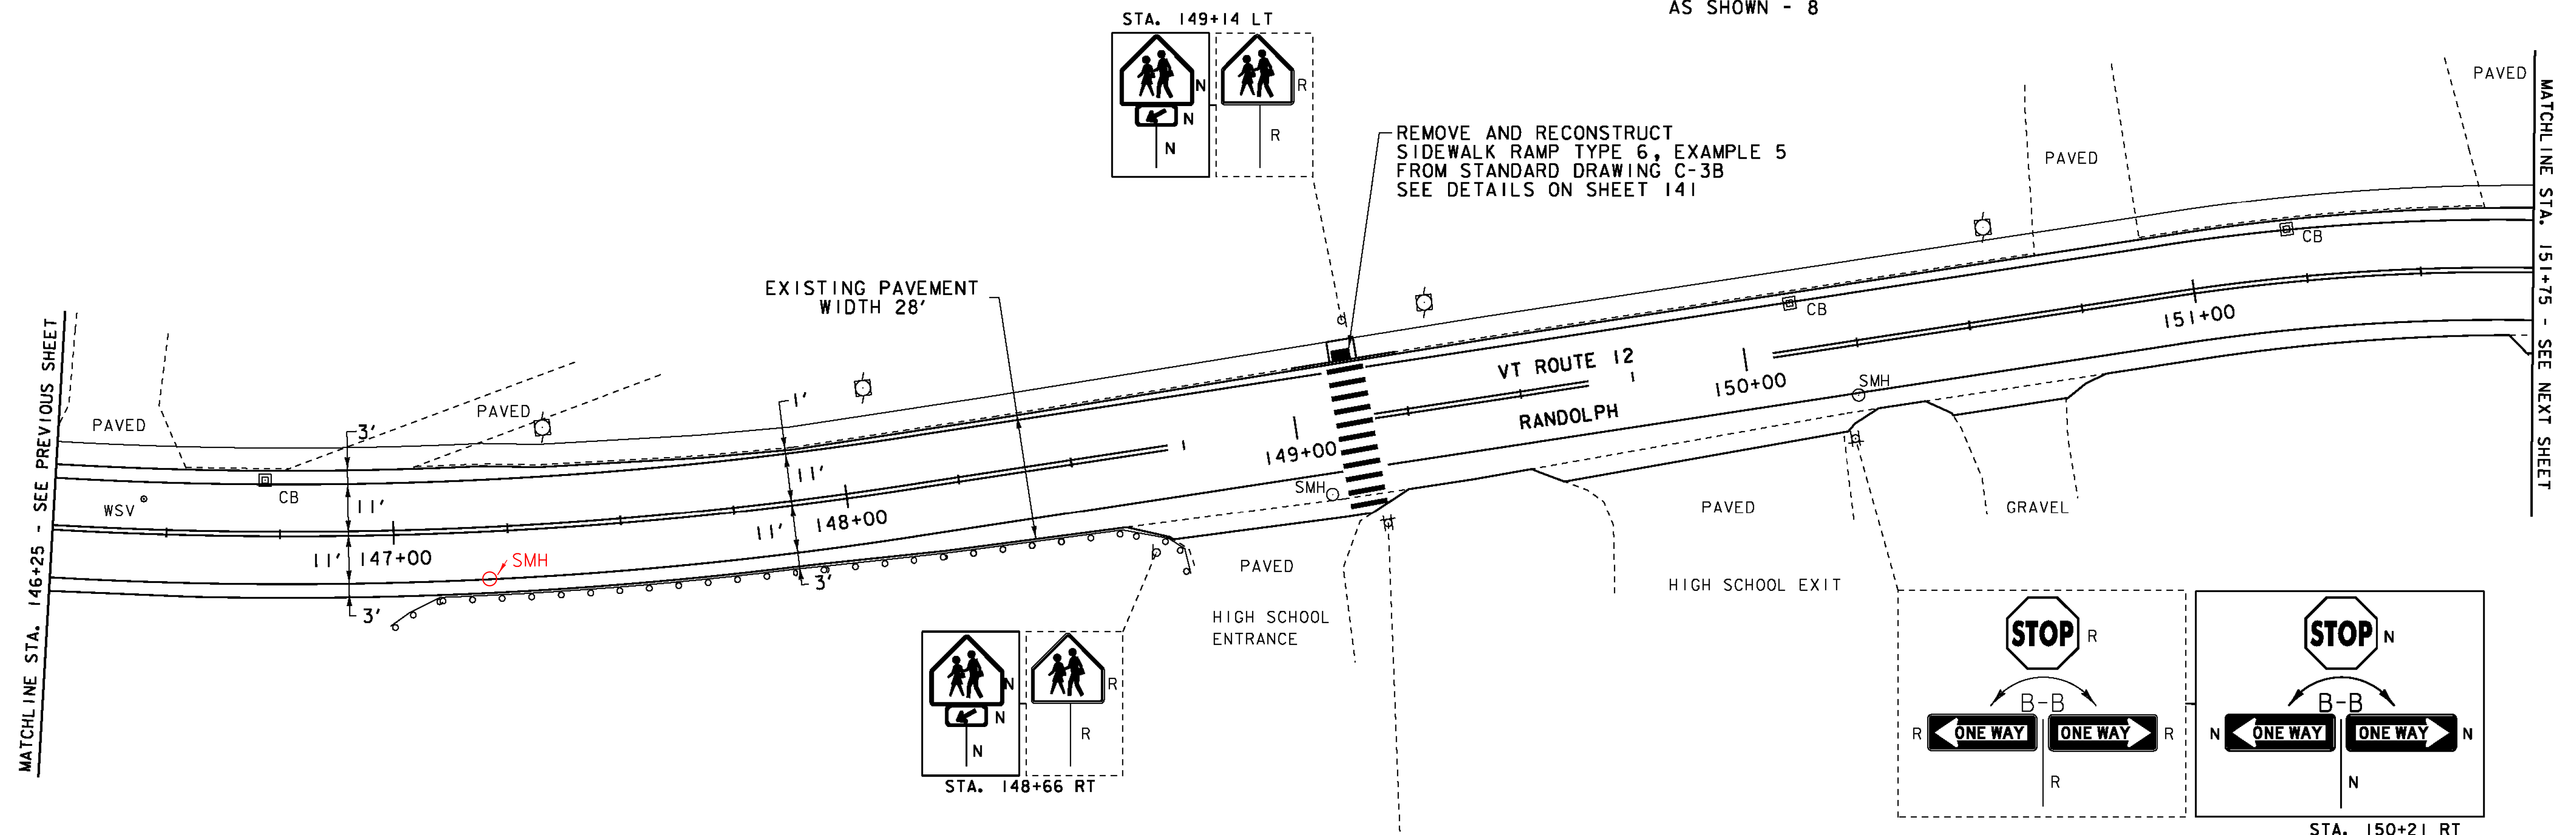


MATCHLINE STA. 146+25 - SEE PREVIOUS SHEET

MATCHLINE STA. 151+75 - SEE NEXT SHEET

- LEGEND**
- SIGN
 - HYDRANT
 - MANHOLE
 - VALVE
 - GAS PIPELINE MARKER
 - CATCH BASIN / DROP INLET
 - CURB INLET
 - ⊠ TRAFFIC CONTROL BOX
 - ⊠ PARKING METER
 - ⊠ UTILITY POLE
 - DETECTABLE WARNINGS
 - LIGHT POLE
 - EX. DETECTABLE WARNINGS
 - JUNCTION BOX
 - ⊠ PED BUTTON
 - ⊠ ELECTRICAL BOX
 - ⊠ SIGNAL
 - ⊠ PEDESTAL POST
 - ⊠ STRAIN POLE
 - CAMERA
 - VIDEO DETECTION ZONE

- SIGN LEGEND**
- R = REMOVE
 - R&S = REMOVE AND SALVAGE
 - RET = RETAIN
 - S = SALVAGE
 - N = NEW
 - B-B = BACK TO BACK

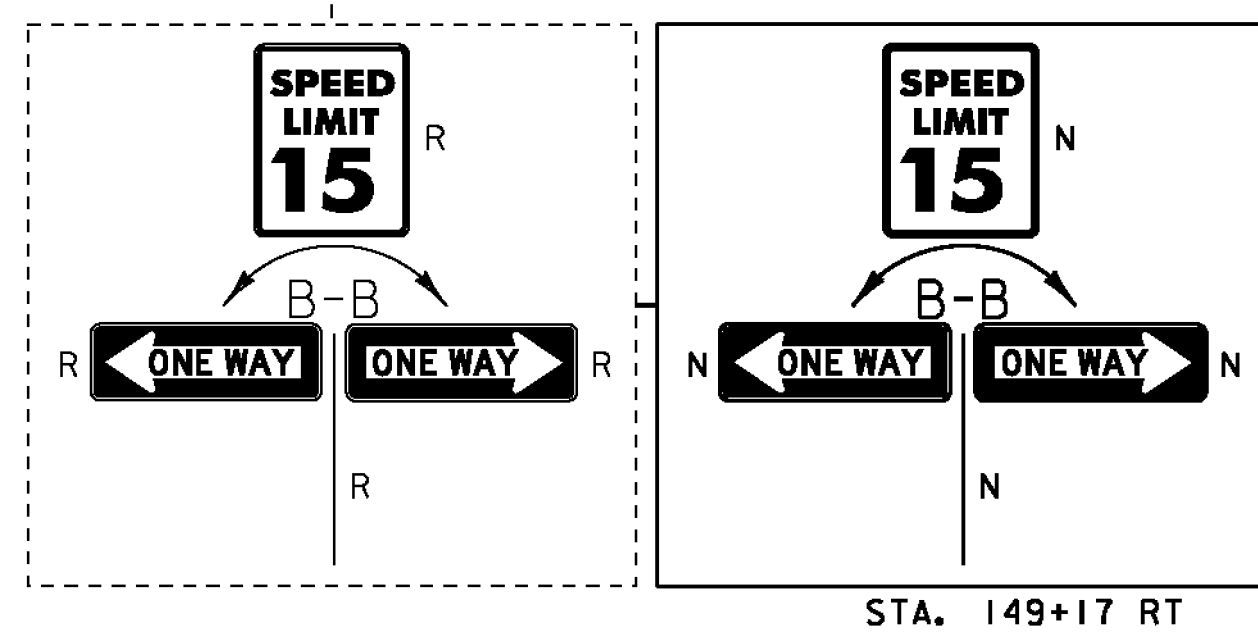

NOT TO SCALE

PROJECT LAYOUT SHEET 23	PROJECT NAME: BETHEL-NORTHFIELD	PLOT DATE: 1/3/13
	PROJECT NUMBER: STP 2922(I)	DRAWN BY: JBG
	FILE NAME: piOC246.dgn	CHECKED BY: CDL
	DESIGNED BY: SJL	SHEET 42 OF 149
	PLOT FILE: piOC246_42.i	