

REHAB, DROP INLETS, CATCH BASINS, OR MANHOLES, CLASS I OR CLASS II

- STA. 152+07 LT ✓
- STA. 153+05 LT ✓
- STA. 154+92 LT ✓
- STA. 155+19 LT ✓

CHANGING ELEVATION OF SEWER MANHOLES

- STA. 152+01 LT ✓ LISTED AS STA. 120+01 IN SITE MGR
- STA. 153+69 RT ✓
- STA. 155+16 LT ✓
- STA. 155+29 LT ✓

ADJUST ELEVATION OF VALVE BOX
STA. 152+78 RT "WSV" ✓

DURABLE 4 INCH WHITE LINE, TYPE I TAPE
STA. 151+75 - STA. 157+50 (SOLID LT & RT)
(WITH BREAKS AT SIDEROADS)
STA. 155+32 LT (EDGELINES AYERS BROOK RD)

DURABLE 4 INCH YELLOW LINE, TYPE I TAPE
STA. 151+75 - STA. 157+50 (SOLID LT & RT)
(WITH BREAKS AT SIDEROADS)
STA. 155+32 LT (CENTERLINE AYERS BROOK RD)

TEMPORARY 4 INCH WHITE LINE, PAINT
STA. 151+75 - STA. 157+50 (SOLID LT & RT)
(WITH BREAKS AT SIDEROADS)
STA. 155+32 LT (EDGELINES AYERS BROOK RD)


TEMPORARY 4 INCH YELLOW LINE, PAINT
STA. 151+75 - STA. 157+50 (SOLID LT & RT)
(WITH BREAKS AT SIDEROADS)
STA. 155+32 LT (CENTERLINE AYERS BROOK RD)

DURABLE 24 INCH STOP BAR, TYPE I TAPE
STA. 155+14 - 155+33 LT

TEMPORARY 24 INCH STOP BAR, PAINT
STA. 155+14 - STA. 155+33 LT

DURABLE LETTER OR SYMBOL, TYPE I TAPE
STA. 155+24 LT "STOP"

TEMPORARY LETTER OR SYMBOL, PAINT
STA. 155+24 LT "STOP"

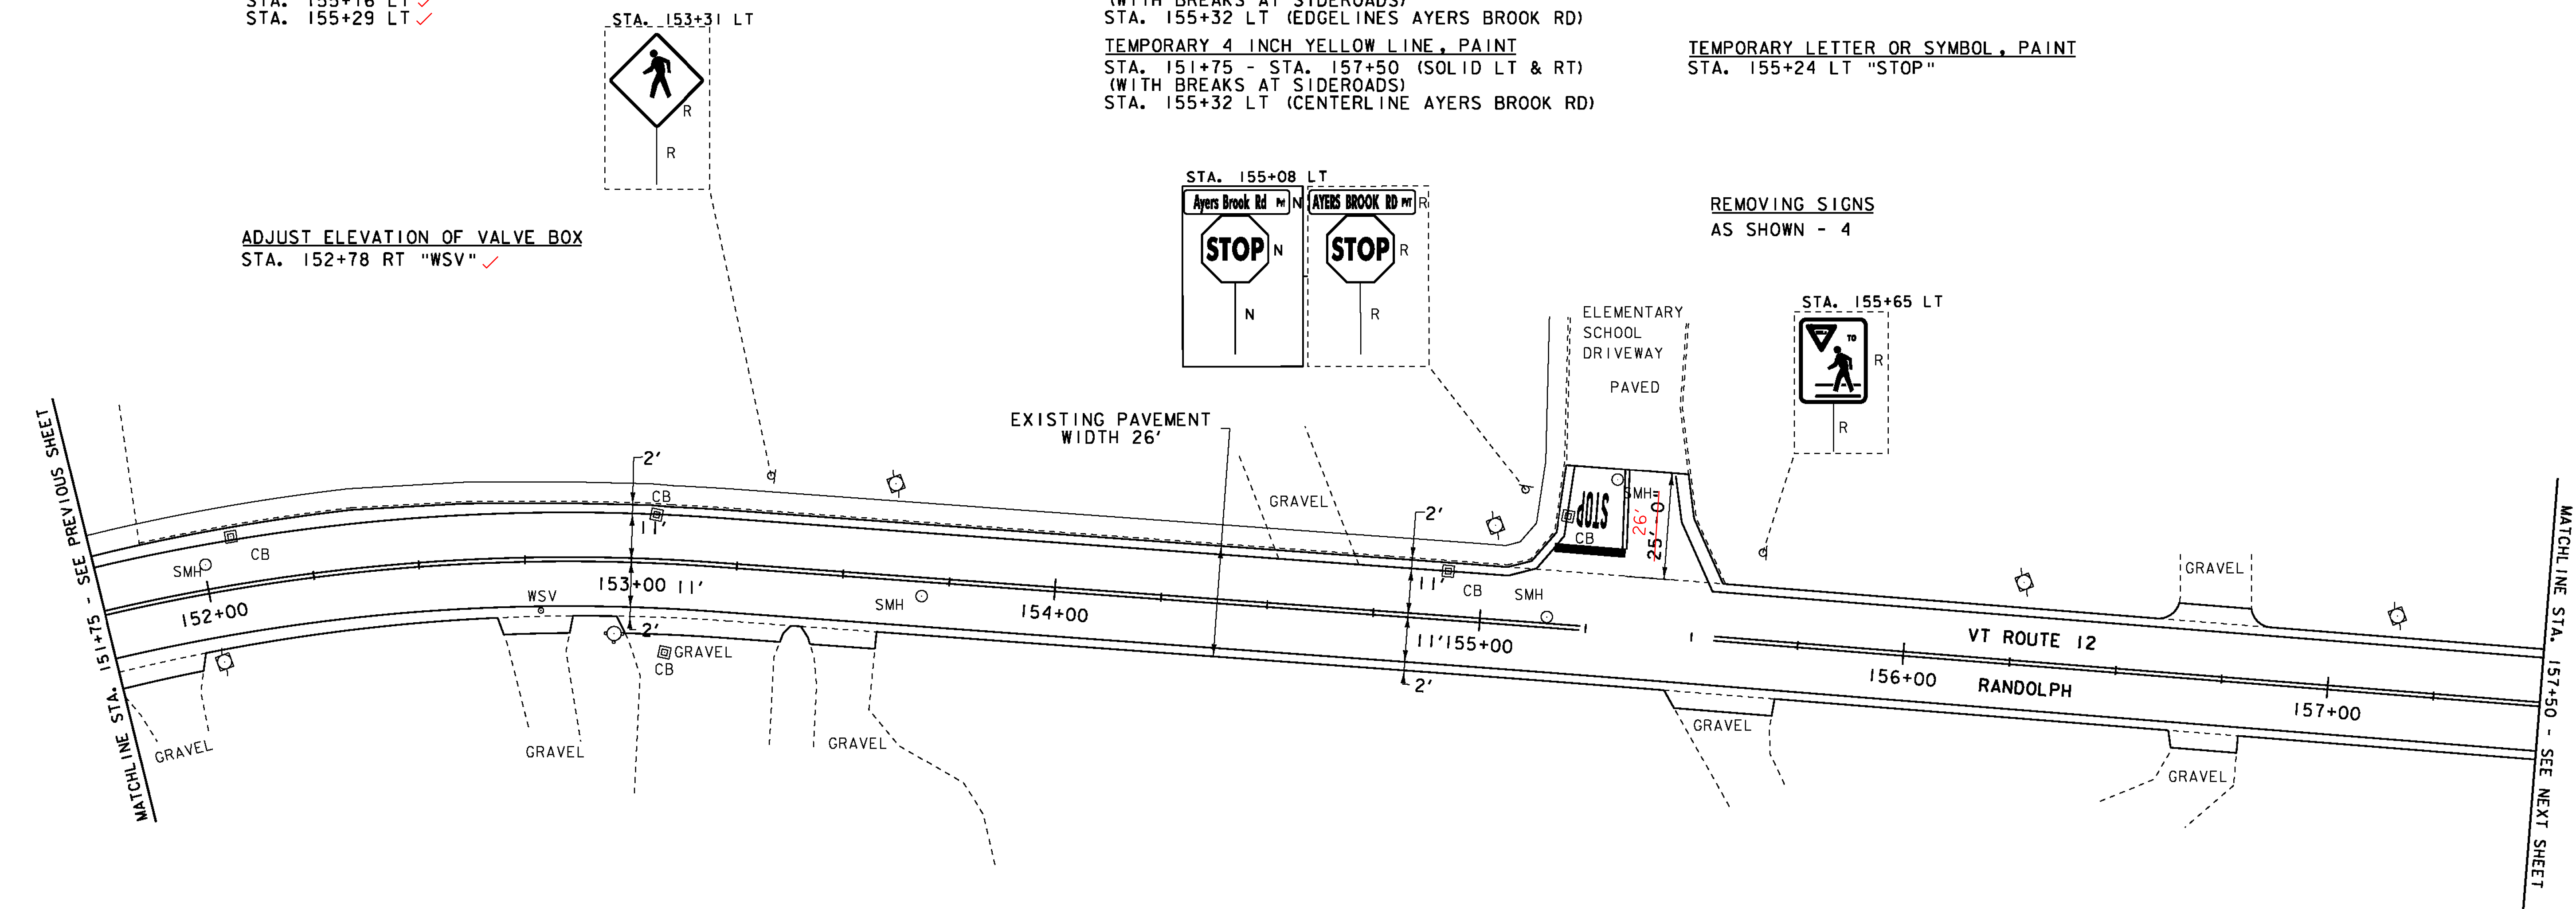

- LEGEND**
- SIGN
 - HYDRANT
 - MANHOLE
 - VALVE
 - GAS PIPELINE MARKER
 - CATCH BASIN / DROP INLET
 - CURB INLET
 - TRAFFIC CONTROL BOX
 - PARKING METER
 - UTILITY POLE
 - DETECTABLE WARNINGS

- LIGHT POLE
- EX. DETECTABLE WARNINGS
- JUNCTION BOX
- PED BUTTON
- ELECTRICAL BOX
- SIGNAL
- PEDESTAL POST
- STRAIN POLE
- CAMERA
- V D Z VIDEO DETECTION ZONE

- SIGN LEGEND**
- R = REMOVE
 - R&S = REMOVE AND SALVAGE
 - RET = RETAIN
 - S = SALVAGE
 - N = NEW
 - B-B = BACK TO BACK

NOT TO SCALE

PROJECT LAYOUT SHEET 24	PROJECT NAME: BETHEL-NORTHFIELD	PLOT DATE: 1/3/13
	PROJECT NUMBER: STP 2922(I)	DRAWN BY: JBG
	FILE NAME: piOC246.dgn	CHECKED BY: CDL
	DESIGNED BY: SJL	SHEET 43 OF 149
	PLOT FILE: piOC246_43.I	