

CHANGING ELEVATION OF SEWER MANHOLES
 STA. 159+09 LT ✓
 STA. 160+51 LT ✓

DURABLE LETTER OR SYMBOL, TYPE I TAPE
 STA. 158+71 LT "SCHOOL"

TEMPORARY LETTER OR SYMBOL, PAINT
 STA. 158+71 LT "SCHOOL"


DURABLE 4 INCH WHITE LINE, TYPE I TAPE
 STA. 157+50 - STA. 161+53 (SOLID LT & RT)

DURABLE 4 INCH YELLOW LINE, TYPE I TAPE
 STA. 157+50 - STA. 161+53 (SOLID LT & RT)

TEMPORARY 4 INCH WHITE LINE, PAINT
 STA. 157+50 - STA. 161+53 (SOLID LT & RT)

TEMPORARY 4 INCH YELLOW LINE, PAINT
 STA. 157+50 - STA. 161+53 (SOLID LT & RT)

REMOVING SIGNS
 AS SHOWN - 5

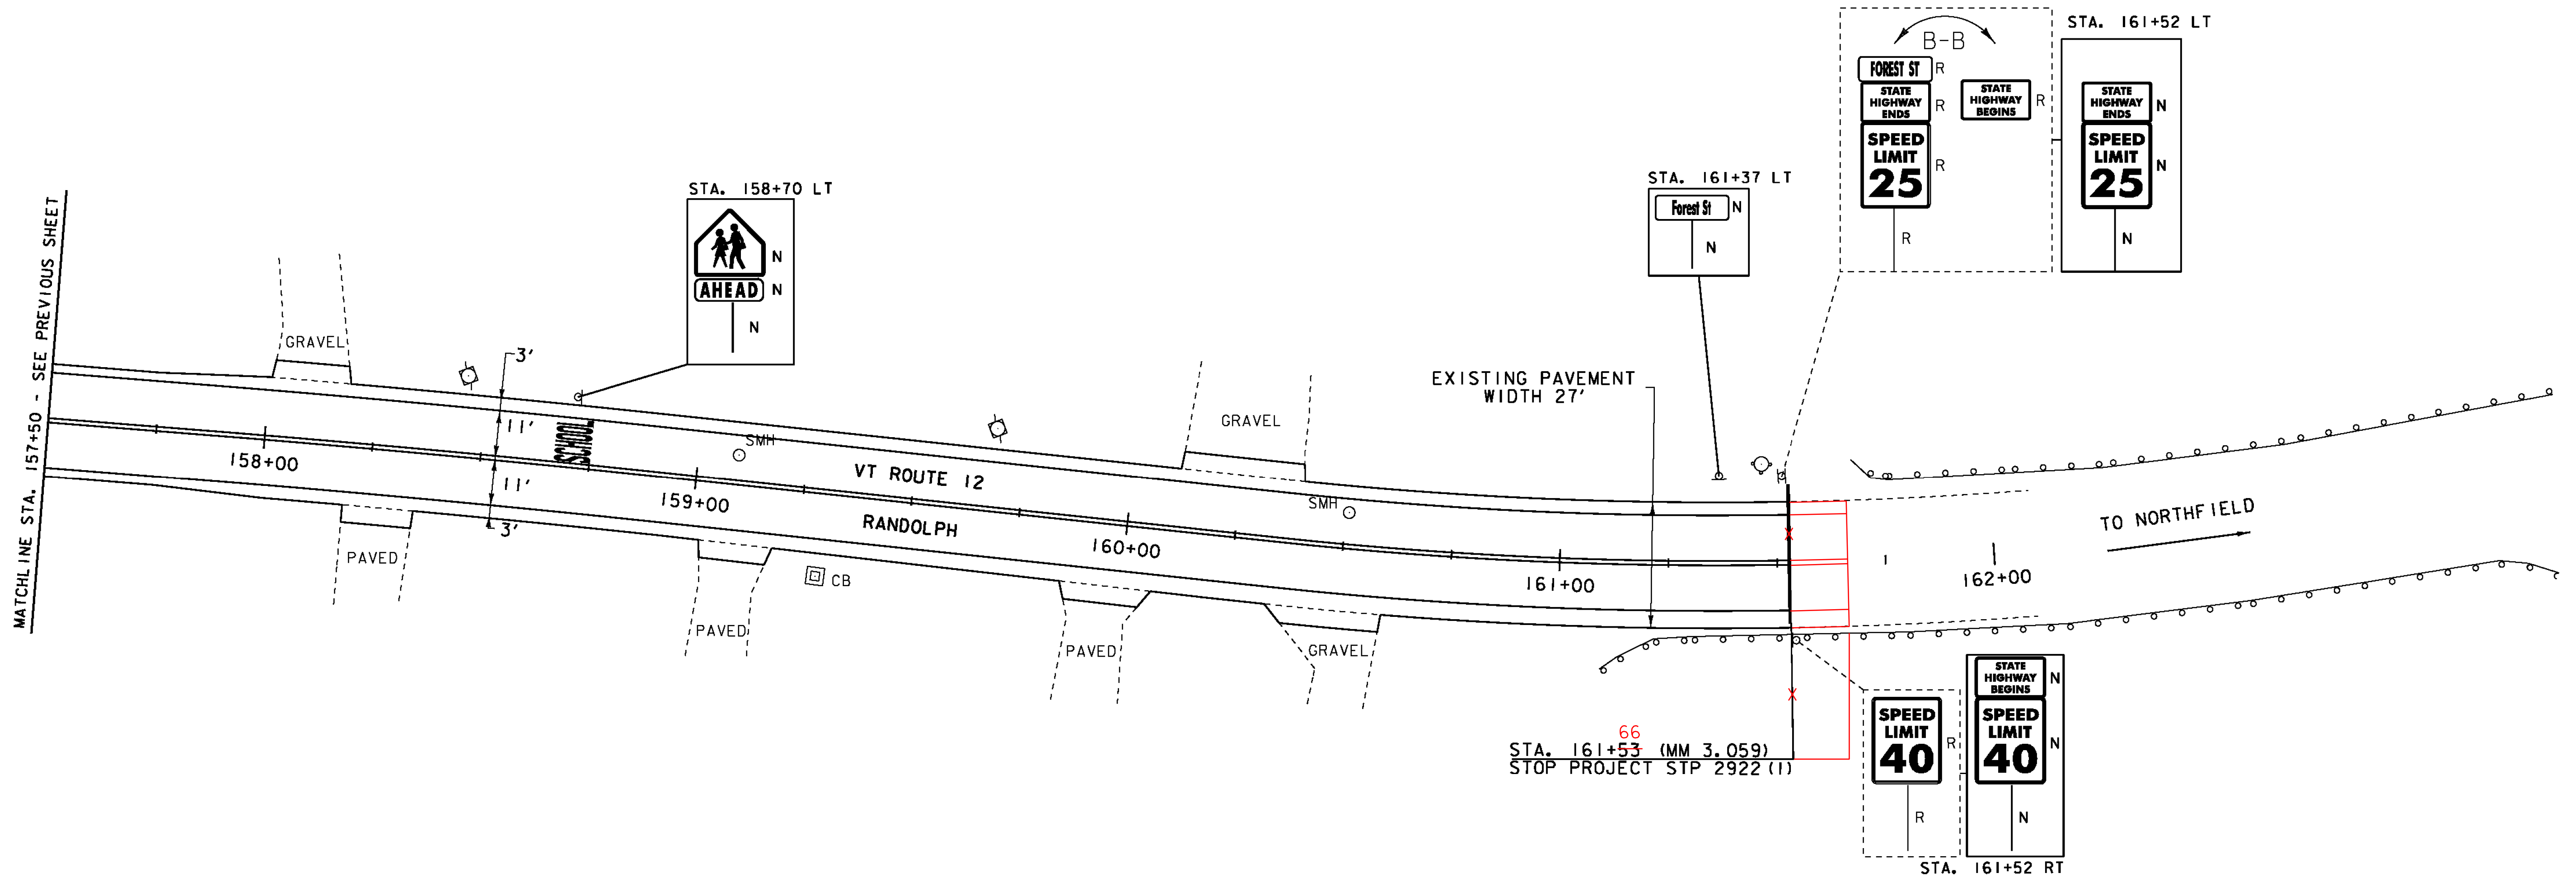

LEGEND

- | | | | |
|---|--------------------------|---|-------------------------|
| ○ | SIGN | ● | LIGHT POLE |
| ○ | HYDRANT | ■ | EX. DETECTABLE WARNINGS |
| ○ | MANHOLE | □ | JUNCTION BOX |
| ○ | VALVE | ⊕ | PED BUTTON |
| ○ | GAS PIPELINE MARKER | ⊖ | ELECTRICAL BOX |
| □ | CATCH BASIN / DROP INLET | ⊙ | SIGNAL |
| □ | CURB INLET | ⊙ | PEDESTAL POST |
| ⊕ | TRAFFIC CONTROL BOX | | |
| ⊖ | PARKING METER | | |
| ⊙ | UTILITY POLE | | |
| ■ | DETECTABLE WARNINGS | | |

SIGN LEGEND

- | | |
|-----|----------------------|
| R | = REMOVE |
| R&S | = REMOVE AND SALVAGE |
| RET | = RETAIN |
| S | = SALVAGE |
| N | = NEW |
| B-B | = BACK TO BACK |

NOT TO SCALE

PROJECT LAYOUT SHEET 25

PROJECT NAME: BETHEL-NORTHFIELD
 PROJECT NUMBER: STP 2922(I)

FILE NAME: piOC246.dgn
 PROJECT LEADER: CDL
 DESIGNED BY: SJL
 PLOT FILE: piOC246_44.I

PLOT DATE: 1/3/13
 DRAWN BY: JBG
 CHECKED BY: CDL
 SHEET 44 OF 149