

REHAB. DROP INLETS, CATCH BASINS,
OR MANHOLES, CLASS I OR CLASS II
STA. 8+00 LT ← OUTSIDE PAVED AREA

CHANGING ELEVATION OF SEWER MANHOLES
STA. 10+88 RT ✓

COMMON EXCAVATION
STA. 10+15 - STA. 10+22 RT

PORTLAND CEMENT CONCRETE SIDEWALK, 5 INCH
STA. 10+15 - STA. 10+22 RT ✓

SUBBASE OF CRUSHED GRAVEL, FINE GRADED
STA. 10+15 - STA. 10+22 RT

DETECTABLE WARNING SURFACES
STA. 10+18 RT (8 SF) ✓

DURABLE 4 INCH YELLOW LINE, TYPE I TAPE
STA. 5+75 - STA. 11+75 (SOLID LT & RT)
(WITH BREAKS AT TOWN ROADS)
STA. 10+90 RT (CENTERLINES TH #366)

DURABLE 24 INCH STOP BAR, TYPE I TAPE
STA. 10+78 - STA. 10+89 RT

TEMPORARY 24 INCH STOP BAR, PAINT
STA. 10+78 - STA. 10+89 RT


DURABLE LETTER OR SYMBOL, TYPE I TAPE
STA. 10+85 RT "STOP"

TEMPORARY LETTER OR SYMBOL, PAINT
STA. 10+85 RT "STOP"

TEMPORARY 4 INCH YELLOW LINE, PAINT
STA. 5+75 - STA. 11+75 (SOLID LT & RT)
(WITH BREAKS AT TOWN ROADS)
STA. 10+90 RT (CENTERLINES TH #366)

REMOVING SIGNS
AS SHOWN - 6

ADJUST ELEVATION OF VALVE BOX
STA. 10+52 LT "WSV" (NOT ON PLANS)
STA. 10+54 LT "WSV" (NOT ON PLANS)
STA. 10+56 LT "WSV" (NOT ON PLANS)

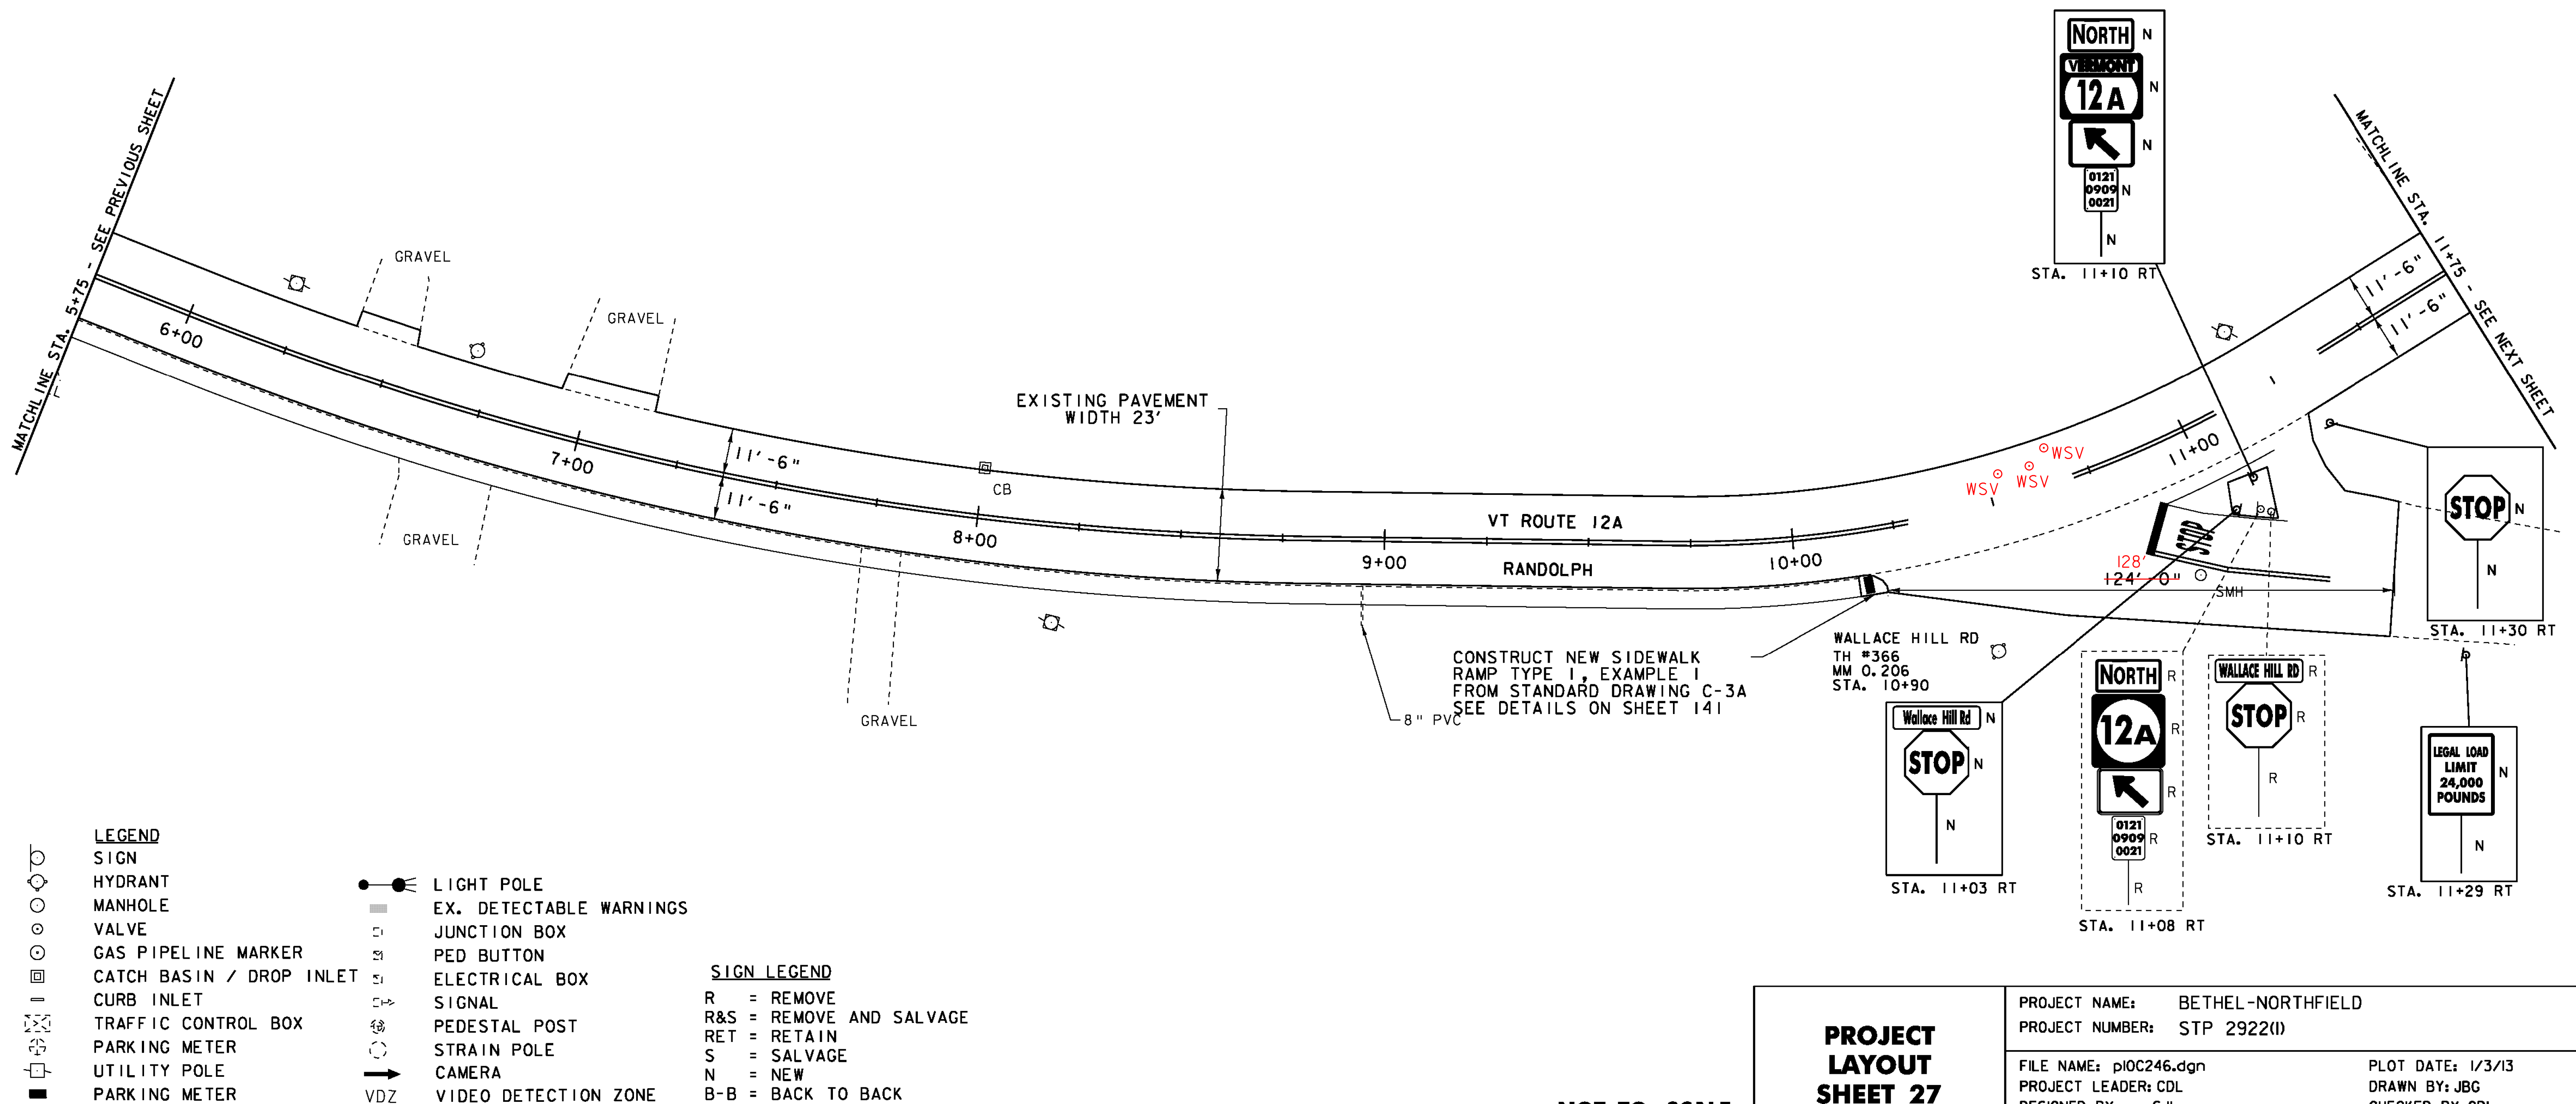

- LEGEND**
- SIGN
 - HYDRANT
 - MANHOLE
 - VALVE
 - GAS PIPELINE MARKER
 - CATCH BASIN / DROP INLET
 - CURB INLET
 - TRAFFIC CONTROL BOX
 - PARKING METER
 - UTILITY POLE
 - PARKING METER
 - LIGHT POLE
 - EX. DETECTABLE WARNINGS
 - JUNCTION BOX
 - PED BUTTON
 - ELECTRICAL BOX
 - SIGNAL
 - PEDESTAL POST
 - STRAIN POLE
 - CAMERA
 - VIDEO DETECTION ZONE
- SIGN LEGEND**
- R = REMOVE
 - R&S = REMOVE AND SALVAGE
 - RET = RETAIN
 - S = SALVAGE
 - N = NEW
 - B-B = BACK TO BACK

PROJECT LAYOUT SHEET 27	PROJECT NAME: BETHEL-NORTHFIELD	PLOT DATE: 1/3/13
	PROJECT NUMBER: STP 2922(I)	DRAWN BY: JBG
	FILE NAME: piOC246.dgn	CHECKED BY: CDL
DESIGNED BY: SJL	SHEET 46 OF 149	
PLOT FILE: piOC246_46.1		

NOT TO SCALE