

COMMON EXCAVATION
 STA. 13+45 - STA. 13+54 RT ✓
 STA. 13+47 - STA. 13+52 LT ✓

PORTLAND CEMENT CONCRETE SIDEWALK, 5 INCH
 STA. 13+45 - STA. 13+54 RT
 STA. 13+47 - STA. 13+52 LT

SUBBASE OF CRUSHED GRAVEL, FINE GRADED
 STA. 13+45 - STA. 13+54 RT
 STA. 13+47 - STA. 13+52 LT

DETECTABLE WARNING SURFACES
 STA. 13+50 RT (8 SF) ✓
 STA. 13+50 LT (8 SF) ✓

DURABLE 4 INCH YELLOW LINE, TYPE I TAPE
 STA. 11+75 - STA. 17+75 (SOLID LT & RT)
 (WITH BREAKS AT CROSSWALKS)


DURABLE CROSSWALK MARKING, TYPE I TAPE
 STA. 13+50 LT & RT

TEMPORARY CROSSWALK MARKING, PAINT
 STA. 13+50 LT & RT

TEMPORARY 4 INCH YELLOW LINE, PAINT
 STA. 11+75 - STA. 17+75 (SOLID LT & RT)
 (WITH BREAKS AT CROSSWALKS)

REMOVING SIGNS
 AS SHOWN - 5

ERECTING SALVAGED SIGNS
 AS SHOWN - 1

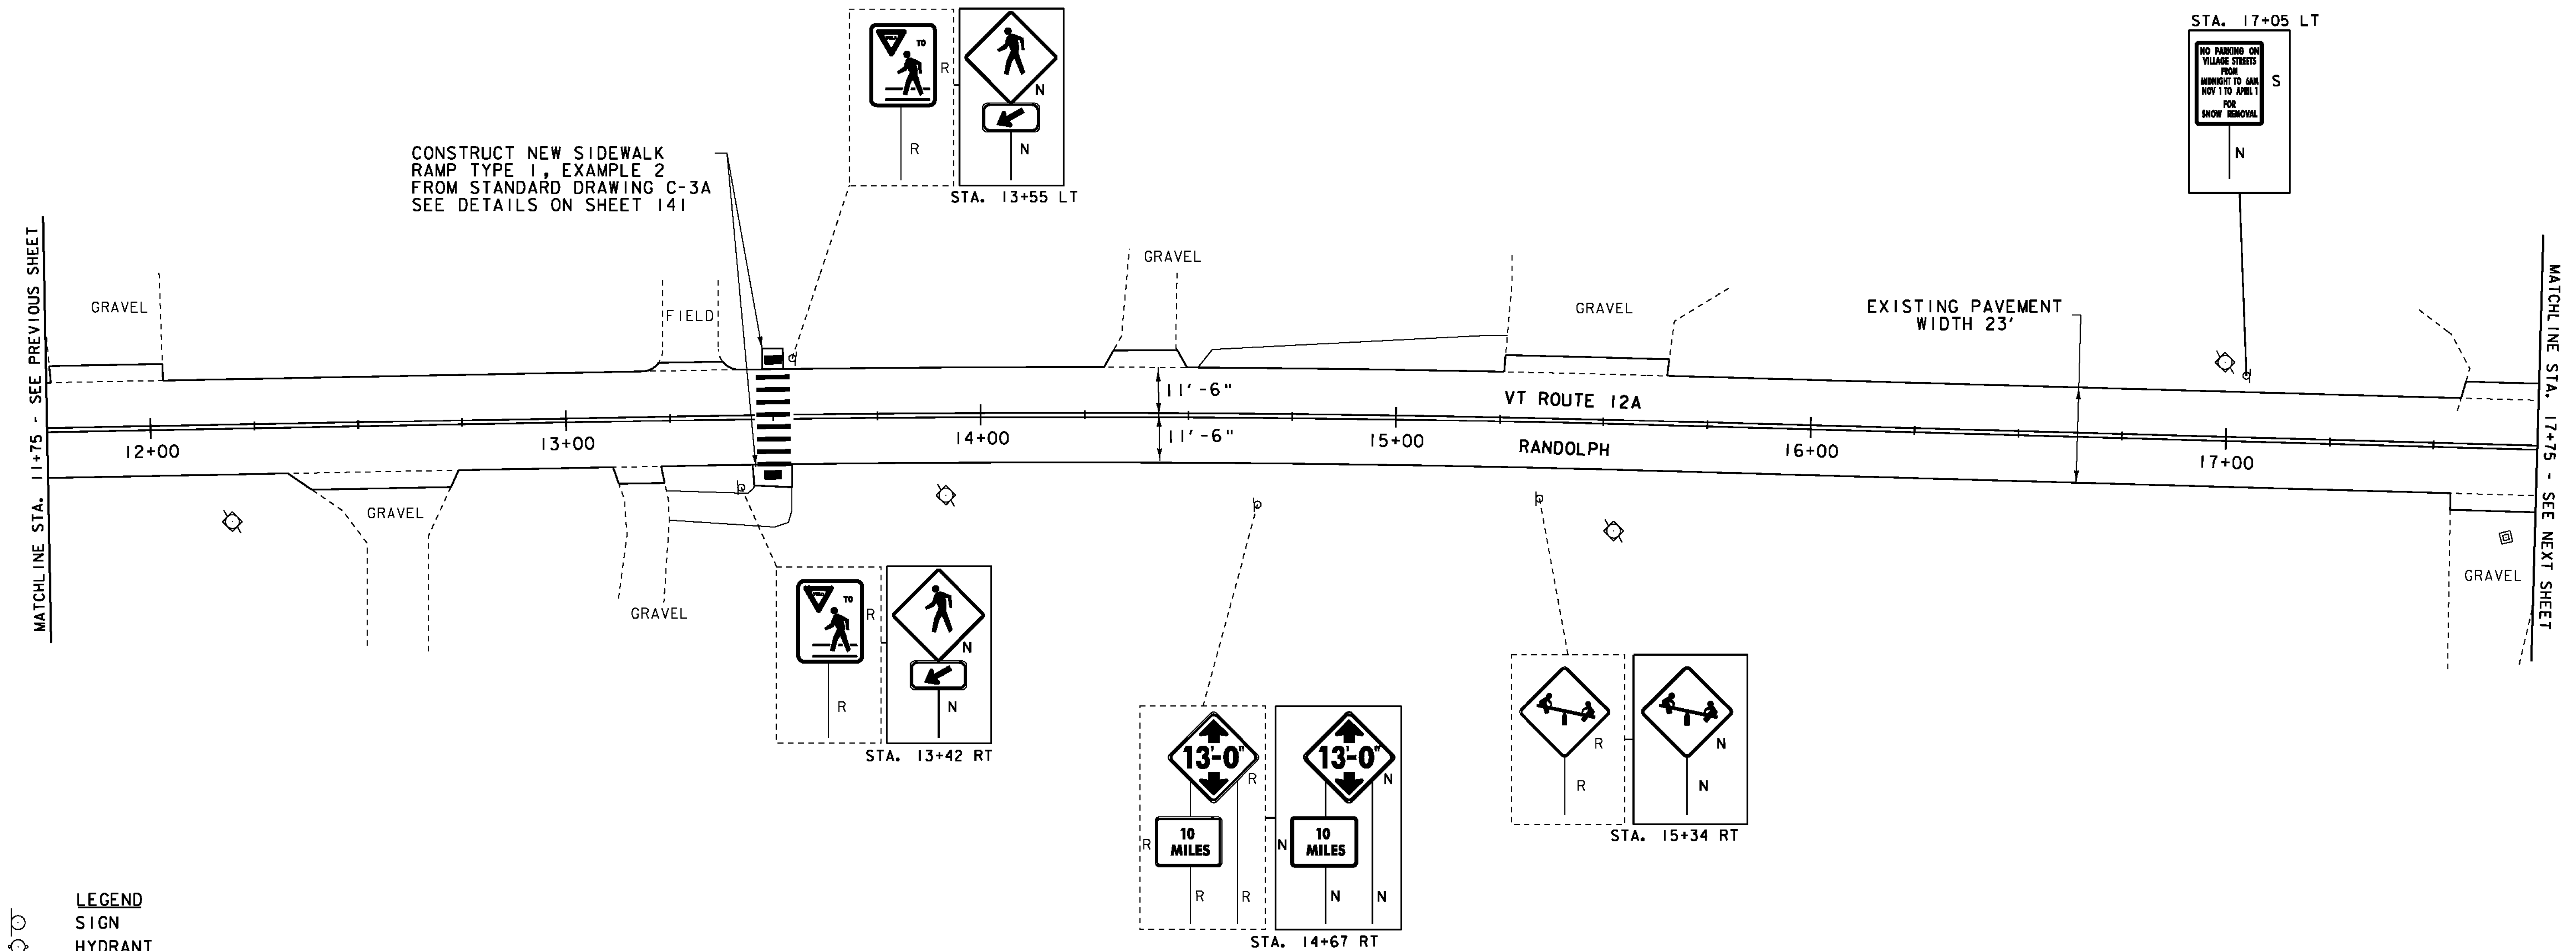

- LEGEND**
- SIGN
 - ⊕ HYDRANT
 - MANHOLE
 - VALVE
 - GAS PIPELINE MARKER
 - ▣ CATCH BASIN / DROP INLET
 - ▣ CURB INLET
 - ▣ TRAFFIC CONTROL BOX
 - ▣ PARKING METER
 - ▣ UTILITY POLE
 - ▣ PARKING METER
 - LIGHT POLE
 - ▣ EX. DETECTABLE WARNINGS
 - ▣ JUNCTION BOX
 - ▣ PED BUTTON
 - ▣ ELECTRICAL BOX
 - ▣ SIGNAL
 - ▣ PEDESTAL POST

- SIGN LEGEND**
- R = REMOVE
 - R&S = REMOVE AND SALVAGE
 - RET = RETAIN
 - S = SALVAGE
 - N = NEW
 - B-B = BACK TO BACK

NOT TO SCALE

PROJECT LAYOUT SHEET 28

PROJECT NAME: BETHEL-NORTHFIELD
 PROJECT NUMBER: STP 2922(I)

FILE NAME: piOC246.dgn
 PROJECT LEADER: CDL
 DESIGNED BY: SJL
 PLOT FILE: piOC246_47.I

PLOT DATE: 1/3/13
 DRAWN BY: JBG
 CHECKED BY: CDL
 SHEET 47 OF 149