


DURABLE 4 INCH YELLOW LINE, TYPE I TAPE
 STA. 17+75 - STA. 20+60 (SOLID LT & RT)

TEMPORARY 4 INCH YELLOW LINE, PAINT
 STA. 17+75 - STA. 20+60 (SOLID LT & RT)

REMOVING SIGNS
 AS SHOWN - 8

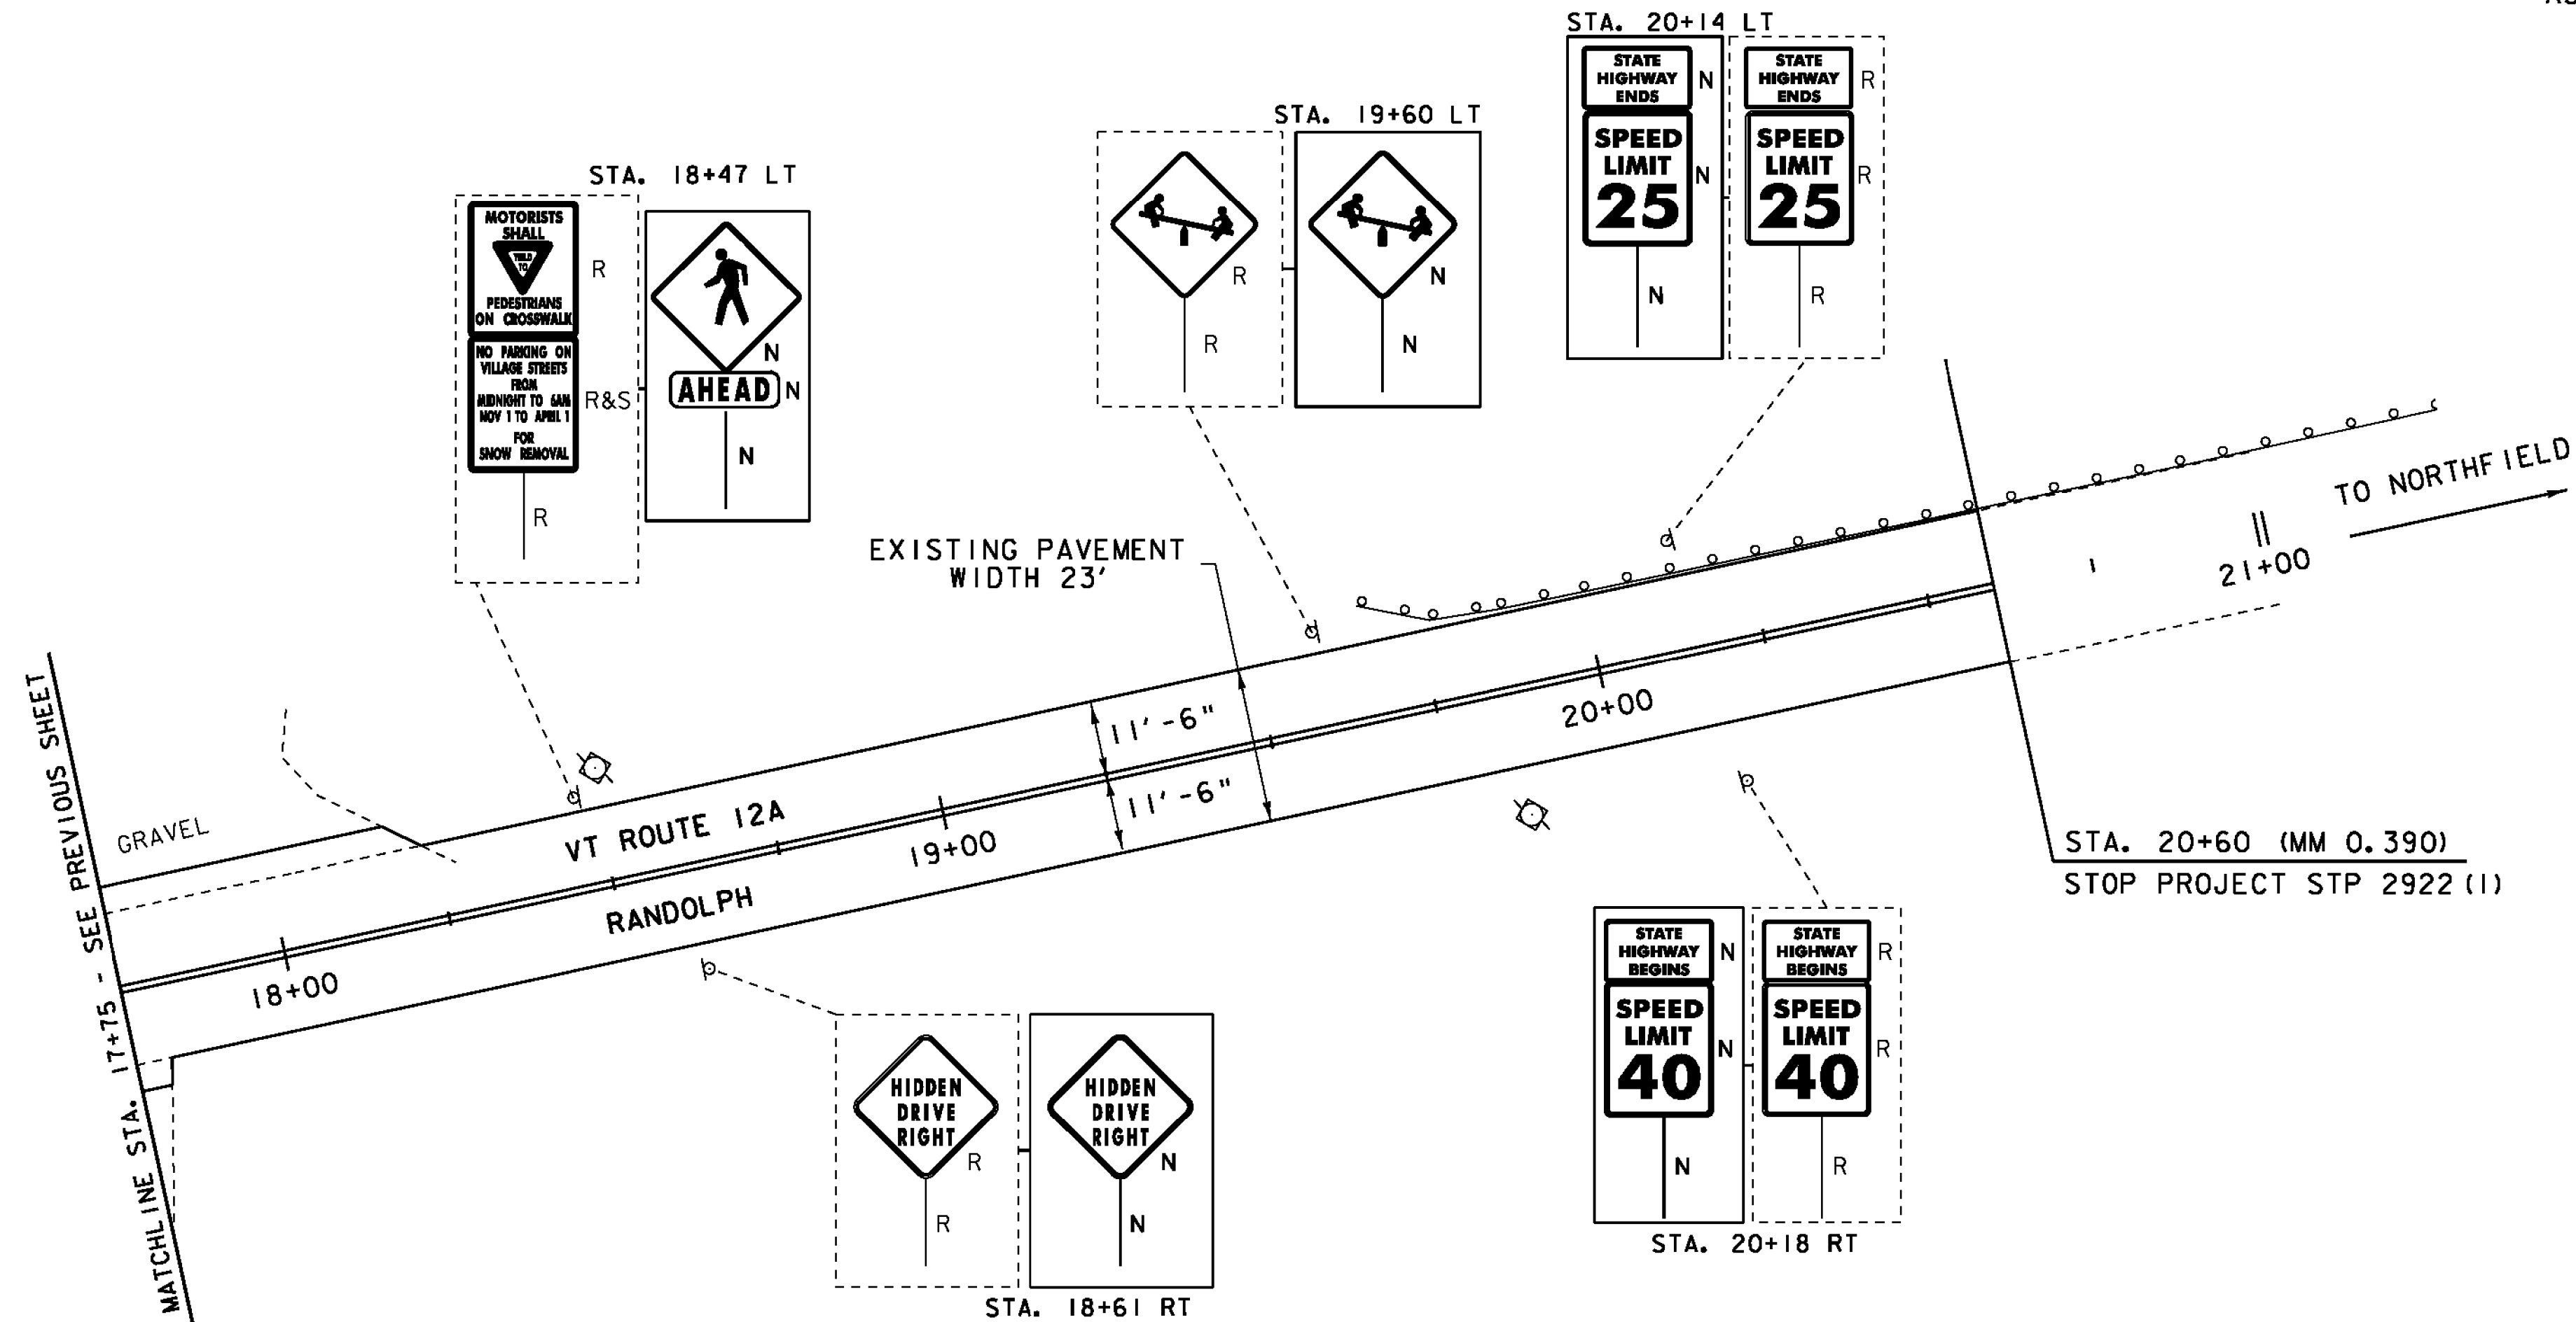

- LEGEND**
- SIGN
 - HYDRANT
 - MANHOLE
 - VALVE
 - GAS PIPELINE MARKER
 - CATCH BASIN / DROP INLET
 - CURB INLET
 - ☒ TRAFFIC CONTROL BOX
 - ☒ PARKING METER
 - ☒ UTILITY POLE
 - DETECTABLE WARNINGS

- LIGHT POLE
- EX. DETECTABLE WARNINGS
- JUNCTION BOX
- PED BUTTON
- ELECTRICAL BOX
- SIGNAL
- PEDESTAL POST
- STRAIN POLE
- CAMERA
- VDZ VIDEO DETECTION ZONE

- SIGN LEGEND**
- R = REMOVE
 - R&S = REMOVE AND SALVAGE
 - RET = RETAIN
 - S = SALVAGE
 - N = NEW
 - B-B = BACK TO BACK

NOT TO SCALE

PROJECT LAYOUT SHEET 29

PROJECT NAME: BETHEL-NORTHFIELD
 PROJECT NUMBER: STP 2922(1)

FILE NAME: piOC246.dgn
 PROJECT LEADER: CDL
 DESIGNED BY: SJL
 PLOT FILE: piOC246_48.1

PLOT DATE: 1/3/13
 DRAWN BY: SJL
 CHECKED BY: CDL
 SHEET 48 OF 149