

CHANGING ELEVATION OF SEWER MANHOLES

STA. 12+12 CL ✓
 STA. 13+74 RT ✓
 STA. 15+30 RT ✓

ADJUST ELEVATION OF VALVE BOX

STA. 11+30 LT "WSV" ✓
 STA. 11+83 LT "WSV" ✓
 STA. 16+13 LT "WSV"



DURABLE 4 INCH WHITE LINE, TYPE I TAPE
 STA. 11+25 - STA. 16+75 (SOLID LT & RT)

DURABLE 4 INCH YELLOW LINE, TYPE I TAPE
 STA. 11+25 - STA. 16+75 (SOLID LT & RT)

TEMPORARY 4 INCH WHITE LINE, PAINT
 STA. 11+25 - STA. 16+75 (SOLID LT & RT)

TEMPORARY 4 INCH YELLOW LINE, PAINT
 STA. 11+25 - STA. 16+75 (SOLID LT & RT)

REMOVING SIGNS
 AS SHOWN - 1

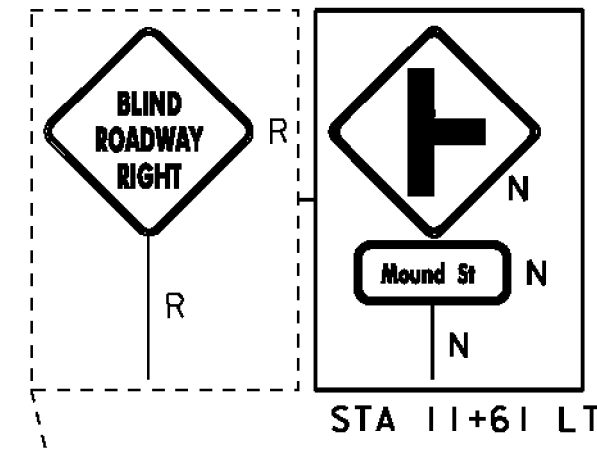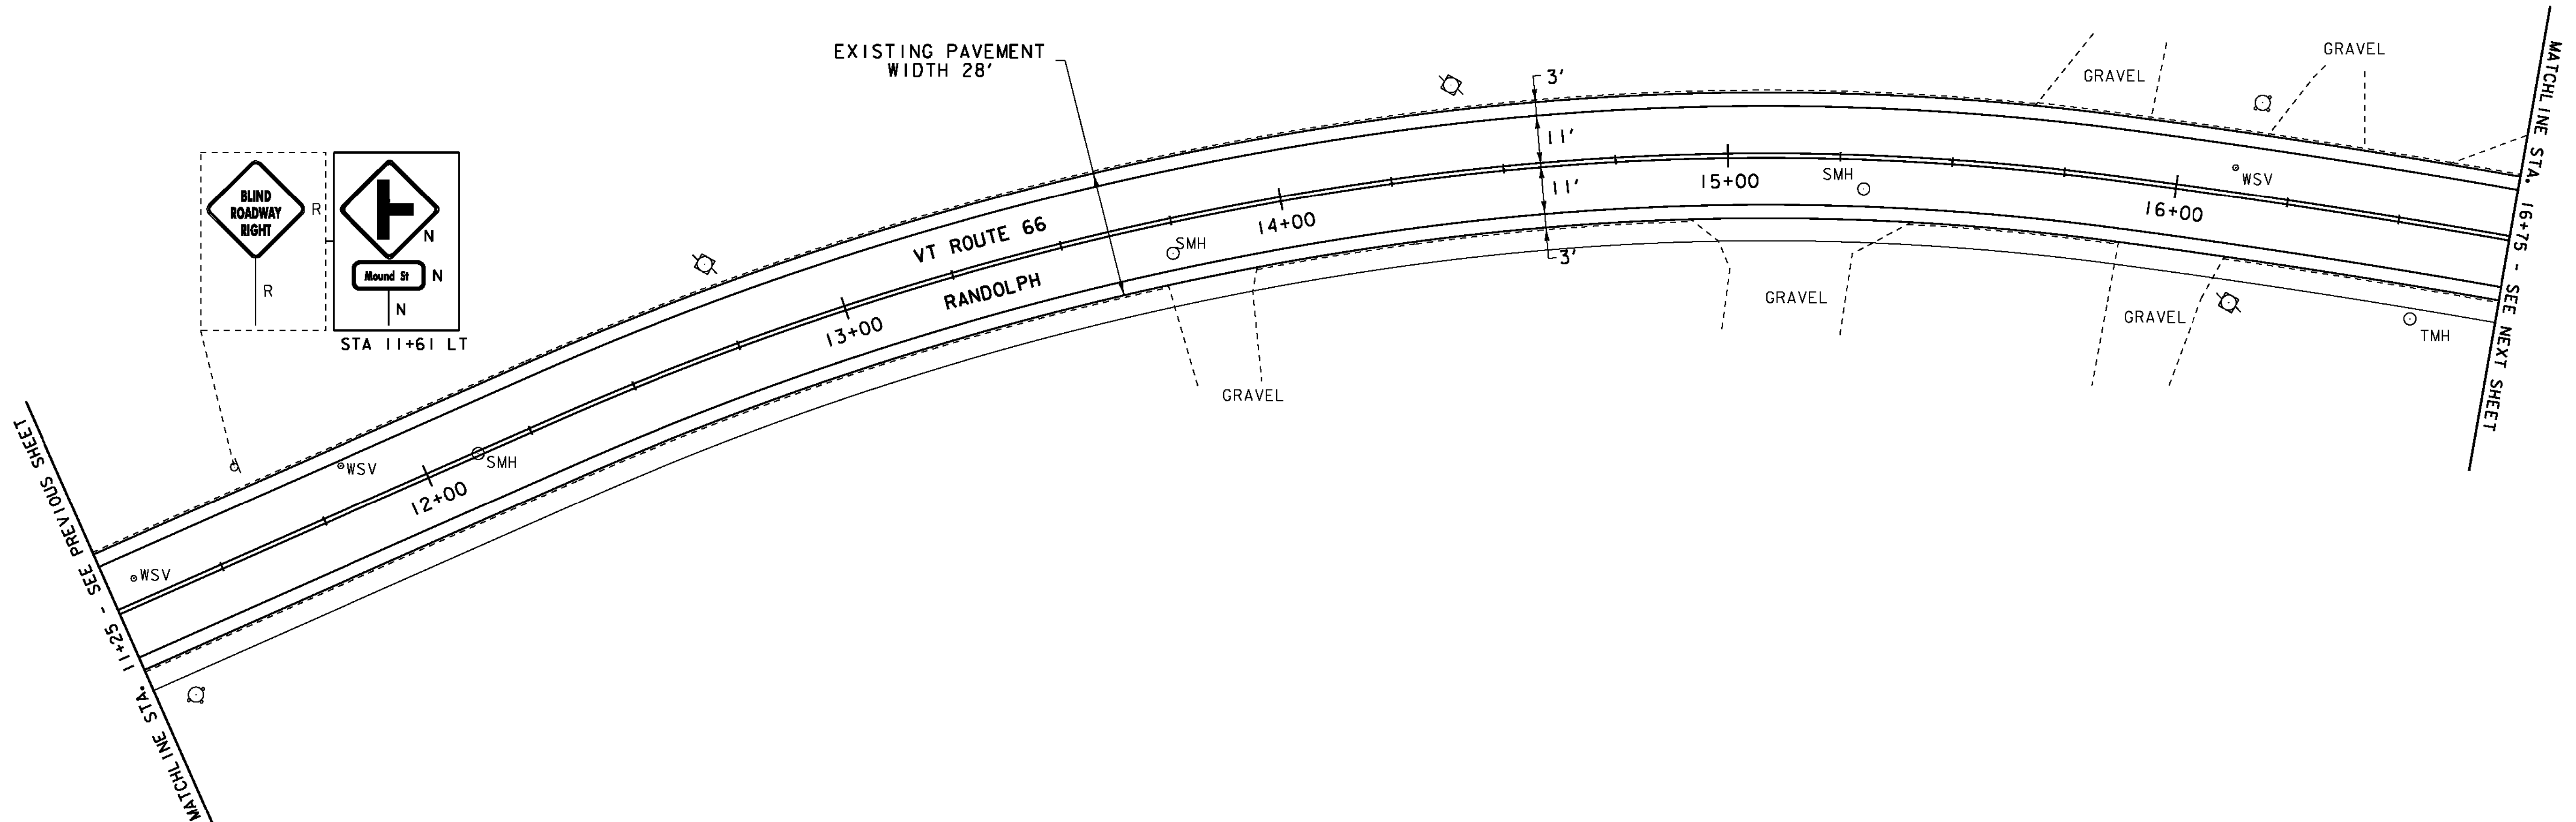

- LEGEND**
- SIGN
 - HYDRANT
 - MANHOLE
 - VALVE
 - GAS PIPELINE MARKER
 - CATCH BASIN / DROP INLET
 - CURB INLET
 - TRAFFIC CONTROL BOX
 - PARKING METER
 - UTILITY POLE
 - DETECTABLE WARNINGS
 - LIGHT POLE
 - EX. DETECTABLE WARNINGS
 - JUNCTION BOX
 - PED BUTTON
 - ELECTRICAL BOX
 - SIGNAL
 - PEDESTAL POST
 - STRAIN POLE
 - CAMERA
 - V DZ VIDEO DETECTION ZONE

- SIGN LEGEND**
- R = REMOVE
 - R&S = REMOVE AND SALVAGE
 - RET = RETAIN
 - S = SALVAGE
 - N = NEW
 - B-B = BACK TO BACK

NOT TO SCALE

PROJECT LAYOUT SHEET 32	PROJECT NAME: BETHEL-NORTHFIELD	PLOT DATE: 1/3/13
	PROJECT NUMBER: STP 2922(I)	DRAWN BY: JBG
	FILE NAME: p10C246.dgn	CHECKED BY: CDL
	DESIGNED BY: SJL	SHEET 51 OF 149
	PLOT FILE: p10C246_51.i	