

REHAB, DROP INLETS, CATCH BASINS, OR MANHOLES, CLASS I OR CLASS II  
 STA. 17+89 RT ✓ STA. 19+25 RT ✓ STA. 17+75 LT  
 STA. 18+43 RT ✓ STA. 20+50 RT ✓ STA. 20+50 LT

CHANGING ELEVATION OF SEWER MANHOLES  
 STA. 17+08 CL ✓ STA. 21+48 RT (NOT ON PLANS)  
 STA. 18+52 RT ✓  
 STA. 20+25 RT ✓

CHANGING ELEVATION OF DROP INLETS, CATCH BASINS, OR MANHOLES  
 STA. 21+93 LT "DMH" ✓

ADJUST ELEVATION OF VALVE BOX  
 STA. 18+15 LT "WSV"  
 STA. 18+21 LT "WSV"  
 STA. 21+20 LT "WSV"

DETECTABLE WARNING SURFACES  
 STA. 18+07 RT (8 SF) ✓  
 STA. 18+34 RT (8 SF) ✓

DURABLE 4 INCH WHITE LINE, TYPE I TAPE  
 STA. 16+75 - STA. 22+51 (SOLID LT & RT)  
 (WITH BREAKS AT SIDE ROADS)

DURABLE 4 INCH YELLOW LINE, TYPE I TAPE  
 STA. 16+75 - STA. 22+51 (SOLID LT & RT)  
 (WITH BREAKS AT SIDE ROADS)


TEMPORARY 4 INCH WHITE LINE, PAINT  
 STA. 16+75 - STA. 22+51 (SOLID LT & RT)

TEMPORARY 4 INCH YELLOW LINE, PAINT  
 STA. 16+75 - STA. 22+51 (SOLID LT & RT)

REMOVING SIGNS  
 AS SHOWN - 10

DURABLE CROSSWALK MARKING, TYPE I TAPE  
 STA. 18+07 - STA. 18+34 RT

TEMPORARY CROSSWALK MARKING, PAINT  
 STA. 18+07 - STA. 18+34 RT

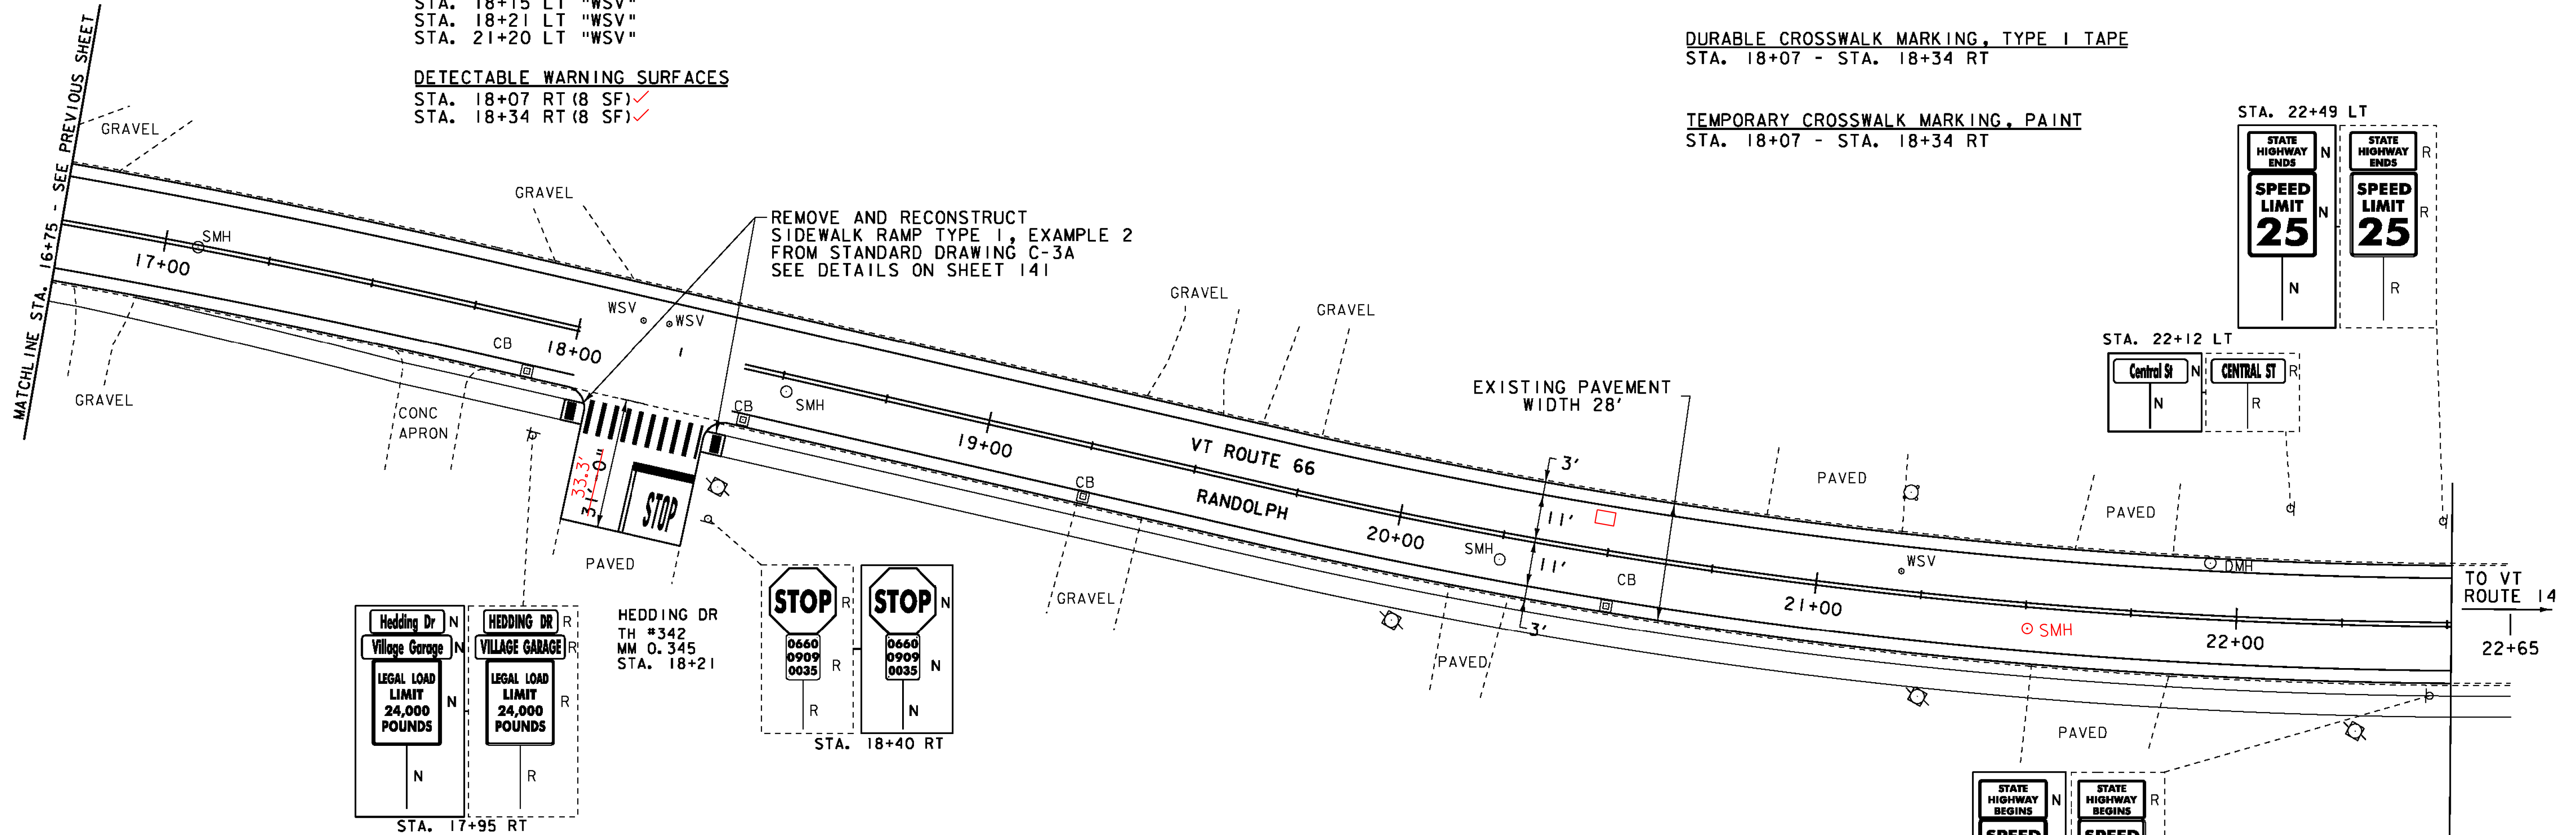

COMMON EXCAVATION  
 STA. 18+01 - STA. 18+06 RT  
 STA. 18+35 - STA. 18+40 RT

PORTLAND CEMENT CONCRETE SIDEWALK, 5 INCH  
 STA. 18+01 - STA. 18+06 RT ✓  
 STA. 18+35 - STA. 18+40 RT ✓

SUBBASE OF CRUSHED GRAVEL, FINE GRADED  
 STA. 18+01 - STA. 18+06 RT  
 STA. 18+35 - STA. 18+40 RT

DURABLE 24 INCH STOP BAR, TYPE I TAPE  
 STA. 18+23 - STA. 18+34 RT

TEMPORARY 24 INCH STOP BAR, PAINT  
 STA. 18+23 - STA. 18+34 RT

DURABLE LETTER OR SYMBOL, TYPE I TAPE  
 STA. 18+29 RT "STOP"

TEMPORARY LETTER OR SYMBOL, PAINT  
 STA. 18+29 RT "STOP"

**LEGEND**

- SIGN
- HYDRANT
- MANHOLE
- VALVE
- GAS PIPELINE MARKER
- CATCH BASIN / DROP INLET
- CURB INLET
- ⊠ TRAFFIC CONTROL BOX
- ⊠ PARKING METER
- ⊠ UTILITY POLE
- DETECTABLE WARNINGS
- LIGHT POLE
- EX. DETECTABLE WARNINGS
- JUNCTION BOX
- ⊠ PED BUTTON
- ⊠ ELECTRICAL BOX
- ⊠ SIGNAL
- ⊠ PEDESTAL POST
- ⊠ STRAIN POLE
- ⊠ CAMERA
- VDZ VIDEO DETECTION ZONE

**SIGN LEGEND**

- R = REMOVE
- R&S = REMOVE AND SALVAGE
- RET = RETAIN
- S = SALVAGE
- N = NEW
- B-B = BACK TO BACK

**PROJECT LAYOUT SHEET 33**

NOT TO SCALE

PROJECT NAME: BETHEL-NORTHFIELD  
 PROJECT NUMBER: STP 2922(1)

FILE NAME: piOC246.dgn  
 PROJECT LEADER: CDL  
 DESIGNED BY: SJL  
 PLOT FILE: piOC246\_52.1

PLOT DATE: 1/31/13  
 DRAWN BY: JBG  
 CHECKED BY: CDL  
 SHEET 52 OF 149