


DURABLE 4 INCH WHITE LINE, TYPE I TAPE
 STA. 219+75 - STA. 225+50 (SOLID LT & RT)

TEMPORARY 4 INCH WHITE LINE, PAINT
 STA. 219+75 - STA. 225+50 (SOLID LT & RT)

DURABLE 4 INCH YELLOW LINE, TYPE I TAPE
 STA. 219+75 - STA. 225+50 (SOLID LT & RT)

TEMPORARY 4 INCH YELLOW LINE, PAINT
 STA. 219+75 - STA. 225+50 (SOLID LT & RT)

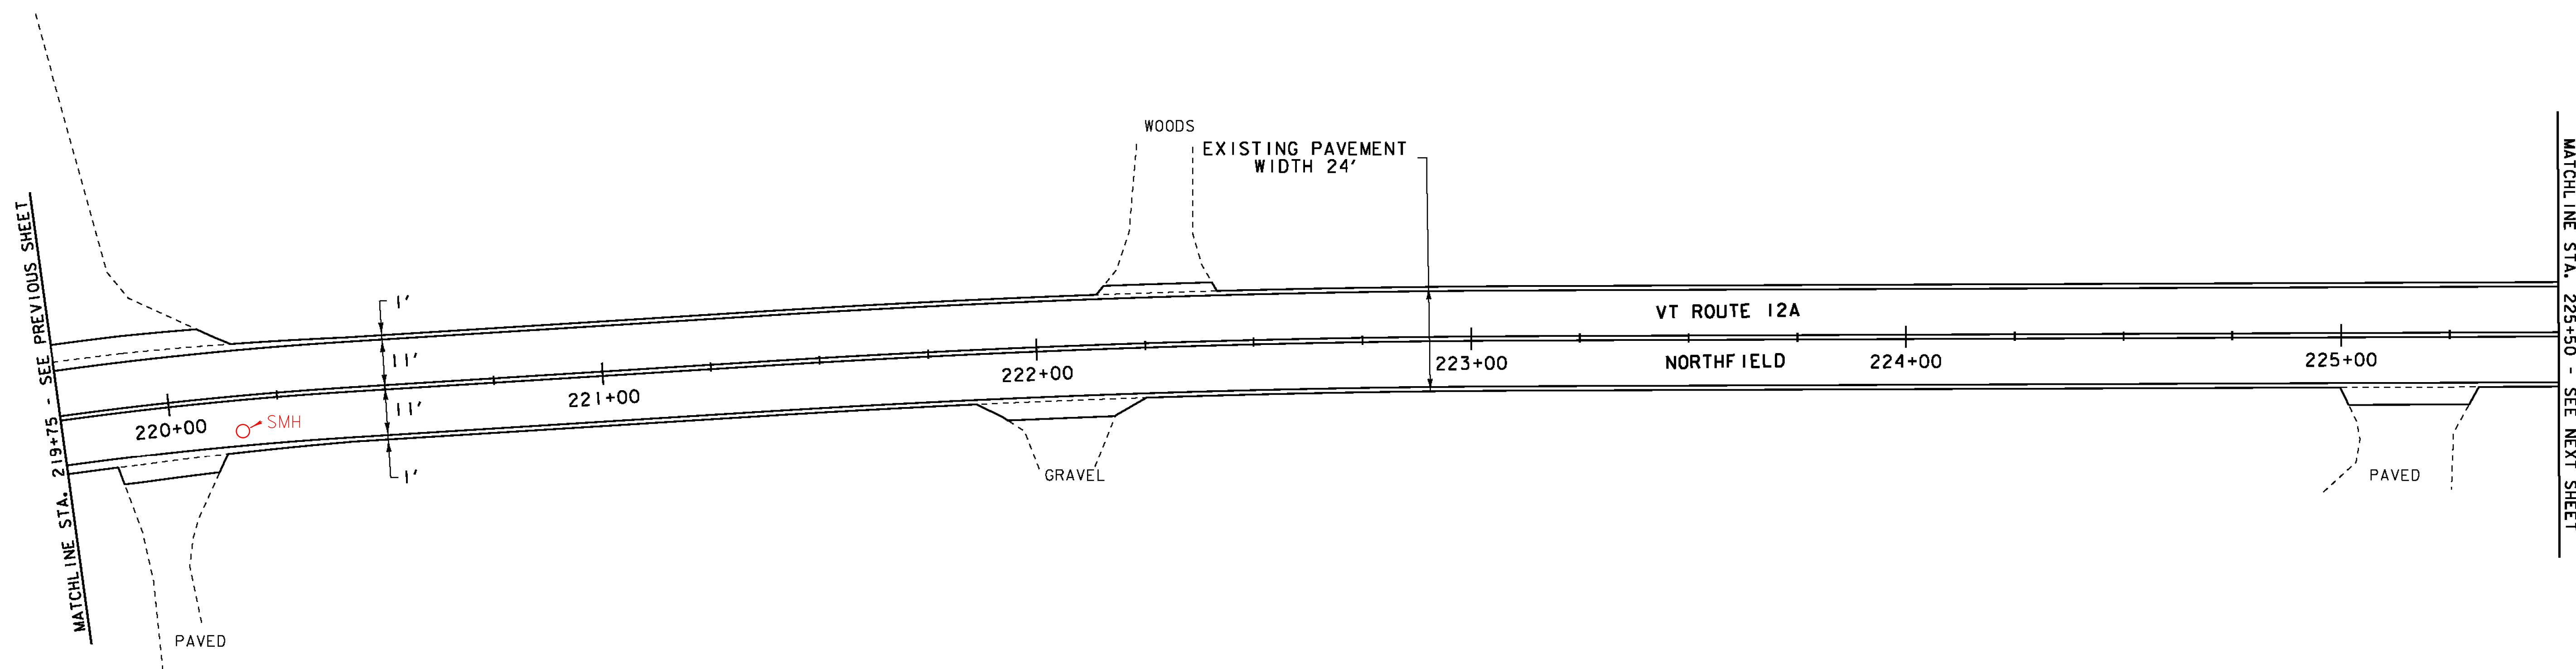

- LEGEND**
- SIGN
 - HYDRANT
 - MANHOLE
 - VALVE
 - GAS PIPELINE MARKER
 - CATCH BASIN / DROP INLET
 - CURB INLET
 - ⊠ TRAFFIC CONTROL BOX
 - ⊠ PARKING METER
 - ⊠ UTILITY POLE
 - DETECTABLE WARNINGS
 - LIGHT POLE
 - EX. DETECTABLE WARNINGS
 - JUNCTION BOX
 - ⊠ PED BUTTON
 - ⊠ ELECTRICAL BOX
 - ⊠ SIGNAL
 - ⊠ PEDESTAL POST
 - ⊠ STRAIN POLE
 - CAMERA
 - VDZ VIDEO DETECTION ZONE

- SIGN LEGEND**
- R = REMOVE
 - R&S = REMOVE AND SALVAGE
 - RET = RETAIN
 - S = SALVAGE
 - N = NEW
 - B-B = BACK TO BACK

NOT TO SCALE

PROJECT LAYOUT SHEET 35	PROJECT NAME: BETHEL-NORTHFIELD	PLOT DATE: 1/3/13
	PROJECT NUMBER: STP 2922(I)	DRAWN BY: JBG
	FILE NAME: p10C246.dgn	CHECKED BY: CDL
	DESIGNED BY: SJL	SHEET 54 OF 149
	PLOT FILE: p10C246_54.I	