

REHAB. DROP INLETS, CATCH
BASINS, OR MANHOLES, CLASS I OR CLASS II
STA. 167+48 LT (NOT IN PAVED AREA)
STA. 168+25 RT


ADJUST ELEVATION OF VALVE BOX
STA. 168+23 RT "WSV"
STA. 168+25 RT "WSV"
STA. 168+25 RT "WSV"
STA. 170+20 RT "WSV"

DURABLE 4 INCH WHITE LINE, TYPE I TAPE
STA. 167+25 - STA. 171+75 (SOLID LT & RT)
(WITH BREAKS AT SIDE ROADS)
STA. 168+42 RT (EDGELINES TH #71)
DURABLE 4 INCH YELLOW LINE, TYPE I TAPE
STA. 167+25 - STA. 171+75 (SOLID LT & RT)
(WITH BREAKS AT SIDE ROADS)
STA. 168+42 RT (CENTERLINE TH #71)
TEMPORARY 4 INCH WHITE LINE, PAINT
STA. 167+25 - STA. 171+75 (SOLID LT & RT)
(WITH BREAKS AT SIDE ROADS)
STA. 168+42 RT (EDGELINES TH #71)
TEMPORARY 4 INCH YELLOW LINE, PAINT
STA. 167+25 - STA. 171+75 (SOLID LT & RT)
(WITH BREAKS AT SIDE ROADS)
STA. 168+42 RT (CENTERLINE TH #71)

DURABLE LETTER OR SYMBOL, TYPE I TAPE
STA. 168+48 RT "STOP"
STA. 170+41 LT "STOP"
STA. 170+97 LT "STOP"

TEMPORARY LETTER OR SYMBOL, PAINT
STA. 168+48 RT "STOP"
STA. 170+41 LT "STOP"
STA. 170+97 LT "STOP"

REMOVING SIGNS
AS SHOWN - 12

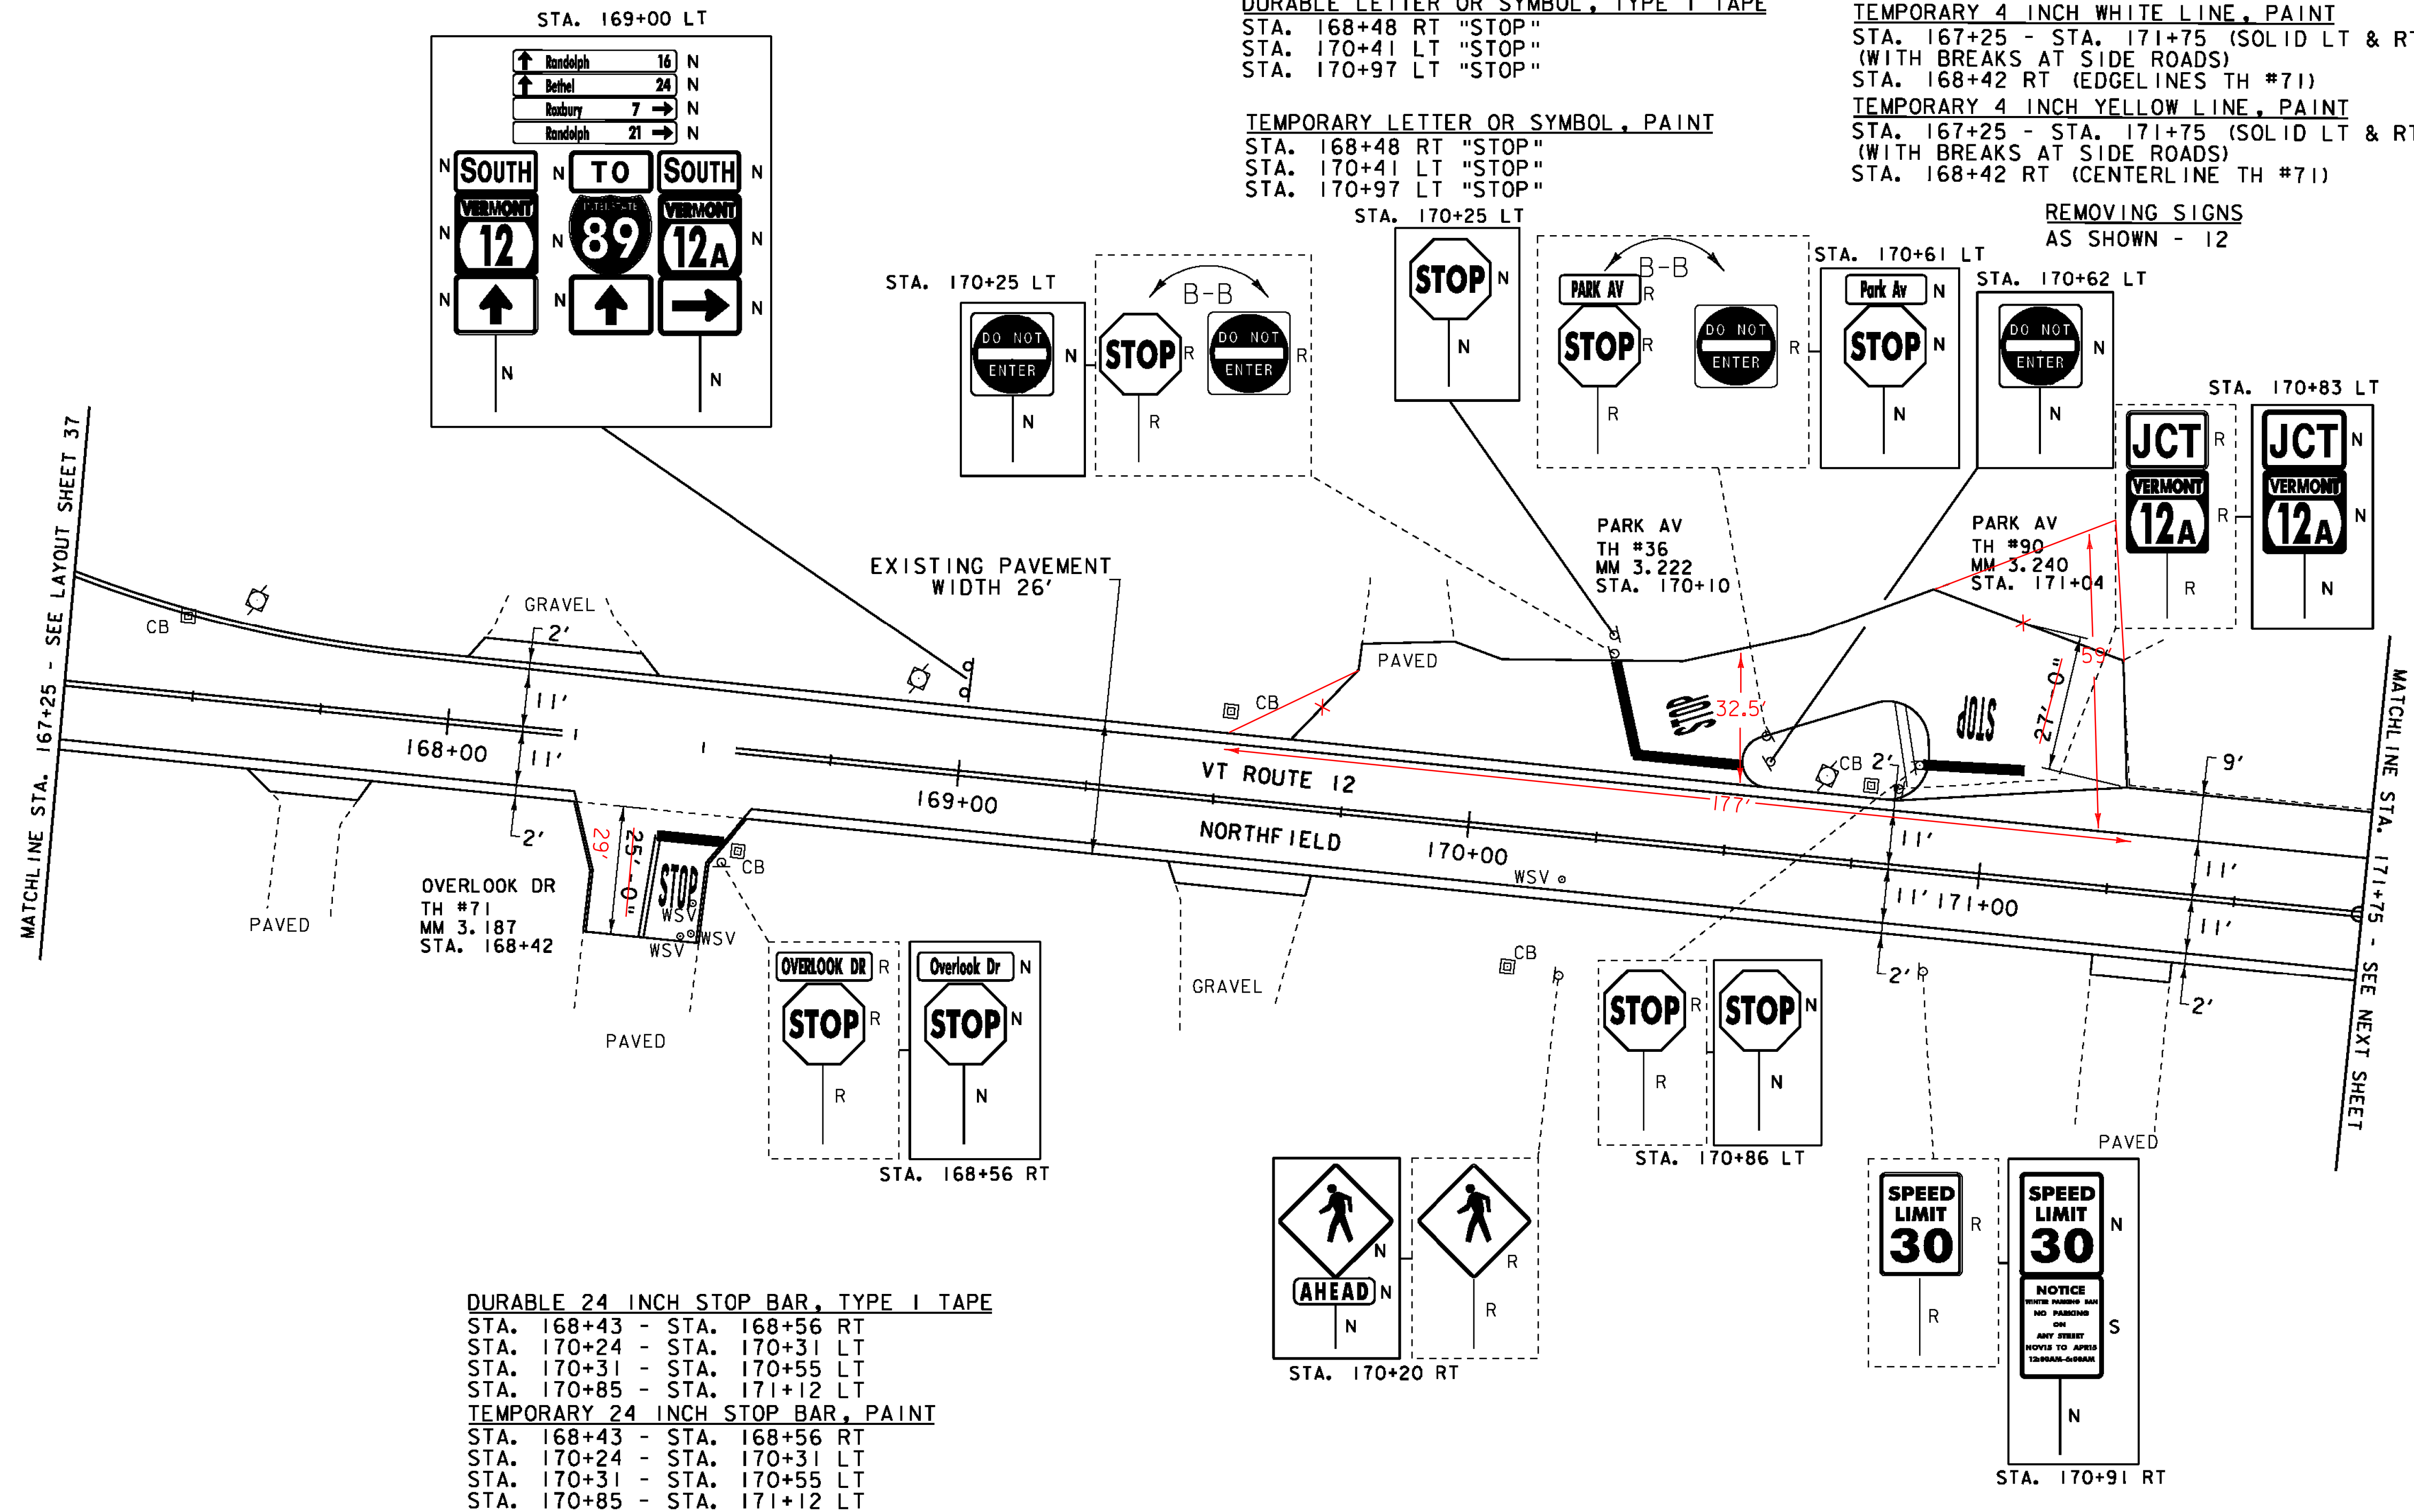

DURABLE 24 INCH STOP BAR, TYPE I TAPE
STA. 168+43 - STA. 168+56 RT
STA. 170+24 - STA. 170+31 LT
STA. 170+31 - STA. 170+55 LT
STA. 170+85 - STA. 171+12 LT
TEMPORARY 24 INCH STOP BAR, PAINT
STA. 168+43 - STA. 168+56 RT
STA. 170+24 - STA. 170+31 LT
STA. 170+31 - STA. 170+55 LT
STA. 170+85 - STA. 171+12 LT

LEGEND

- SIGN
- HYDRANT
- MANHOLE
- VALVE
- GAS PIPELINE MARKER
- CATCH BASIN / DROP INLET
- CURB INLET
- ⊠ TRAFFIC CONTROL BOX
- ⊠ PARKING METER
- ⊠ UTILITY POLE
- DETECTABLE WARNINGS
- LIGHT POLE
- EX. DETECTABLE WARNINGS
- JUNCTION BOX
- ⊠ PED BUTTON
- ⊠ ELECTRICAL BOX
- ⊠ SIGNAL
- ⊠ PEDESTAL POST
- ⊠ STRAIN POLE
- ⊠ CAMERA
- VDZ VIDEO DETECTION ZONE

SIGN LEGEND

- R = REMOVE
- R&S = REMOVE AND SALVAGE
- RET = RETAIN
- S = SALVAGE
- N = NEW
- B-B = BACK TO BACK

PROJECT LAYOUT SHEET 39

NOT TO SCALE

PROJECT NAME: BETHEL-NORTHFIELD
PROJECT NUMBER: STP 2922(I)

FILE NAME: piOC246.dgn
PROJECT LEADER: CDL
DESIGNED BY: SJL
PLOT FILE: piOC246_58.I

PLOT DATE: 1/3/13
DRAWN BY: JBG
CHECKED BY: CDL
SHEET 58 OF 149