

ADJUST ELEVATION OF VALVE BOX

STA. 172+20 RT "WSV"
 STA. 173+85 RT "WSV"
 STA. 173+90 RT "WSV"
 STA. 173+97 RT "WSV"
 STA. 174+05 RT "WSV"

CHANGE ELEVATION SEWER MAN HOLES

STA. 175+50 RT

DURABLE 4 INCH WHITE LINE, TYPE I TAPE

STA. 171+75 - STA. 177+50 (SOLID LT & RT)
 (WITH BREAKS AT SIDE ROADS)
 STA. 175+34 RT (EDGELINES TH #42)

DURABLE 4 INCH YELLOW LINE, TYPE I TAPE

STA. 171+75 - STA. 177+50 (SOLID LT & RT)
 (WITH BREAKS AT SIDEROADS)
 STA. 172+29 RT (CENTERLINE TH #92)
 STA. 175+34 RT (CENTERLINE TH #42)

TEMPORARY 4 INCH WHITE LINE, PAINT

STA. 171+75 - STA. 177+50 (SOLID LT & RT)
 (WITH BREAKS AT SIDE ROADS)
 STA. 175+34 RT (EDGELINES TH #42)

TEMPORARY 4 INCH YELLOW LINE, PAINT

STA. 171+75 - STA. 177+50 (SOLID LT & RT)
 (WITH BREAKS AT SIDEROADS)
 STA. 172+29 RT (CENTERLINE TH #92)
 STA. 175+34 RT (CENTERLINE TH #42)

DURABLE 24 INCH STOP BAR, TYPE I TAPE

STA. 172+30 - STA. 172+41 RT
 STA. 175+36 - STA. 175+61 RT

TEMPORARY 24 INCH STOP BAR, PAINT

STA. 172+30 - STA. 172+41 RT
 STA. 175+36 - STA. 175+61 RT

DURABLE LETTER OR SYMBOL, TYPE I TAPE


STA. 172+36 RT "STOP"
 STA. 175+42 RT "STOP"

TEMPORARY LETTER OR SYMBOL, PAINT

STA. 172+36 RT "STOP"
 STA. 175+42 RT "STOP"

REMOVING SIGNS

AS SHOWN - 10

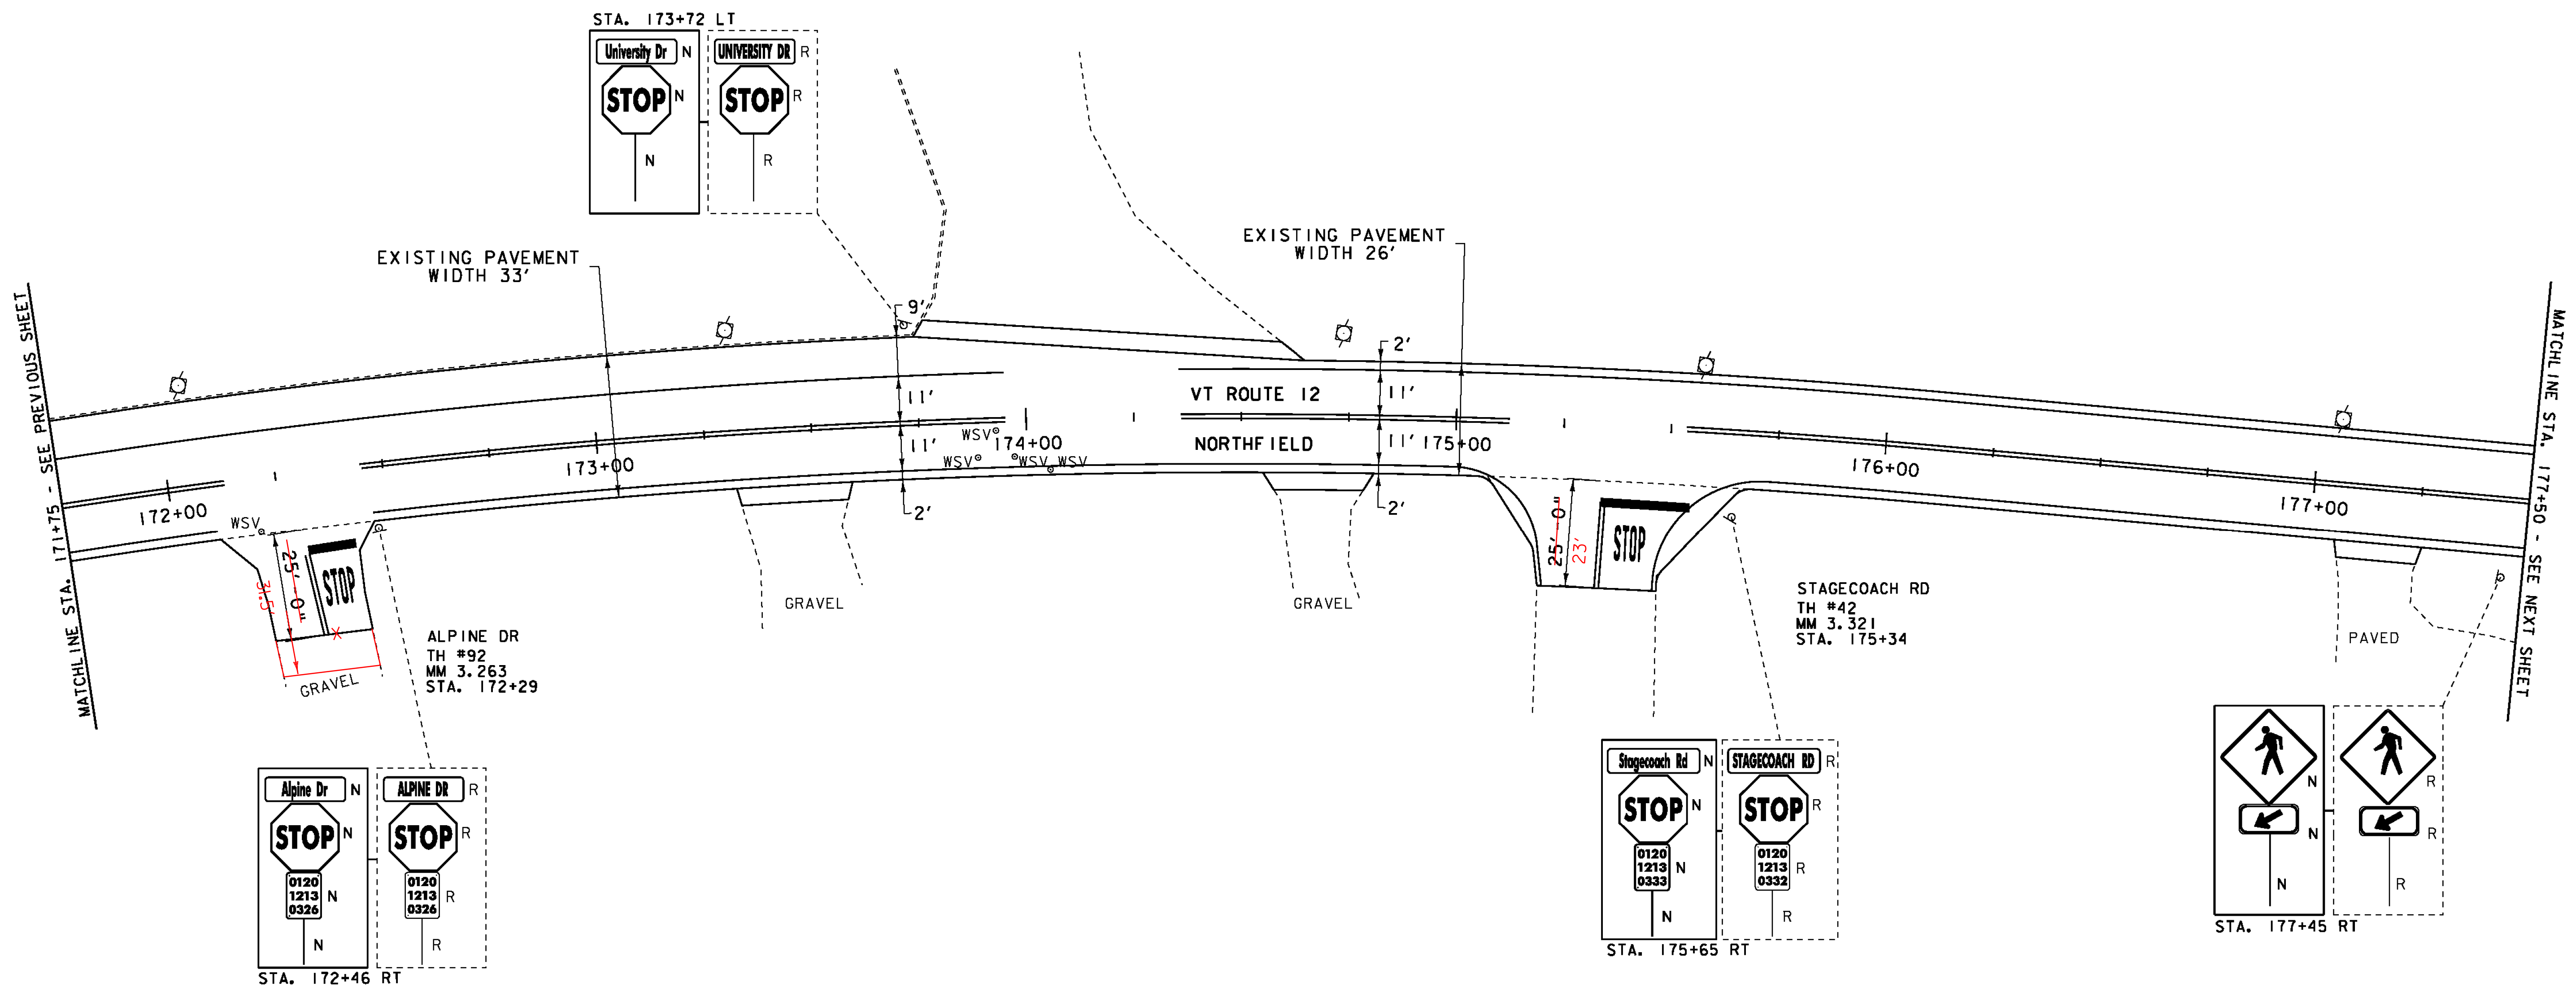

- LEGEND**
- SIGN
 - HYDRANT
 - MANHOLE
 - VALVE
 - GAS PIPELINE MARKER
 - CATCH BASIN / DROP INLET
 - CURB INLET
 - TRAFFIC CONTROL BOX
 - PARKING METER
 - UTILITY POLE
 - DETECTABLE WARNINGS
 - LIGHT POLE
 - EX. DETECTABLE WARNINGS
 - JUNCTION BOX
 - PED BUTTON
 - ELECTRICAL BOX
 - SIGNAL
 - PEDESTAL POST
 - STRAIN POLE
 - CAMERA
 - VIDEO DETECTION ZONE

- SIGN LEGEND**
- R = REMOVE
 - R&S = REMOVE AND SALVAGE
 - RET = RETAIN
 - S = SALVAGE
 - N = NEW
 - B-B = BACK TO BACK

PROJECT LAYOUT SHEET 40	PROJECT NAME: BETHEL-NORTHFIELD	PLOT DATE: 1/3/13
	PROJECT NUMBER: STP 2922(I)	DRAWN BY: JBG
	FILE NAME: piOC246.dgn	CHECKED BY: CDL
DESIGNED BY: SJL	PLOT FILE: piOC246_59.1	SHEET 59 OF 149

NOT TO SCALE