

ADJUST ELEVATION OF VALVE BOX
 STA. 184+36 RT "WSV"

CHANGING ELEVATION OF SEWER MANHOLES
 STA. ~~184+67 RT~~ 148+67 RT
 STA. 187+57 CL ✓

DURABLE 4 INCH WHITE LINE, TYPE I TAPE
 STA. 183+75 - STA. 189+25 (SOLID LT & RT)

DURABLE 4 INCH YELLOW LINE, TYPE I TAPE
 STA. 183+75 - STA. 189+25 (SOLID LT & RT)


TEMPORARY 4 INCH WHITE LINE, PAINT
 STA. 183+75 - STA. 189+25 (SOLID LT & RT)

TEMPORARY 4 INCH YELLOW LINE, PAINT
 STA. 183+75 - STA. 189+25 (SOLID LT & RT)

DURABLE 24 INCH STOP BAR, TYPE I TAPE
 STA. 185+71 - STA. 185+83 RT

TEMPORARY 24 INCH STOP BAR, PAINT
 STA. 185+71 - STA. 185+83 RT

REMOVING SIGNS
 AS SHOWN - 4

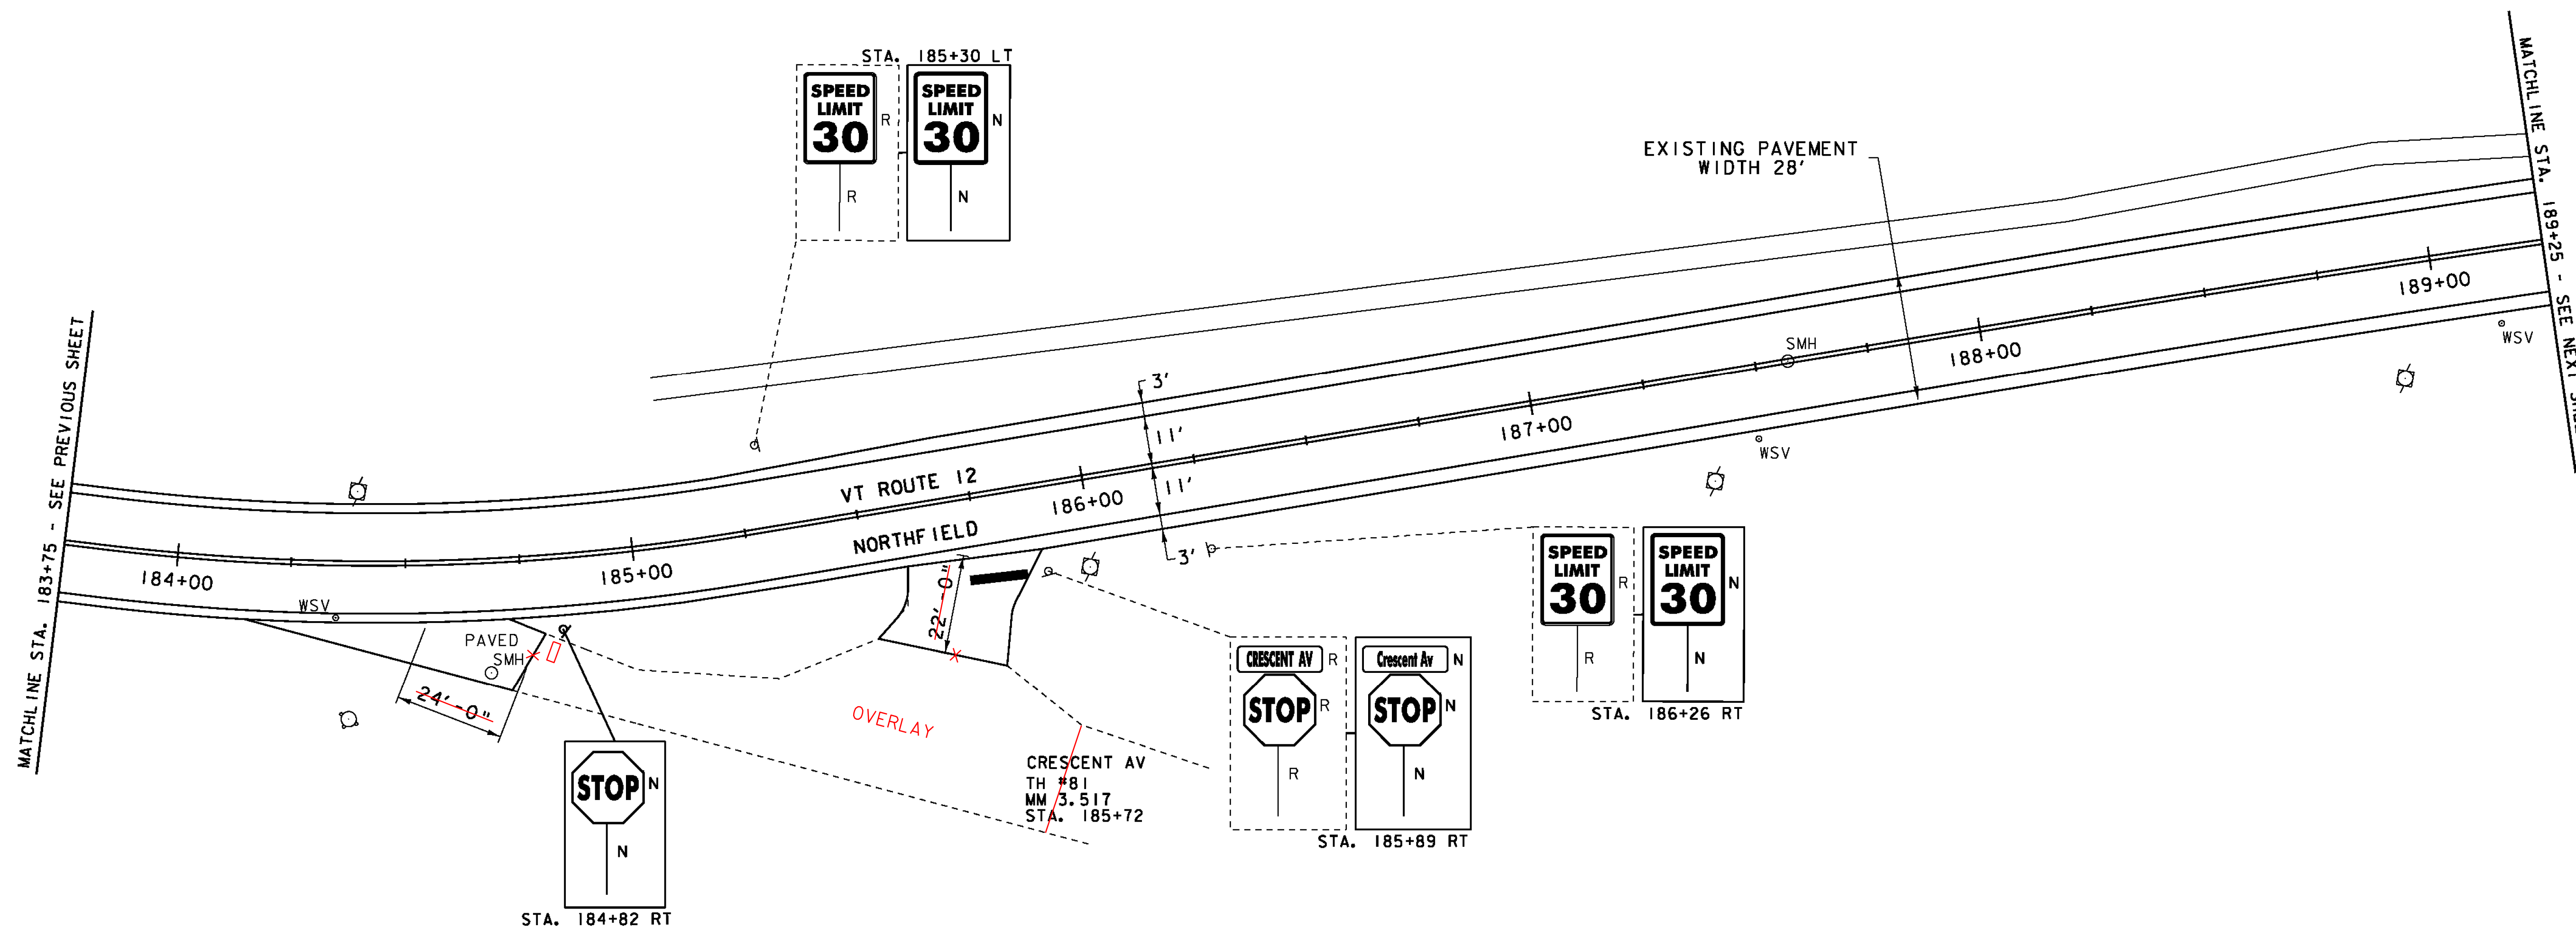

- LEGEND**
- SIGN
 - HYDRANT
 - MANHOLE
 - VALVE
 - GAS PIPELINE MARKER
 - CATCH BASIN / DROP INLET
 - CURB INLET
 - TRAFFIC CONTROL BOX
 - PARKING METER
 - UTILITY POLE
 - DETECTABLE WARNINGS

- LIGHT POLE
- EX. DETECTABLE WARNINGS
- JUNCTION BOX
- PED BUTTON
- ELECTRICAL BOX
- SIGNAL
- PEDESTAL POST
- STRAIN POLE
- CAMERA
- V D Z VIDEO DETECTION ZONE

- SIGN LEGEND**
- R = REMOVE
 - R&S = REMOVE AND SALVAGE
 - RET = RETAIN
 - S = SALVAGE
 - N = NEW
 - B-B = BACK TO BACK

NOT TO SCALE

PROJECT LAYOUT SHEET 42	PROJECT NAME: BETHEL-NORTHFIELD	PLOT DATE: 1/3/13
	PROJECT NUMBER: STP 2922(I)	DRAWN BY: JBG
	FILE NAME: p10C246.dgn	CHECKED BY: CDL
	DESIGNED BY: SJL	SHEET 61 OF 149
	PLOT FILE: p10C246_61.i	