

CHANGE DI, CB OR MANHOLES
STA. 226+40 RT

REHAB. DROP INLETS, CATCH
BASINS, OR MANHOLES, CLASS I OR CLASS II
STA. 228+07 RT ✓ STA. 231+27 RT ✓
STA. 228+09 LT ✓ STA. 231+27 LT ✓
STA. 229+57 LT ✓ STA. 232+39 LT ✓
STA. 229+59 RT ✓ STA. 232+41 RT ✓

CHANGING ELEVATION OF SEWER MANHOLES
STA. 232+04 LT ✓

ADJUST ELEVATION OF VALVE BOX
STA. 229+05 LT
STA. 231+83 LT

DETECTABLE WARNING SURFACES
STA. 227+80 LT (+2-SF) (8 SF) ✓
STA. 227+82 RT (8 SF) ✓
STA. 231+33 LT (8 SF) ✓
STA. 231+34 RT (8 SF) ✓
STA. 231+48 LT (8 SF) ✓ 231+84
STA. 232+16 LT (8 SF) ✓
(LISTED AS 232+05)

COMMON EXCAVATION
STA. 227+76 - STA. 227+85 LT ✓
STA. 227+74 - STA. 227+79 RT ✓
STA. 231+29 - STA. 231+36 LT ✓
STA. 231+32 - STA. 231+38 RT ✓
STA. 231+44 - STA. 231+51 LT ✓
STA. 232+12 - STA. 232+19 LT ✓

PORTLAND CEMENT CONCRETE SIDEWALK, 5 INCH
STA. 227+76 - STA. 227+85 LT
STA. 227+74 - STA. 227+79 RT
STA. 231+29 - STA. 231+36 LT
STA. 231+32 - STA. 231+38 RT
STA. 231+44 - STA. 231+51 LT
STA. 232+12 - STA. 232+19 LT

SUBBASE OF CRUSHED GRAVEL, FINE GRADED
STA. 227+76 - STA. 227+85 LT
STA. 227+74 - STA. 227+79 RT
STA. 231+29 - STA. 231+36 LT
STA. 231+32 - STA. 231+38 RT
STA. 231+44 - STA. 231+51 LT
STA. 232+12 - STA. 232+19 LT

REMOVING AND RESETTING CURB
STA. 227+75 - STA. 227+92 LT
STA. 227+75 - STA. 227+94 RT
STA. 231+20 - STA. 231+57 LT
STA. 232+05 - STA. 232+28 LT

ERECTING SALVAGED SIGNS
AS SHOWN - 2

REMOVING SIGNS
AS SHOWN - 12

DURABLE 4 INCH WHITE LINE, TYPE I TAPE

STA. 227+87 - STA. 231+25 (SOLID RT)
STA. 227+87 - STA. 232+23 (SOLID LT)
(WITH BREAKS AT SIDEROADS & CROSSWALKS)
STA. 231+78 LT (EDGE LINES VINE ST)
STA. 232+22 - STA. 233+50 (SOLID RT)
STA. 232+23 - STA. 233+50 (SOLID LT)

TEMPORARY 4 INCH WHITE LINE, PAINT
STA. 227+87 - STA. 231+25 (SOLID RT)
STA. 227+87 - STA. 232+23 (SOLID LT)
(WITH BREAKS AT SIDEROADS & CROSSWALKS)
STA. 231+78 LT (EDGE LINES VINE ST)
STA. 232+22 - STA. 233+50 (SOLID RT)
STA. 232+23 - STA. 233+50 (SOLID LT)

DURABLE 8 INCH WHITE LINE, TYPE I TAPE

STA. 227+87 - STA. 228+11 (HATCH LT)
STA. 230+92 - STA. 231+25 (HATCH LT)
STA. 232+22 - STA. 233+01 (HATCH RT)

DURABLE 4 INCH YELLOW LINE, TYPE I TAPE


STA. 227+75 - STA. 233+50 (SOLID LT & RT)
(WITH BREAKS AT SIDEROADS & CROSSWALKS)
STA. 231+78 LT (CENTERLINE VINE ST)

TEMPORARY 4 INCH YELLOW LINE, PAINT

STA. 227+75 - STA. 233+50 (SOLID LT & RT)
(WITH BREAKS AT SIDEROADS & CROSSWALKS)
STA. 231+78 LT (CENTERLINE VINE ST)

TEMPORARY 8 INCH WHITE LINE, PAINT

STA. 227+87 - STA. 228+11 (HATCH LT)
STA. 230+92 - STA. 231+25 (HATCH LT)
STA. 232+22 - STA. 233+01 (HATCH RT)

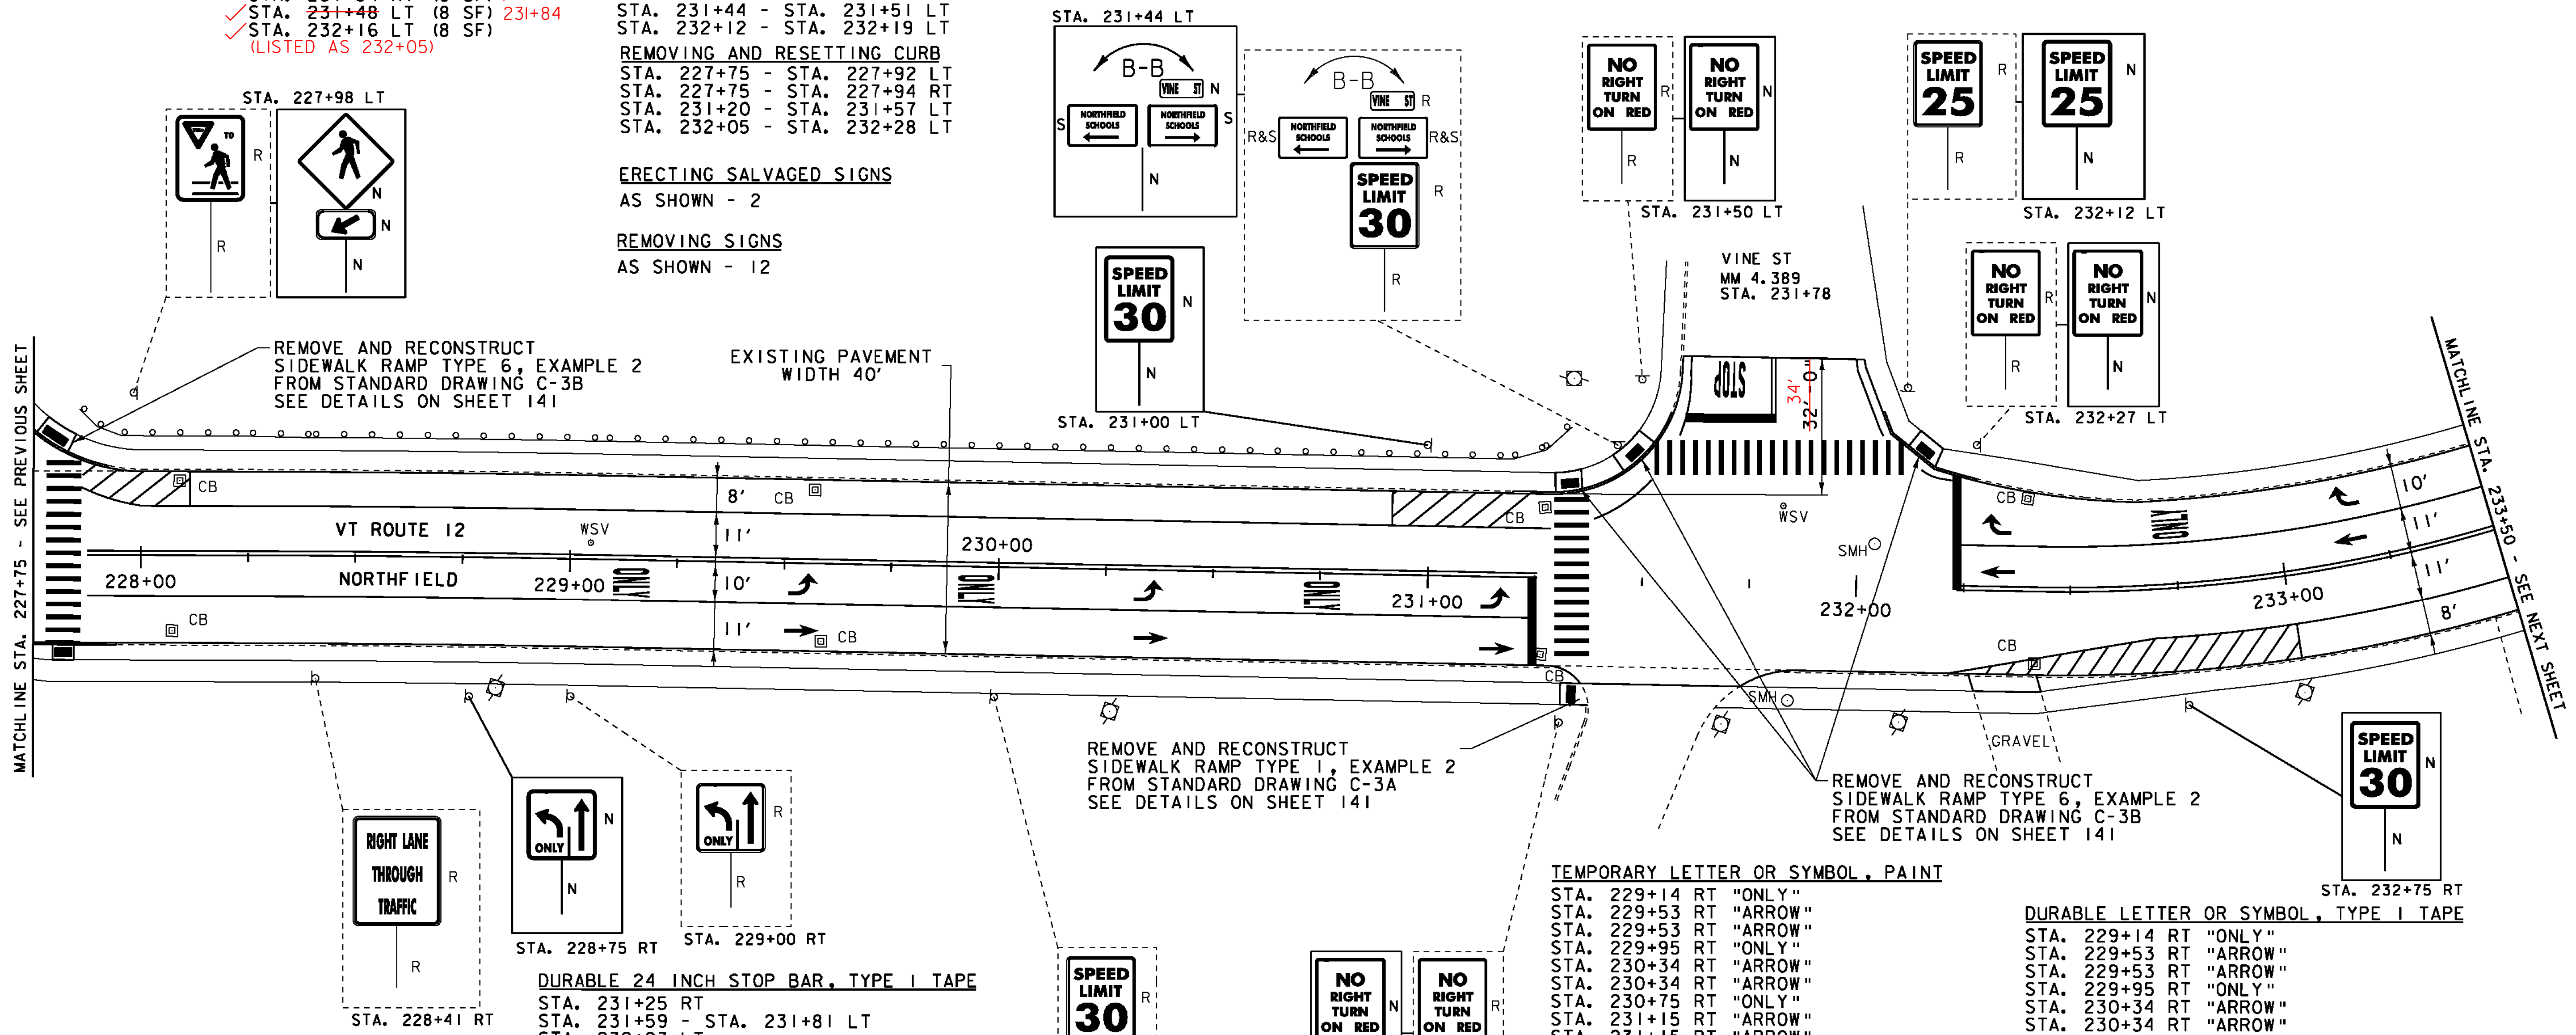

LEGEND

- SIGN
- HYDRANT
- MANHOLE
- VALVE
- GAS PIPELINE MARKER
- CATCH BASIN / DROP INLET
- CURB INLET
- ⊠ TRAFFIC CONTROL BOX
- ⊠ PARKING METER
- ⊠ UTILITY POLE
- ⊠ PARKING METER
- LIGHT POLE
- EX. DETECTABLE WARNINGS
- JUNCTION BOX
- ⊠ PED BUTTON
- ⊠ ELECTRICAL BOX
- ⊠ SIGNAL
- ⊠ PEDESTAL POST
- ⊠ STRAIN POLE
- ⊠ CAMERA
- ⊠ VIDEO DETECTION ZONE

SIGN LEGEND

- R = REMOVE
- R&S = REMOVE AND SALVAGE
- RET = RETAIN
- S = SALVAGE
- N = NEW
- B-B = BACK TO BACK

TEMPORARY CROSSWALK MARKING, PAINT

STA. 227+82 LT & RT
STA. 231+34 LT & RT
STA. 231+52 - STA. 232+11 LT

DURABLE CROSSWALK MARKING, TYPE I TAPE

STA. 227+82 LT & RT
STA. 231+34 LT & RT
STA. 231+52 - STA. 232+11 LT

TEMPORARY LETTER OR SYMBOL, PAINT

STA. 229+14 RT "ONLY"
STA. 229+53 RT "ARROW"
STA. 229+53 RT "ARROW"
STA. 229+95 RT "ONLY"
STA. 230+34 RT "ARROW"
STA. 230+34 RT "ARROW"
STA. 230+75 RT "ONLY"
STA. 231+15 RT "ARROW"
STA. 231+15 RT "ARROW"
STA. 231+69 LT "STOP"
STA. 232+33 LT ARROW
STA. 232+33 LT ARROW
STA. 232+74 LT "ONLY"
STA. 233+16 LT ARROW
STA. 233+16 LT ARROW

DURABLE LETTER OR SYMBOL, TYPE I TAPE

STA. 229+14 RT "ONLY"
STA. 229+53 RT "ARROW"
STA. 229+53 RT "ARROW"
STA. 229+95 RT "ONLY"
STA. 230+34 RT "ARROW"
STA. 230+34 RT "ARROW"
STA. 230+75 RT "ONLY"
STA. 231+15 RT "ARROW"
STA. 231+15 RT "ARROW"
STA. 231+69 LT "STOP"
STA. 232+33 LT ARROW
STA. 232+33 LT ARROW
STA. 232+74 LT "ONLY"
STA. 233+16 LT ARROW
STA. 233+16 LT ARROW

PROJECT LAYOUT SHEET 50

PROJECT NAME: BETHEL-NORTHFIELD
PROJECT NUMBER: STP 2922(I)

FILE NAME: piOC246.dgn
PROJECT LEADER: CDL
DESIGNED BY: SJL
PLOT FILE: piOC246_69.1

PLOT DATE: 1/3/13
DRAWN BY: JBG
CHECKED BY: CDL
SHEET 69 OF 149

NOT TO SCALE