

REHAB. DROP INLETS, CATCH BASINS, OR MANHOLES, CLASS I OR CLASS II

- STA. 233+67 RT ✓
- STA. 234+43 LT ✓
- STA. 234+68 RT ✓
- STA. 236+46 LT ✓
- STA. 236+80 RT ✓
- STA. 238+13 RT ✓
- STA. 239+32 LT ✓

CHANGING ELEVATION OF SEWER MANHOLES

- STA. 234+30 LT ✓

ADJUST ELEVATION OF VALVE BOX

- STA. 234+41 CL
- STA. 234+42 LT
- STA. 235+56 LT
- STA. 236+18 RT
- STA. 239+07 RT

DURABLE 4 INCH WHITE LINE, TYPE I TAPE

- STA. 233+50 - STA. 234+48 (SOLID LT)
- STA. 233+50 - STA. 239+50 (SOLID RT)
- STA. 235+60 - STA. 239+50 (SOLID LT)

TEMPORARY 4 INCH WHITE LINE, PAINT

- STA. 233+50 - STA. 234+48 (SOLID LT)
- STA. 233+50 - STA. 239+50 (SOLID RT)
- STA. 235+60 - STA. 239+50 (SOLID LT)

DURABLE 4 INCH YELLOW LINE, TYPE I TAPE


- STA. 233+50 - STA. 239+50 (SOLID LT & RT)

TEMPORARY 4 INCH YELLOW LINE, PAINT

- STA. 233+50 - STA. 239+50 (SOLID LT & RT)

REMOVING SIGNS

AS SHOWN - 3

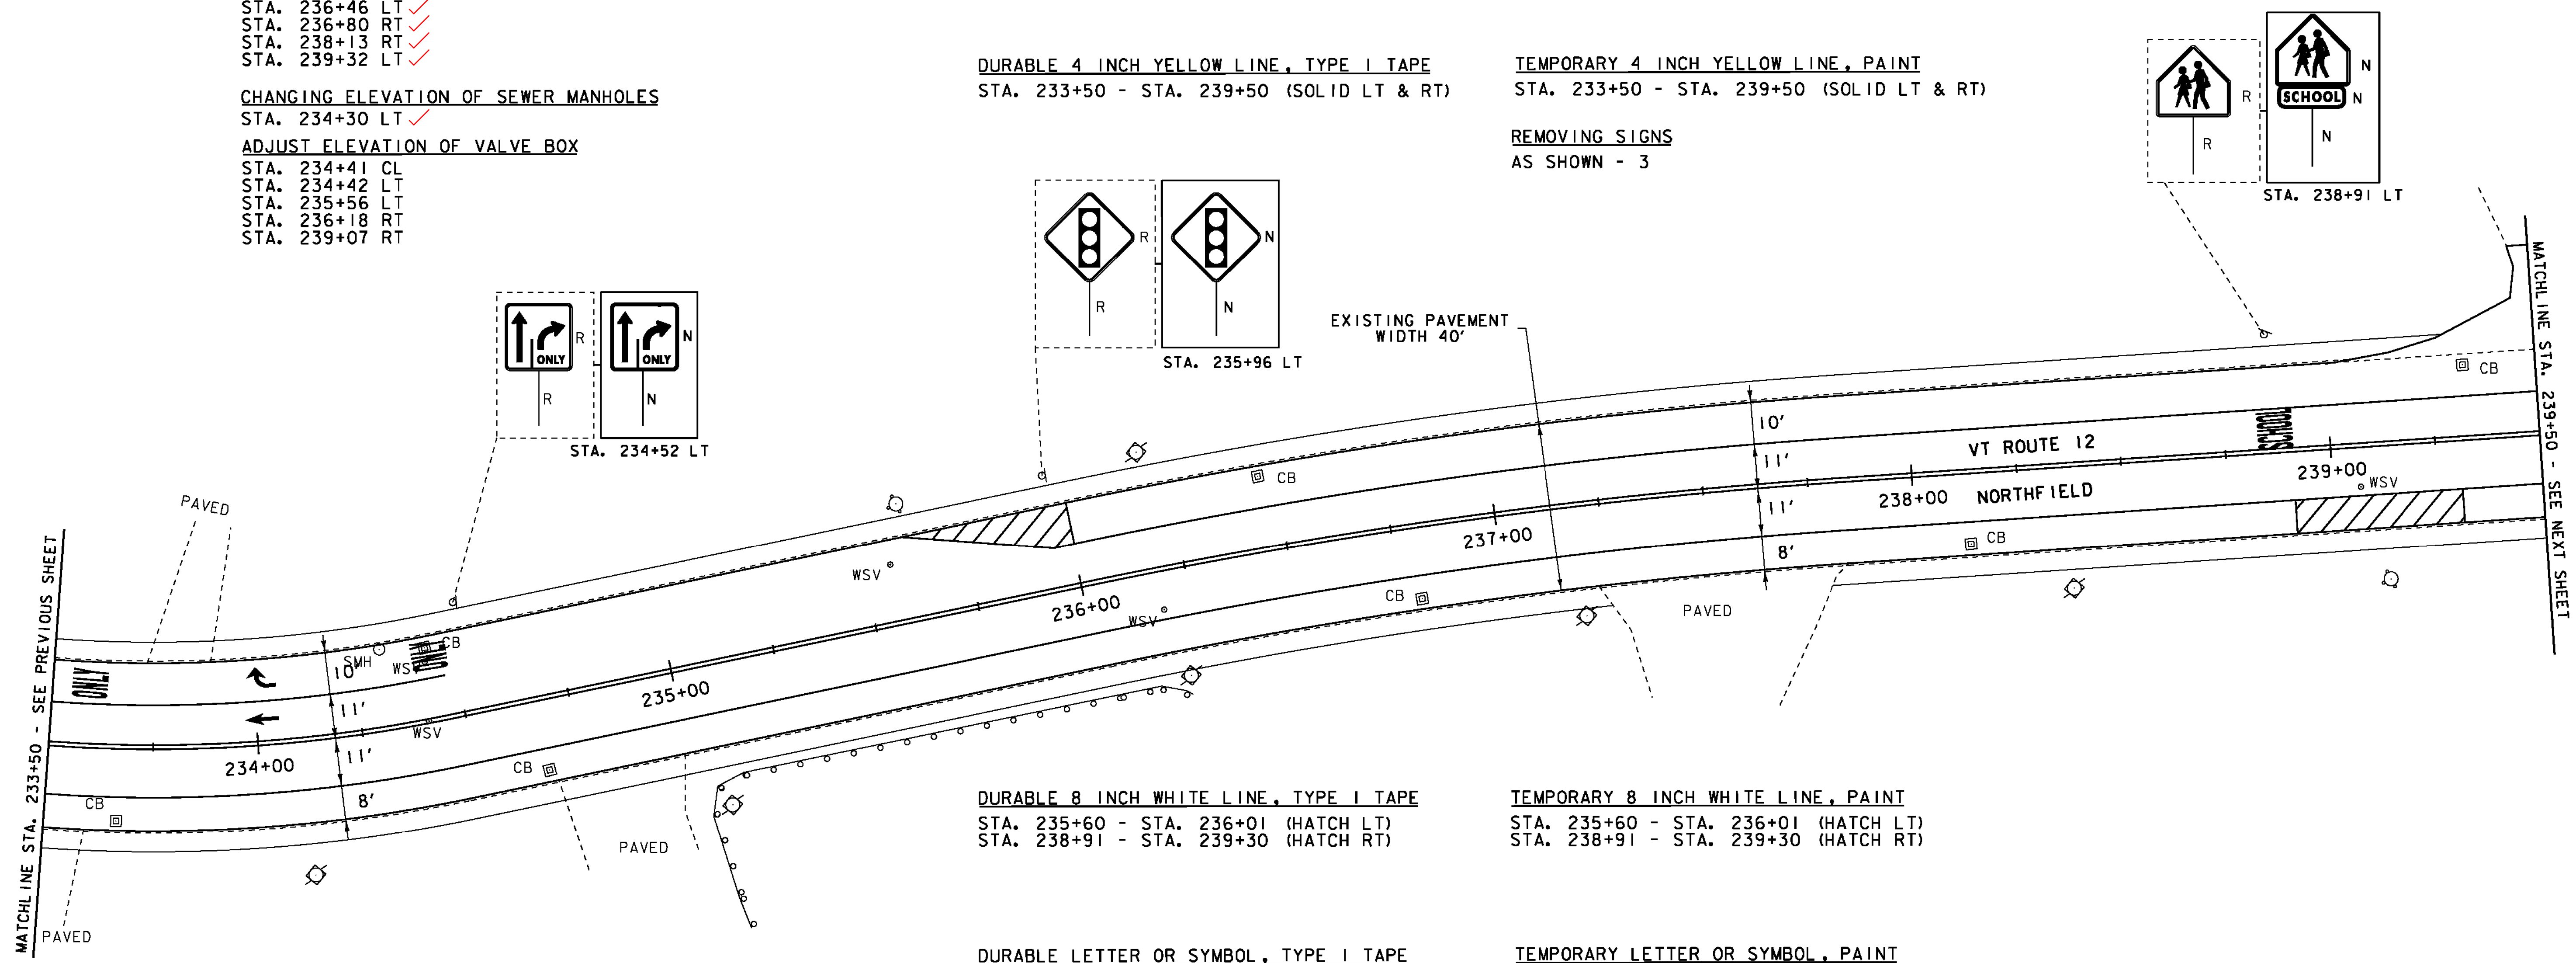

DURABLE 8 INCH WHITE LINE, TYPE I TAPE

- STA. 235+60 - STA. 236+01 (HATCH LT)
- STA. 238+91 - STA. 239+30 (HATCH RT)

TEMPORARY 8 INCH WHITE LINE, PAINT

- STA. 235+60 - STA. 236+01 (HATCH LT)
- STA. 238+91 - STA. 239+30 (HATCH RT)

DURABLE LETTER OR SYMBOL, TYPE I TAPE

- STA. 233+59 LT "ONLY"
- STA. 234+03 LT ARROW
- STA. 234+03 LT ARROW
- STA. 234+43 LT "ONLY"
- STA. 238+87 LT "SCHOOL "

TEMPORARY LETTER OR SYMBOL, PAINT

- STA. 233+59 LT "ONLY"
- STA. 234+03 LT ARROW
- STA. 234+03 LT ARROW
- STA. 234+43 LT "ONLY"
- STA. 238+87 LT "SCHOOL "

LEGEND

- SIGN
- HYDRANT
- MANHOLE
- VALVE
- GAS PIPELINE MARKER
- CATCH BASIN / DROP INLET
- CURB INLET
- TRAFFIC CONTROL BOX
- PARKING METER
- UTILITY POLE
- DETECTABLE WARNINGS
- LIGHT POLE
- EX. DETECTABLE WARNINGS
- JUNCTION BOX
- PED BUTTON
- ELECTRICAL BOX
- SIGNAL
- PEDESTAL POST
- STRAIN POLE
- CAMERA
- VDZ VIDEO DETECTION ZONE

SIGN LEGEND

- R = REMOVE
- R&S = REMOVE AND SALVAGE
- RET = RETAIN
- S = SALVAGE
- N = NEW
- B-B = BACK TO BACK

NOT TO SCALE

PROJECT LAYOUT SHEET 51	PROJECT NAME: BETHEL-NORTHFIELD
	PROJECT NUMBER: STP 2922(I)
FILE NAME: piOC246.dgn	PLOT DATE: 1/3/13
PROJECT LEADER: CDL	DRAWN BY: JBG
DESIGNED BY: SJL	CHECKED BY: CDL
PLOT FILE: piOC246_70.I	SHEET 70 OF 149