

REHAB. DROP INLETS, CATCH BASINS, OR MANHOLES, CLASS I OR CLASS II
 STA. 246+04 LT ✓ STA. 250+40 RT ✓
 STA. 250+27 LT ✓

CHANGING ELEVATION OF SEWER MANHOLES
 STA. 246+00 LT ✓
 STA. 246+02 RT ✓
 STA. 250+40 CL ✓

ADJUST ELEVATION OF VALVE BOX
 STA. 250+13 RT

DURABLE 4 INCH WHITE LINE, TYPE I TAPE
 STA. 245+50 - STA. 251+50 (SOLID LT & RT)
 (WITH BREAKS AT SIDEROADS)

DURABLE 4 INCH YELLOW LINE, TYPE I TAPE
 STA. 245+50 - STA. 251+50 (SOLID LT & RT)
 (WITH BREAKS AT SIDEROADS)
 STA. 250+33 RT (CENTERLINE SHERMAN AV)

DURABLE LETTER OR SYMBOL, TYPE I TAPE
 STA. 250+41 RT "STOP"

DURABLE 24 INCH STOP BAR, TYPE I TAPE
 STA. 250+35 - STA 250+46 RT


TEMPORARY 4 INCH WHITE LINE, PAINT
 STA. 245+50 - STA. 251+50 (SOLID LT & RT)
 (WITH BREAKS AT SIDEROADS)

TEMPORARY 4 INCH YELLOW LINE, PAINT
 STA. 245+50 - STA. 251+50 (SOLID LT & RT)
 (WITH BREAKS AT SIDEROADS)
 STA. 250+33 RT (CENTERLINE SHERMAN AV)

TEMPORARY LETTER OR SYMBOL, PAINT
 STA. 250+41 RT "STOP"

TEMPORARY 24 INCH STOP BAR, PAINT
 STA. 250+35 - STA 250+46 RT

REMOVING SIGNS
 AS SHOWN - 4

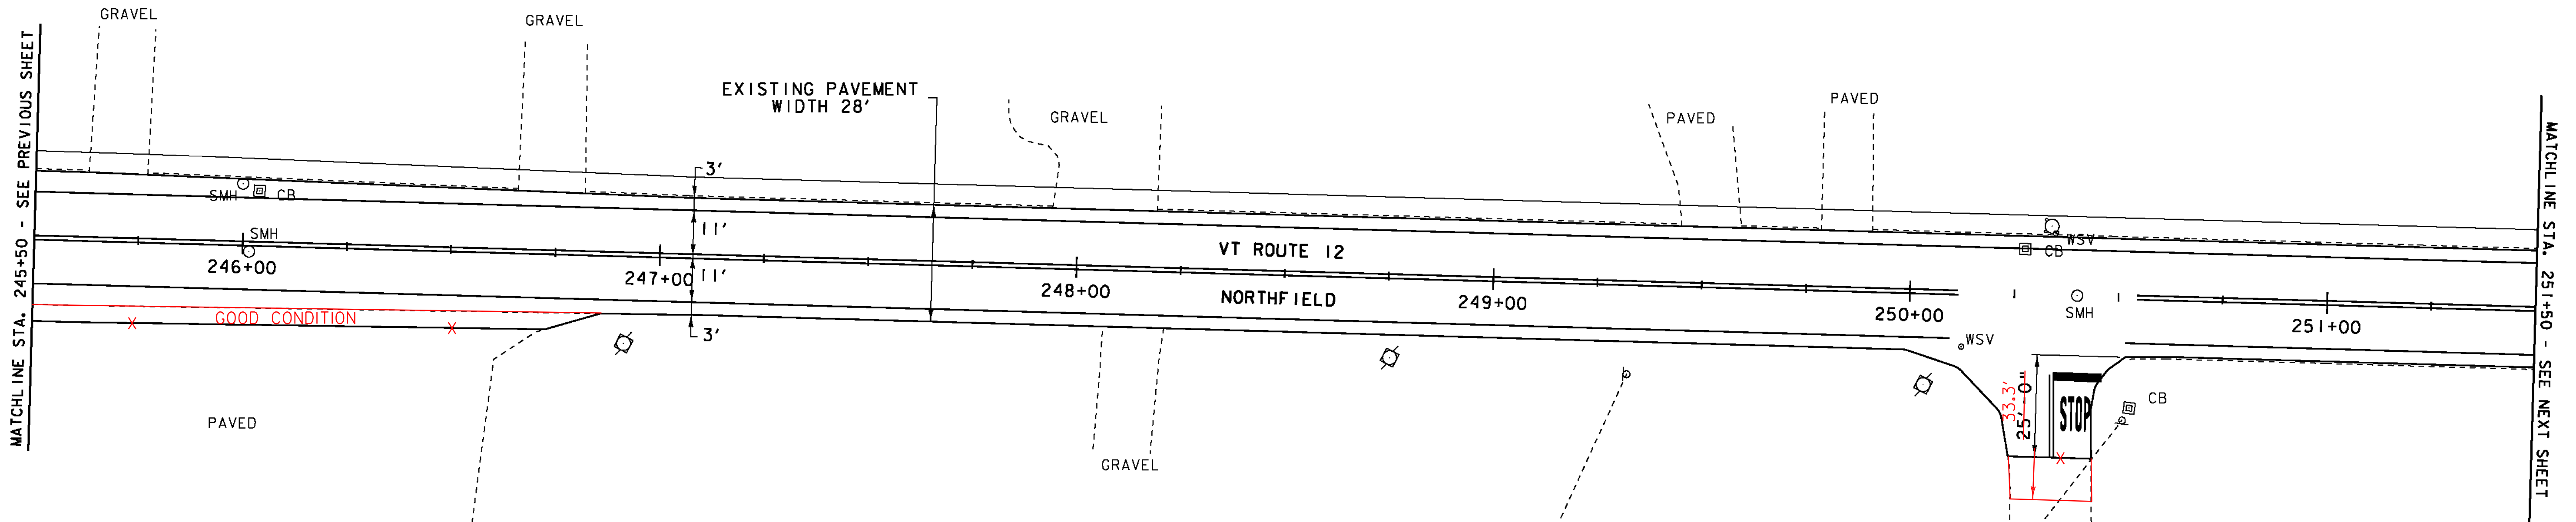

- LEGEND**
- SIGN
 - HYDRANT
 - MANHOLE
 - VALVE
 - GAS PIPELINE MARKER
 - CATCH BASIN / DROP INLET
 - CURB INLET
 - ⊠ TRAFFIC CONTROL BOX
 - ⊠ PARKING METER
 - ⊠ UTILITY POLE
 - DETECTABLE WARNINGS
 - LIGHT POLE
 - EX. DETECTABLE WARNINGS
 - JUNCTION BOX
 - ⊠ PED BUTTON
 - ⊠ ELECTRICAL BOX
 - ⊠ SIGNAL
 - ⊠ PEDESTAL POST
 - ⊠ STRAIN POLE
 - CAMERA
 - VIDEO DETECTION ZONE

- SIGN LEGEND**
- R = REMOVE
 - R&S = REMOVE AND SALVAGE
 - RET = RETAIN
 - S = SALVAGE
 - N = NEW
 - B-B = BACK TO BACK

PROJECT LAYOUT SHEET 53	PROJECT NAME: BETHEL-NORTHFIELD
	PROJECT NUMBER: STP 2922(I)
FILE NAME: piOC246.dgn	PLOT DATE: 1/3/13
PROJECT LEADER: CDL	DRAWN BY: JBG
DESIGNED BY: SJL	CHECKED BY: CDL
PLOT FILE: piOC246_72.1	SHEET 72 OF 149

NOT TO SCALE