

DURABLE 4 INCH WHITE LINE, TYPE I TAPE
 STA. 251+50 - STA. 255+50 (SOLID LT & RT)

TEMPORARY 4 INCH WHITE LINE, PAINT
 STA. 251+50 - STA. 255+50 (SOLID LT & RT)


DURABLE 4 INCH YELLOW LINE, TYPE I TAPE
 STA. 251+50 - STA. 255+50 (SOLID LT & RT)

TEMPORARY 4 INCH YELLOW LINE, PAINT
 STA. 251+50 - STA. 255+50 (SOLID LT & RT)

REHAB, DROP INLETS, CATCH
 BASINS, OR MANHOLES, CLASS I OR CLASS II
 STA. 253+90 LT ✓
 STA. 253+90 RT ✓

REMOVING SIGNS
 AS SHOWN - 7

CHANGING ELEVATION OF SEWER MANHOLES
 STA. 252+47 CL ✓
 STA. 254+14 CL ✓

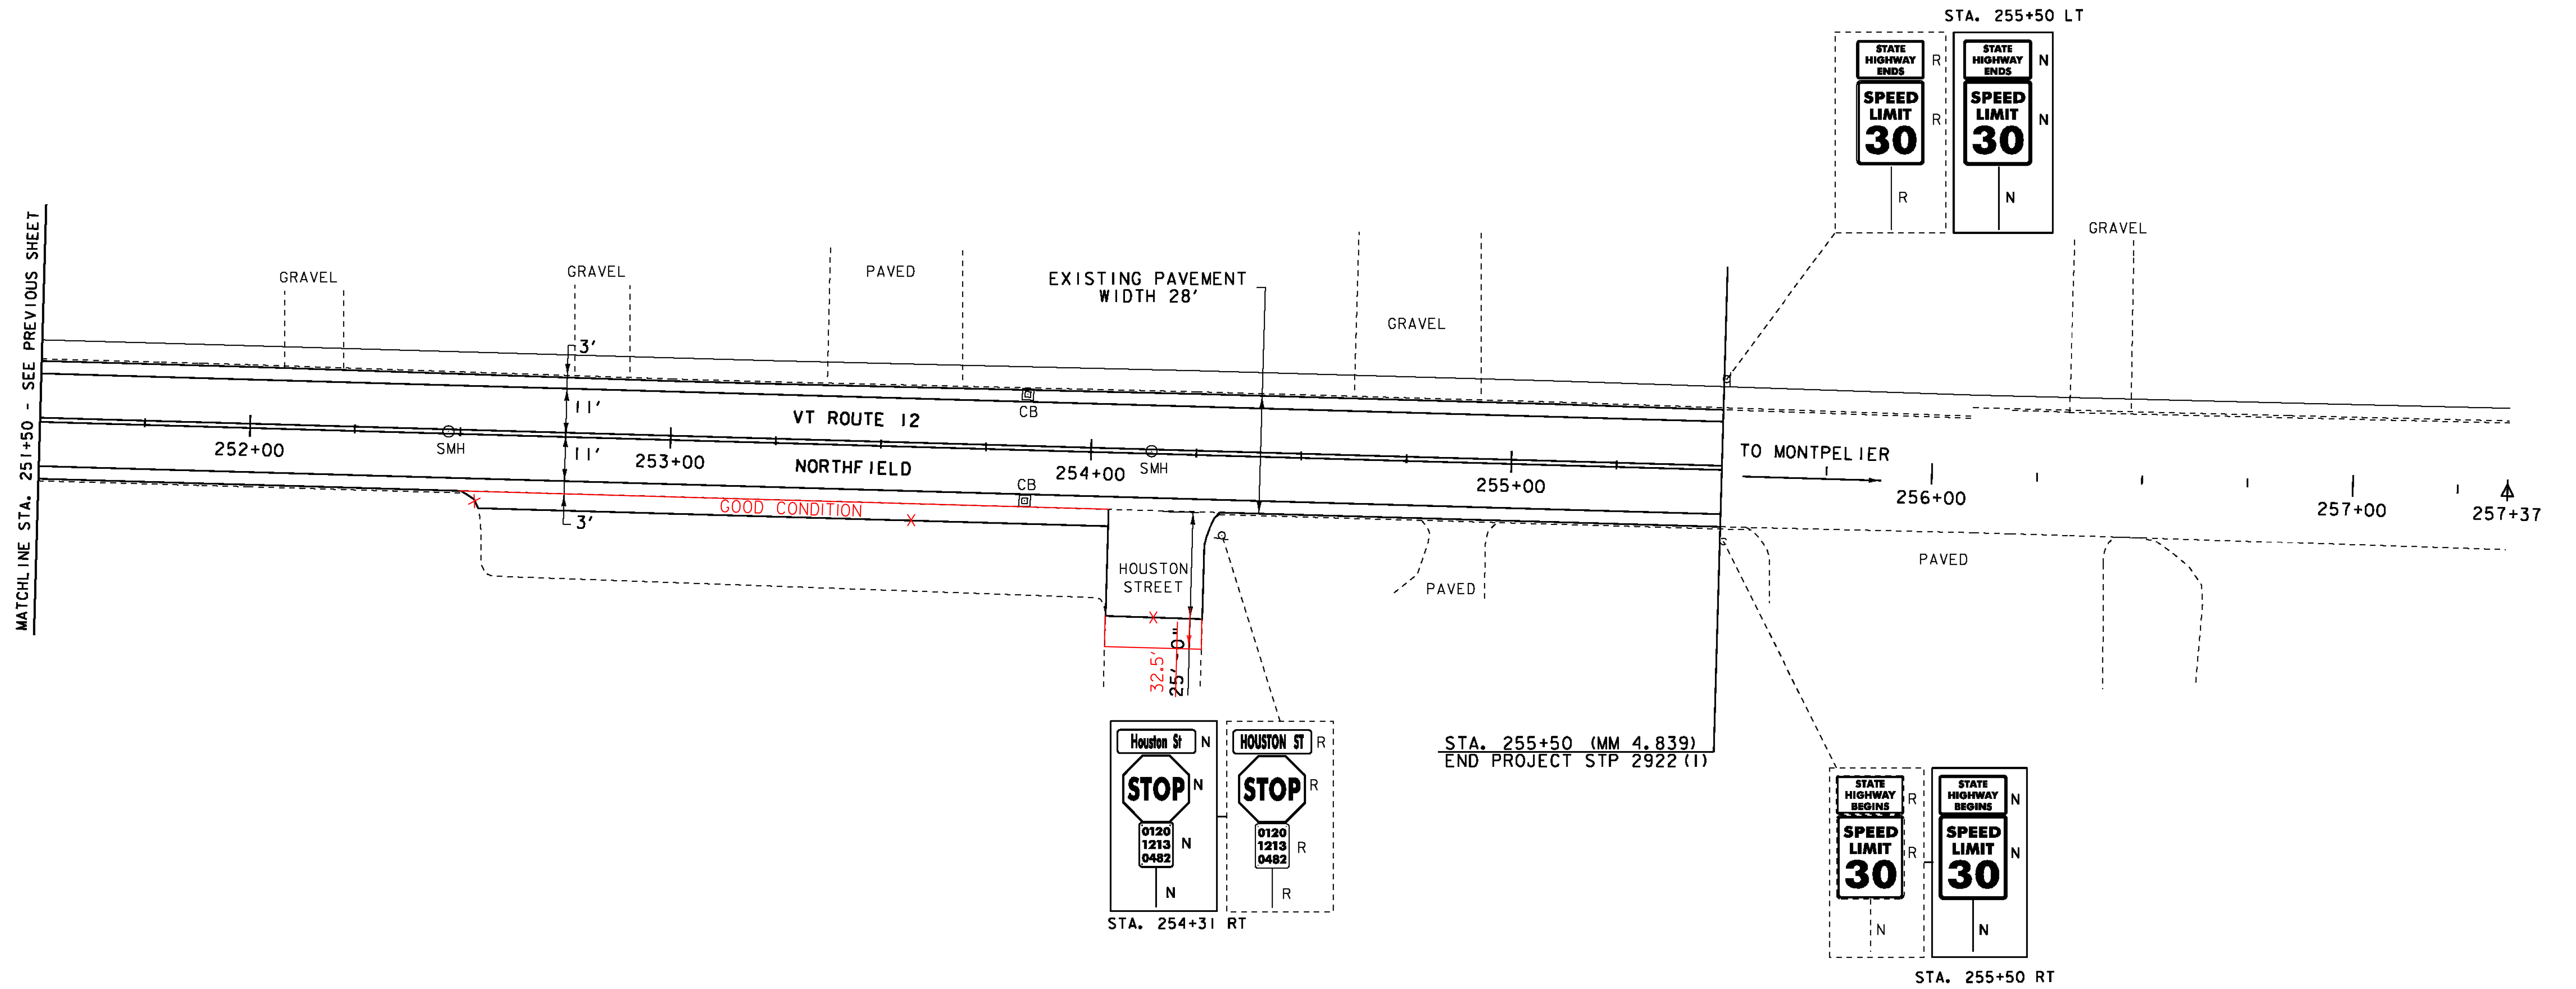

- LEGEND**
- SIGN
 - HYDRANT
 - MANHOLE
 - VALVE
 - GAS PIPELINE MARKER
 - CATCH BASIN / DROP INLET
 - CURB INLET
 - TRAFFIC CONTROL BOX
 - PARKING METER
 - UTILITY POLE
 - DETECTABLE WARNINGS

- LIGHT POLE
- EX. DETECTABLE WARNINGS
- JUNCTION BOX
- PED BUTTON
- ELECTRICAL BOX
- SIGNAL
- PEDESTAL POST
- STRAIN POLE
- CAMERA
- V D Z VIDEO DETECTION ZONE

- SIGN LEGEND**
- R = REMOVE
 - R&S = REMOVE AND SALVAGE
 - RET = RETAIN
 - S = SALVAGE
 - N = NEW
 - B-B = BACK TO BACK

NOT TO SCALE

PROJECT LAYOUT SHEET 54	PROJECT NAME: BETHEL-NORTHFIELD	PLOT DATE: 1/3/13
	PROJECT NUMBER: STP 2922(1)	DRAWN BY: JBG
	FILE NAME: p10C246.dgn	CHECKED BY: CDL
	DESIGNED BY: SJL	SHEET 73 OF 149
	PLOT FILE: p10C246_73.1	