


STATE OF VERMONT AGENCY OF TRANSPORTATION



PROPOSED IMPROVEMENT TOWN OF HANCOCK COUNTY OF ADDISON VT ROUTE 125 (MAJOR COLLECTOR)

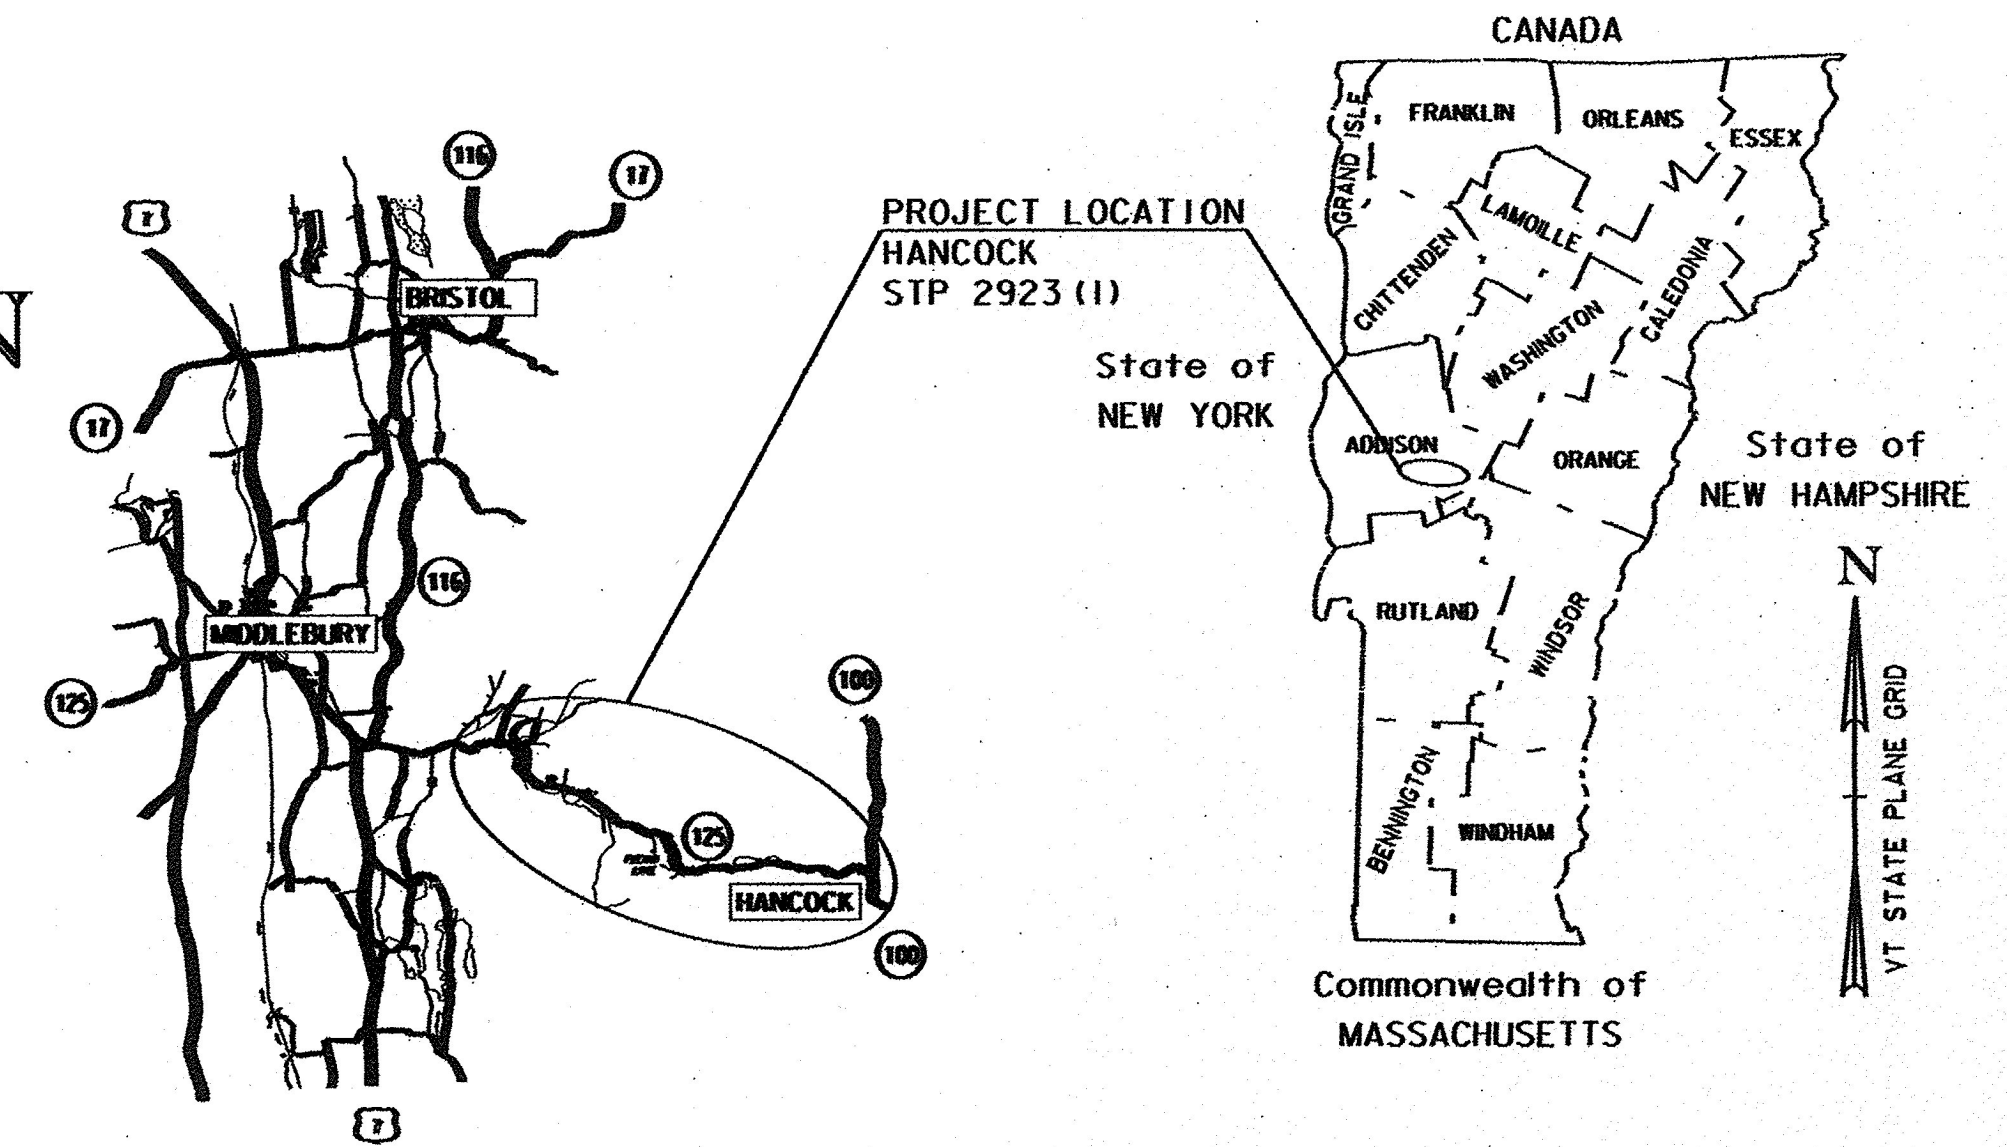

NOT TO SCALE

RECORD PLANS	
CONTRACTOR:	F.W. WHITCOMB CONSTRUCTION CO.P. - WALPOLE, NH
RESIDENT ENGINEER:	CHRIS LAVALETTE
CONSTRUCTION BEGAN:	AUGUST 06, 2015
CONSTRUCTION COMPLETE:	SEPTEMBER 07, 2017
RECORD PLANS BY:	CHRIS LAVALETTE & JESSE IVES
I HEREBY CERTIFY THAT ALL THE CONSTRUCTION REQUIRED BY THIS SET OF DRAWINGS HAS BEEN ACCOMPLISHED AS INDICATED HEREIN.	
BY:	<i>Chris Lavolette</i> RESIDENT ENGINEER
DATE:	9/20/19
NOTE: Any further information concerning final quantities, amounts or other details relative to this project may be found at Central Files in the electronic archives.	


PROJECT LOCATION: BEGINNING IN THE TOWN OF HANCOCK ON VT ROUTE 125 AT STA. 40+50.00 (MM 0.767) AND EXTENDING EAST ALONG VT ROUTE 125 34198.00 FT (6.477 MILES) TO STA. 382+48.00 (MM 7.244) AT THE INTERSECTION WITH VT ROUTE 100 IN THE TOWN OF HANCOCK.

STATION TO STATION DATA	LENGTH (FEET)	LENGTH (MILES)
TOWN OF HANCOCK STA. 40+50.00 TO STA. 382+48.00 (MM 0.767 TO MM 7.244)	34198.00	6.477

TOTAL ROADWAY LENGTH =	34198.00	6.477
TOTAL PROJECT LENGTH =	34198.00	6.477

STA. 40+50.00 (MM 0.767)
BEGIN STP 2923 (1)
TOWN OF HANCOCK

PROJECT DESCRIPTION: WORK TO BE PERFORMED UNDER THIS PROJECT INCLUDES COLD PLANING, RECLAIMING, CORRECTING SUPERELEVATION DEFICIENCIES, RESURFACING WITH BASE, INTERMEDIATE, AND WEARING COURSES, NEW PAVEMENT MARKINGS, GUARDRAIL IMPROVEMENTS, DRAINAGE IMPROVEMENTS AND OTHER RELATED HIGHWAY ITEMS.

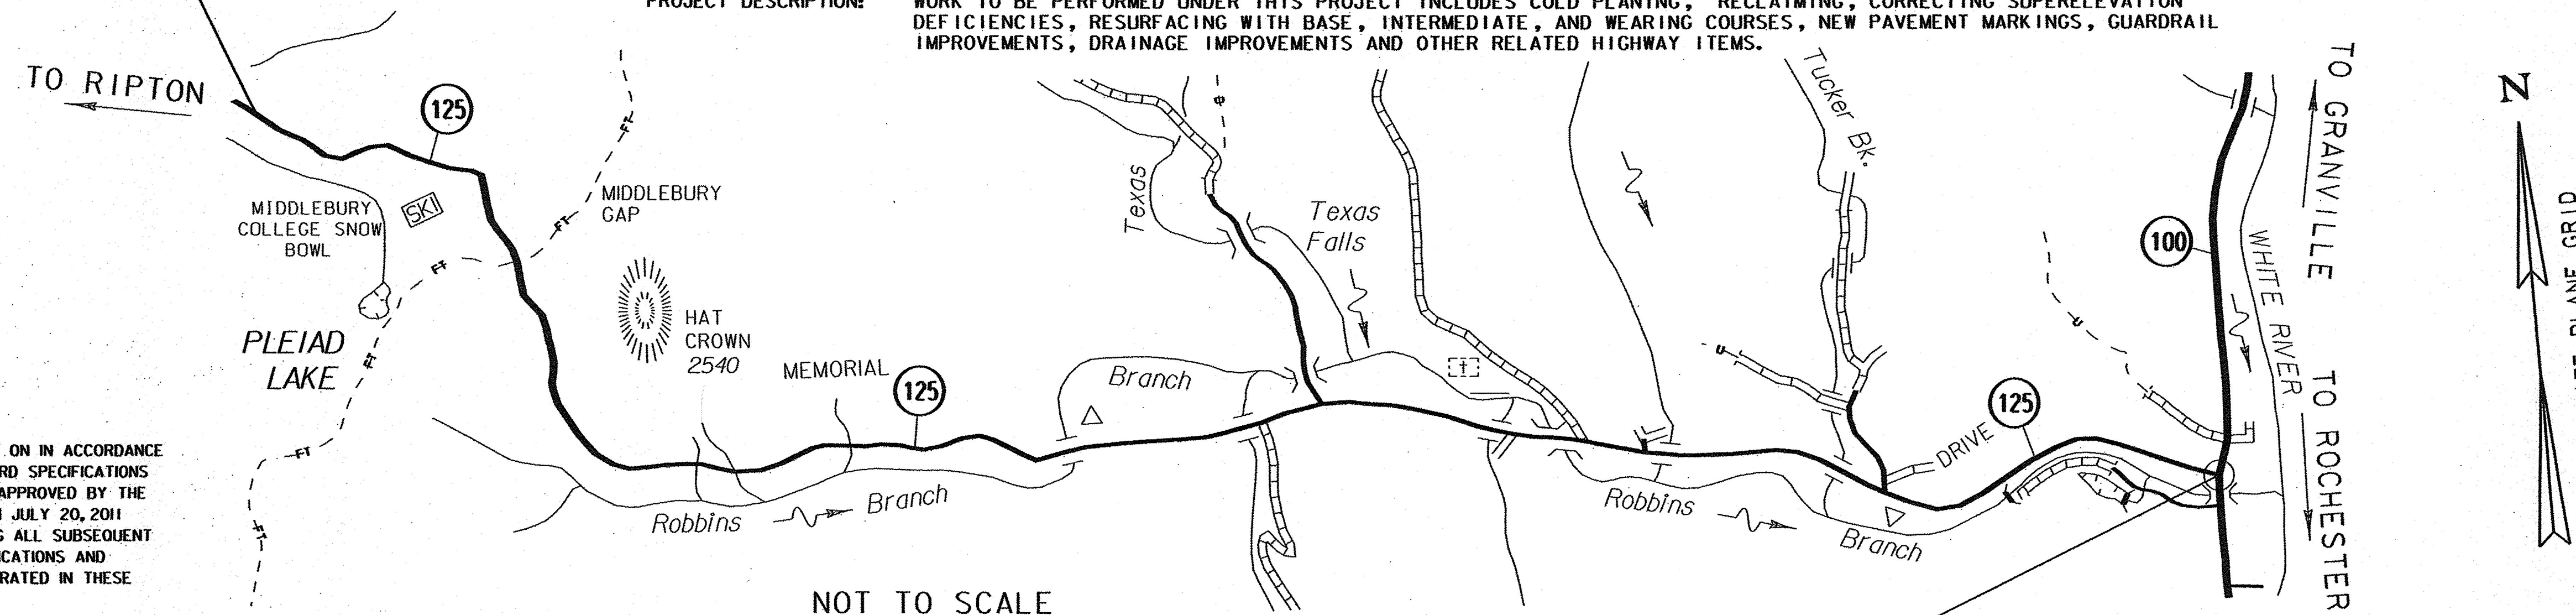

CONSTRUCTION IS TO BE CARRIED ON IN ACCORDANCE WITH THESE PLANS AND THE STANDARD SPECIFICATIONS FOR CONSTRUCTION DATED 2011, AS APPROVED BY THE FEDERAL HIGHWAY ADMINISTRATION ON JULY 20, 2011 FOR USE ON THIS PROJECT, INCLUDING ALL SUBSEQUENT REVISIONS AND SUCH REVISED SPECIFICATIONS AND SPECIAL PROVISIONS AS ARE INCORPORATED IN THESE PLANS.


QUALITY ASSURANCE PROGRAM : LEVEL 3

SURVEYED BY : VTRANS
SURVEYED DATE : APRIL, 2014

DATUM
VERTICAL NAVD 88
HORIZONTAL NAD 83 CORS

STA. 382+48.00 (MM 7.244)
END STP 2923 (1)
TOWN OF HANCOCK

DuBois & King
INC.

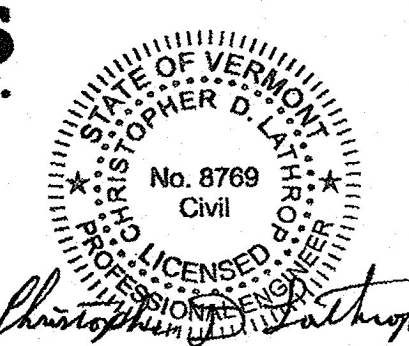

DIRECTOR OF PROJECT DELIVERY	APPROVED: <i>J.H.</i> DATE: 3/24/2015
PROJECT MANAGER : JONATHAN HARRINGTON, P.E.	
PROJECT NAME : HANCOCK	
PROJECT NUMBER : STP 2923 (1)	
SHEET 1 OF 207 SHEETS	