

RECLAIMED STABILIZED BASE TYPICAL SECTION

STA. 42+00 - STA. 266+50
 STA. 271+17 - STA. 374+00


* 10'-0" LANES, 4'-0" SHOULDER
 STA. 374+00 - STA. 380+98

NOTES:

- APPROXIMATE WETLAND AND OTHER RESOURCE LOCATIONS HAVE BEEN IDENTIFIED. SEE PROJECT LAYOUT SHEETS FOR LOCATIONS. THE PROJECT SHALL BE CONSTRUCTED AS DESIGNED AND WITHIN THE LIMITS ESTABLISHED IN THE CROSS SECTIONS. IF IT IS DEEMED NECESSARY BY THE CONTRACTOR TO WORK BEYOND THOSE LIMITS IT WILL BE THE RESPONSIBILITY OF THE CONTRACTOR TO ACQUIRE ANY NECESSARY STATE AND FEDERAL PERMITS.
- ITEM 201.10 "CLEARING AND GRUBBING, INCLUDING INDIVIDUAL TREES AND STUMPS" HAS BEEN INCLUDED TO REMOVE ANY VEGETATION, PARTIAL AND FULL TREE REMOVAL, THINNING AND TRIMMING FOR SIGNS, AND ANY ASSOCIATED GRUBBING WITHIN THE ASSUMED 3 ROD R.O.W., OR GREATER IF NECESSARY WHEN R.O.W HAS BEEN CONFIRMED BEYOND THE ASSUMED 3 RODS. THE ENGINEER MAY EXCLUDE REMOVAL IN SOME AREAS WHERE DEEMED NECESSARY AND APPROPRIATE OR NECESSITATED BY PERMIT REQUIREMENTS PER THE REGIONAL CONSTRUCTION ENVIRONMENTAL ENGINEER'S RECOMMENDATIONS. THINNING AND TRIMMING SHALL BE PERFORMED IN ACCORDANCE WITH THE DETAIL ON SHEET 6 AND SECTION 201.
- ALL BORINGS WERE TAKEN IN THE CENTER OF THE TRAVEL LANE AND THEREFORE MAY NOT BE REPRESENTATIVE OF FOOTPRINT.
- ADDITIONAL QUANTITIES FOR ITEMS 203.15 "COMMON EXCAVATION", 900.680 "SPECIAL PROVISION (RSB SUPPLEMENTAL AGGREGATE MATERIAL)", 301.35 "SUBBASE OF DENSE GRADED CRUSHED STONE", AND 649.11 "GEOTEXTILE FOR ROADBED SEPARATOR" HAVE BEEN ESTIMATED TO ADDRESS POSSIBLE UNSUITABLE SUBBASE MATERIAL ENCOUNTERED WITHIN THE PROJECT. REFER TO DETAIL ON SHEET 8.
- A QUANTITY OF ITEM 204.21 "TRENCH EXCAVATION OF ROCK" HAS BEEN INCLUDED IN THE EVENT LEDGE IS ENCOUNTERED DURING THE INSTALLATION OF UNDERDRAIN OUTSIDE AREAS OF SOLID ROCK EXCAVATION AS DETAILED ON SHEET 5.
- COLD PLANING SHALL BE COMPLETED ACCORDING TO THE TYPICAL OR AS OTHERWISE NOTED ON THE PLANS. A BUTT JOINT SHALL BE CONSTRUCTED AT THE BEGINNING AND END OF THE PROJECT AND ALL PAVED SIDE ROAD APPROACHES AS DENOTED ON THE PROJECT PLANS OR AS OTHERWISE DIRECTED BY THE ENGINEER. SAWCUTTING WILL NOT BE PAID FOR SEPARATELY, BUT WILL BE PAID INCIDENTAL TO ITEM 210.10 "COLD PLANING, BITUMINOUS PAVEMENT". PRIOR TO RECLAIMING, ANY EXISTING SHOULDER MATERIAL DEEMED UNSUITABLE BY THE ENGINEER WILL BE EXCAVATED TO THE DEPTH OF RECLAIMING OR AS DIRECTED BY THE ENGINEER. EXCAVATED MATERIAL WILL BE SPREAD ON THE ADJACENT SLOPES OR REMOVED FROM THE PROJECT AS DIRECTED BY THE ENGINEER. THIS WORK WILL BE PAID FOR USING THE APPROPRIATE RENTAL ITEMS. THE METHOD OF REMOVAL AND THE USE OF RENTAL ITEMS SHALL BE APPROVED BY THE ENGINEER PRIOR TO ANY WORK BEING DONE. MATERIAL REMOVED SHALL BE REPLACED WITH ITEM 900.680 "SPECIAL PROVISION (RSB SUPPLEMENTAL AGGREGATE MATERIAL)".
- AN ADDITIONAL QUANTITY OF 900.680 "SPECIAL PROVISION (RSB SUPPLEMENTAL AGGREGATE MATERIAL)" HAS BEEN INCLUDED TO CORRECT SUPERELEVATION AND GRADATION DEFICIENCIES WITHIN THE RECLAIMED SECTION. FOR EXISTING SHOULDER RECONSTRUCTION DETAIL SEE SHEET 6.
- ITEM 900.683 "SPECIAL PROVISION (FOG SEAL SURFACE TREATMENT)" SHALL BE APPLIED ON THE SURFACE OF THE RECLAIMED STABILIZED BASE, PORTLAND CEMENT AT THE RATE OF 0.15 GAL/SY OR AS DIRECTED BY THE ENGINEER.
- THE FIRST RECLAIM PASS SHALL BE PERFORMED FROM TOP OF BANK TO TOP OF BANK WHERE FULL WIDTH IS NOT ACHIEVABLE. THE FIRST RECLAIM PASS SHALL BE PAID UNDER ITEM 900.675 "SPECIAL PROVISION (RECLAIMED STABILIZED BASE)". THE SECOND RECLAIM PASS SHALL BE PERFORMED FULL WIDTH PER THE TYPICAL SECTION. THE SECOND RECLAIM PASS SHALL BE PAID UNDER ITEM 900.675 "SPECIAL PROVISION (RECLAIMED STABILIZED BASE, PORTLAND CEMENT)".
- ALL EDGES OF PAVEMENT SHALL BE BACKED UP TO FULL HEIGHT WITH AGGREGATE SHOULDER MATERIAL AS DIRECTED BY THE ENGINEER AND WILL BE PAID UNDER ITEM 402.13 "AGGREGATE SHOULDERS, RAP".
- ~~FOR THE PURPOSES OF QUANTITY CALCULATION IT HAS BEEN ASSUMED ITEM 900.675 "SPECIAL PROVISION (COLD MIXED RECYCLED BITUMINOUS PAVEMENT, PORTLAND CEMENT)" WILL REQUIRE 3% BY WEIGHT OF ITEM 900.683 "SPECIAL PROVISION (EMULSIFIED ASPHALT, COLD MIX WITH CEMENT)". FOR THE SAME PURPOSE IT HAS ALSO BEEN ASSUMED 1% BY WEIGHT OF PORTLAND CEMENT WILL BE REQUIRED BY MIX DESIGN. ITEM 900.680 "SPECIAL PROVISION (MATERIAL TRANSFER VEHICLE, COLD MIX)" HAS BEEN ESTIMATED USING A UNIT WEIGHT OF 2 TONS/CY. THE AVERAGE BULK SPECIFIC GRAVITY DETERMINED IN THE MIX DESIGN SHALL BE USED FOR ACTUAL PAYMENT QUANTITY.~~
- ITEM 900.683 "SPECIAL PROVISION (EMULSIFIED ASPHALT) (RS-1H OR CRS-1H)" SHALL BE APPLIED AS A TACK COAT ON ALL EXISTING OR COLD PLANED PAVEMENT SURFACES AT THE RATE OF 0.080 GAL/SY, AT THE RATE OF 0.040 TO 0.060 GAL/SY ON ALL COLD MIX PAVEMENT SURFACES, AND BETWEEN ALL COURSES OF BITUMINOUS CONCRETE PAVEMENT AT THE RATE OF 0.025 TO 0.040 GAL/SY. PAYMENT WILL BE MADE UNDER ITEM 900.683 "SPECIAL PROVISION (EMULSIFIED ASPHALT) (RS-1H OR CRS-1H)".
- THE WEARING AND LEVELING COURSES SHALL BE TYPE IVS SUPERPAVE BITUMINOUS CONCRETE PAVEMENT, AND THE BASE COURSE SHALL BE SPECIAL PROVISION (COLD MIXED RECYCLED BITUMINOUS PAVEMENT, PORTLAND CEMENT). ALL ASPHALT CEMENT USED IN THE SUPERPAVE BITUMINOUS CONCRETE PAVEMENT SHALL BE AS SPECIFIED IN SUBSECTION 490.03 (b).

NOTES (CONTINUED):

- ALL PAVED AND GRAVEL RESIDENTIAL AND COMMERCIAL DRIVES SHALL RECEIVE A PAVED APRON OF 4' AND ALL FIELD AND WOODS DRIVES SHALL RECEIVE A 2' PAVED APRON UNLESS OTHERWISE SHOWN ON PLANS OR AS DIRECTED BY THE ENGINEER. ANY AND ALL REQUIRED EXCAVATION AND ASSOCIATED DRIVE GRADING IN DRIVE AREAS SHALL BE AS SHOWN ON THE PLANS OR AS DIRECTED BY THE ENGINEER. THE NEW BITUMINOUS SURFACE SHALL BE CONSTRUCTED AS DIRECTED AND WILL BE PAID FOR UNDER ITEM 900.675 "SPECIAL PROVISION (HAND-PLACED BITUMINOUS CONCRETE MATERIAL, DRIVES)". ALL OTHER BITUMINOUS MATERIAL PLACED WITHIN THE PROJECT LIMITS WHETHER BY HAND OR MECHANICAL METHODS WILL BE PAID AS ITEM 490.30 "SUPERPAVE BITUMINOUS CONCRETE PAVEMENT".
- SUPERPAVE BITUMINOUS CONCRETE PAVEMENT TOLERANCE = +/- 1/4 INCH (TOTAL THICKNESS).
~~COLD MIXED RECYCLED BITUMINOUS BASE COURSE TOLERANCE = +/- 1/4 INCH.~~
 SPECIAL PROVISION (RSB SUPPLEMENTAL AGGREGATE MATERIAL) TOLERANCE = +/- 1 INCH (TOTAL SUBBASE THICKNESS).
- EDGES OF PAVEMENT SHALL INCLUDE A SAFETY EDGE AS SHOWN ON SHEET 8.
- A QUANTITY FOR ITEM 604.412 "REHAB D1, CB OR MH CLASS 1" HAS BEEN INCLUDED IN THE QUANTITIES TO BE USED AS DIRECTED BY THE ENGINEER. ALL D1'S SHALL BE RAISED OR REHABILITATED SUCH THAT THE NEW GRATE ELEVATION IS LEVEL WITH THE SURROUNDING TERRAIN.
- DAMAGE TO ANY D1'S, CROSS CULVERTS OR OTHER DRAINAGE FEATURES DUE DIRECTLY TO THE CONTRACTOR'S OPERATIONS SHALL BE REPAIRED OR REPLACED AS DIRECTED BY THE ENGINEER AT NO ADDITIONAL COST TO THE STATE.
- ITEM 613.10 "STONE FILL, TYPE 1"; ITEM 651.40 "GRUBBING MATERIAL (6")"; ITEM 653.20 "TEMPORARY EROSION MATTING" AND ITEM 608.25 "ALL PURPOSE EXCAVATOR RENTAL, TYPE 1" HAVE BEEN INCLUDED FOR AREAS WITH PROPOSED SIDE SLOPES STEEPER THAN 1:1.5, AND TO PROVIDE FOR REPAIR OF EXISTING STONE LINED DRAINAGE OUTLETS OR WASHOUTS LOCATED ALONG THE ROADWAY SIDE SLOPES AS DIRECTED BY THE ENGINEER.
- A QUANTITY HAS BEEN ESTIMATED FOR ITEM 617.10 "RELOCATE MAILBOX, SINGLE SUPPORT", TO BE USED AS DETERMINED BY THE ENGINEER.
- A QUANTITY FOR ITEM 619.17 "YIELDING MARKER POSTS" HAS BEEN INCLUDED TO DELINEATE PIPE INLETS, PIPE OUTLETS AND DROP INLETS LOCATED OUTSIDE THE PAVEMENT SURFACES OR AS DIRECTED BY THE ENGINEER. ESTIMATED QUANTITIES FOR ITEMS 608.25, "ALL PURPOSE EXCAVATOR RENTAL, TYPE 1", 608.37, "TRUCK RENTAL", AND 608.40, "LOADER RENTAL, TYPE 1" HAVE BEEN INCLUDED FOR THE PROVISION OF CONSTRUCTING GUARDRAIL END SECTIONS WITH EXCAVATED DITCHING MATERIAL AND THE REMOVAL OF BUILT UP EXCESS SHOULDER MATERIAL IN NON-GUARDRAIL LOCATIONS. AN ESTIMATED QUANTITY OF ITEM 203.30, "EARTH BORROW" HAS BEEN INCLUDED FOR USE WITH THE GUARDRAIL END SECTIONS. 25 CY OF ITEM 203.30, "EARTH BORROW" HAS BEEN ESTIMATED FOR EACH NEW END SECTION. GUARDRAIL END SECTIONS SHALL BE CAPPED WITH AN ESTIMATED 3 INCH DEPTH OF ITEM 651.35, "TOPSOIL" UNLESS OTHERWISE DIRECTED BY THE ENGINEER. THE QUANTITIES INCLUDED REFLECT 5 CY OF ITEM 651.35, "TOPSOIL" FOR EACH NEW GUARDRAIL END SECTION. ITEM 653.20, "TEMPORARY EROSION MATTING" SHALL BE PLACED ON SLOPES GREATER THAN 1:6 CREATED BY THE GUARDRAIL END SECTIONS. THE QUANTITIES INCLUDED REFLECT 25 SY OF ITEM 653.20, "TEMPORARY EROSION MATTING" FOR EACH NEW GUARDRAIL END SECTION. PRIOR TO THE PLACEMENT OF TEMPORARY EROSION MATTING, THE AREA SHALL BE TOPSOILED AND SEEDED USING ITEM 651.35, "TOPSOIL", ITEM 651.15 "SEED", ITEM 651.18 "FERTILIZER" AND ITEM 651.20 "AGRICULTURAL LIMESTONE".
- BOX BEAM GUARDRAIL WITH 7' POSTS SHALL BE USED ON THIS PROJECT. ITEM WILL BE PAYED UNDER 900.640 SPECIAL PROVISION (BOX BEAM GUARDRAIL W/7 FEET POSTS).
- ADDITIONAL QUANTITIES FOR PAY ITEMS 649.51 "GEOTEXTILE FOR SILT FENCE", 651.15 "SEED", 651.18 "FERTILIZER", 651.20 "AGRICULTURAL LIMESTONE", 653.20 "TEMPORARY EROSION MATTING" AND 651.25 "HAY MULCH" HAVE BEEN INCLUDED FOR STONE FILL SLOPE STABILIZATION AREAS TO BE PLACED ON GRUBBING MATERIAL.
- AN ESTIMATED QUANTITY OF ITEM 653.20 "TEMPORARY EROSION MATTING" HAS BEEN INCLUDED FOR AREAS WITH PROPOSED SLOPES BETWEEN 1:2 AND 1:1.5 AS DIRECTED BY THE ENGINEER.
- QUANTITIES FOR ITEM 653.50 "BARRIER FENCE" AND ITEM 653.60 "EROSION LOG" HAVE BEEN INCLUDED FOR USE ADJACENT TO THE ENVIRONMENTALLY SENSITIVE AREAS IDENTIFIED IN THE PLANS AND AS DIRECTED BY THE ENGINEER. INSTALLATION SHALL BE PER MANUFACTURERS RECOMMENDATIONS.
- WHEN FINISHED GRADE HAS BEEN MET, THE CONTRACTOR IS RESPONSIBLE FOR ENSURING THAT ALL SIGNS BEING RETAINED ARE IN CONFORMANCE WITH VAOT STANDARD E-121 AS DIRECTED BY THE ENGINEER.
- NO ADDITIONAL COMPENSATION WILL BE GIVEN SHOULD THE CONTRACTOR BE DIRECTED BY THE ENGINEER TO SWEEP UNDERDRAIN IN ANY AREAS NOT ALREADY IDENTIFIED.
- NO ADDITIONAL COMPENSATION WILL BE GIVEN SHOULD THE CONTRACTOR BE DIRECTED BY THE ENGINEER TO SHORTEN, REPOSITION, OR ADD ADDITIONAL GUARDRAIL POSTS AT LOCATIONS OF SHALLOW OBSTRUCTIONS.

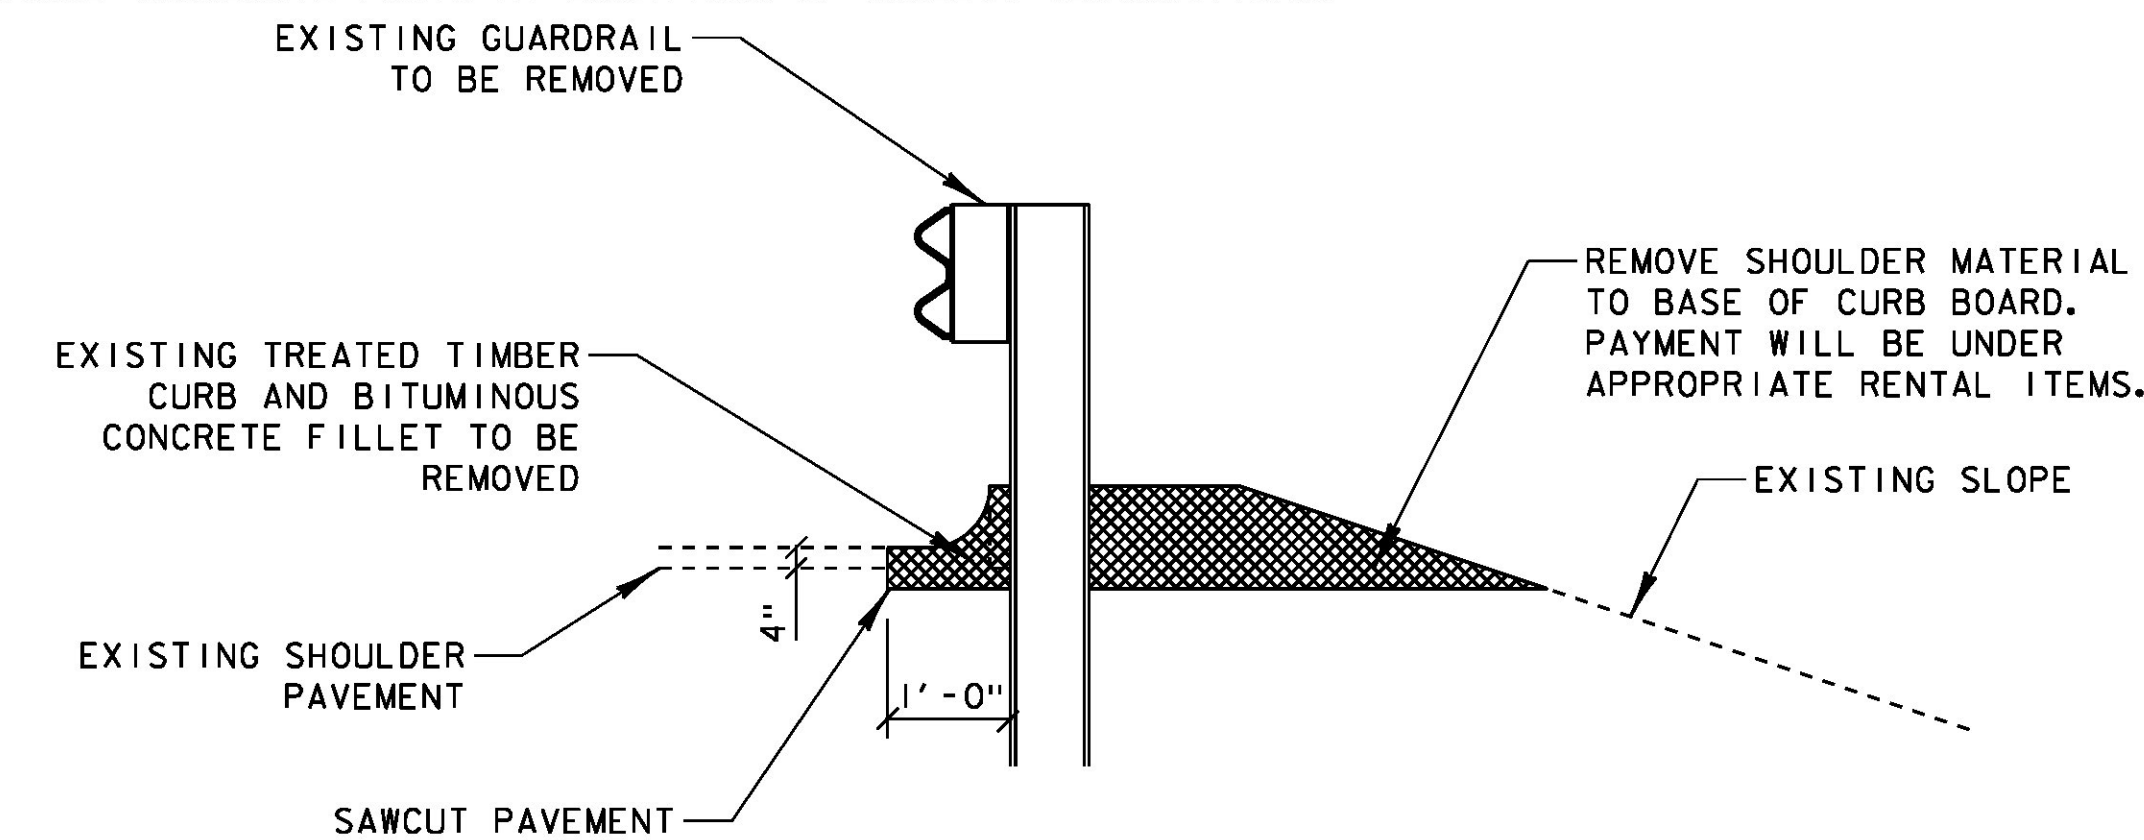

TREATED TIMBER CURB REMOVAL

NOT TO SCALE

NOTE: THE REMOVAL OF TREATED TIMBER CURBING, INCLUDING THE BITUMINOUS CONCRETE FILLET, AND ANY SAWCUTTING, WILL NOT BE PAID FOR DIRECTLY, BUT WILL BE CONSIDERED INCIDENTAL TO REMOVAL AND DISPOSAL OF GUARDRAIL.

NOT TO SCALE

PROJECT NAME:	HANCOCK
PROJECT NUMBER:	STP 2923 (1)
FILE NAME:	z10c252 typ. dgn
PROJECT LEADER:	C. LATHROP
DESIGNED BY:	B. MARTIN
PROJECT TYPICAL SHEET 1	
PLOT DATE:	3/18/2015
DRAWN BY:	J. GOODALL
CHECKED BY:	C. LATHROP
SHEET 4	OF 207