
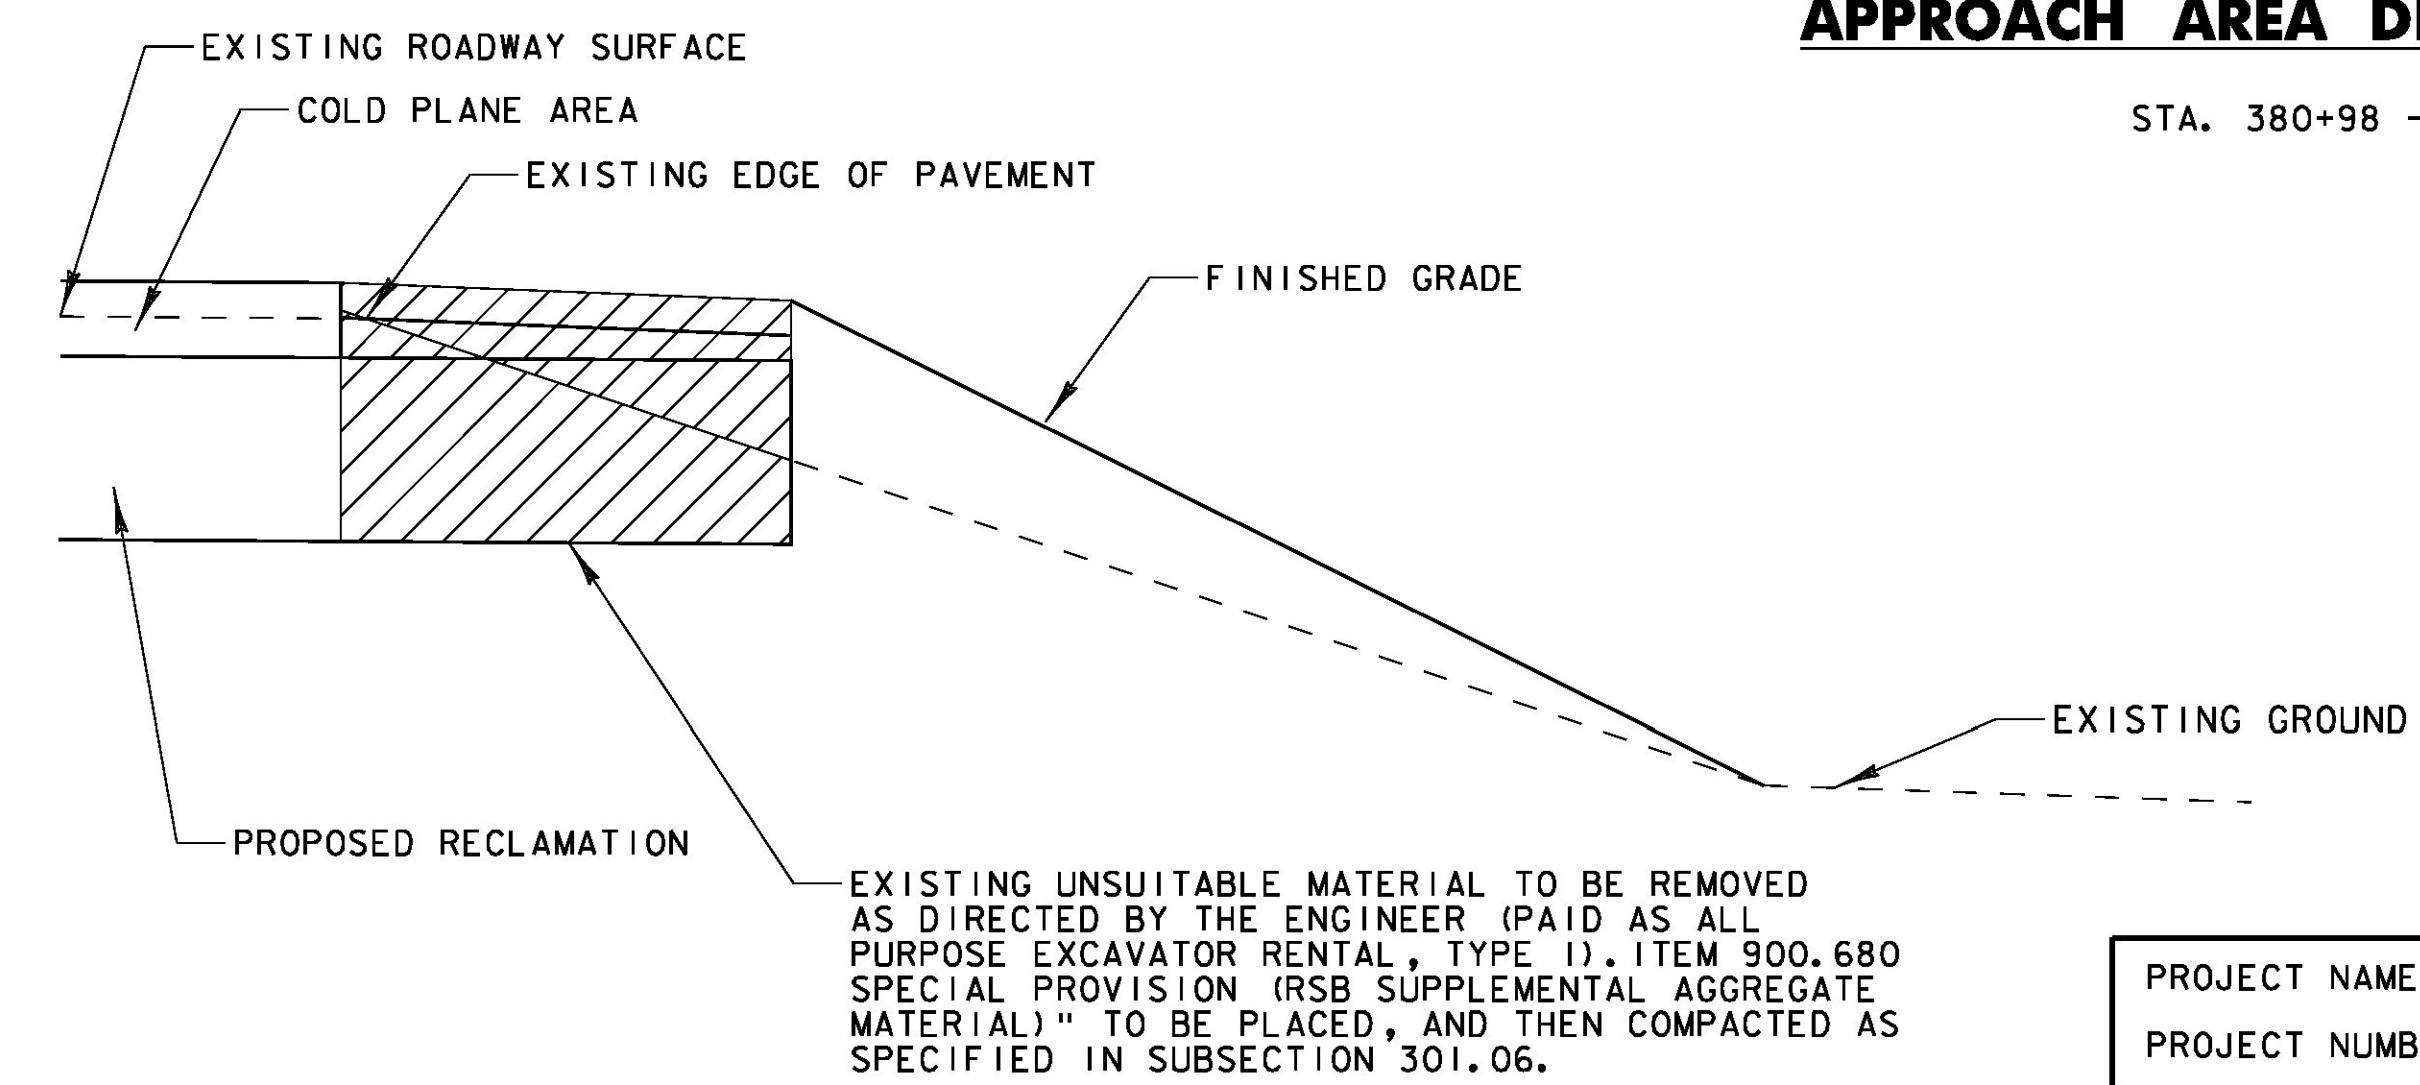
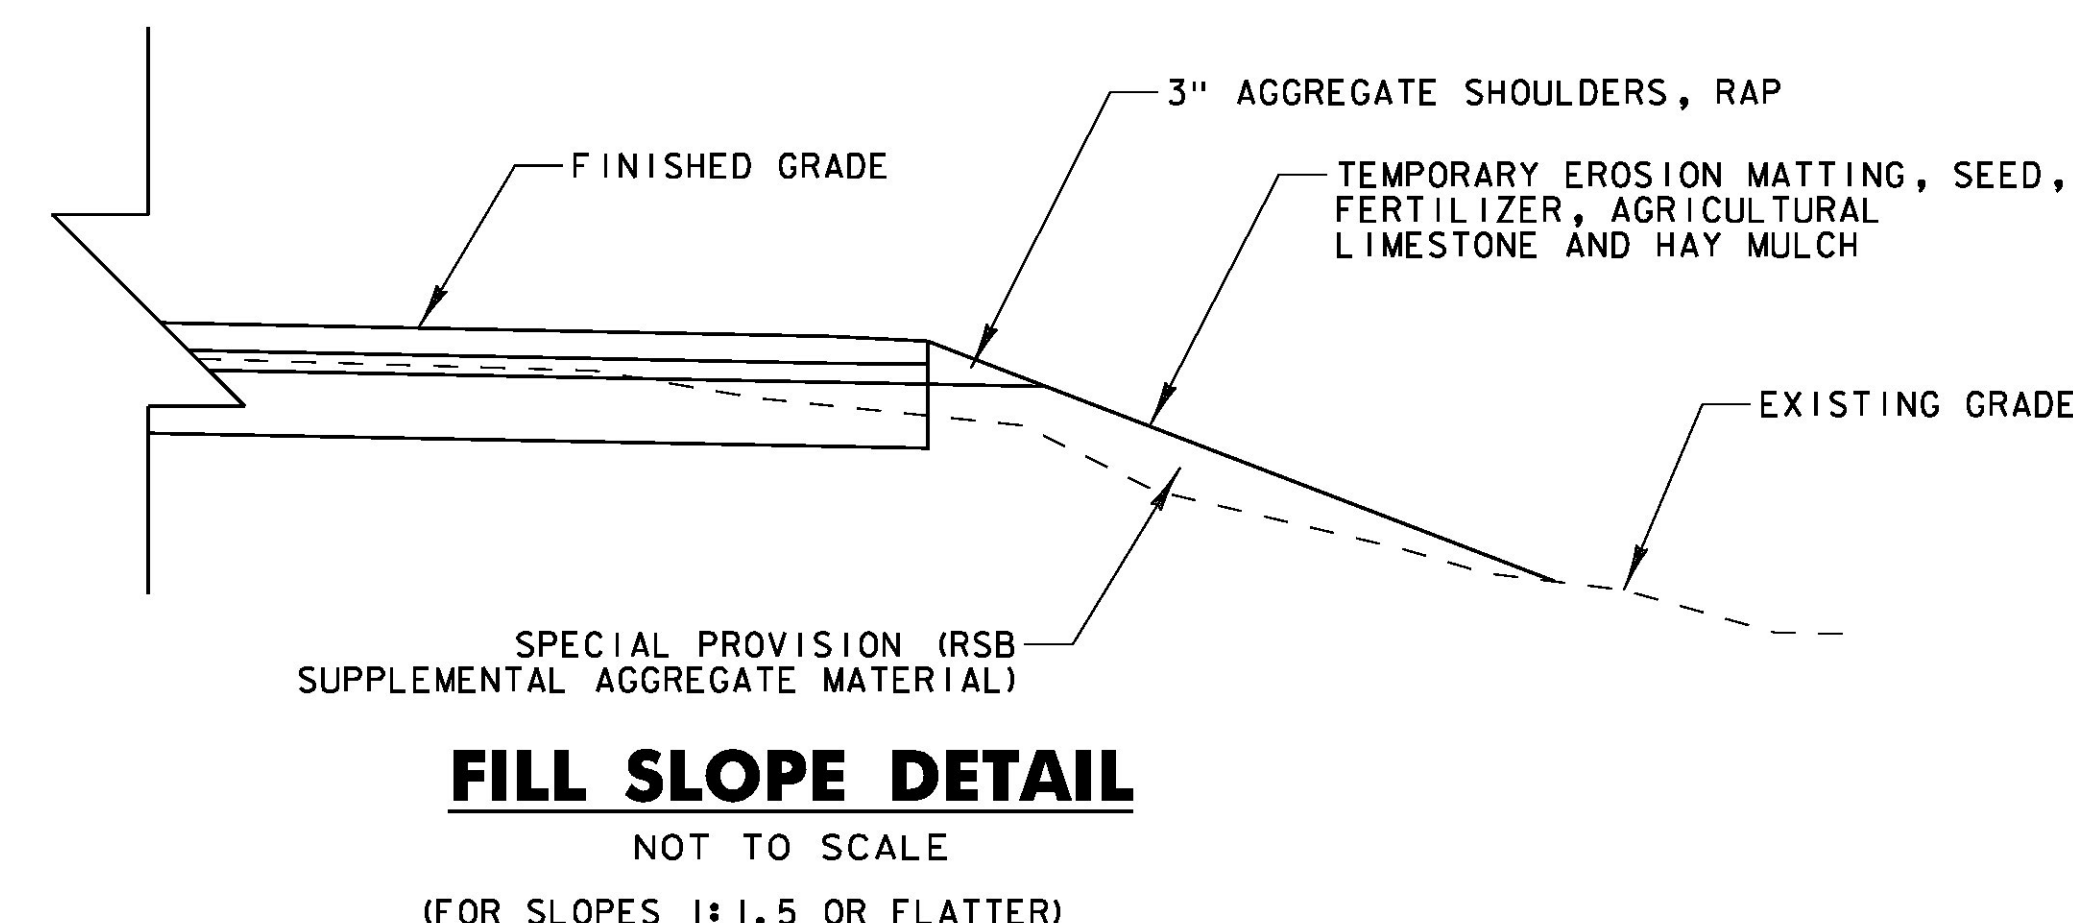
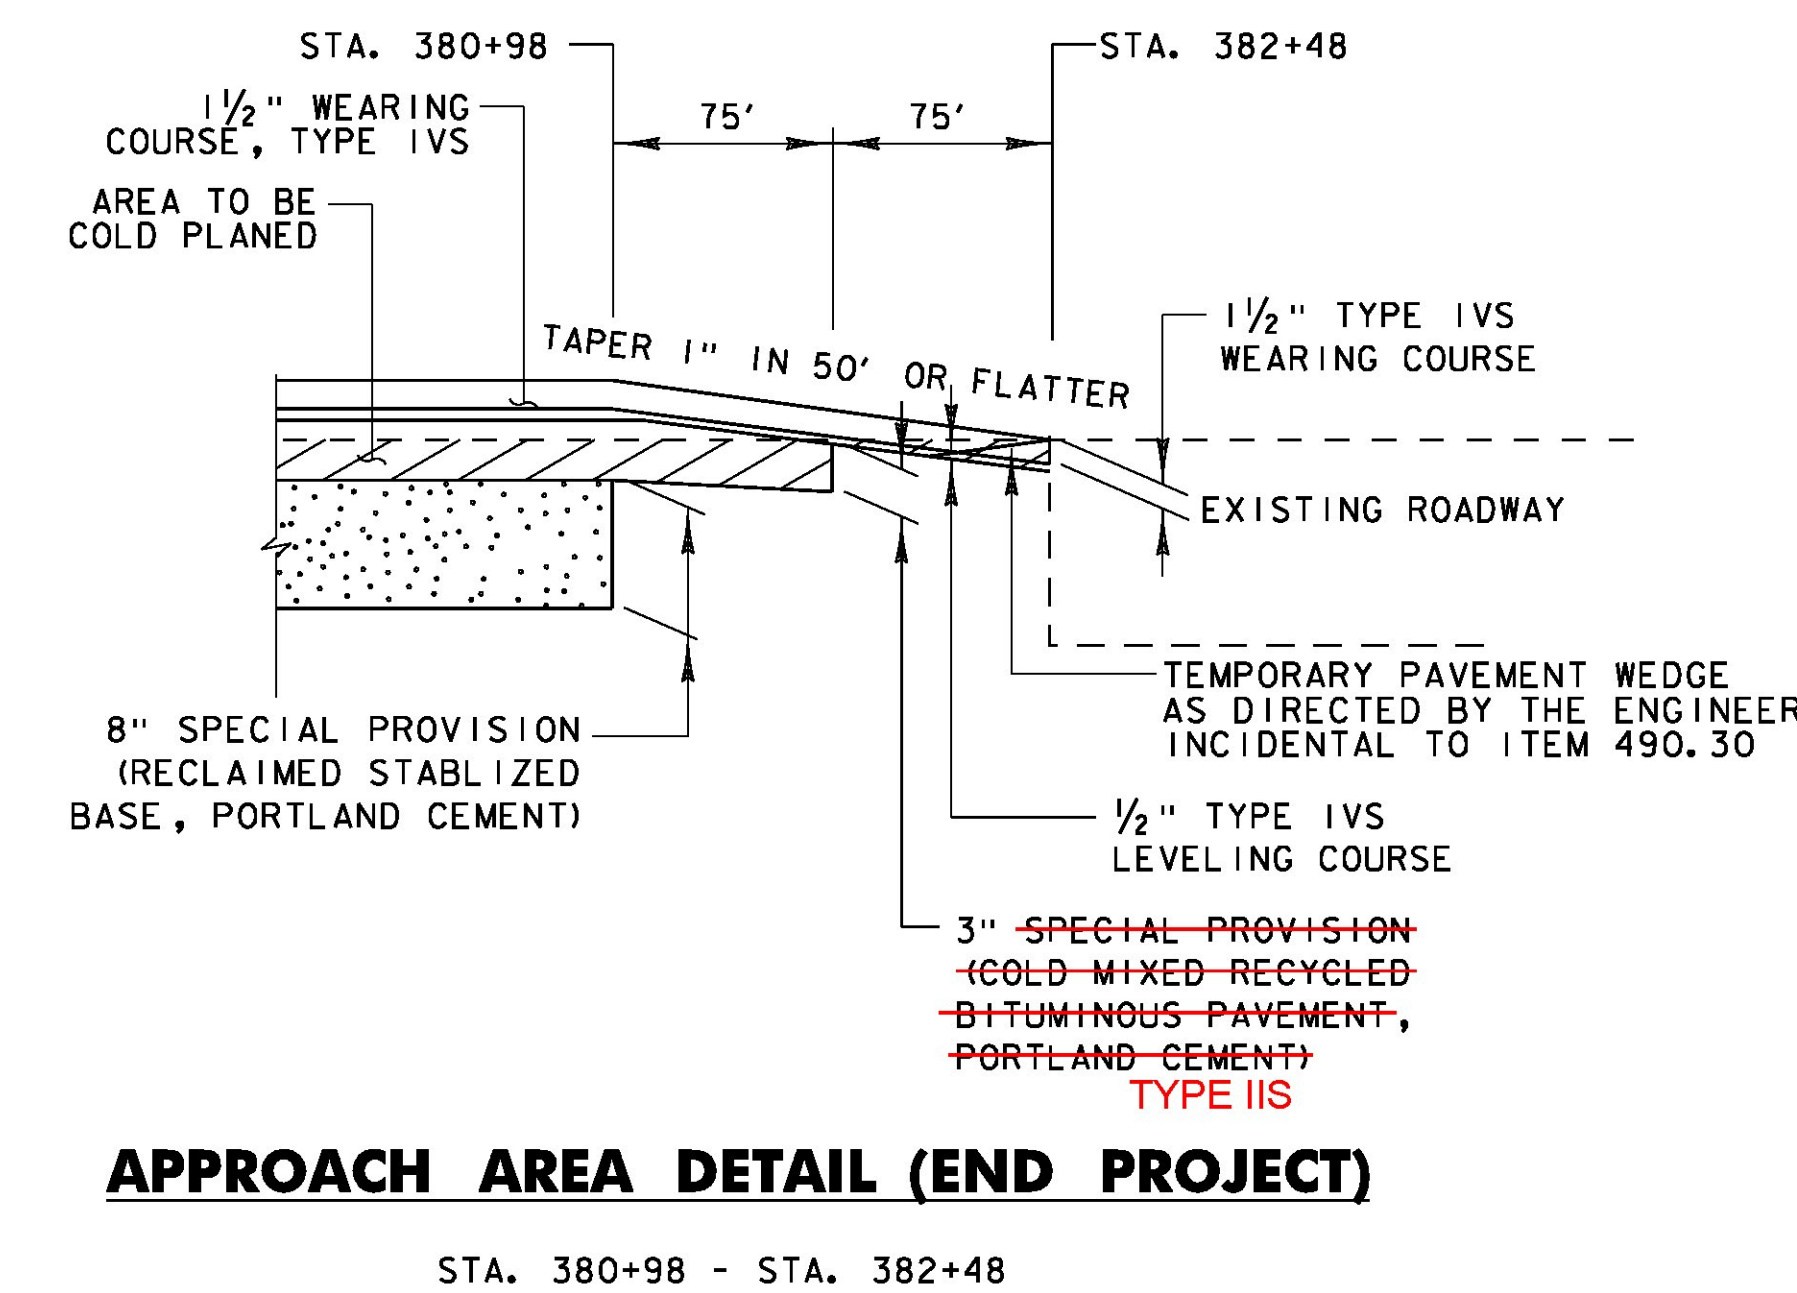


FULL WIDTH OF TOWN HIGHWAY
 SEE LAYOUT SHEETS FOR LOCATIONS OF ALL SIDE ROADS

TH #2	STA. 223+21	LT
TH #17	STA. 257+99	RT
TH #3	STA. 269+23	LT
TH #16	STA. 279+41	LT
TH #5	STA. 319+17	LT

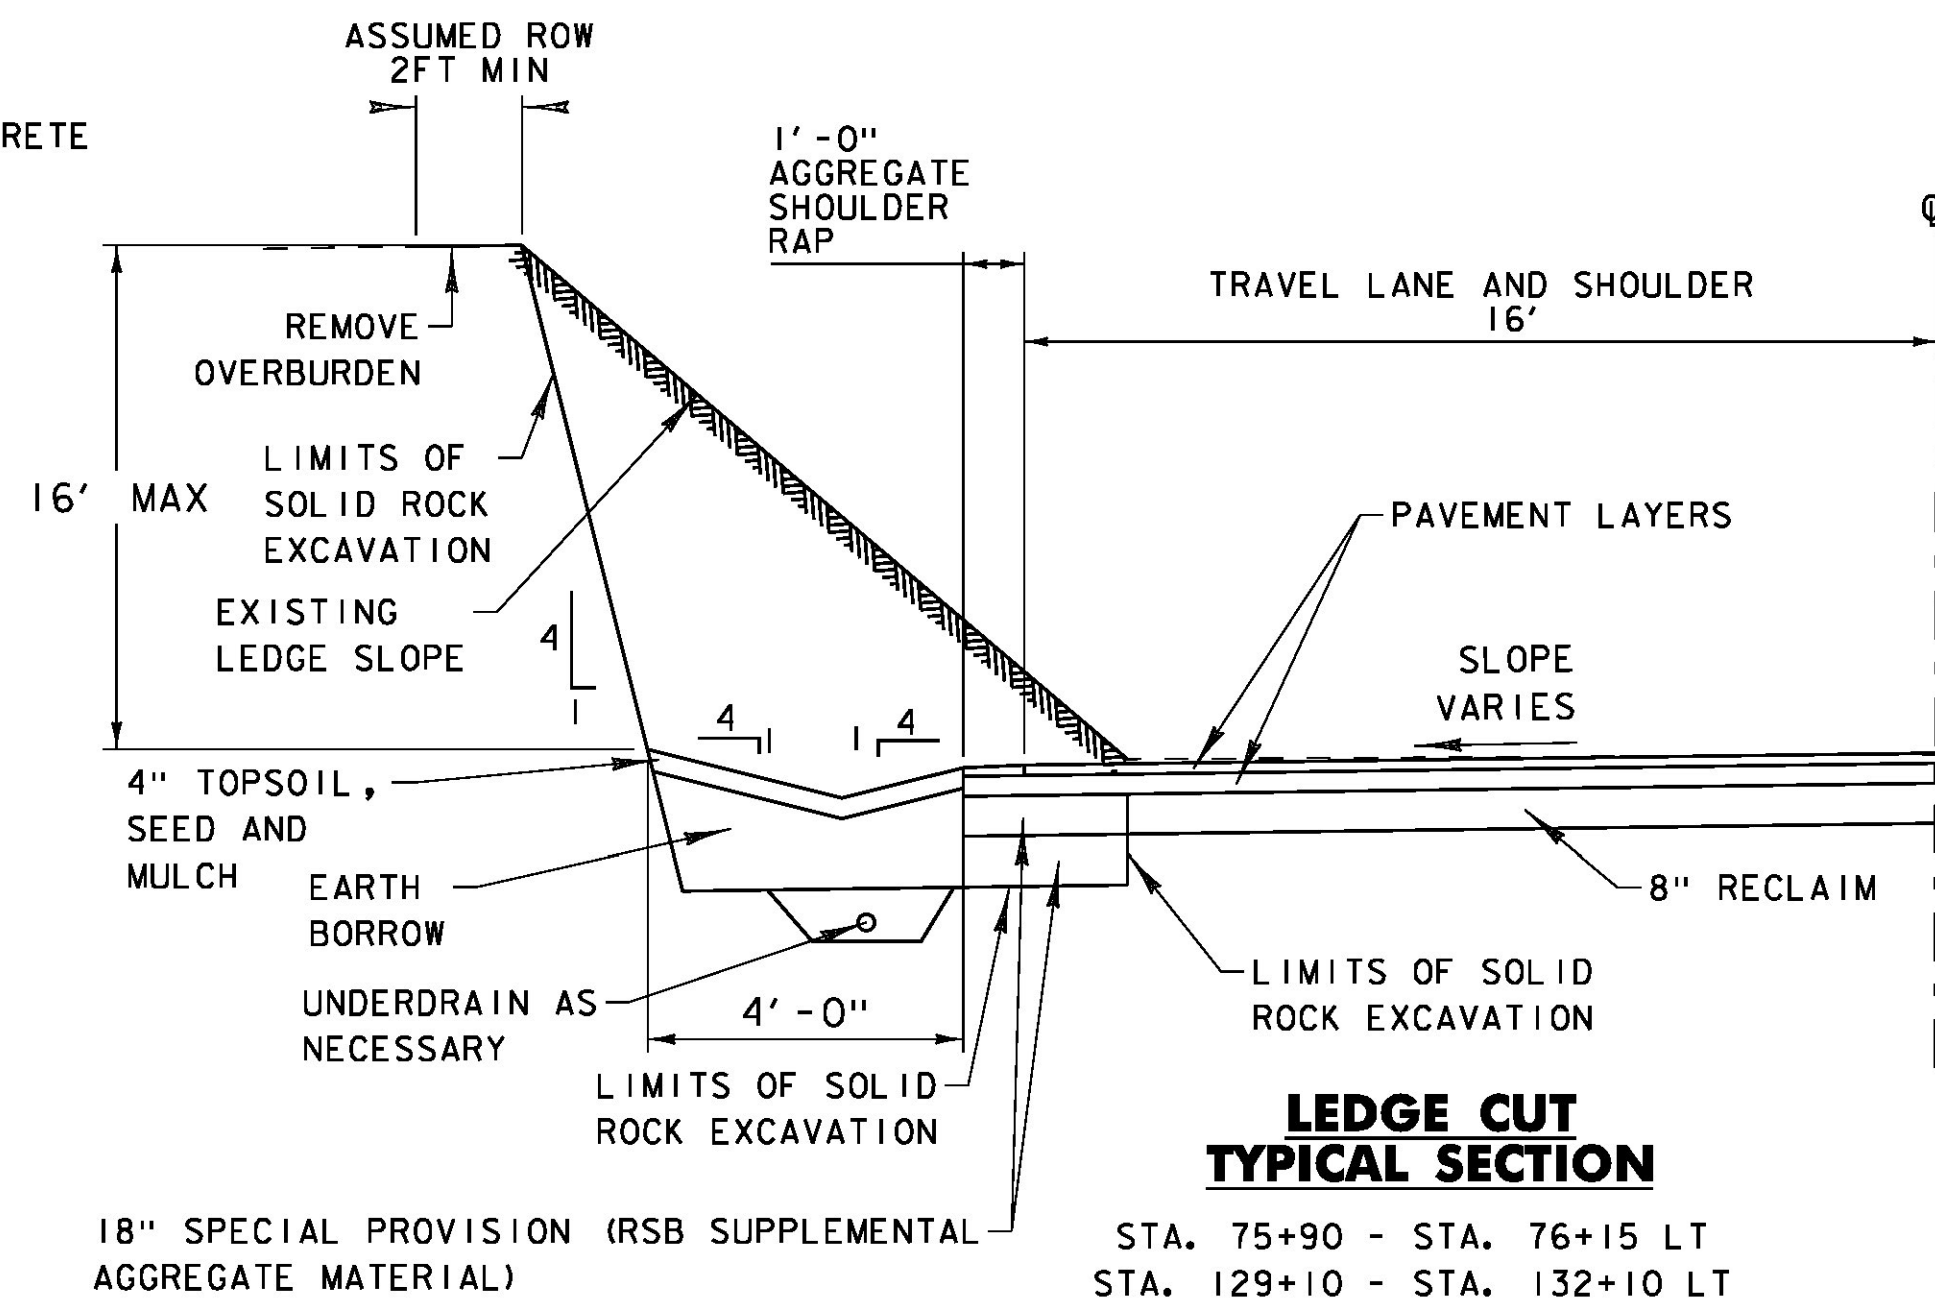

NOTE: IF DUE TO GROWING SEASON TIME CONSTRAINTS IT IS DEEMED NECESSARY BY THE CONSTRUCTION ENVIRONMENTAL ENGINEER THAT A MORE RAPID VEGETATION ESTABLISHMENT IS REQUIRED, PLACEMENT OF 2" OF GRUBBING MATERIAL SHALL BE PLACED ON THE SLOPE PRIOR TO PLACEMENT OF SEED, FERTILIZER, TEMPORARY EROSION MATTING, AND AGRICULTURAL LIMESTONE. PLACEMENT OF THE GRUBBING MATERIAL WILL BE PAID FOR AT THE CONTRACT UNIT PRICE PER SQUARE YARD OF ITEM 651.40 "GRUBBING MATERIAL (2)".

PROJECT NAME:	HANCOCK
PROJECT NUMBER:	STP 2923 (1)
FILE NAME:	z10c252typ.dgn
PROJECT LEADER:	C. LATHROP
DESIGNED BY:	B. MARTIN
PROJECT TYPICAL SHEET 2	
PLOT DATE:	3/18/2015
DRAWN BY:	J. GOODALL
CHECKED BY:	C. LATHROP
SHEET 5 OF 207	