

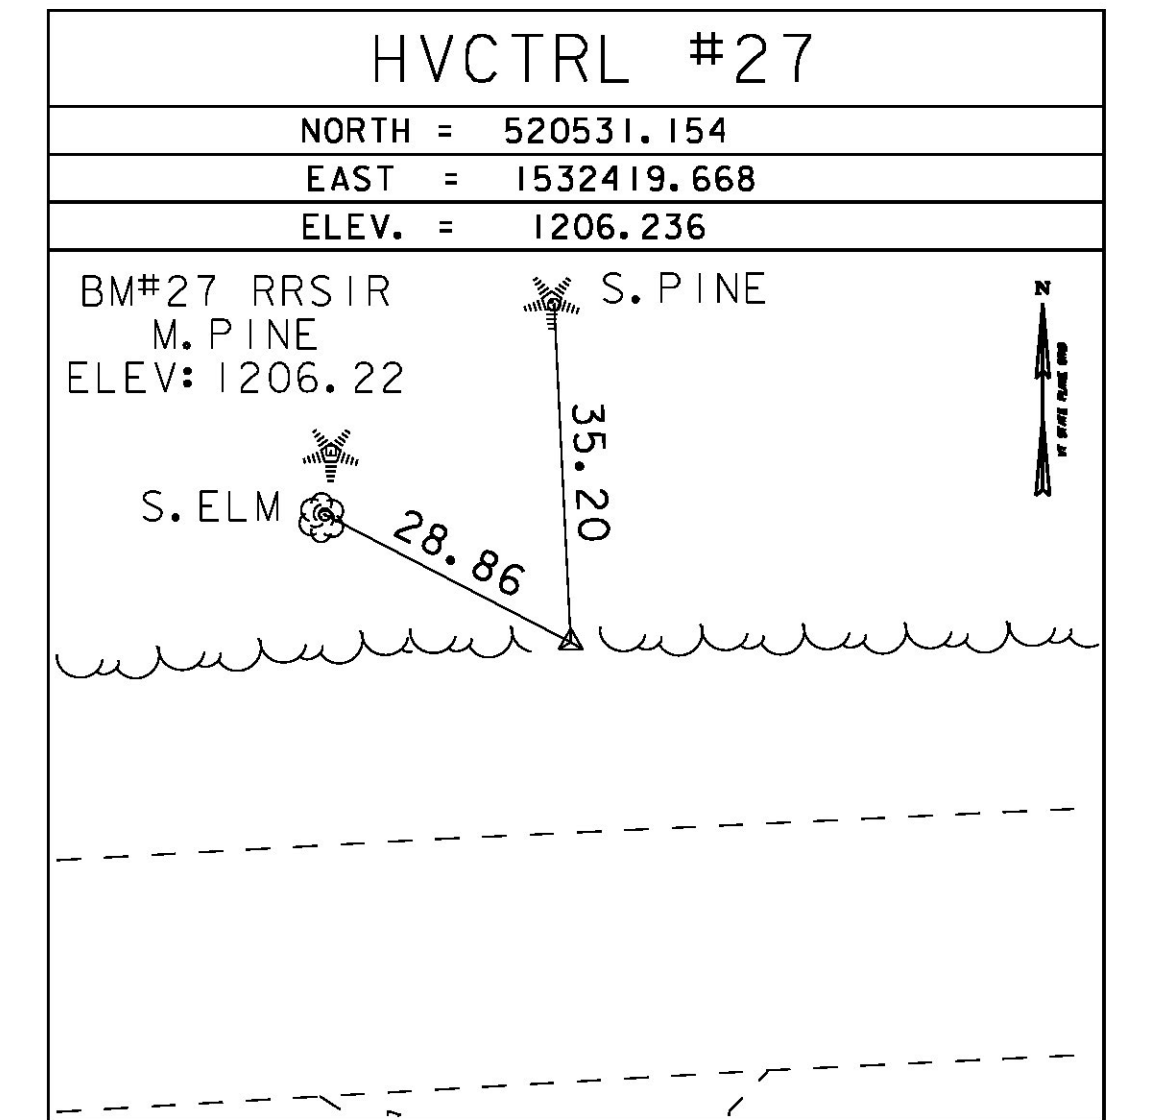
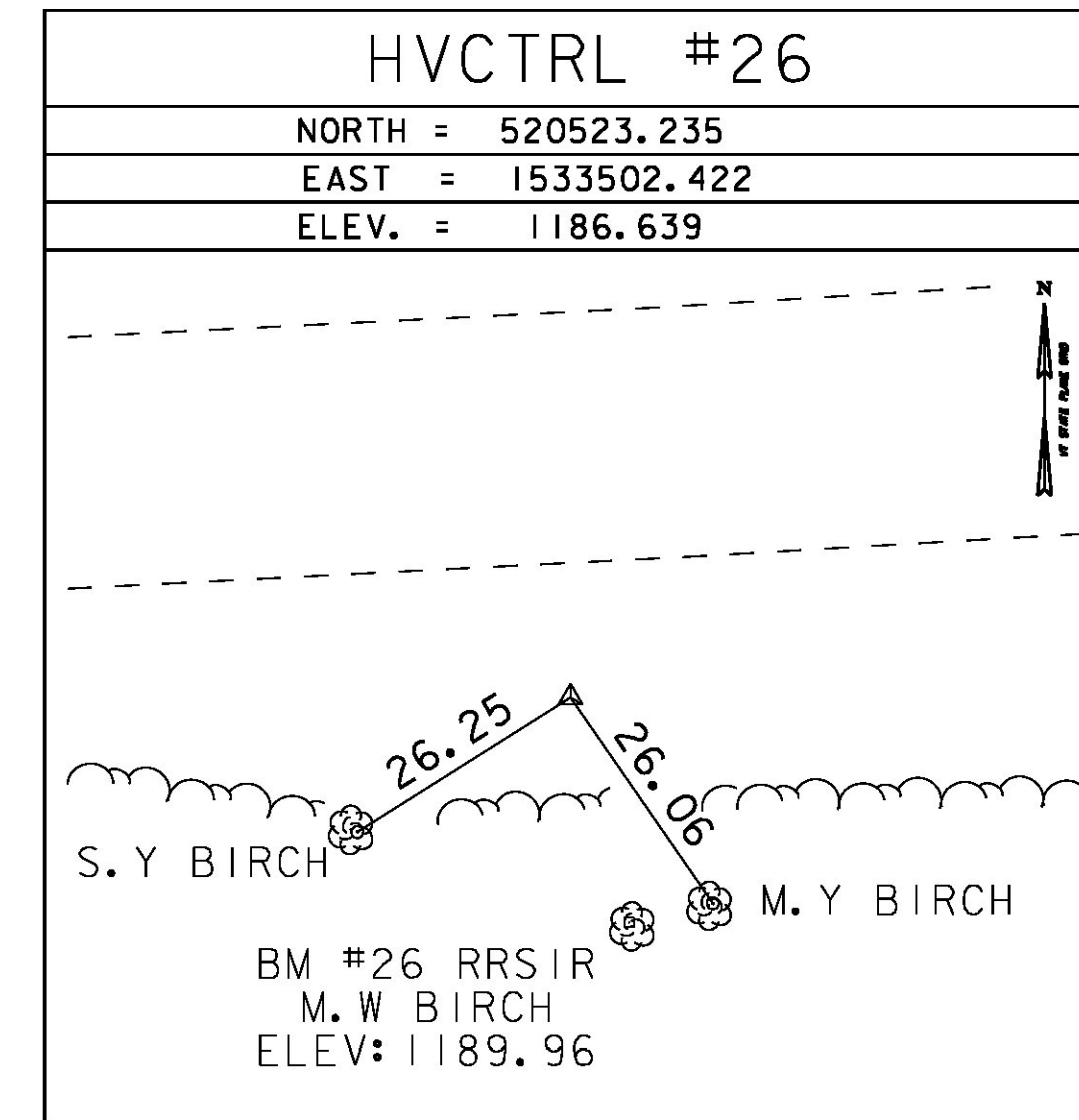
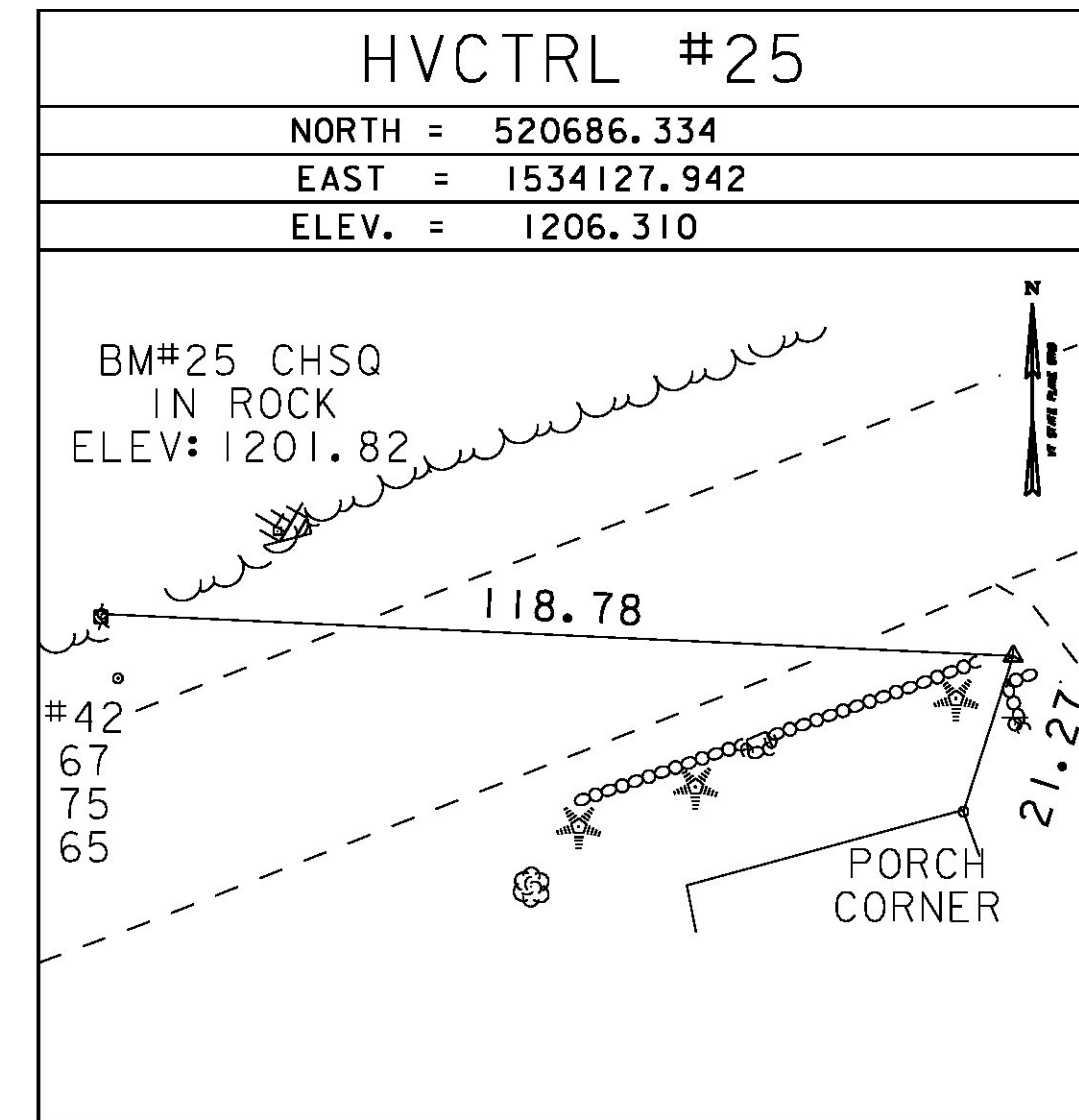
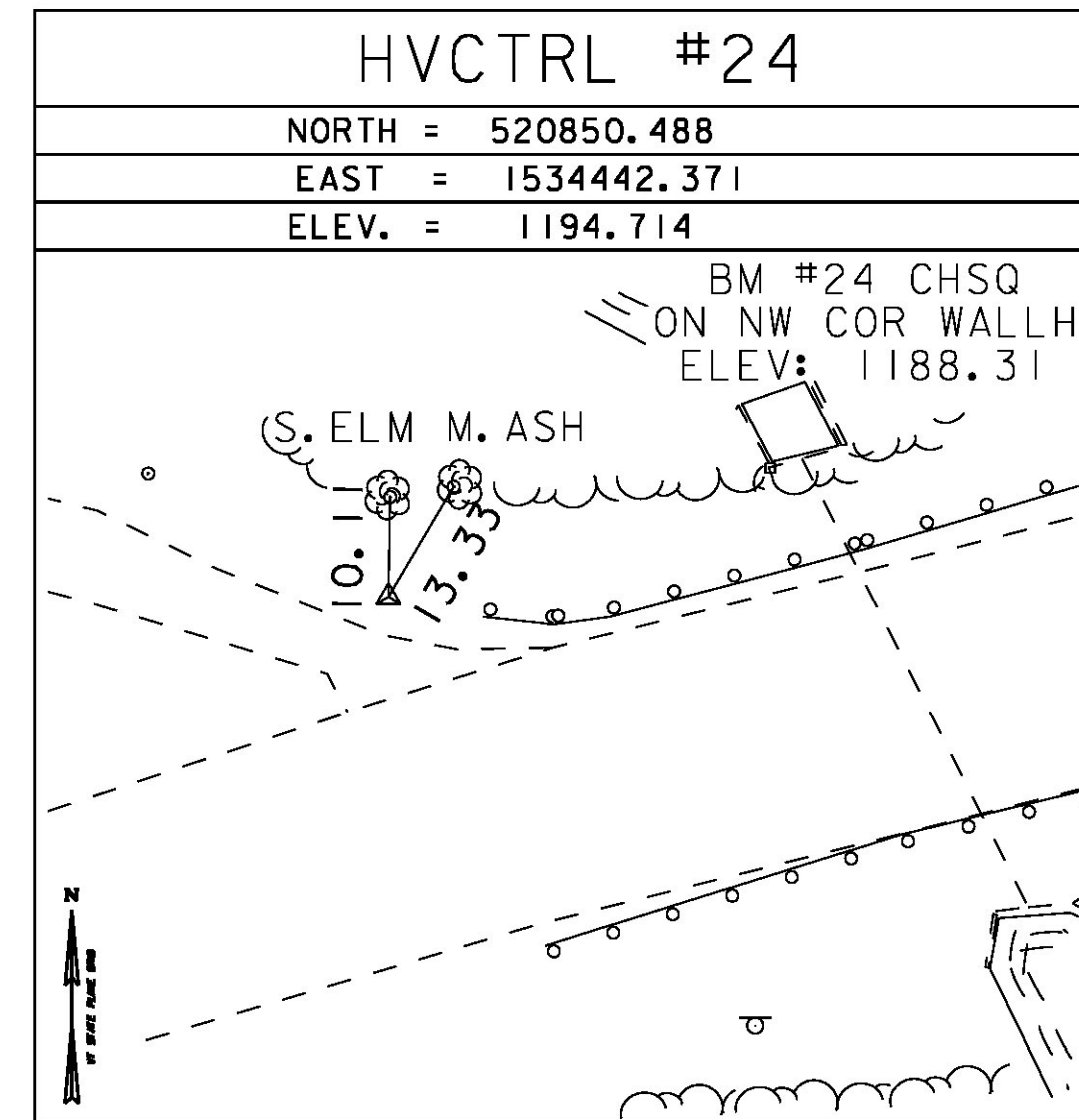
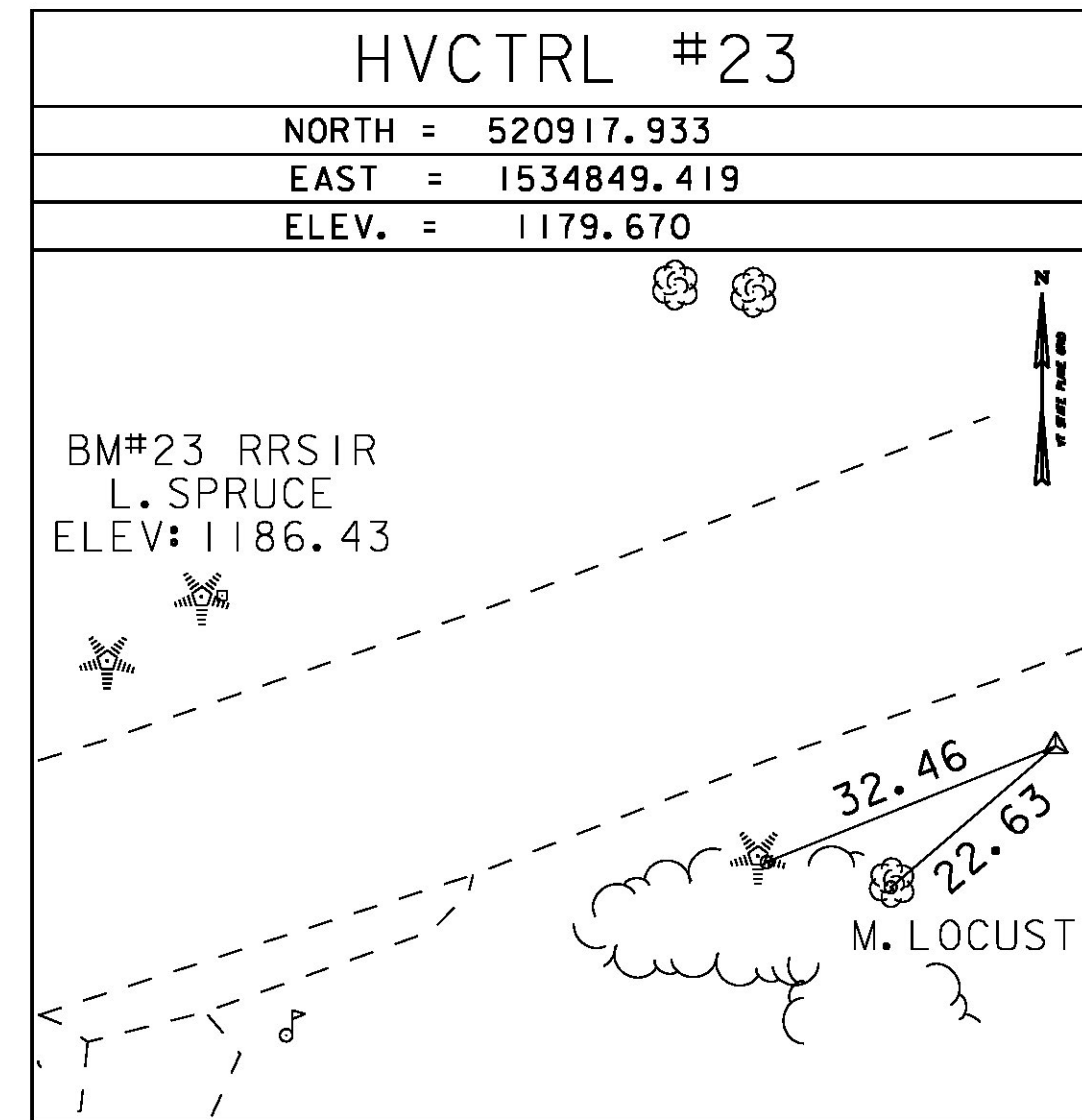
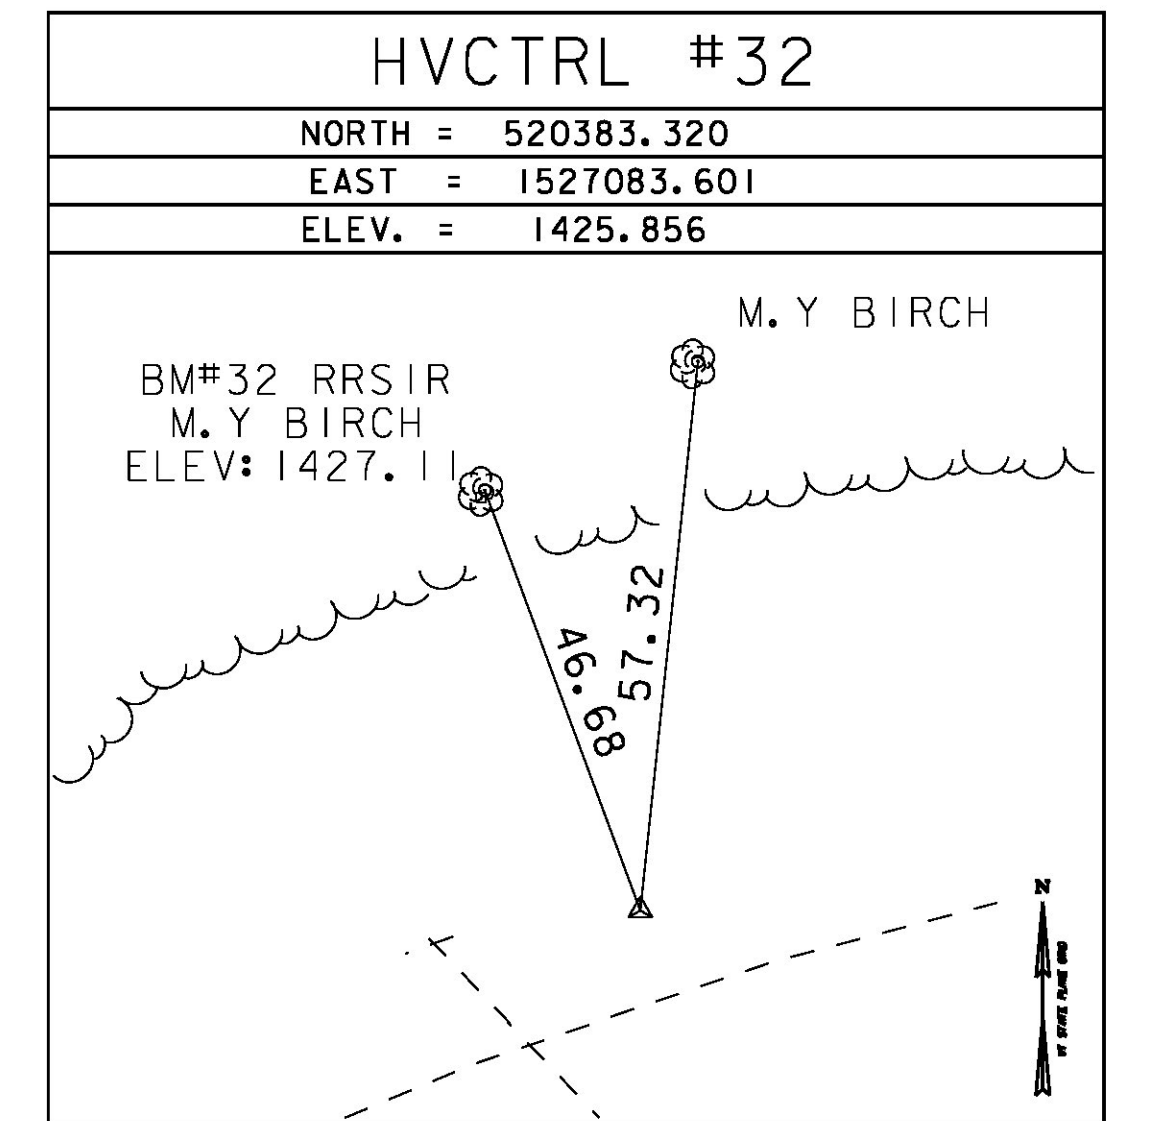
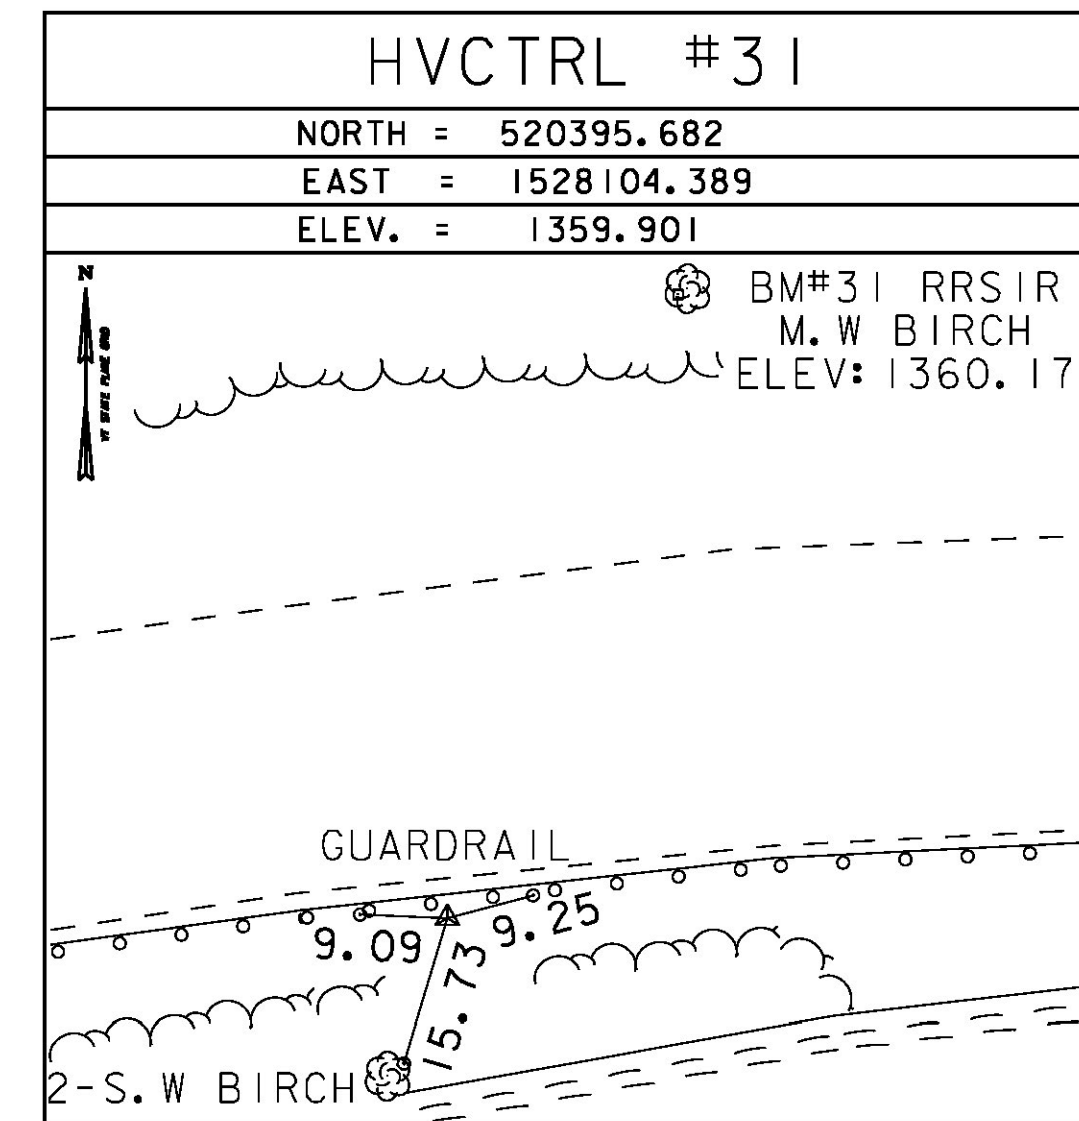
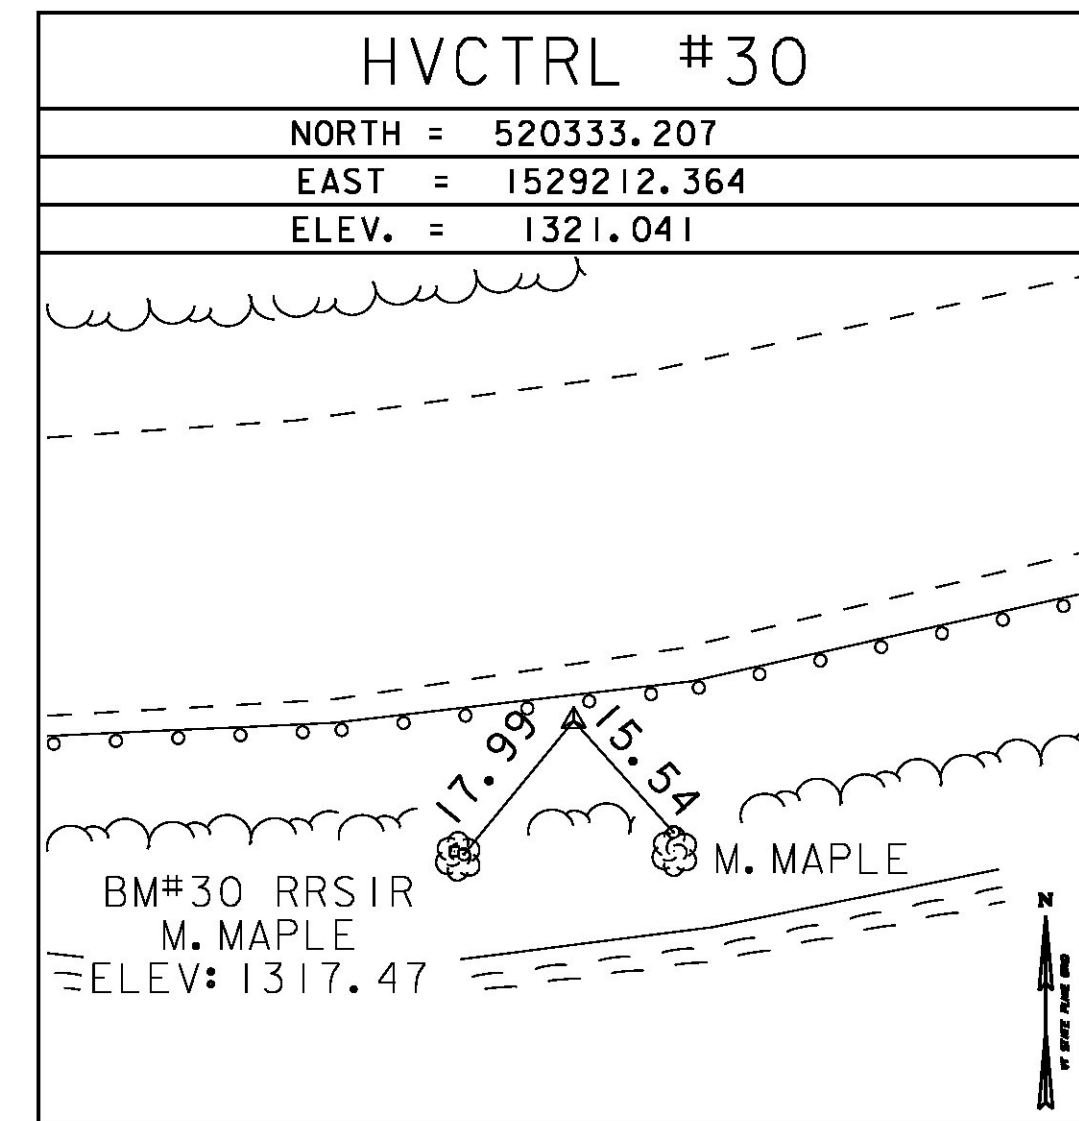







TRAVERSE TIES

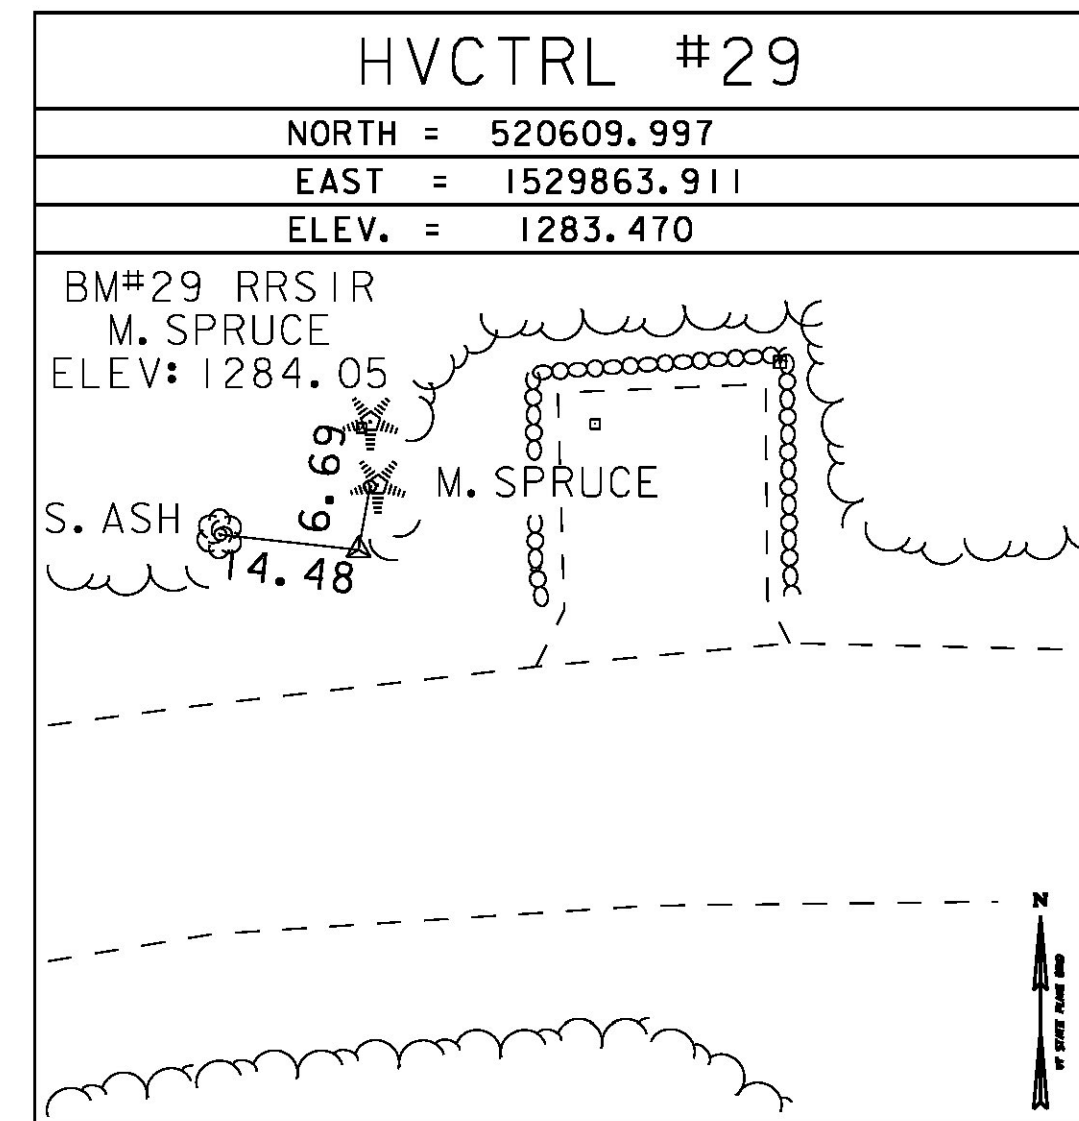

TRAVERSE TIES

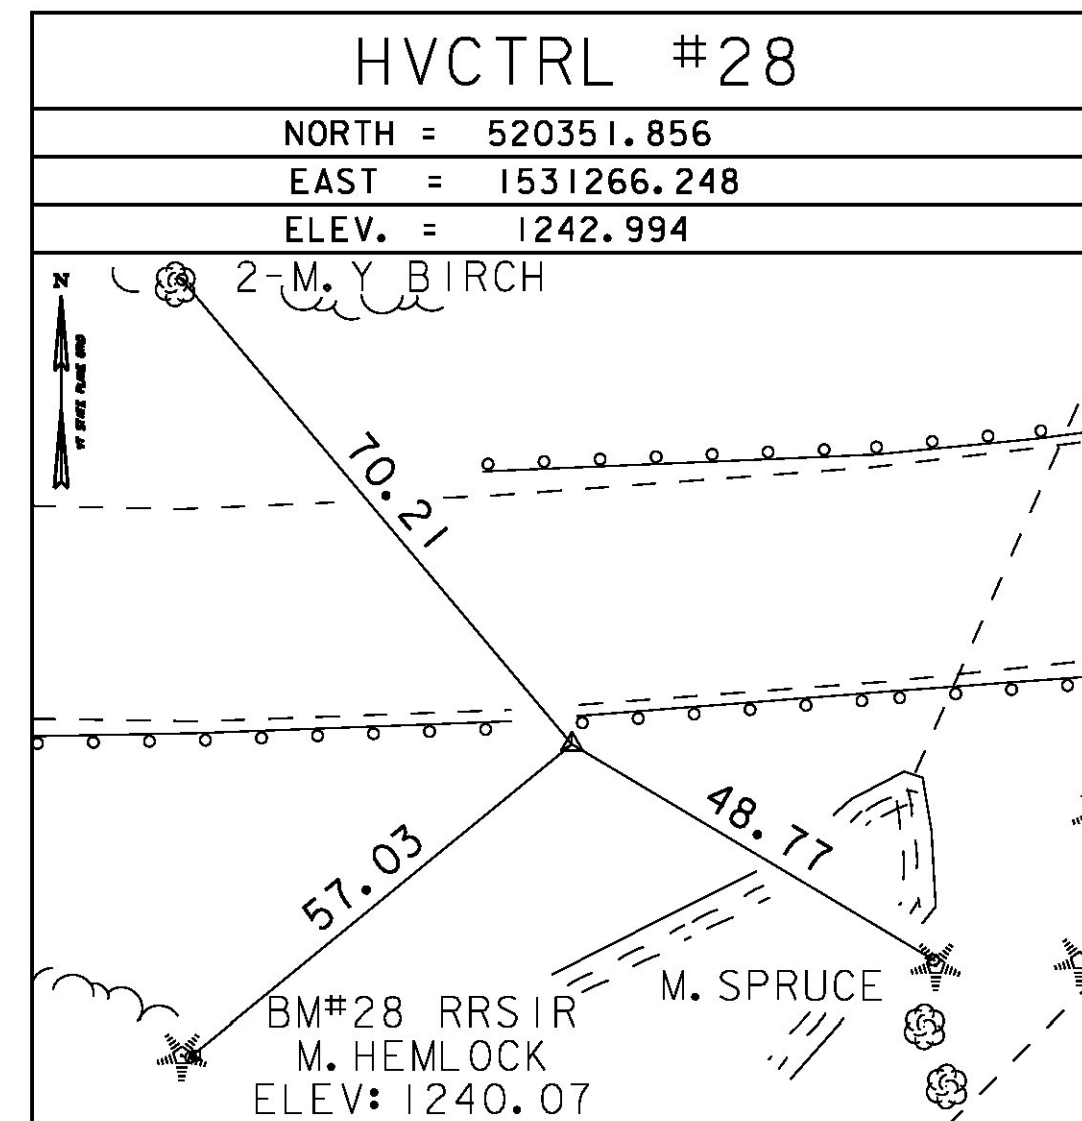

TRAVERSE TIES

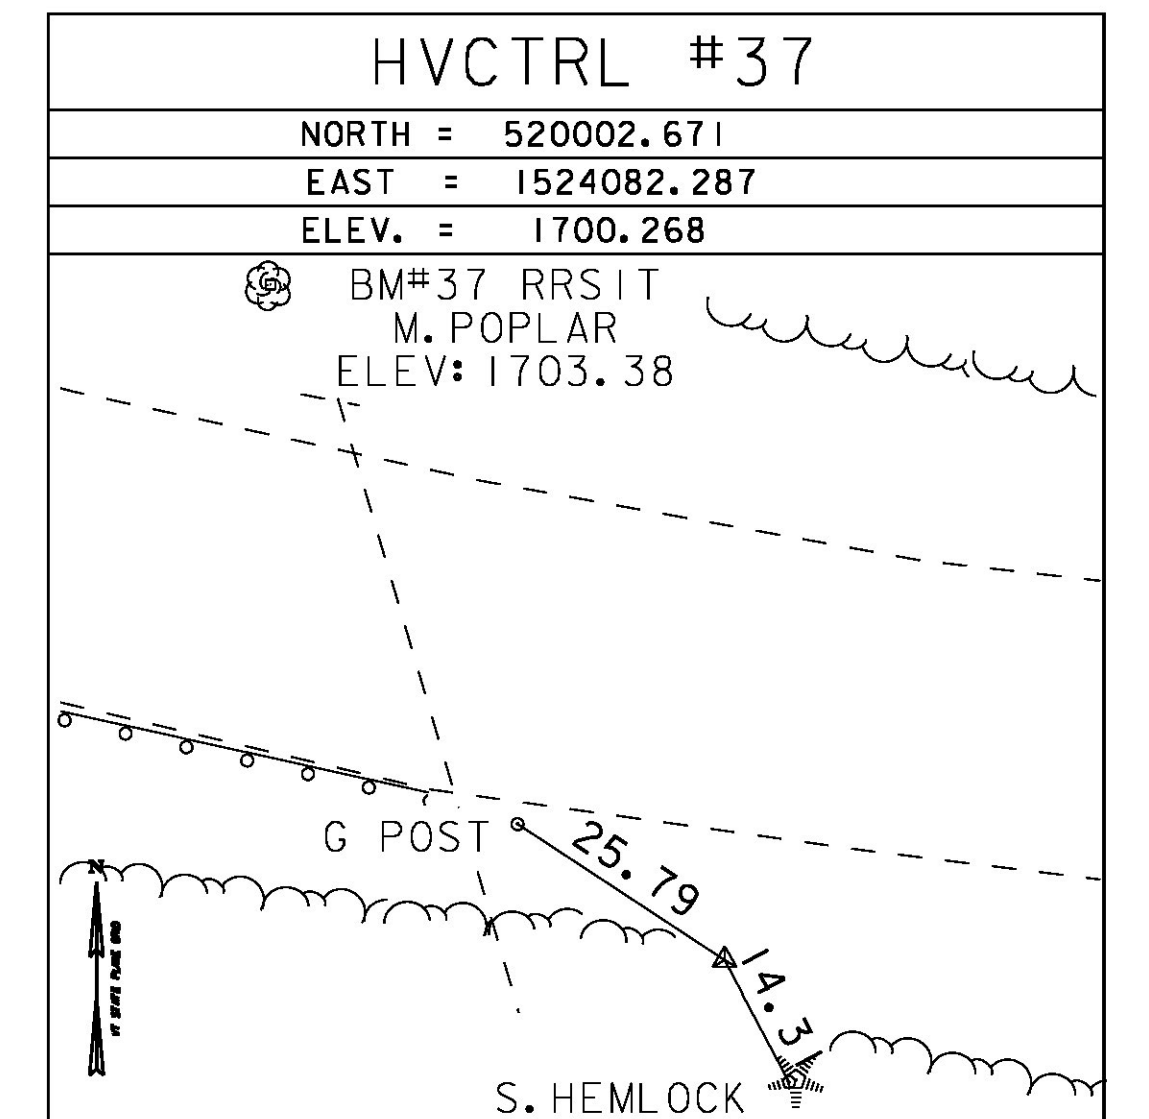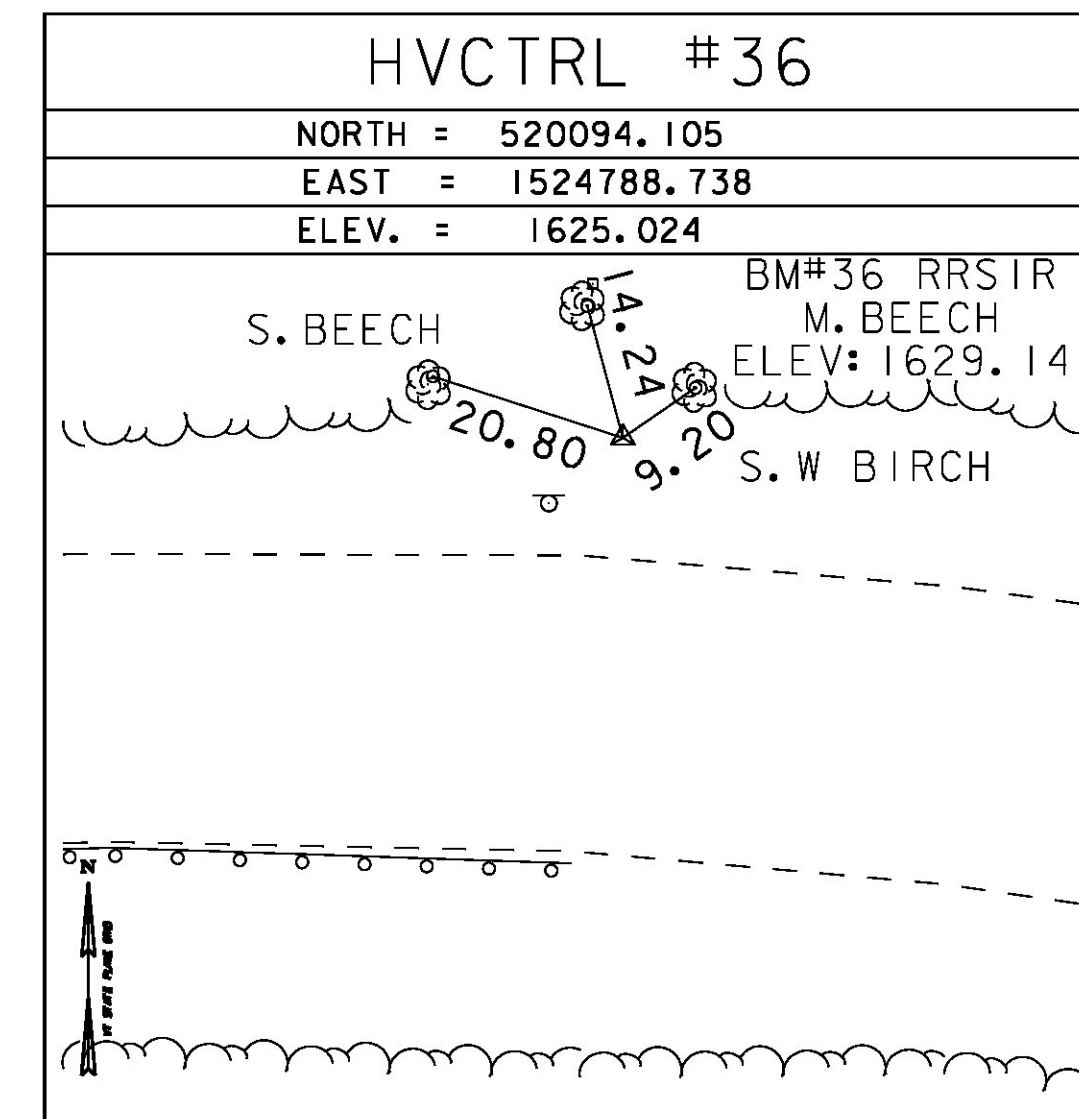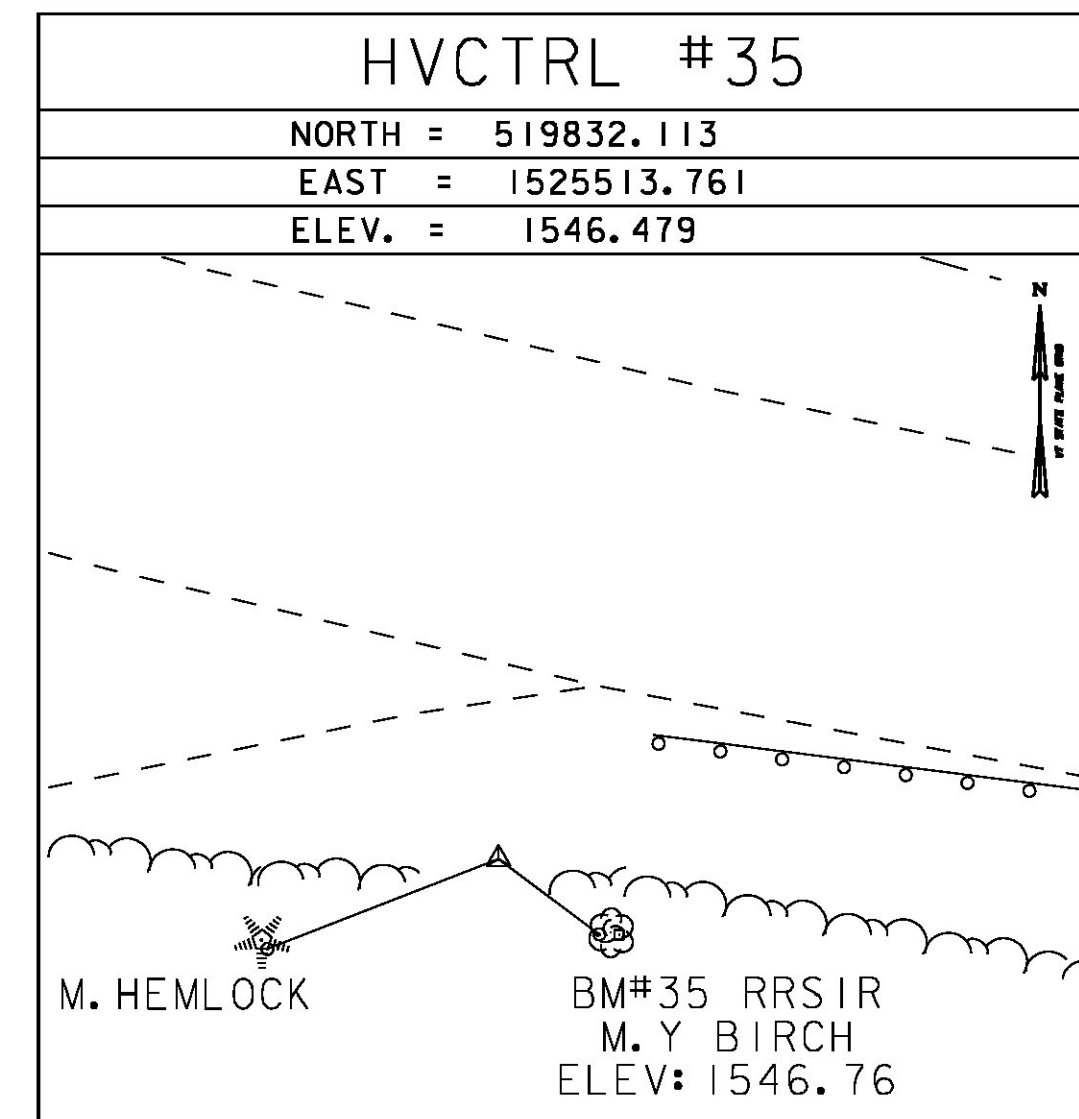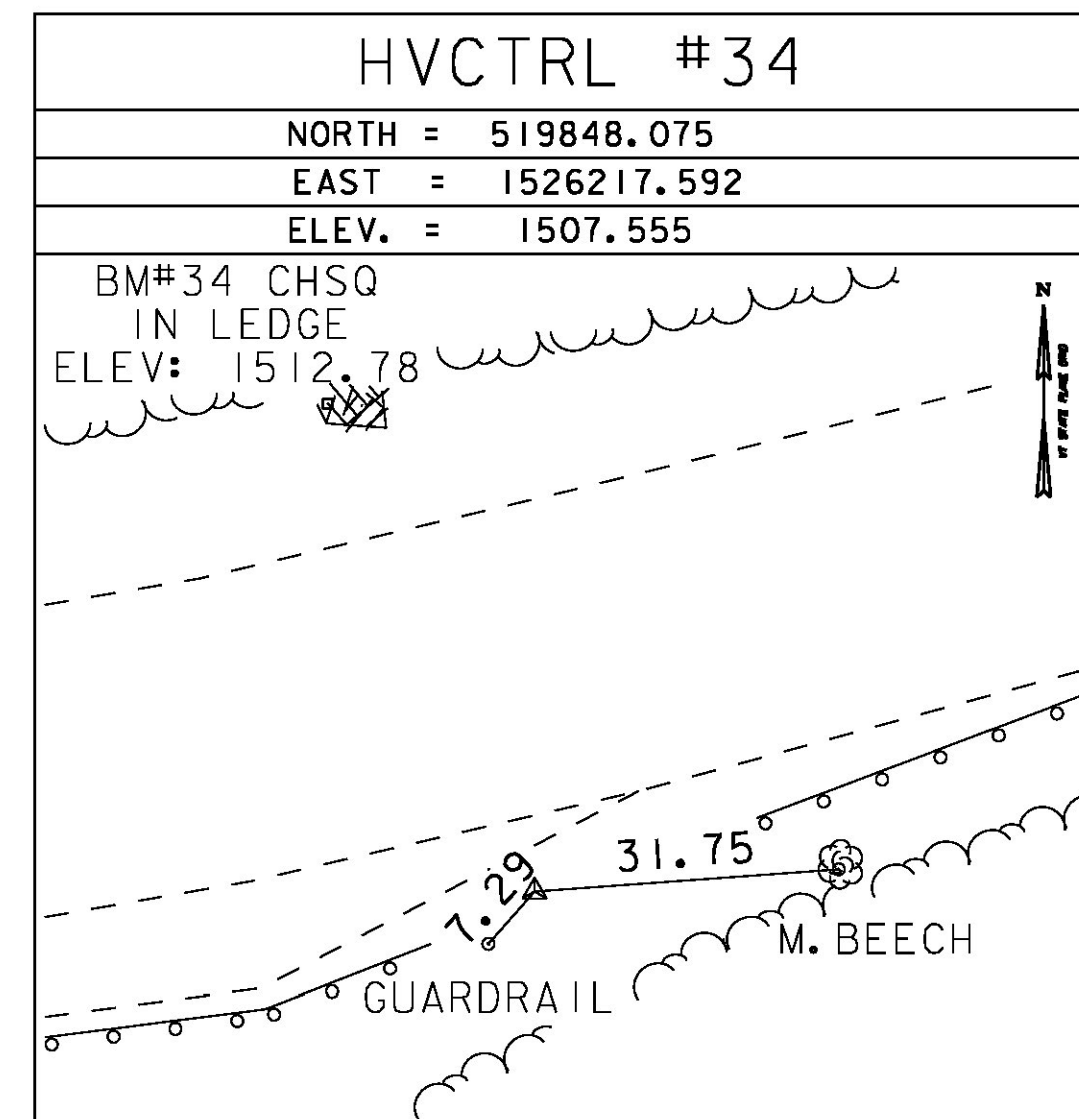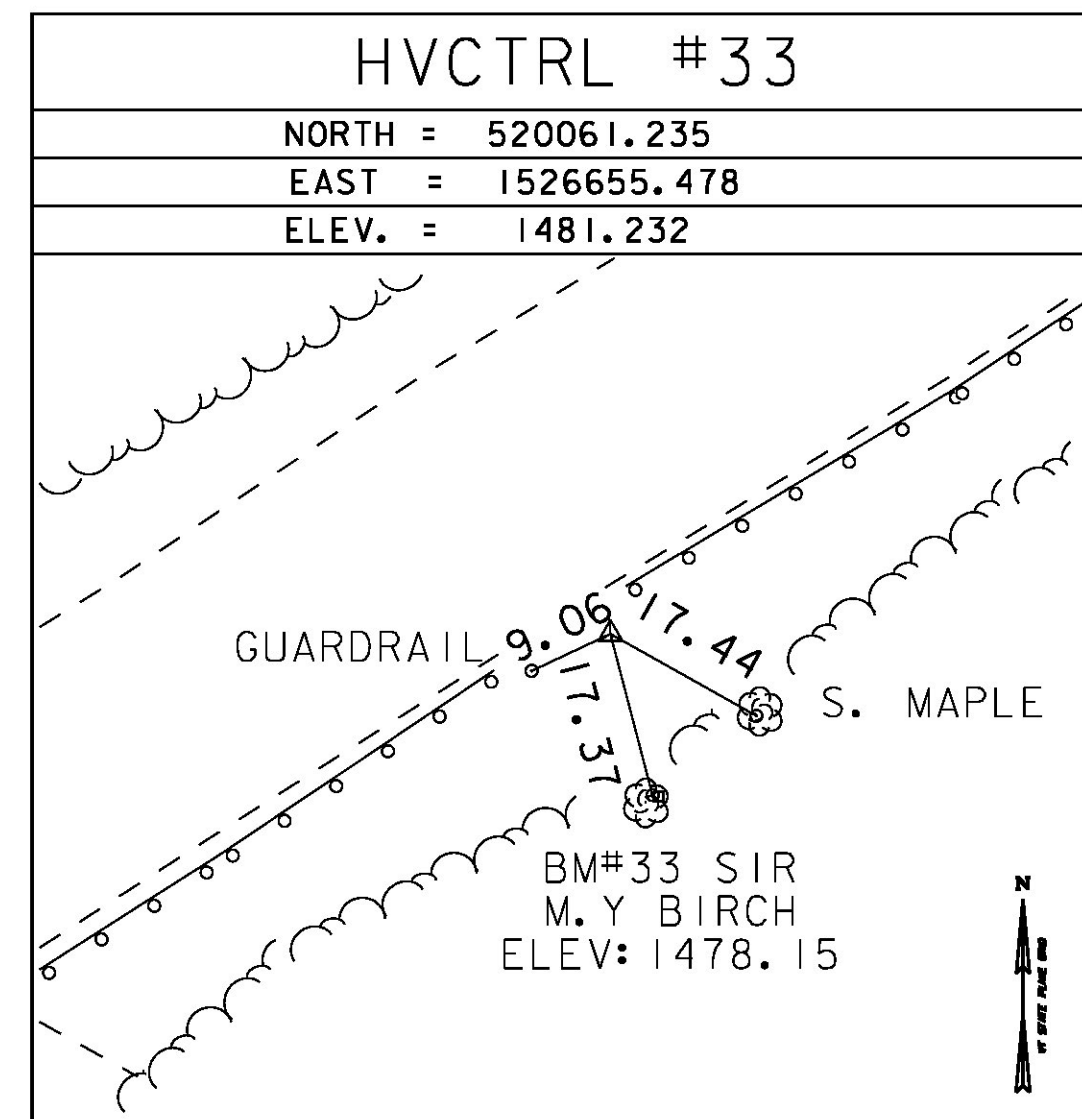

DATUM	
VERTICAL	NAVD 88
HORIZONTAL	NAD 83 CORS
ADJUSTMENT	COMPASS

PROJECT NAME:	HANCOCK	
PROJECT NUMBER:	STP 2923 (1)	
FILE NAME:	z10c252+i.dgn	PLOT DATE: 3/18/2015
PROJECT LEADER:	C. LATHROP	DRAWN BY: R. BULLOCK
DESIGNED BY:	VTRANS	CHECKED BY: VTRANS
TIE SHEET 3		SHEET 13 OF 207