

SOLID ROCK EXCAVATION  
 STA. 129+10 - STA. 130+25 LT

6 INCH UNDERDRAIN PIPE  
 STA. 126+00 - STA. 130+25 LT

STONE FILL, TYPE I  
 STA. 126+10 - STA. 126+60 RT

REMOVAL AND DISPOSAL OF GUARDRAIL  
 STA. 125+25 - STA. 130+25 RT

DURABLE 4 INCH WHITE LINE (SEE OPTION ITEMS)  
 STA. 125+25 - STA. 130+25 (SOLID LT & RT)

DURABLE 4 INCH YELLOW LINE (SEE OPTION ITEMS)  
 STA. 125+25 - STA. 130+25 (SOLID LT & RT)

TEMPORARY 4 INCH WHITE LINE, PAINT  
 STA. 125+25 - STA. 130+25 (SOLID LT & RT)



TEMPORARY 4 INCH YELLOW LINE, PAINT  
 STA. 125+25 - STA. 130+25 (SOLID LT & RT)

GEOTEXTILE FOR SILT FENCE  
 STA. 126+10 - STA. 126+60 RT

GRUBBING MATERIAL (6")  
 STA. 126+10 - STA. 126+60 RT

SPECIAL PROVISION (BOX BEAM GUARDRAIL W/7 FEET POSTS)  
 STA. 125+25 - STA. 130+25 RT

CURVE #14  
 DELTA = 36°09'32"  
 D = 5°12'31" (1) D = 1°54'37" (2)  
 R = 1100.00' (1) R = 2999.14' (2)  
 T = 385.94' (1) T = 582.17' (2)  
 L = 552.05' (1) L = 387.57' (2)  
 E = 65.74'  
 BANKING 0.072 FT/FT, 0.037 FT/FT  
 DESIGN SPEED 50 MPH  
 SEE BANKING DIAGRAMS  
 FOR MORE INFORMATION

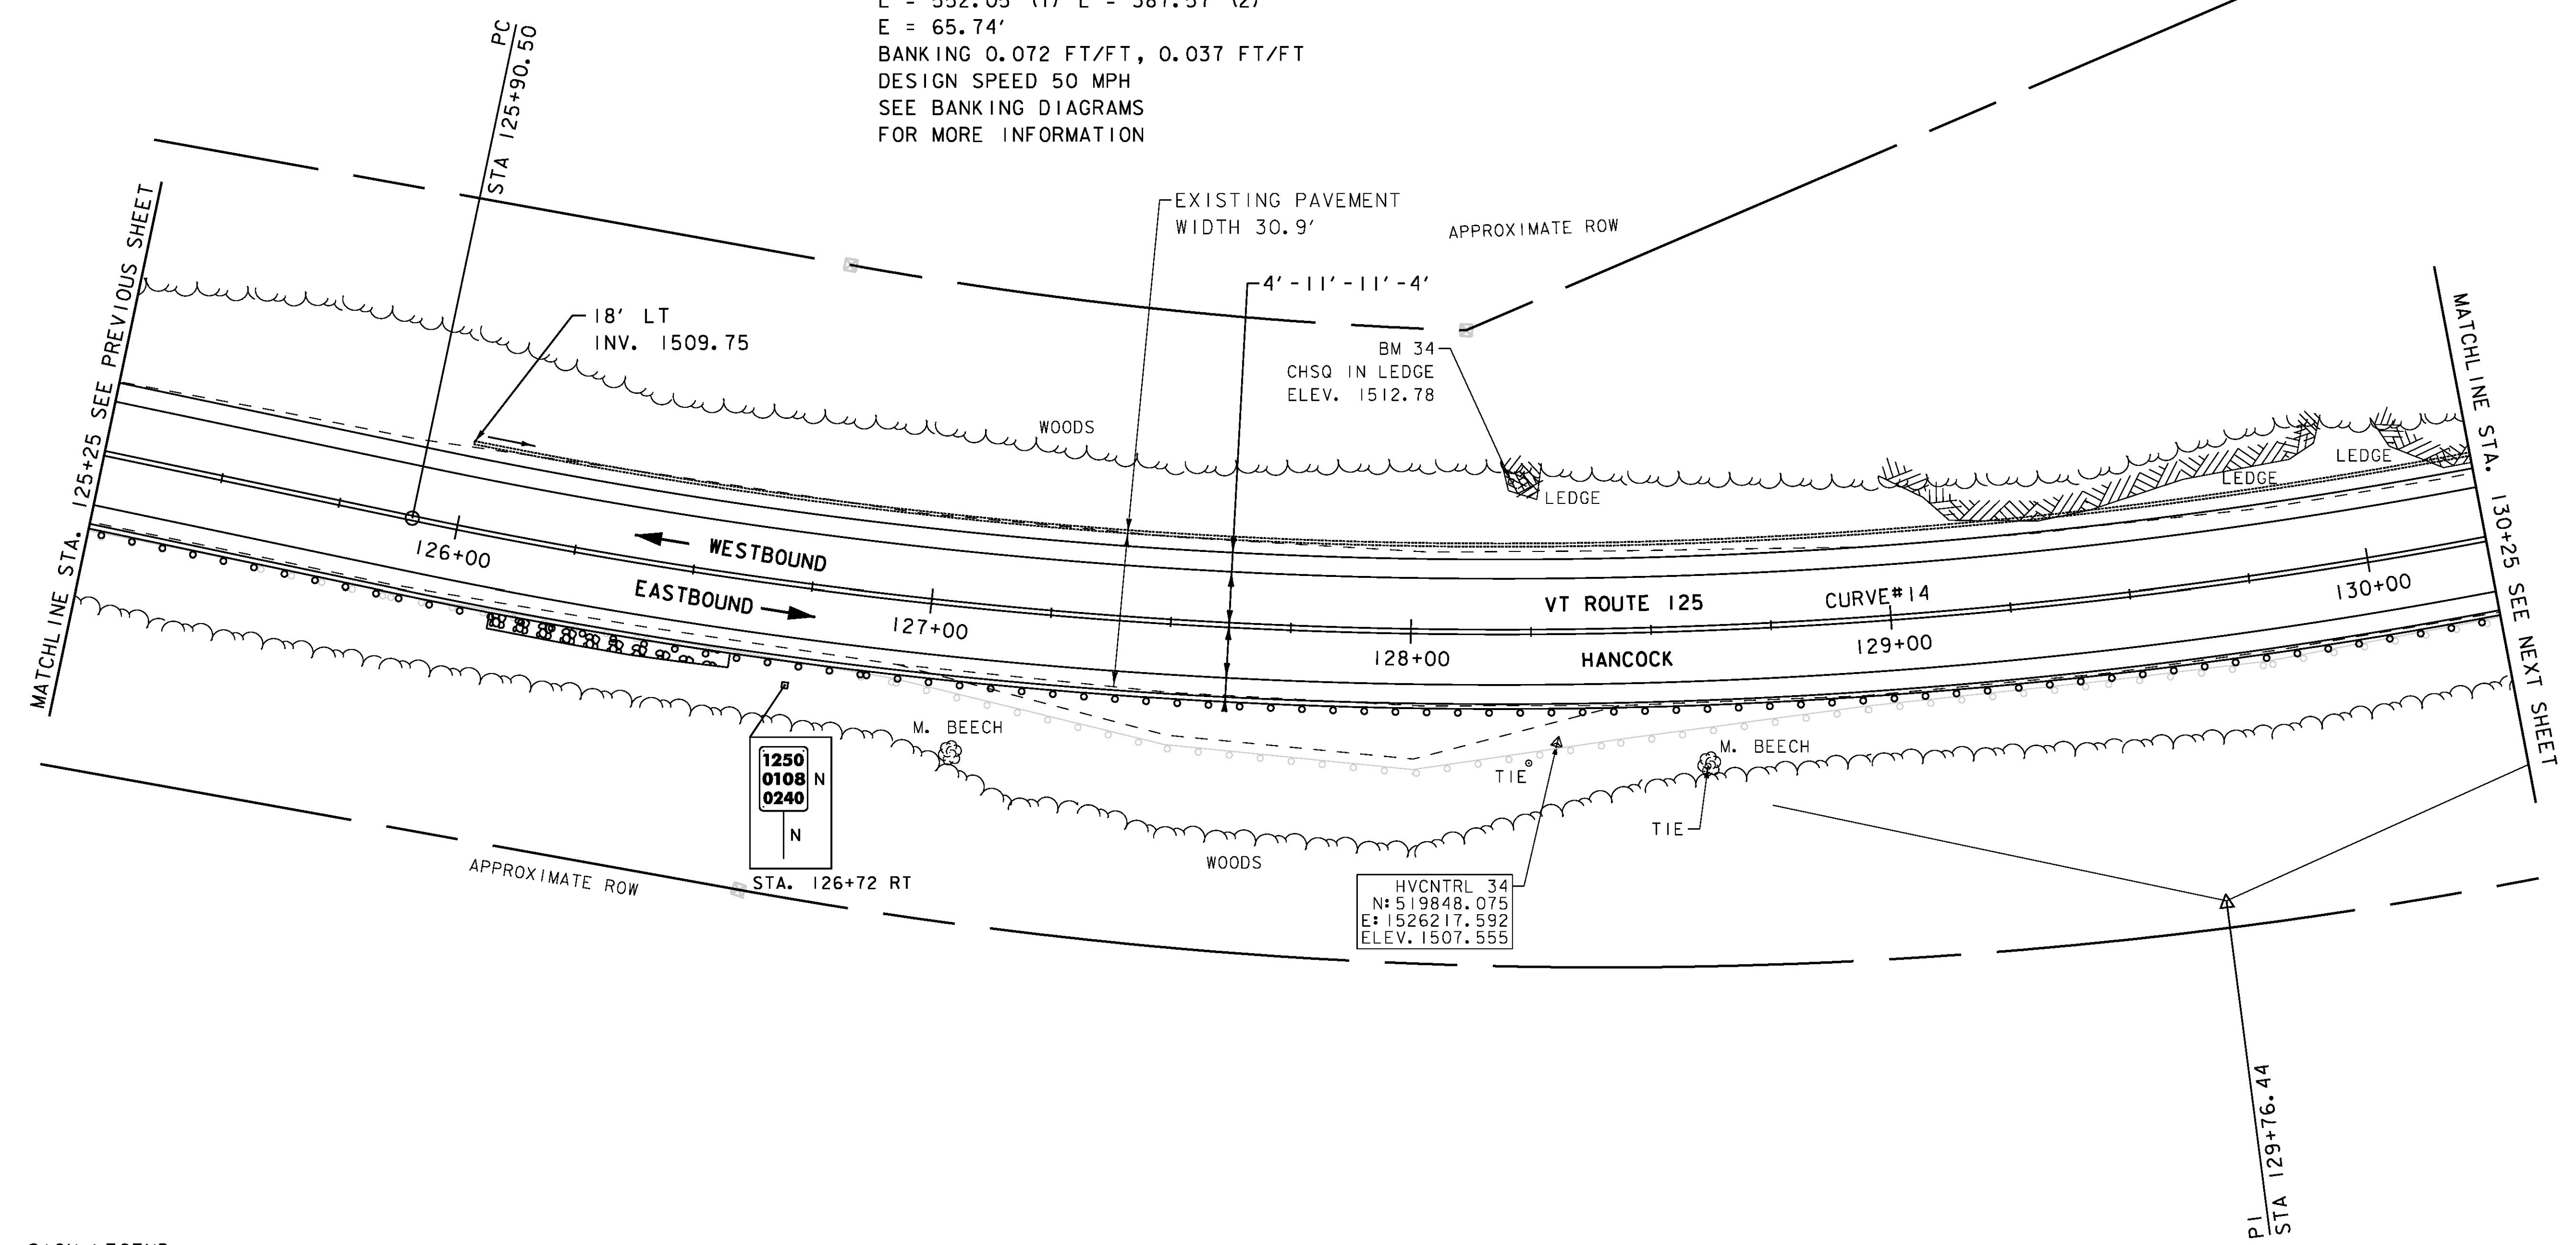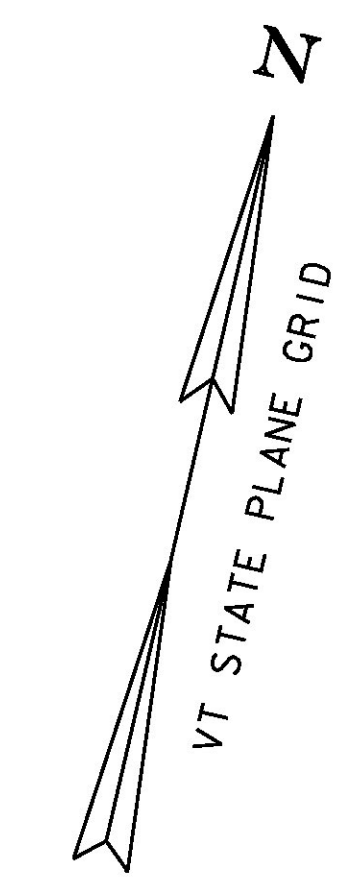

SIGN LEGEND

R = REMOVE  
 R&S = REMOVE AND SALVAGE  
 RET = RETAIN  
 S = SALVAGED  
 N = NEW  
 B-B = BACK TO BACK  
 — = EXISTING  
 - - = NEW



PROJECT NAME: HANCOCK	PLOT DATE: 3/18/2015
PROJECT NUMBER: STP 2923 (1)	DRAWN BY: J. GOODALL
FILE NAME: z10c252bdr.dgn	DESIGNED BY: B. MARTIN
PROJECT LEADER: C. LATHROP	CHECKED BY: C. LATHROP
PROJECT LAYOUT SHEET 17	SHEET 49 OF 207