

CURVE #25
 DELTA = 0°30'44"
 D = 0°34'23"
 R = 10000.00'
 T = 44.70'
 L = 89.40'
 E = 0.10'
 BANKING NORMAL CROWN
 DESIGN SPEED 50 MPH
 SEE BANKING DIAGRAMS
 FOR MORE INFORMATION

STONE FILL, TYPE I
 STA. 188+25 - STA. 188+30 LT
 STA. 188+50 - STA. 189+50 LT
 STA. 188+50 - STA. 193+50 RT

STONE FILL, TYPE II
 STA. 188+30 - STA. 188+50 LT

RELOCATE MAILBOX, SINGLE SUPPORT
 STA. 190+08 RT
 STA. 192+37 RT

6 INCH UNDERDRAIN PIPE
 STA. 188+50 - STA. 193+50 RT

DURABLE 4 INCH WHITE LINE (SEE OPTION ITEMS)
 STA. 188+25 - STA. 193+50 (SOLID LT & RT)

DURABLE 4 INCH YELLOW LINE (SEE OPTION ITEMS)
 STA. 188+25 - STA. 193+50 (SOLID LT, DASHED RT)



TEMPORARY 4 INCH WHITE LINE, PAINT
 STA. 188+25 - STA. 193+50 (SOLID LT & RT)

TEMPORARY 4 INCH YELLOW LINE, PAINT
 STA. 188+25 - STA. 193+50 (SOLID LT, DASHED RT)

GEOTEXTILE FOR SILT FENCE
 STA. 188+25 - STA. 188+30 LT
 STA. 188+30 - STA. 188+50 LT
 STA. 188+50 - STA. 189+50 LT

GRUBBING MATERIAL (6")
 STA. 188+25 - STA. 188+30 LT
 STA. 188+30 - STA. 188+50 LT
 STA. 188+50 - STA. 189+50 LT

SPECIAL PROVISION (BOX BEAM
 GUARDRAIL W/7 FEET POSTS)
 STA. 188+25 - STA. 190+41.5 LT

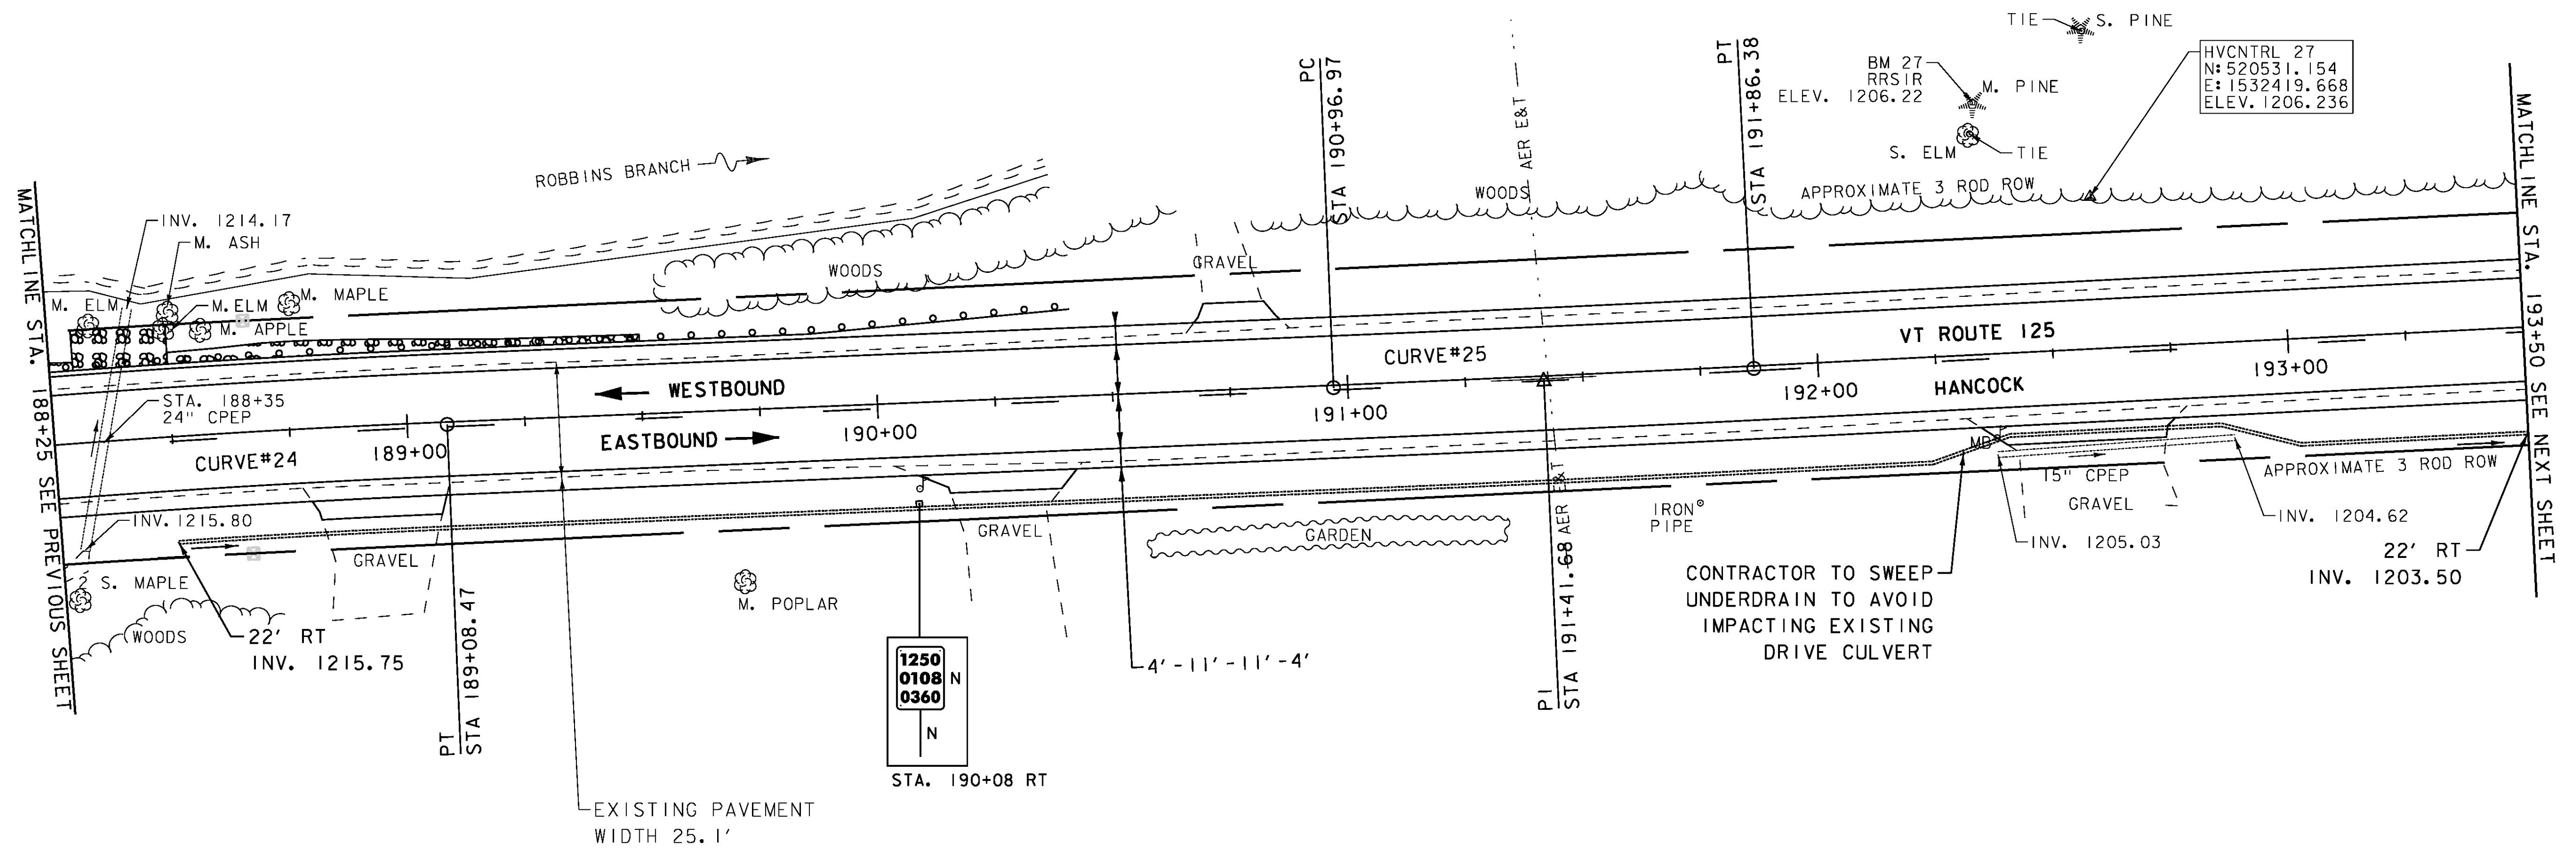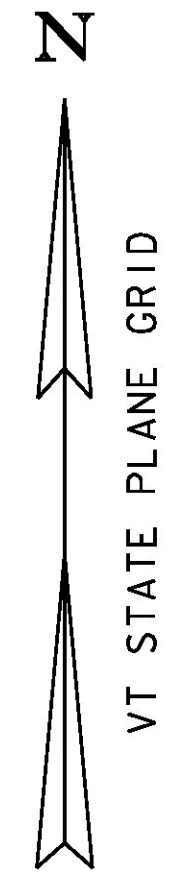

SIGN LEGEND

R = REMOVE
 R&S = REMOVE AND SALVAGE
 RET = RETAIN
 S = SALVAGED
 N = NEW
 B-B = BACK TO BACK
 - - = EXISTING
 — = NEW



PROJECT NAME: HANCOCK	PLOT DATE: 3/18/2015
PROJECT NUMBER: STP 2923 (1)	DRAWN BY: J. GOODALL
FILE NAME: z10c252bdr.dgn	CHECKED BY: C. LATHROP
PROJECT LEADER: C. LATHROP	SHEET 61 OF 207
DESIGNED BY: B. MARTIN	
PROJECT LAYOUT SHEET 29	