



6 INCH UNDERDRAIN PIPE
 STA. 194+00 - STA. 198+00 RT

DURABLE 4 INCH WHITE LINE (SEE OPTION ITEMS)
 STA. 193+50 - STA. 198+50 (SOLID LT & RT)

DURABLE 4 INCH YELLOW LINE (SEE OPTION ITEMS)
 STA. 193+50 - STA. 193+75 (SOLID LT, DASHED RT)
 STA. 193+75 - STA. 198+25 (DASHED LT)
 STA. 198+25 - STA. 198+50 (DASHED LT, SOLID RT)


TEMPORARY 4 INCH WHITE LINE, PAINT
 STA. 193+50 - STA. 198+50 (SOLID LT & RT)

TEMPORARY 4 INCH YELLOW LINE, PAINT
 STA. 193+50 - STA. 193+75 (SOLID LT, DASHED RT)
 STA. 193+75 - STA. 198+25 (DASHED LT)
 STA. 198+25 - STA. 198+50 (DASHED LT, SOLID RT)

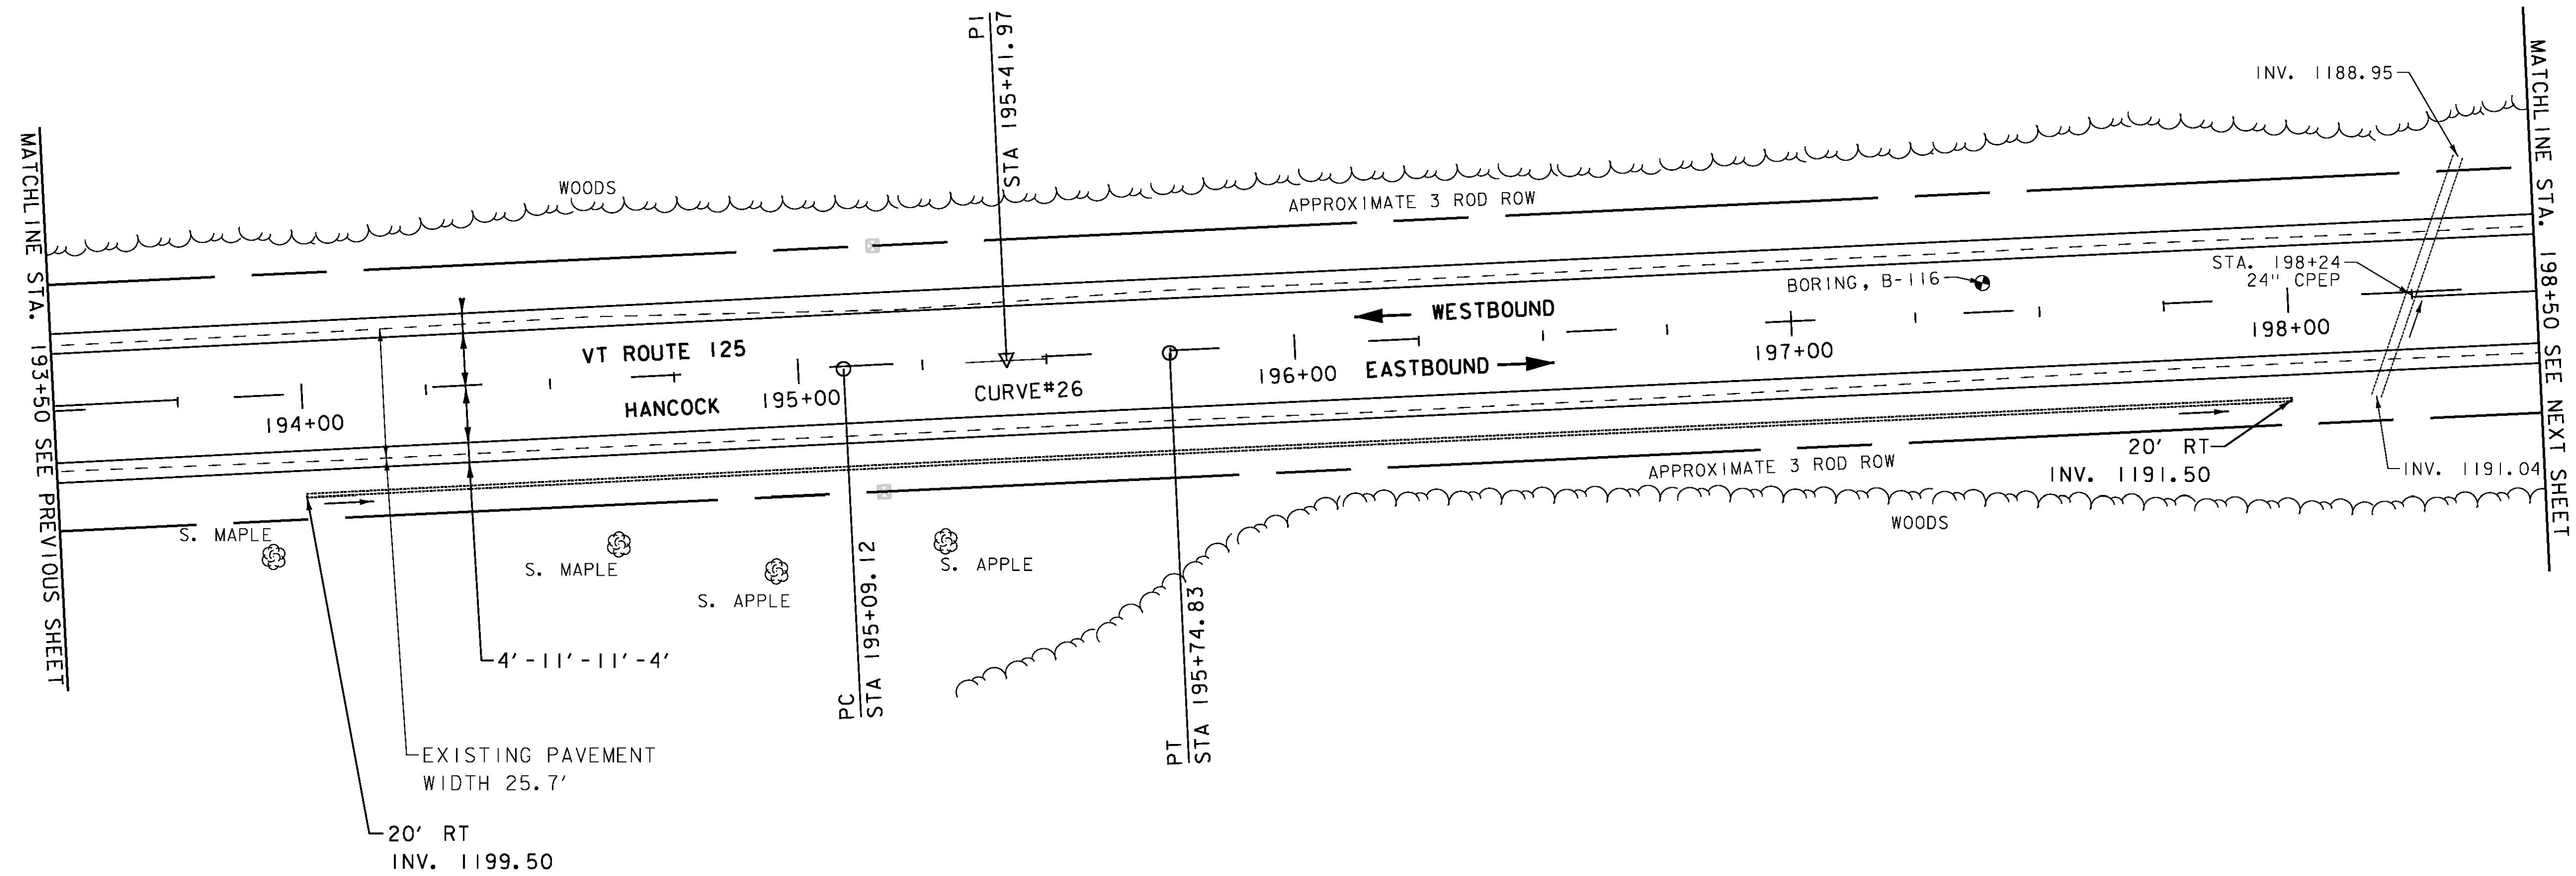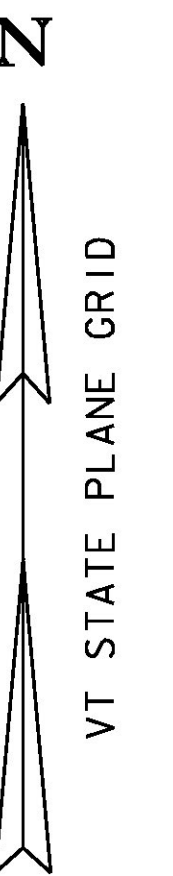

SIGN LEGEND
 R = REMOVE
 R&S = REMOVE AND SALVAGE
 RET = RETAIN
 S = SALVAGED
 N = NEW
 B-B = BACK TO BACK
 - - = EXISTING
 — = NEW

CURVE #26
 DELTA = 0°11'18"
 D = 0°17'11"
 R = 20000.00'
 T = 32.85'
 L = 65.71'
 E = 0.03'
 BANKING NORMAL CROWN
 DESIGN SPEED 50 MPH
 SEE BANKING DIAGRAMS
 FOR MORE INFORMATION

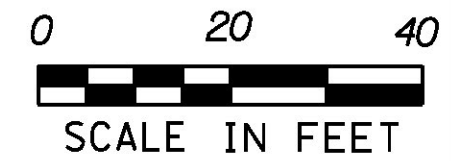

PROJECT NAME: HANCOCK	
PROJECT NUMBER: STP 2923 (1)	
FILE NAME: z10c252bdr.dgn	PLOT DATE: 3/18/2015
PROJECT LEADER: C. LATHROP	DRAWN BY: J. GOODALL
DESIGNED BY: B. MARTIN	CHECKED BY: C. LATHROP
PROJECT LAYOUT SHEET 30	SHEET 62 OF 207