

6 INCH UNDERDRAIN PIPE
 STA. 203+75 - STA. 204+00 RT
 STA. 204+25 - STA. 206+75 LT
 STA. 204+25 - STA. 207+25 RT
 STA. 207+50 - STA. 209+00 RT

STONE FILL, TYPE 11
 STA. 207+28 - STA. 207+48 RT



DURABLE 4 INCH WHITE LINE (SEE OPTION ITEMS)
 STA. 203+75 - STA. 209+25 (SOLID LT & RT)
 DURABLE 4 INCH YELLOW LINE (SEE OPTION ITEMS)
 STA. 203+75 - STA. 206+15 (DASHED LT, SOLID RT)
 STA. 206+15 - STA. 209+25 (SOLID LT & RT)

TEMPORARY 4 INCH WHITE LINE, PAINT
 STA. 203+75 - STA. 209+25 (SOLID LT & RT)
 TEMPORARY 4 INCH YELLOW LINE, PAINT
 STA. 203+75 - STA. 206+15 (DASHED LT, SOLID RT)
 STA. 206+15 - STA. 209+25 (SOLID LT & RT)

GEOTEXTILE FOR SILT FENCE
 STA. 207+28 - STA. 207+48 RT

GRUBBING MATERIAL (6")
 STA. 207+28 - STA. 207+48 RT

CURVE #27
 DELTA = 18°41'12"
 D = 4°10'01"
 R = 1375.00'
 T = 226.23'
 L = 448.45'
 E = 18.49'
 BANKING 0.065 FT/FT
 DESIGN SPEED 50 MPH
 SEE BANKING DIAGRAMS
 FOR MORE INFORMATION

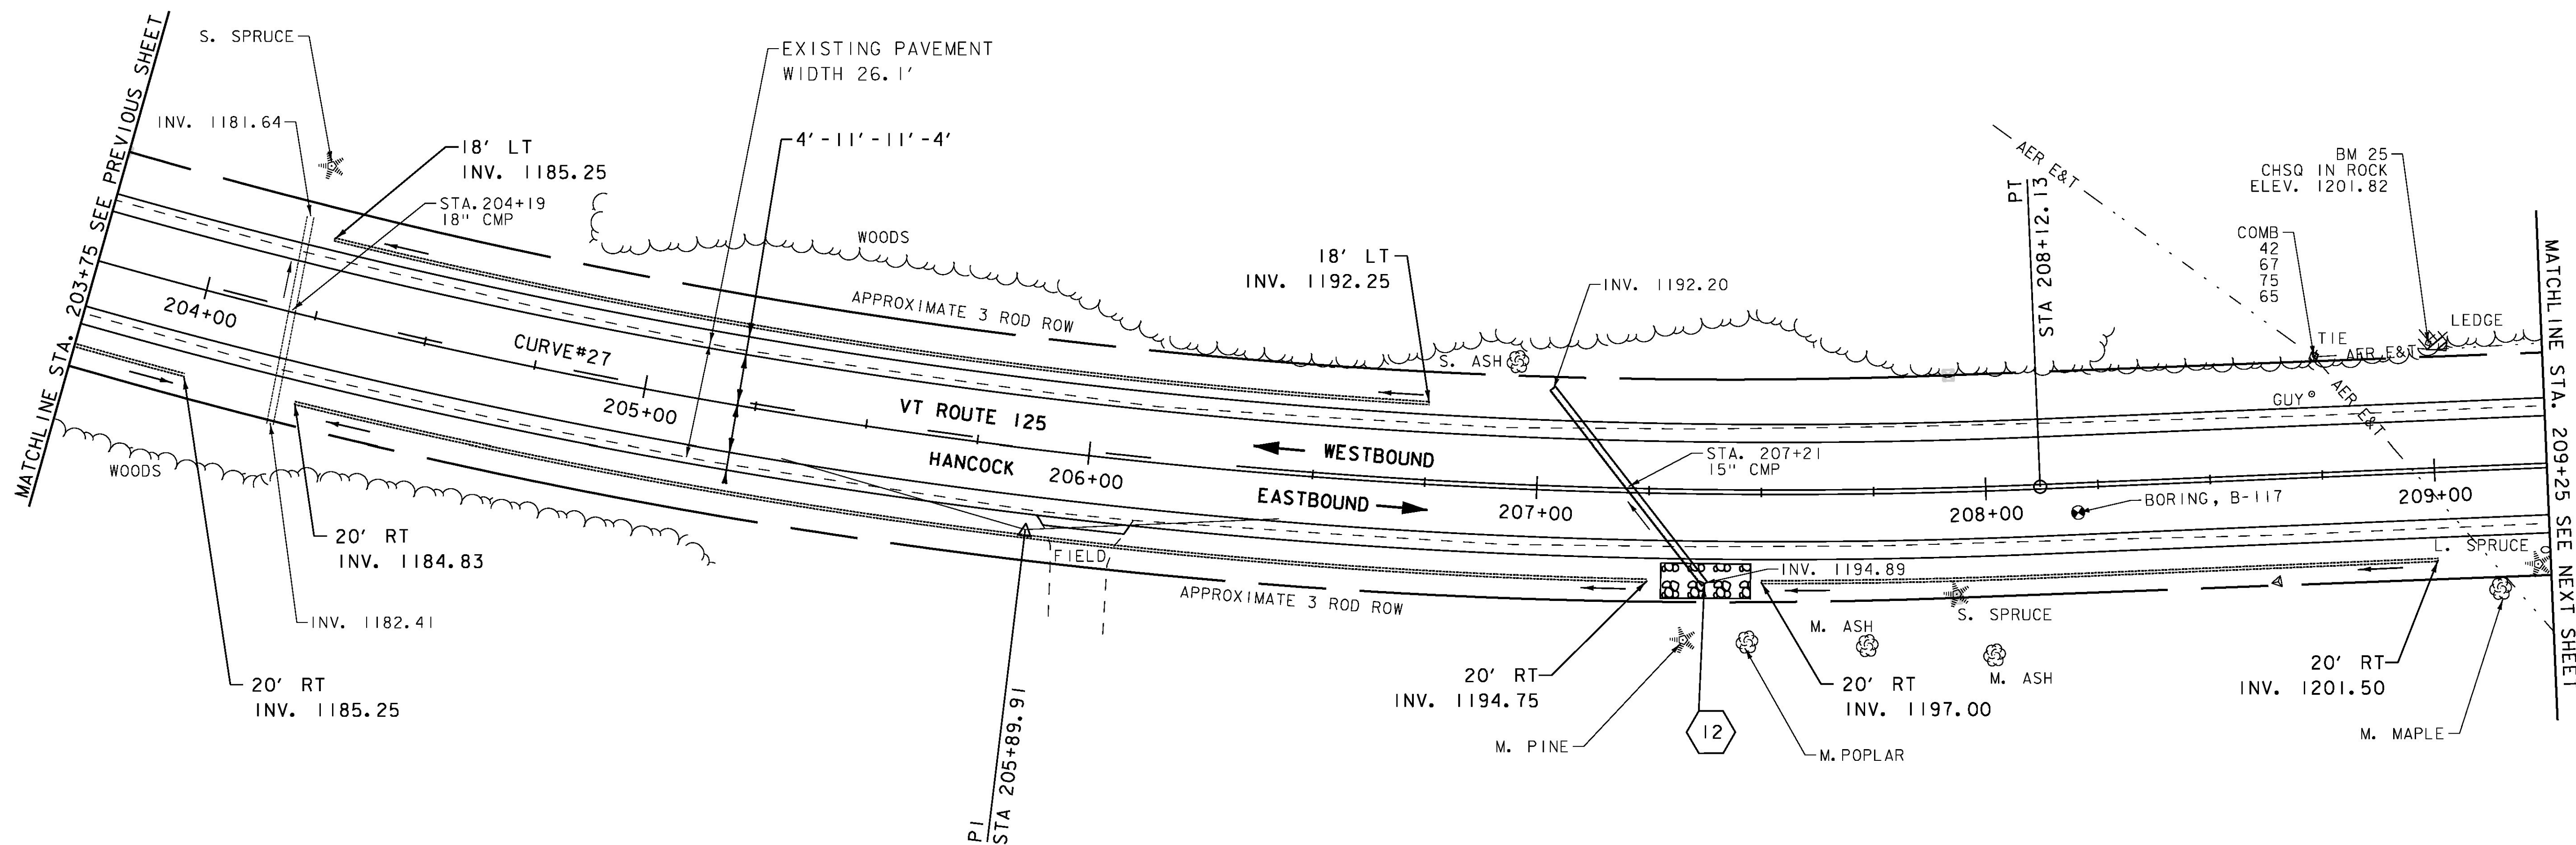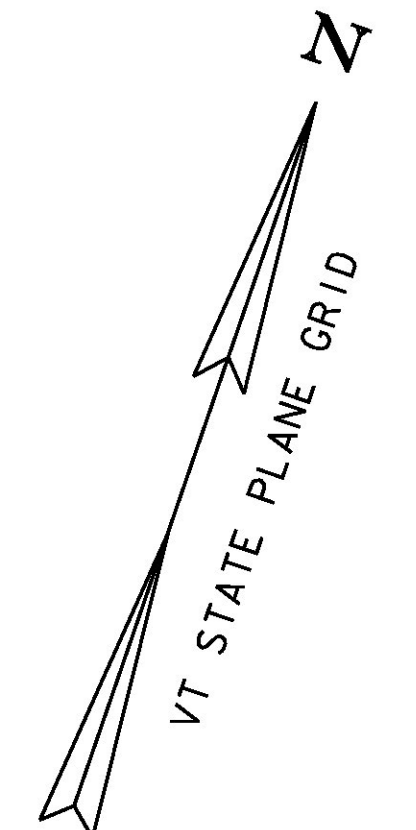

SIGN LEGEND
 R = REMOVE
 R&S = REMOVE AND SALVAGE
 RET = RETAIN
 S = SALVAGED
 N = NEW
 B-B = BACK TO BACK
 - - = EXISTING
 — = NEW

12 STA. 207+02.74 LT 22.08' TO
 STA. 207+37.58 RT 20.50'
 ASKEW ANGLE = 50.8593° RT
 REMOVE EXISTING 15" CMP PIPE
 INSTALL 18" CPEP (55'-0")
 STONE FILL ON CUT SLOPE RT
 INV. IN = 1194.90'
 INV. OUT = 1192.19'



PROJECT NAME: HANCOCK	
PROJECT NUMBER: STP 2923 (1)	
FILE NAME: z10c252bdr.dgn	PLOT DATE: 3/18/2015
PROJECT LEADER: C. LATHROP	DRAWN BY: J. GOODALL
DESIGNED BY: B. MARTIN	CHECKED BY: C. LATHROP
PROJECT LAYOUT SHEET 32	SHEET 64 OF 207