

6 INCH UNDERDRAIN PIPE  
 STA. 216+00 - STA. 218+25 LT  
 STA. 216+75 - STA. 218+25 RT  
 STA. 219+00 - STA. 219+50 RT

STONE FILL, TYPE I  
 STA. 217+70 - STA. 217+80 RT  
 STA. 218+60 - STA. 219+00 LT  
 STA. 216+00 - STA. 218+00 RT

STONE FILL, TYPE II  
 STA. 214+70 - STA. 214+80 RT  
 STA. 214+75 - STA. 214+85 LT  
 STA. 218+23 - STA. 218+41 RT  
 STA. 218+39 - STA. 218+60 LT

RELOCATE MAILBOX, SINGLE SUPPORT  
 STA. 219+46 RT

DURABLE 4 INCH WHITE LINE (SEE OPTION ITEMS)  
 STA. 214+25 - STA. 219+50 (SOLID LT & RT)

DURABLE 4 INCH YELLOW LINE (SEE OPTION ITEMS)  
 STA. 214+25 - STA. 219+50 (SOLID LT & RT)

TEMPORARY 4 INCH WHITE LINE, PAINT  
 STA. 214+25 - STA. 219+50 (SOLID LT & RT)



TEMPORARY 4 INCH YELLOW LINE, PAINT  
 STA. 214+25 - STA. 219+50 (SOLID LT & RT)

GEOTEXTILE FOR SILT FENCE  
 STA. 214+70 - STA. 214+80 RT  
 STA. 214+75 - STA. 214+85 LT  
 STA. 217+70 - STA. 217+80 RT  
 STA. 218+23 - STA. 218+41 RT  
 STA. 218+39 - STA. 218+60 LT  
 STA. 218+60 - STA. 219+00 LT

GRUBBING MATERIAL (6")  
 STA. 214+70 - STA. 214+80 RT  
 STA. 214+75 - STA. 214+85 LT  
 STA. 217+70 - STA. 217+80 RT  
 STA. 218+23 - STA. 218+41 RT  
 STA. 218+39 - STA. 218+60 LT  
 STA. 218+60 - STA. 219+00 LT

SPECIAL PROVISION (BOX BEAM  
 GUARDRAIL W/7 FEET POSTS)  
 STA. 214+25 - STA. 215+50 LT

CURVE #29  
 DELTA = 7°39'00"  
 D = 3°28'21"  
 R = 1650.00'  
 T = 110.32'  
 L = 220.30'  
 E = 3.68'  
 BANKING 0.058 FT/FT  
 DESIGN SPEED 50 MPH  
 SEE BANKING DIAGRAMS  
 FOR MORE INFORMATION

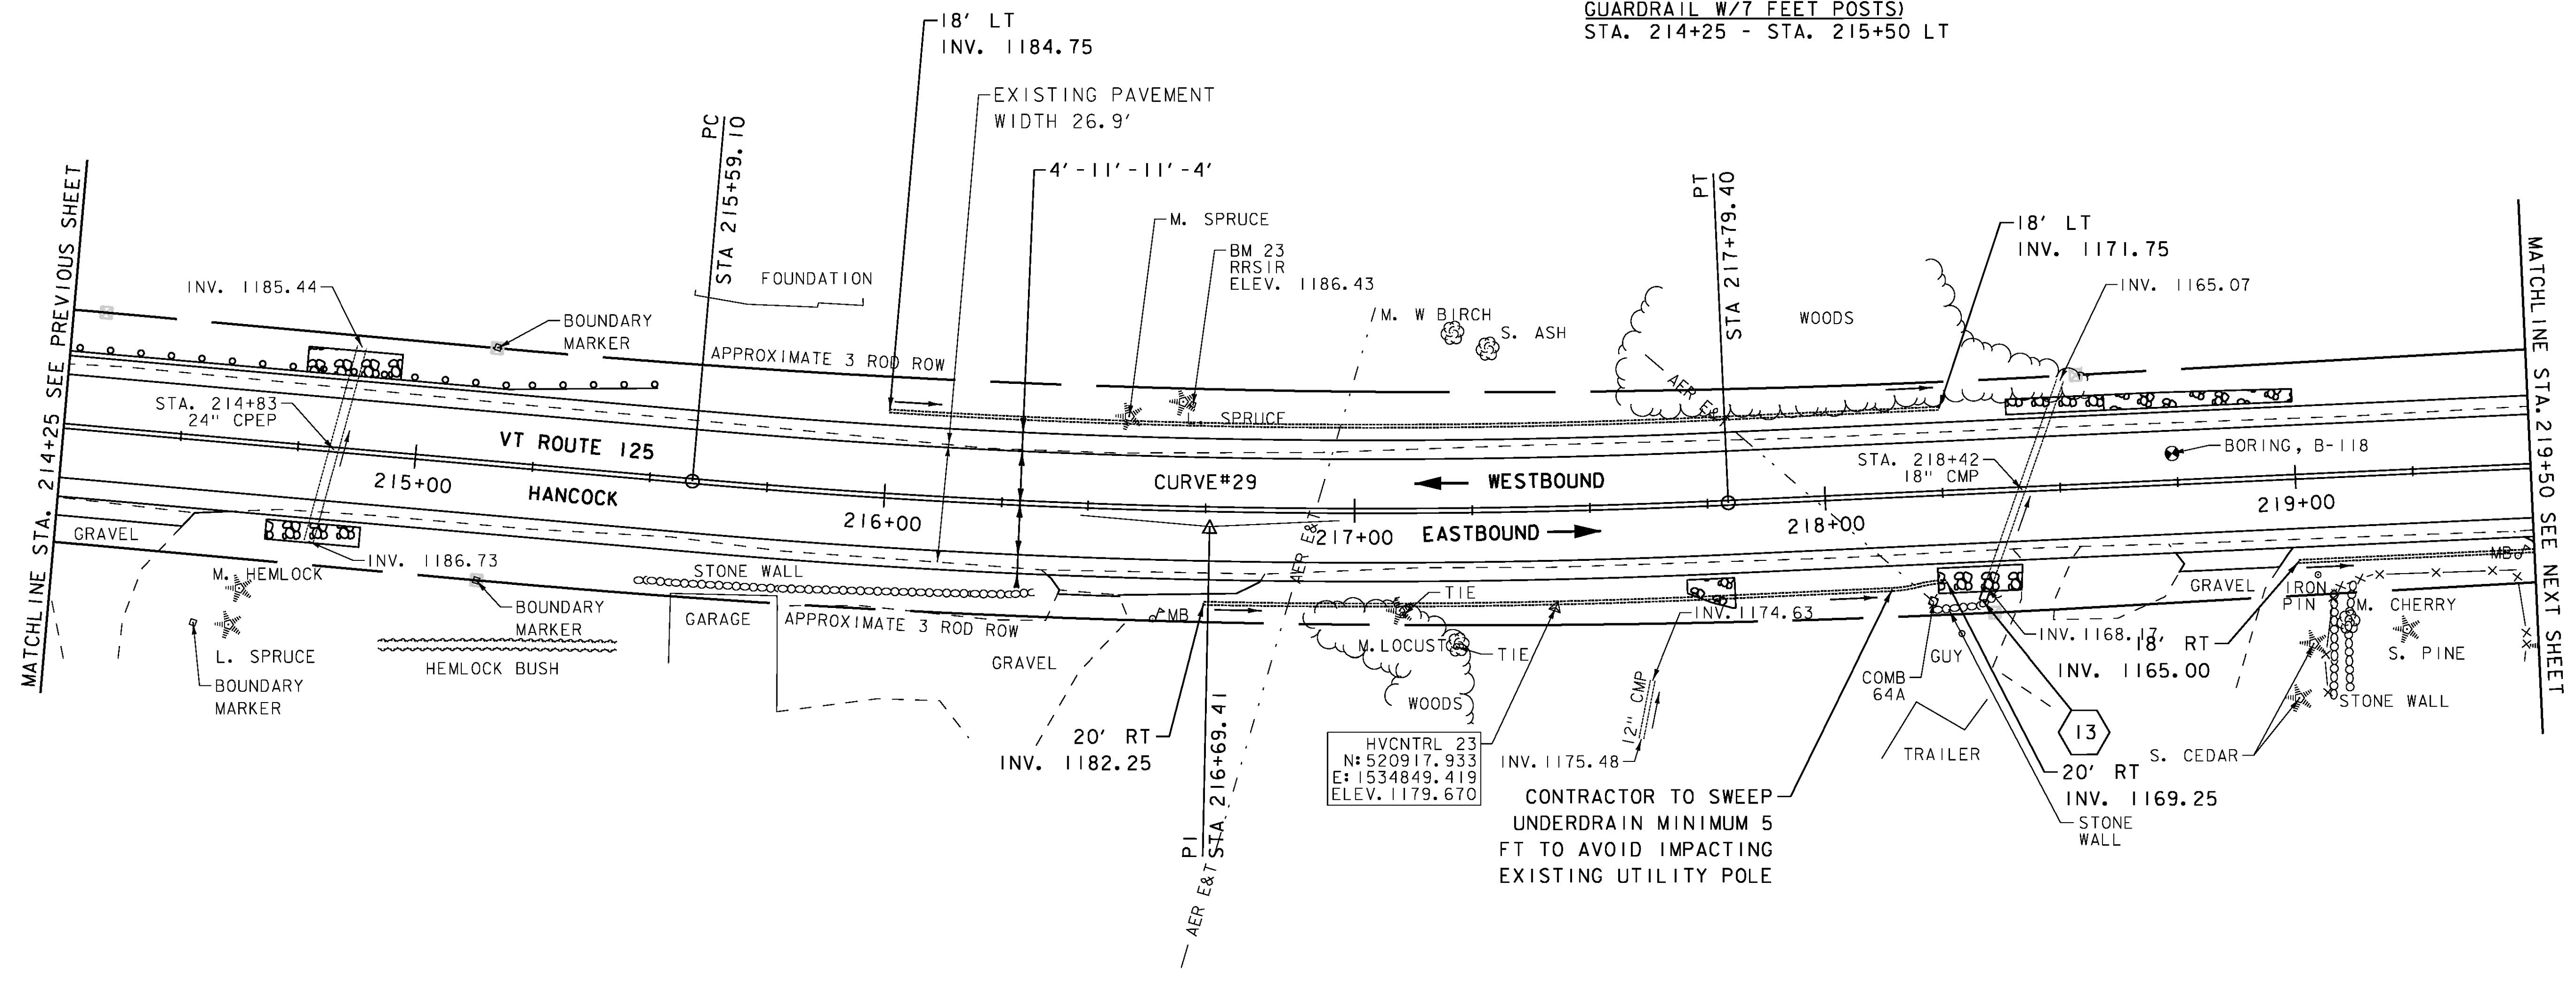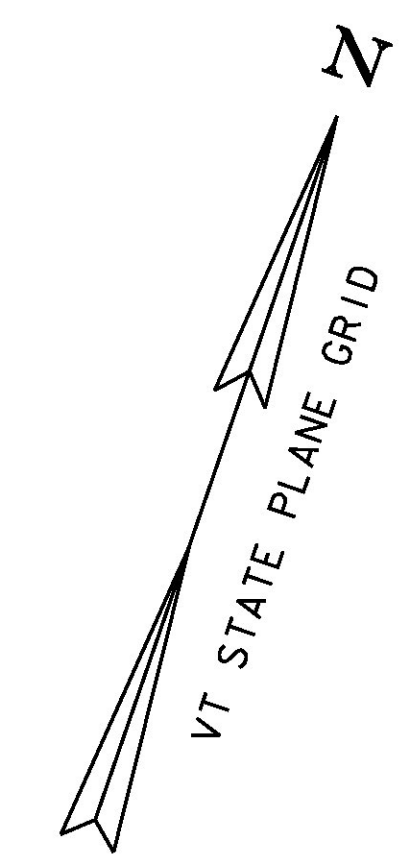

MATCHLINE STA. 214+25 SEE PREVIOUS SHEET

MATCHLINE STA. 219+50 SEE NEXT SHEET

**SIGN LEGEND**  
 R = REMOVE  
 R&S = REMOVE AND SALVAGE  
 RET = RETAIN  
 S = SALVAGED  
 N = NEW  
 B-B = BACK TO BACK  
 - - = EXISTING  
 — = NEW

13 STA. 218+32.45 RT 23.22' TO  
 STA. 218+50.93 LT 22.80'  
 EXTEND 18" CMP 3'-0" RT  
 INV. IN = 1168.36  
 INV. OUT = 1165.07



PROJECT NAME: HANCOCK	PLOT DATE: 3/18/2015
PROJECT NUMBER: STP 2923 (1)	DRAWN BY: J. GOODALL
FILE NAME: z10c252bdr.dgn	CHECKED BY: C. LATHROP
PROJECT LEADER: C. LATHROP	SHEET 66 OF 207
DESIGNED BY: B. MARTIN	
PROJECT LAYOUT SHEET 34	