

6 INCH UNDERDRAIN PIPE  
STA. 240+50 - STA. 244+75 LT

RELOCATE MAILBOX, SINGLE SUPPORT  
STA. 242+72 RT



DURABLE 4 INCH WHITE LINE (SEE OPTION ITEMS)  
STA. 240+50 - STA. 245+75 (SOLID LT & RT)

DURABLE 4 INCH YELLOW LINE (SEE OPTION ITEMS)  
STA. 240+50 - STA. 245+75 (SOLID LT & RT)

TEMPORARY 4 INCH WHITE LINE, PAINT  
STA. 240+50 - STA. 245+75 (SOLID LT & RT)

TEMPORARY 4 INCH YELLOW LINE, PAINT  
STA. 240+50 - STA. 245+75 (SOLID LT & RT)

REMOVING SIGNS  
AS SHOWN - 1

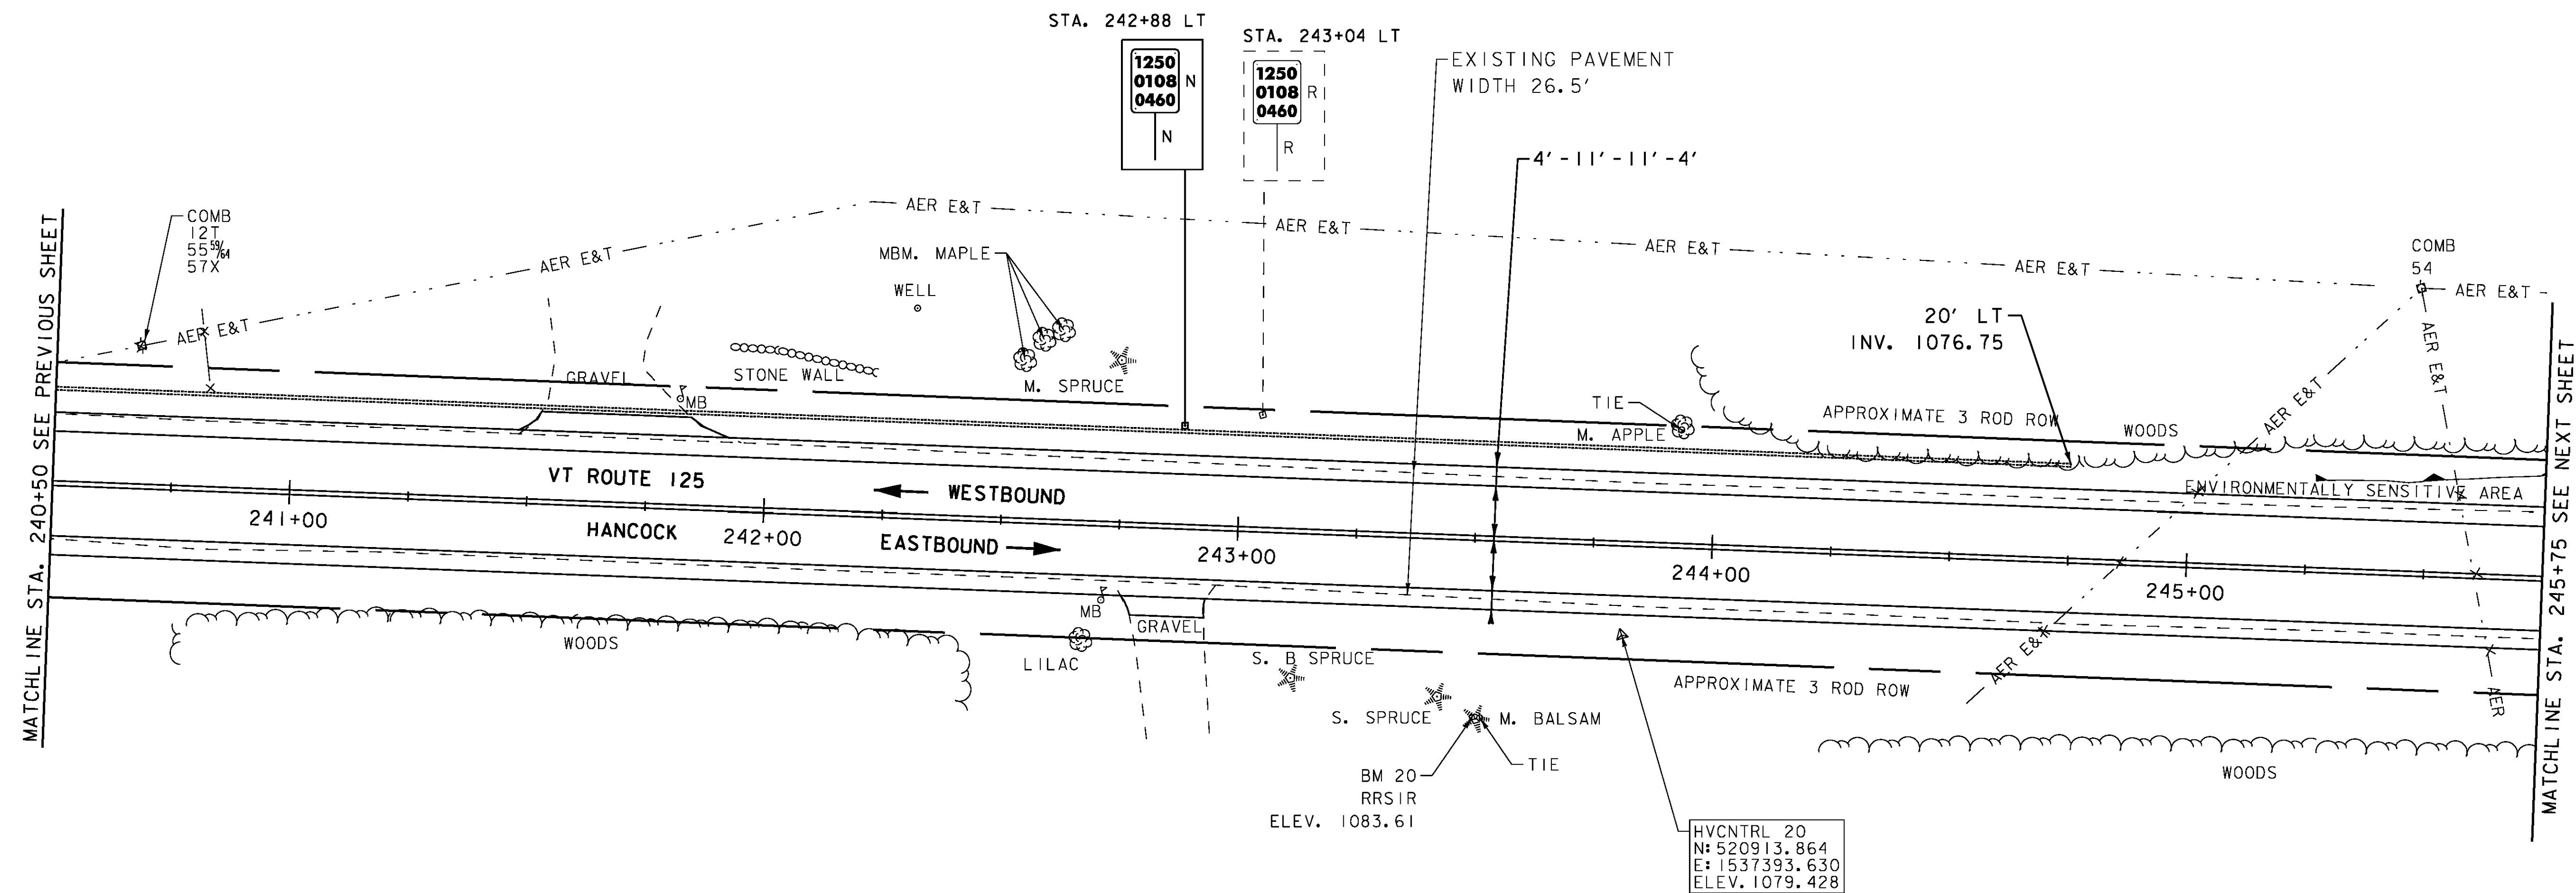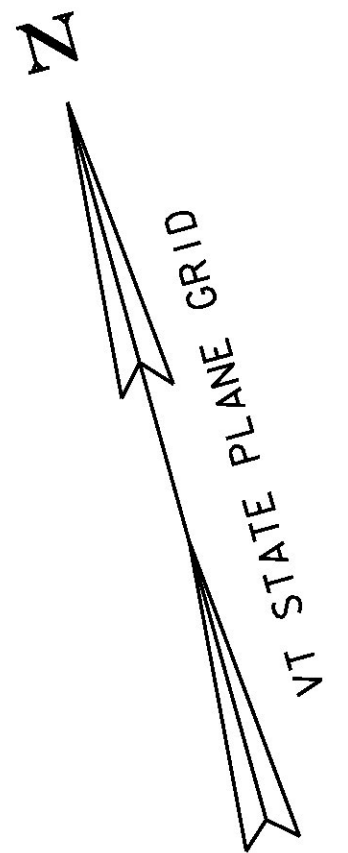

**SIGN LEGEND**  
 R = REMOVE  
 R&S = REMOVE AND SALVAGE  
 RET = RETAIN  
 S = SALVAGED  
 N = NEW  
 B-B = BACK TO BACK  
 - - = EXISTING  
 — = NEW

**ENVIRONMENTALLY SENSITIVE LOCATIONS:**

NO.	LIMITS	POS.	TYPE
4.	STA. 245+26 - STA. 245+50	LT	-



PROJECT NAME: HANCOCK	PLOT DATE: 3/18/2015
PROJECT NUMBER: STP 2923 (1)	DRAWN BY: J. GOODALL
FILE NAME: z10c252bdr.dgn	CHECKED BY: C. LATHROP
PROJECT LEADER: C. LATHROP	SHEET 71 OF 207
DESIGNED BY: B. MARTIN	
PROJECT LAYOUT SHEET 39	