
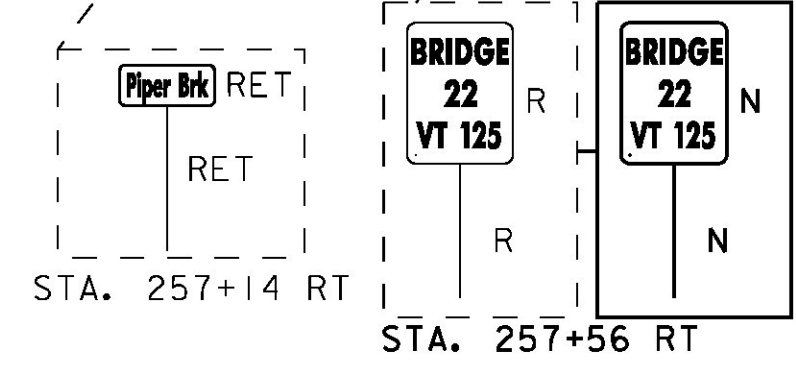
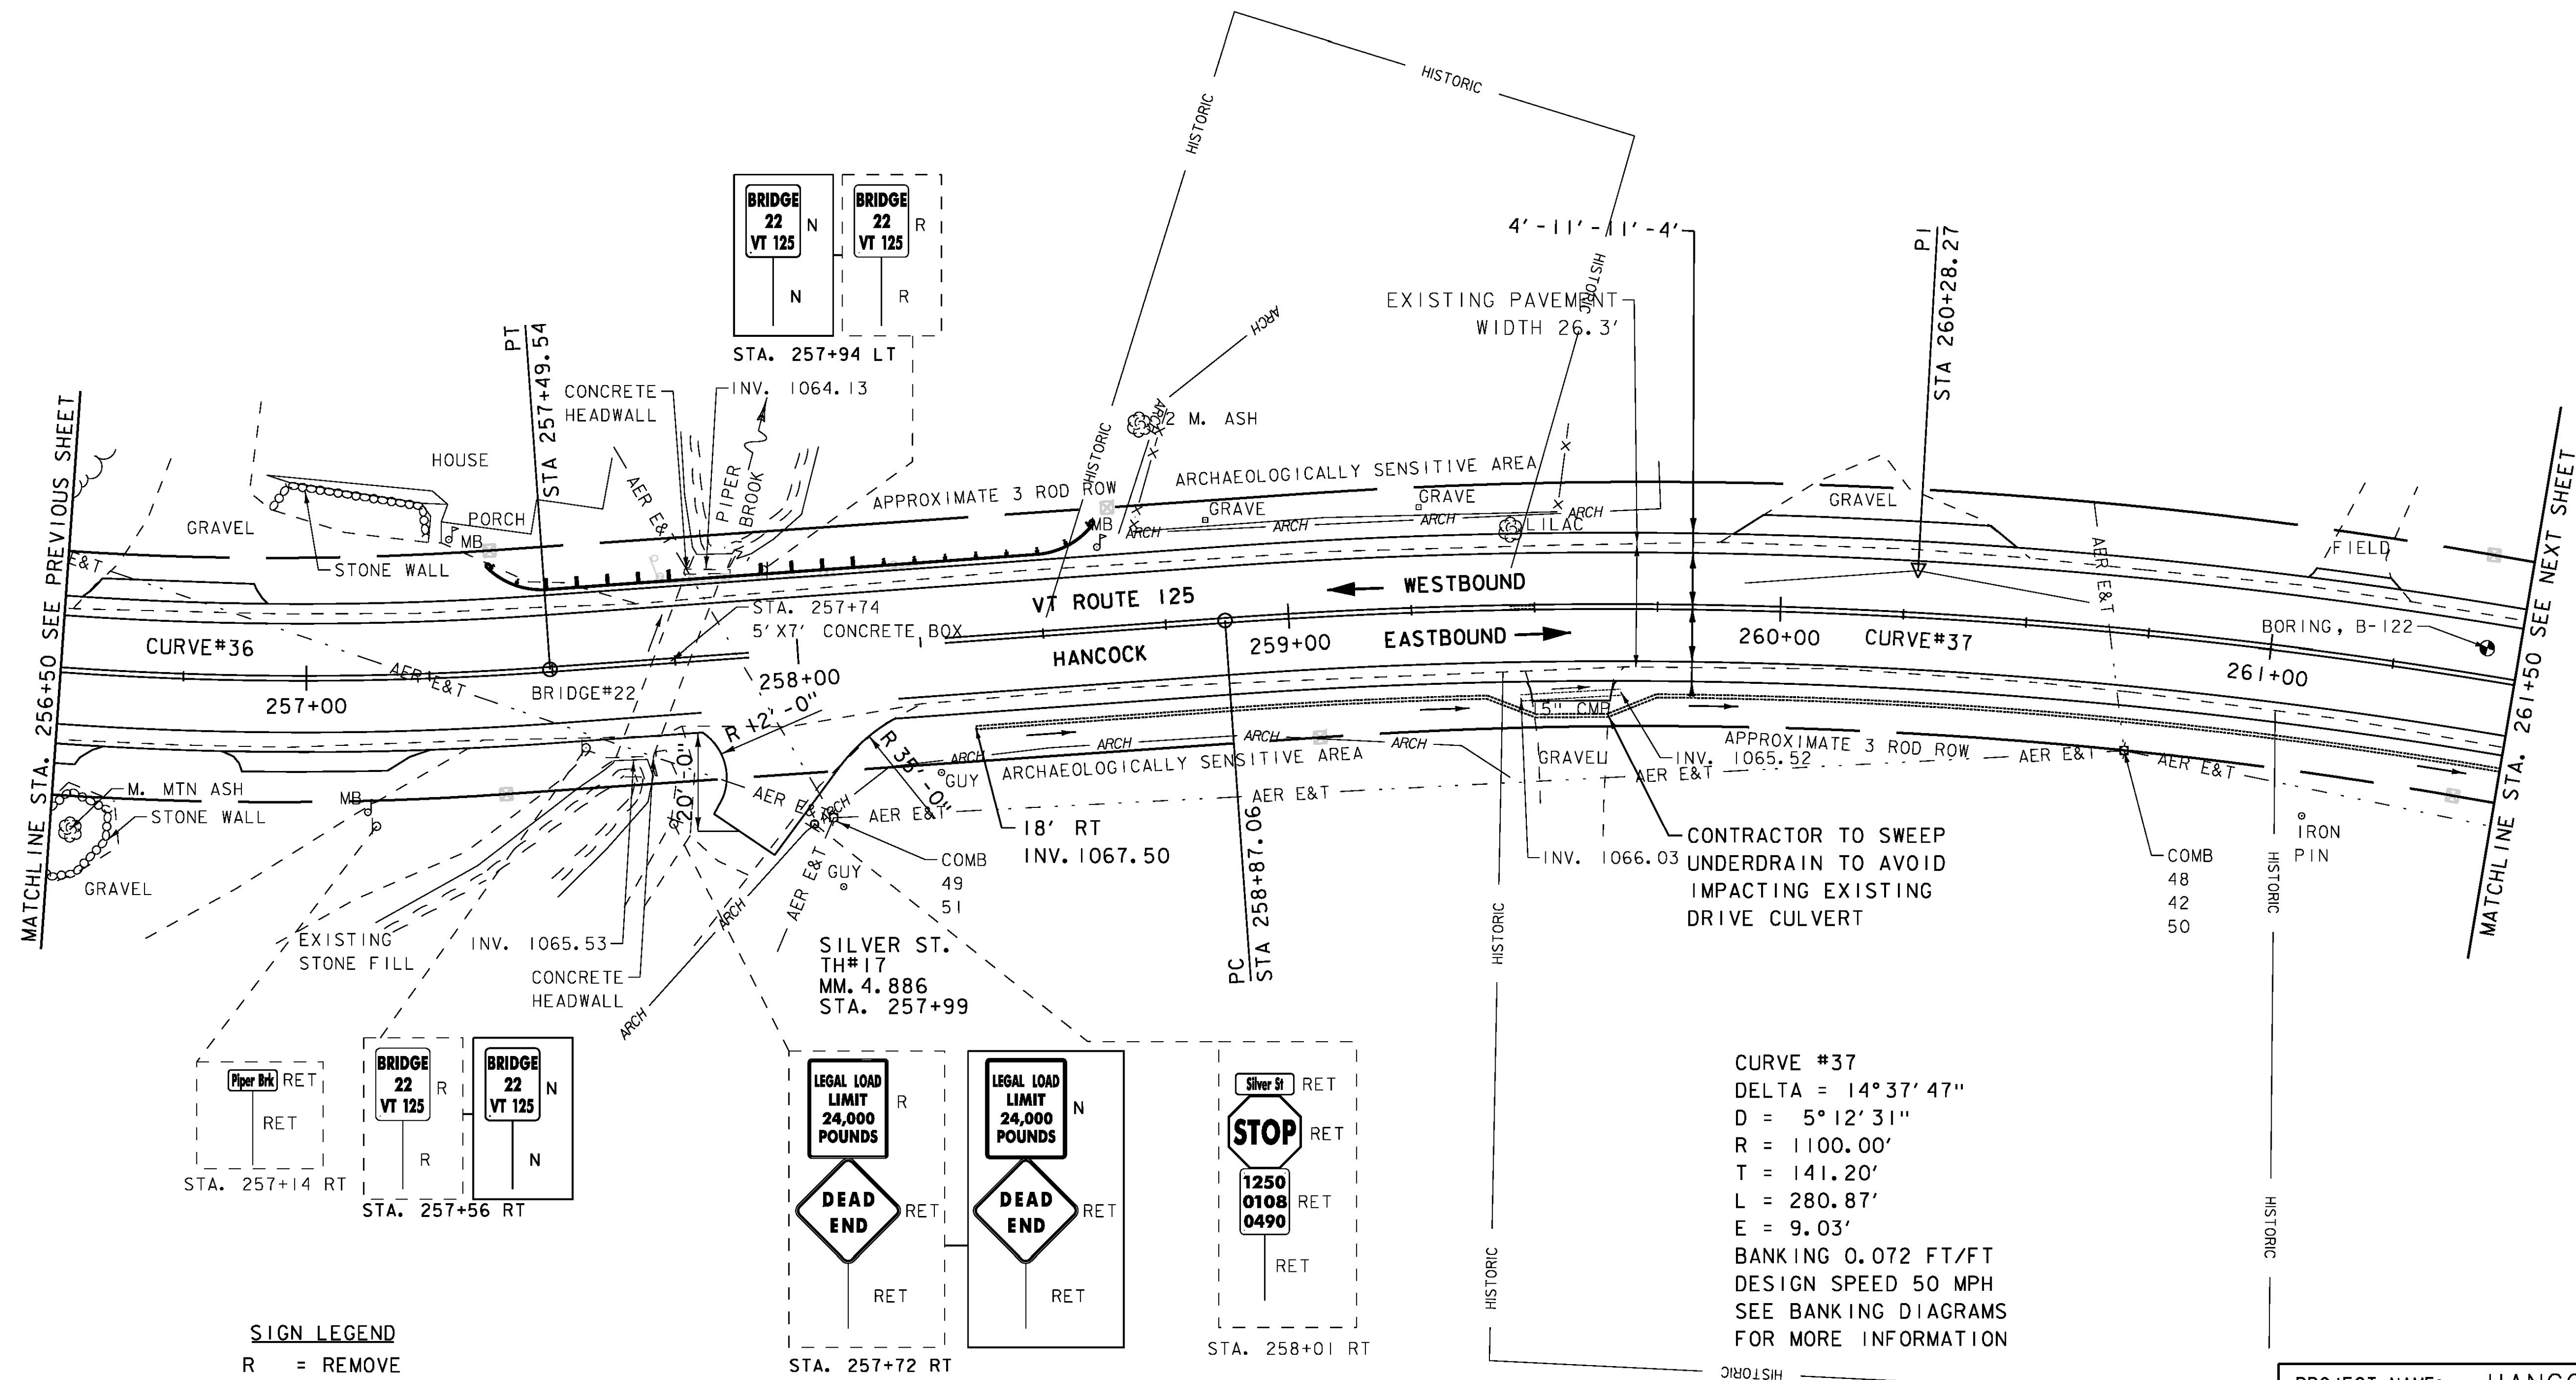


6 INCH UNDERDRAIN PIPE  
 STA. 258+35 - STA. 261+50 RT  
 STEEL BEAM GUARDRAIL, GALVANIZED  
 STA. 257+37.5 - STA. 257+50 LT  
 STA. 258+37.5 - STA. 258+62.5 LT  
 STEEL BEAM GUARDRAIL, GALVANIZED, NESTED  
 STA. 257+50 - STA. 258+36 LT  
 RELOCATE MAILBOX, SINGLE SUPPORT  
 STA. 258+62 LT  
 REMOVAL AND DISPOSAL OF GUARDRAIL  
 STA. 257+70 - STA. 258+26 LT


DURABLE 4 INCH WHITE LINE (SEE OPTION ITEMS)  
 STA. 256+50 - STA. 261+50 (SOLID LT & RT)  
 (WITH EDGE LINE BREAK RT AT TH #17)  
 DURABLE 4 INCH YELLOW LINE (SEE OPTION ITEMS)  
 STA. 256+50 - STA. 261+50 (SOLID LT & RT)  
 (WITH CENTERLINE BREAK AT TH #17)

TEMPORARY 4 INCH WHITE LINE, PAINT  
 STA. 256+50 - STA. 261+50 (SOLID LT & RT)  
 (WITH EDGE LINE BREAK RT AT TH #17)  
 TEMPORARY 4 INCH YELLOW LINE, PAINT  
 STA. 256+50 - STA. 261+50 (SOLID LT & RT)  
 (WITH CENTERLINE BREAK AT TH #17)  
 REMOVING SIGNS  
 AS SHOWN -3  
 BARRIER FENCE  
 STA. 258+75 - STA. 259+75 LT

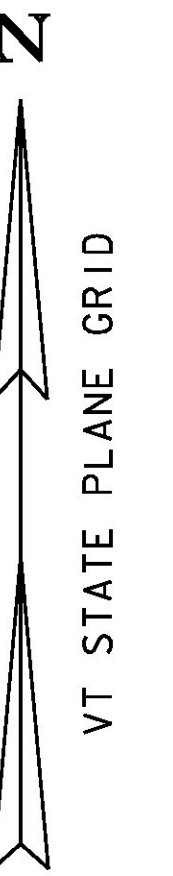

**SIGN LEGEND**  
 R = REMOVE  
 R&S = REMOVE AND SALVAGE  
 RET = RETAIN  
 S = SALVAGED  
 N = NEW  
 B-B = BACK TO BACK  
 --- = EXISTING  
 — = NEW

**CURVE #37**  
 DELTA = 14° 37' 47"  
 D = 5° 12' 31"  
 R = 1100.00'  
 T = 141.20'  
 L = 280.87'  
 E = 9.03'  
 BANKING 0.072 FT/FT  
 DESIGN SPEED 50 MPH  
 SEE BANKING DIAGRAMS  
 FOR MORE INFORMATION

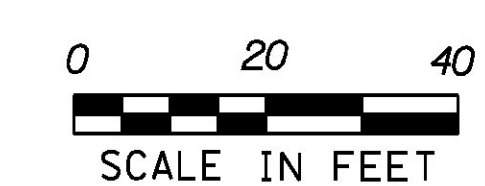

**PROJECT NAME:** HANCOCK  
**PROJECT NUMBER:** STP 2923 (1)  
**FILE NAME:** z10c252bdr.dgn  
**PROJECT LEADER:** C.LATHROP  
**DESIGNED BY:** B.MARTIN  
**PROJECT LAYOUT SHEET:** 42  
**PLOT DATE:** 3/18/2015  
**DRAWN BY:** J.GOODALL  
**CHECKED BY:** C.LATHROP  
**SHEET:** 74 OF 207