
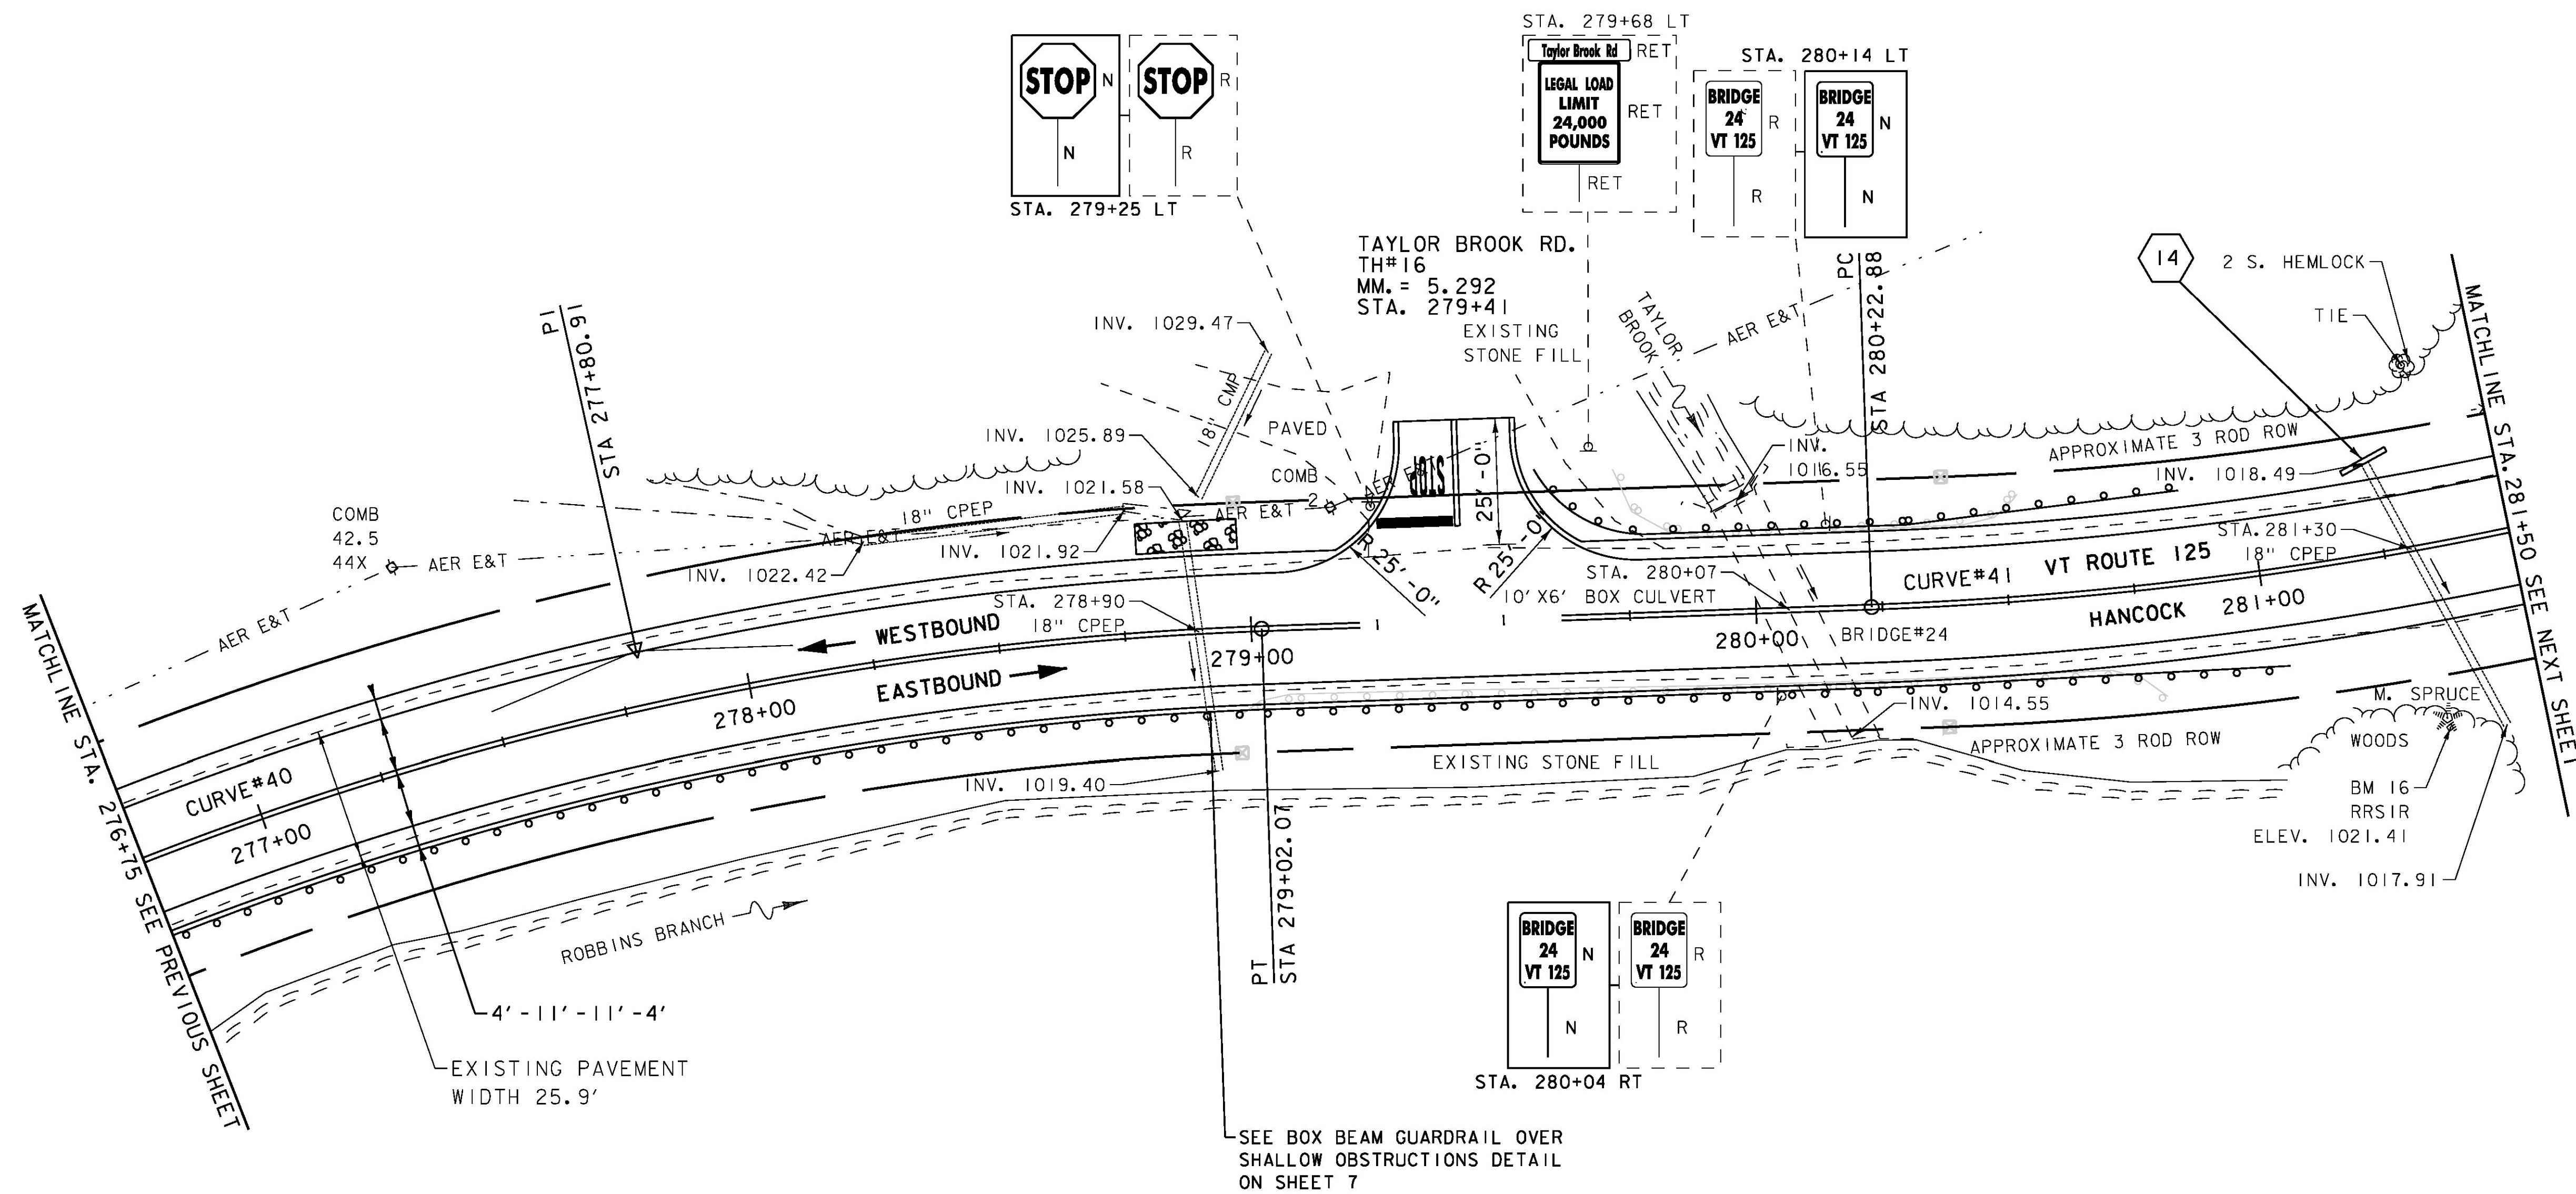


STONE FILL, TYPE 11
 STA. 278+78 - STA. 278+98 LT
REMOVAL AND DISPOSAL OF GUARDRAIL
 STA. 278+96 - STA. 280+79 RT
 STA. 279+72 - STA. 280+53 LT

DURABLE 4 INCH WHITE LINE (SEE OPTION ITEMS)
 STA. 276+75 - STA. 281+50 (SOLID LT & RT)
 (WITH EDGE LINE BREAK LT AT TH #16)
 STA. 279+41 LT (EDGE LINES AT TH #16)
DURABLE 4 INCH YELLOW LINE (SEE OPTION ITEMS)
 STA. 276+75 - STA. 281+50 (SOLID LT & RT)
 (WITH CENTERLINE BREAK AT TH #16)
 STA. 279+41 LT (CENTERLINE AT TH #16)
DURABLE 24 INCH STOP BAR (SEE OPTION ITEMS)
 STA. 279+28 - STA. 279+40 LT (TH #16)
DURABLE LETTER OR SYMBOL (SEE OPTION ITEMS)
 STA. 279+36 LT "STOP" (TH #16)

TEMPORARY 4 INCH WHITE LINE, PAINT
 STA. 276+75 - STA. 281+50 (SOLID LT & RT)
 (WITH EDGE LINE BREAK LT AT TH #16)
 STA. 279+41 LT (EDGE LINES AT TH #16)
TEMPORARY 4 INCH YELLOW LINE, PAINT
 STA. 276+75 - STA. 281+50 (SOLID LT & RT)
 (WITH CENTERLINE BREAK AT TH #16)
 STA. 279+41 LT (CENTERLINE AT TH #16)
TEMPORARY 24 INCH STOP BAR, PAINT
 STA. 279+28 - STA. 279+40 LT (TH #16)
TEMPORARY LETTER OR SYMBOL, PAINT
 STA. 279+36 LT "STOP" (TH #16)

GEOTEXTILE FOR SILT FENCE
 STA. 278+78 - STA. 278+98 LT
GRUBBING MATERIAL (6")
 STA. 278+78 - STA. 278+98 LT
REMOVING SIGNS
 AS SHOWN -3
SPECIAL PROVISION (BOX BEAM GUARDRAIL W/7 FEET POSTS)
 STA. 276+75 - STA. 281+03.5 RT
 STA. 279+47.5 - STA. 280+85.5 LT

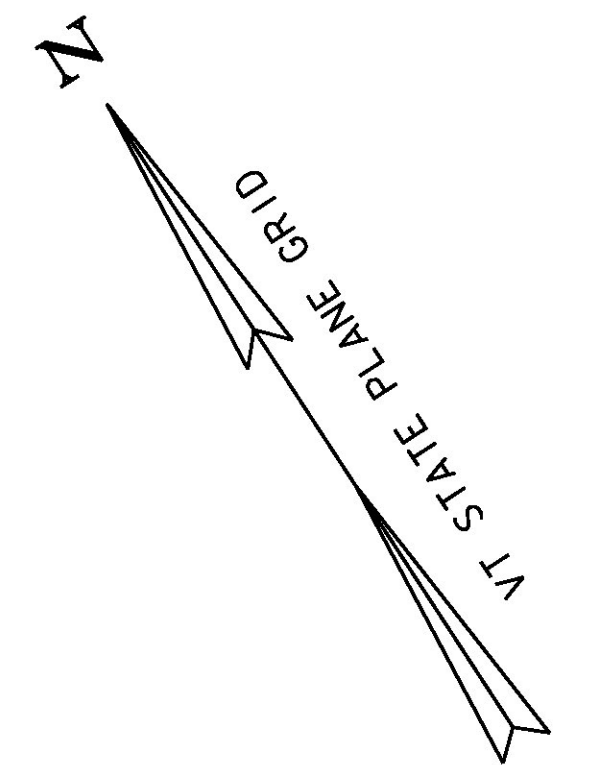

SIGN LEGEND
 R = REMOVE
 R&S = REMOVE AND SALVAGE
 RET = RETAIN
 S = SALVAGED
 N = NEW
 B-B = BACK TO BACK
 - - = EXISTING
 — = NEW

14 STA. 281+19.29 LT 16.6' TO
 STA. 281+28.97 LT 19.88'
 CONSTRUCT CONCRETE REINFORCED
 HEADWALL PER STD. D-33 FOR
 18" PIPE, LT
 INV. IN = 1018.49'
 INV. OUT = 1017.91'

CURVE #40
 DELTA = 20° 48' 00"
 D = 8° 29' 18"
 R = 675.00'
 T = 123.89'
 L = 245.04'
 E = 11.27'
 BANKING 0.080 FT/FT
 DESIGN SPEED 45 MPH
 SEE BANKING DIAGRAMS
 FOR MORE INFORMATION



PROJECT NAME: HANCOCK	PLOT DATE: 3/18/2015
PROJECT NUMBER: STP 2923 (1)	DRAWN BY: J. GOODALL
FILE NAME: z10c252bdr.dgn	CHECKED BY: C. LATHROP
DESIGNED BY: B. MARTIN	SHEET 78 OF 207
PROJECT LAYOUT SHEET 46	