

BRIDGE RAILING REPAIR, TYPE I
 STA. 309+05 - STA. 309+30 LT
 STA. 309+12.5 - STA. 309+37.5 RT

STEEL BEAM GUARDRAIL, GALVANIZED
 STA. 308+56.25 - STA. 308+81.25 RT
 STA. 308+80 - STA. 309+05 LT
 STA. 309+37.5 - STA. 309+62.5 RT
 STA. 309+61.25 - STA. 309+98.75 LT

HEAVY DUTY STEEL BEAM, GALVANIZED
 STA. 308+81.25 - STA. 309+12.5 RT
 STA. 309+30 - STA. 309+61.25 LT

REMOVAL AND DISPOSAL OF GUARDRAIL
 STA. 308+91 - STA. 309+39 LT
 STA. 308+96 - STA. 309+48 RT


DURABLE 4 INCH WHITE LINE (SEE OPTION ITEMS)
 STA. 307+50 - STA. 312+75 (SOLID LT & RT)

DURABLE 4 INCH YELLOW LINE (SEE OPTION ITEMS)
 STA. 307+50 - STA. 312+75 (SOLID LT & RT)

TEMPORARY 4 INCH WHITE LINE, PAINT
 STA. 307+50 - STA. 312+75 (SOLID LT & RT)

TEMPORARY 4 INCH YELLOW LINE, PAINT
 STA. 307+50 - STA. 312+75 (SOLID LT & RT)


REMOVING SIGNS
 AS SHOWN -6

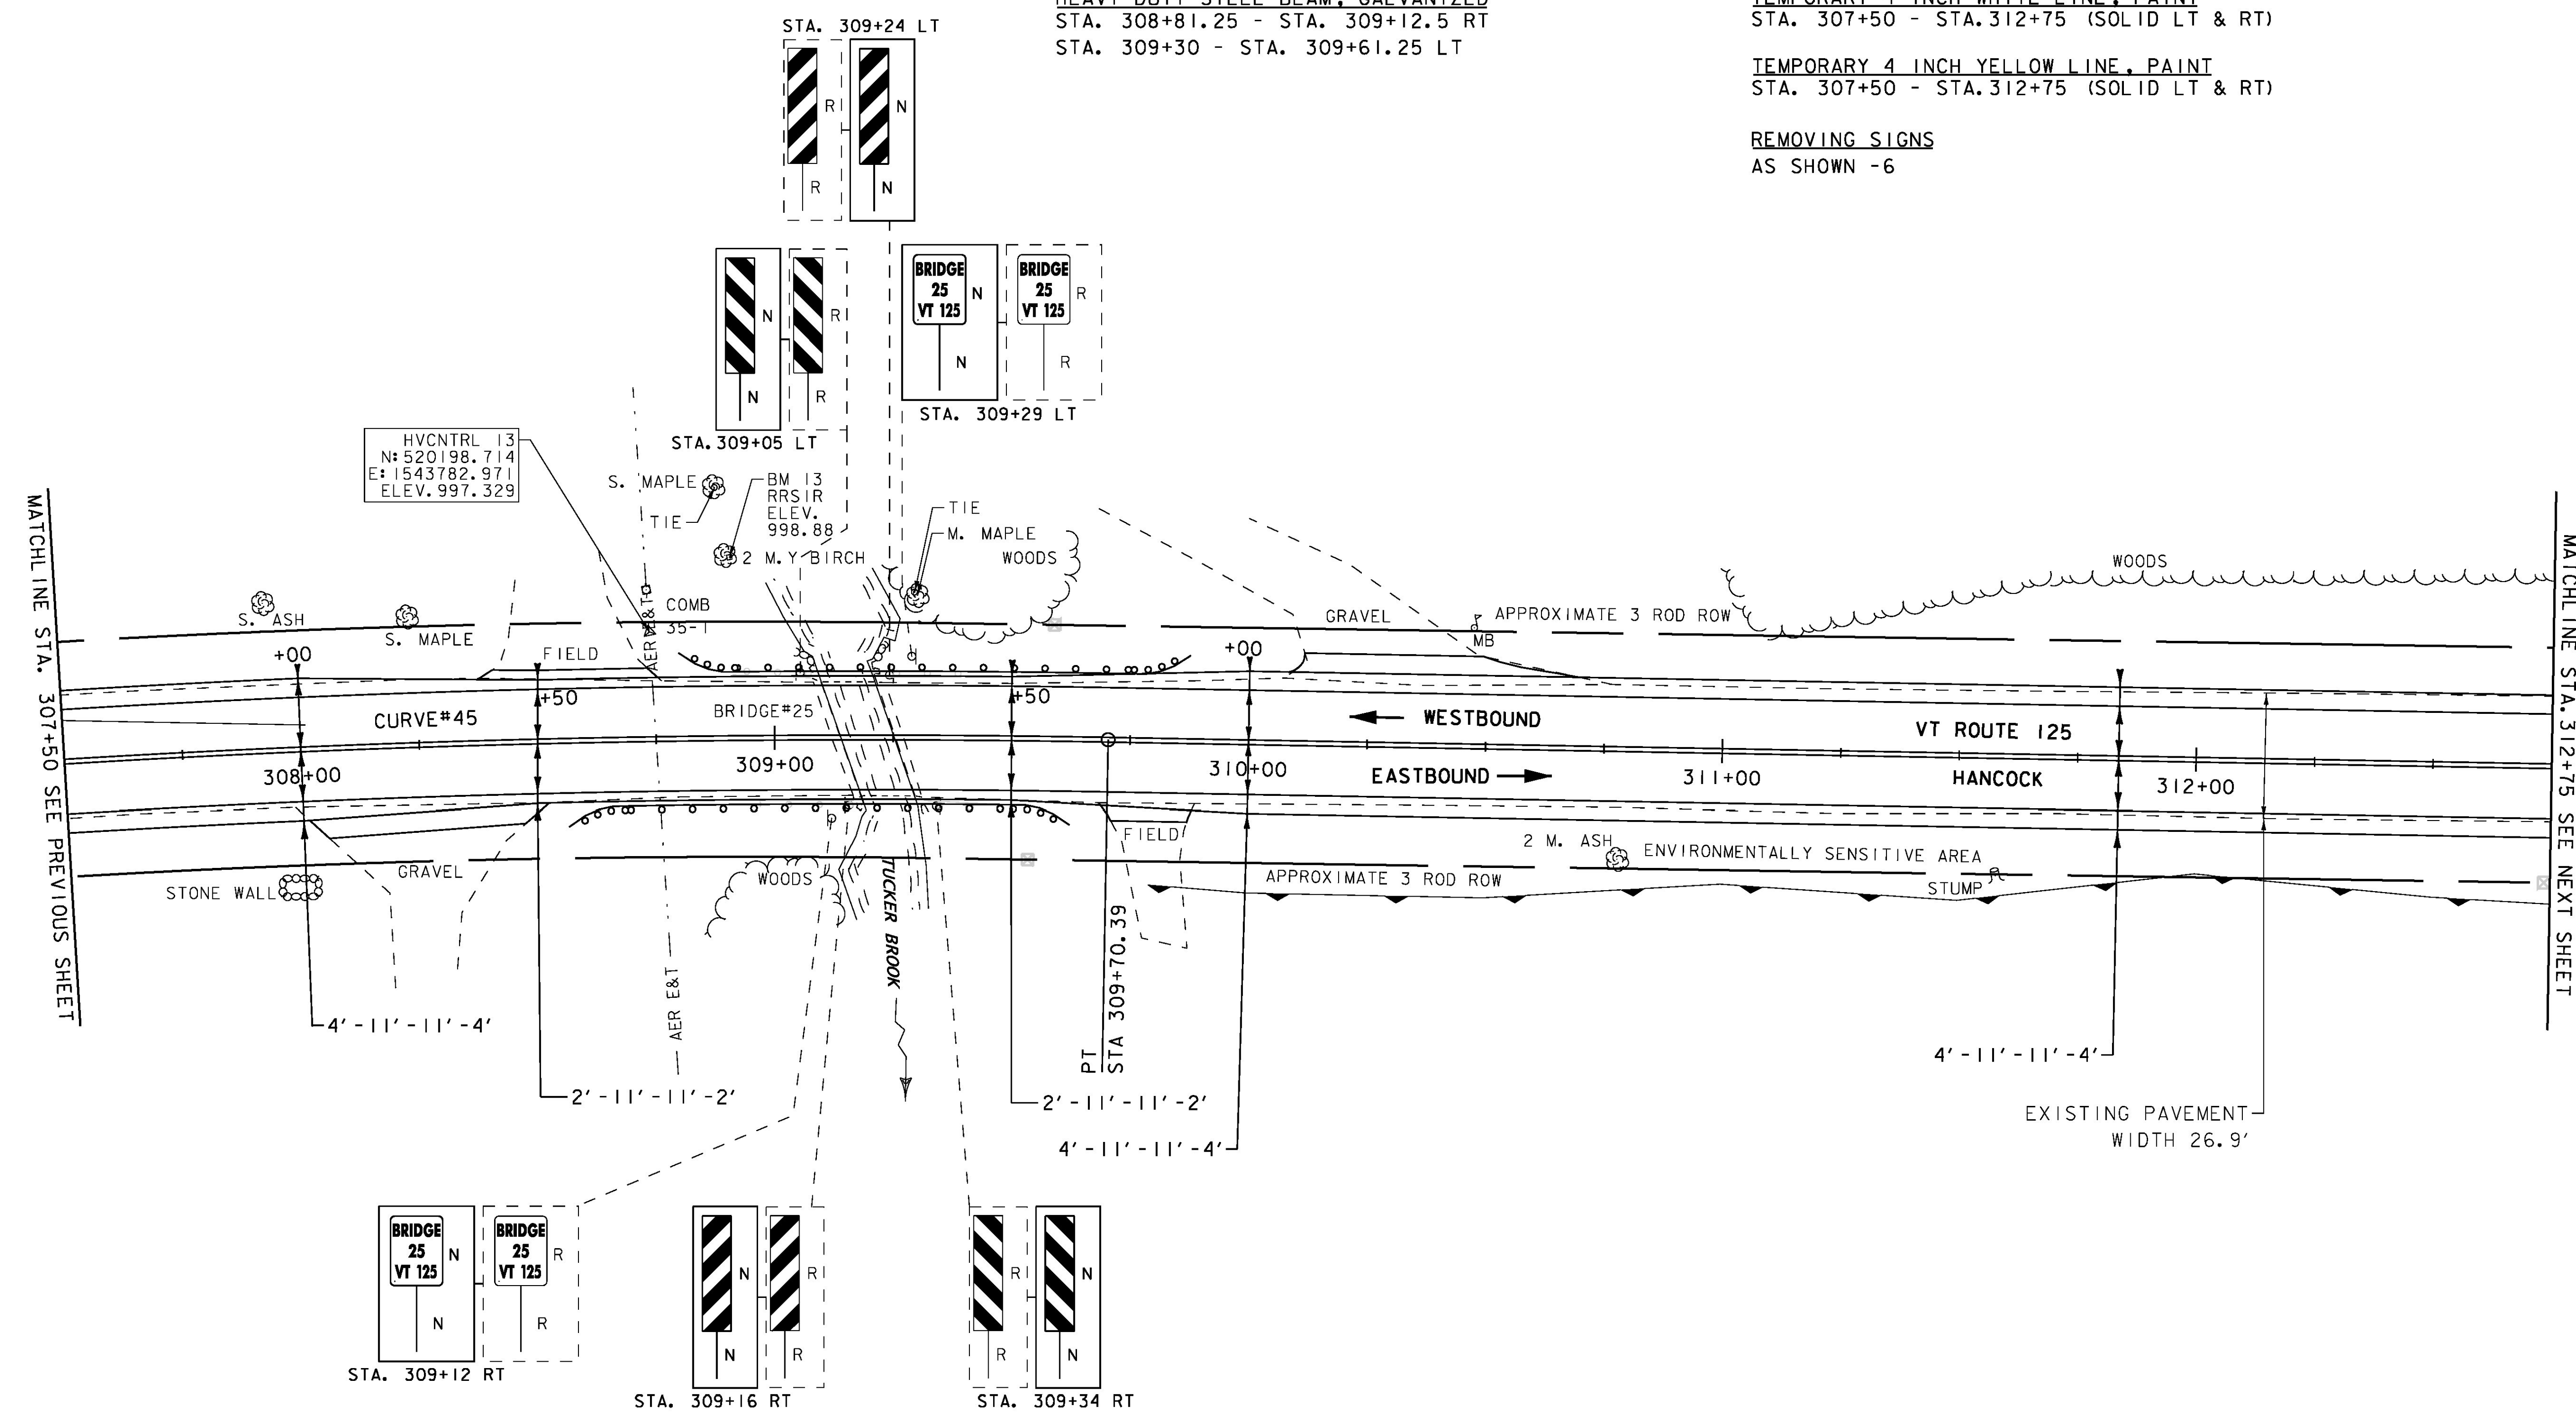

SIGN LEGEND
 R = REMOVE
 R&S = REMOVE AND SALVAGE
 RET = RETAIN
 S = SALVAGED
 N = NEW
 B-B = BACK TO BACK
 - - = EXISTING
 — = NEW

ENVIRONMENTALLY SENSITIVE LOCATIONS:

NO.	LIMITS	POS.	TYPE
9.	STA. 309+79 - STA. 312+75	RT	-

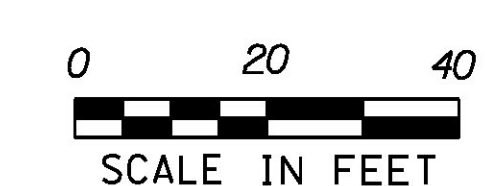

PROJECT NAME: HANCOCK	PLOT DATE: 3/18/2015
PROJECT NUMBER: STP 2923 (1)	DRAWN BY: J. GOODALL
FILE NAME: z10c252bdr.dgn	CHECKED BY: C. LATHROP
PROJECT LEADER: C. LATHROP	SHEET 84 OF 207
DESIGNED BY: B. MARTIN	
PROJECT LAYOUT SHEET 52	