

6 INCH UNDERDRAIN PIPE
 STA. 320+00 - STA. 321+90 LT
 STA. 322+00 - STA. 323+75 LT

STONE FILL, TYPE I
 STA. 322+40 - STA. 322+90 RT

DURABLE 4 INCH WHITE LINE (SEE OPTION ITEMS)
 STA. 318+50 - STA. 323+75 (SOLID LT & RT)
 (WITH EDGE LINE BREAK LT AT TH #5)
 STA. 319+17 LT (EDGE LINES AT TH #5)

DURABLE 4 INCH YELLOW LINE (SEE OPTION ITEMS)
 STA. 318+50 - STA. 323+75 (SOLID LT & RT)
 (WITH CENTERLINE BREAK AT TH #5)
 STA. 319+17 LT (CENTERLINE AT TH #5)

DURABLE 24 INCH STOP BAR (SEE OPTION ITEMS)
 STA. 318+88 - STA. 319+16 LT (TH #5)

DURABLE LETTER OR SYMBOL (SEE OPTION ITEMS)
 STA. 319+04 LT "STOP" (TH #5)

TEMPORARY 4 INCH WHITE LINE, PAINT
 STA. 318+50 - STA. 323+75 (SOLID LT & RT)
 (WITH EDGE LINE BREAK LT AT TH #5)
 STA. 319+17 LT (EDGE LINES AT TH #5)

TEMPORARY 4 INCH YELLOW LINE, PAINT
 STA. 318+50 - STA. 323+75 (SOLID LT & RT)
 (WITH CENTERLINE BREAK AT TH #5)
 STA. 319+17 LT (CENTERLINE AT TH #5)


TEMPORARY 24 INCH STOP BAR, PAINT
 STA. 318+88 - STA. 319+16 LT (TH #5)

TEMPORARY LETTER OR SYMBOL, PAINT
 STA. 319+04 LT "STOP" (TH #5)


GEOTEXTILE FOR SILT FENCE
 STA. 322+40 - STA. 322+90 RT

GRUBBING MATERIAL (6")
 STA. 322+40 - STA. 322+90 RT

REMOVING SIGNS
 AS SHOWN -2

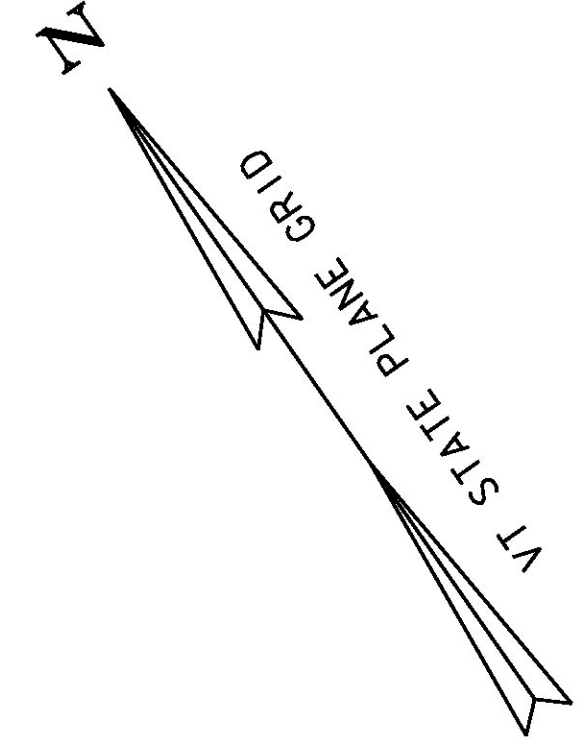

TUCKER BRK. RD.
 TH#5
 MM. = 6.045
 STA. 319+17

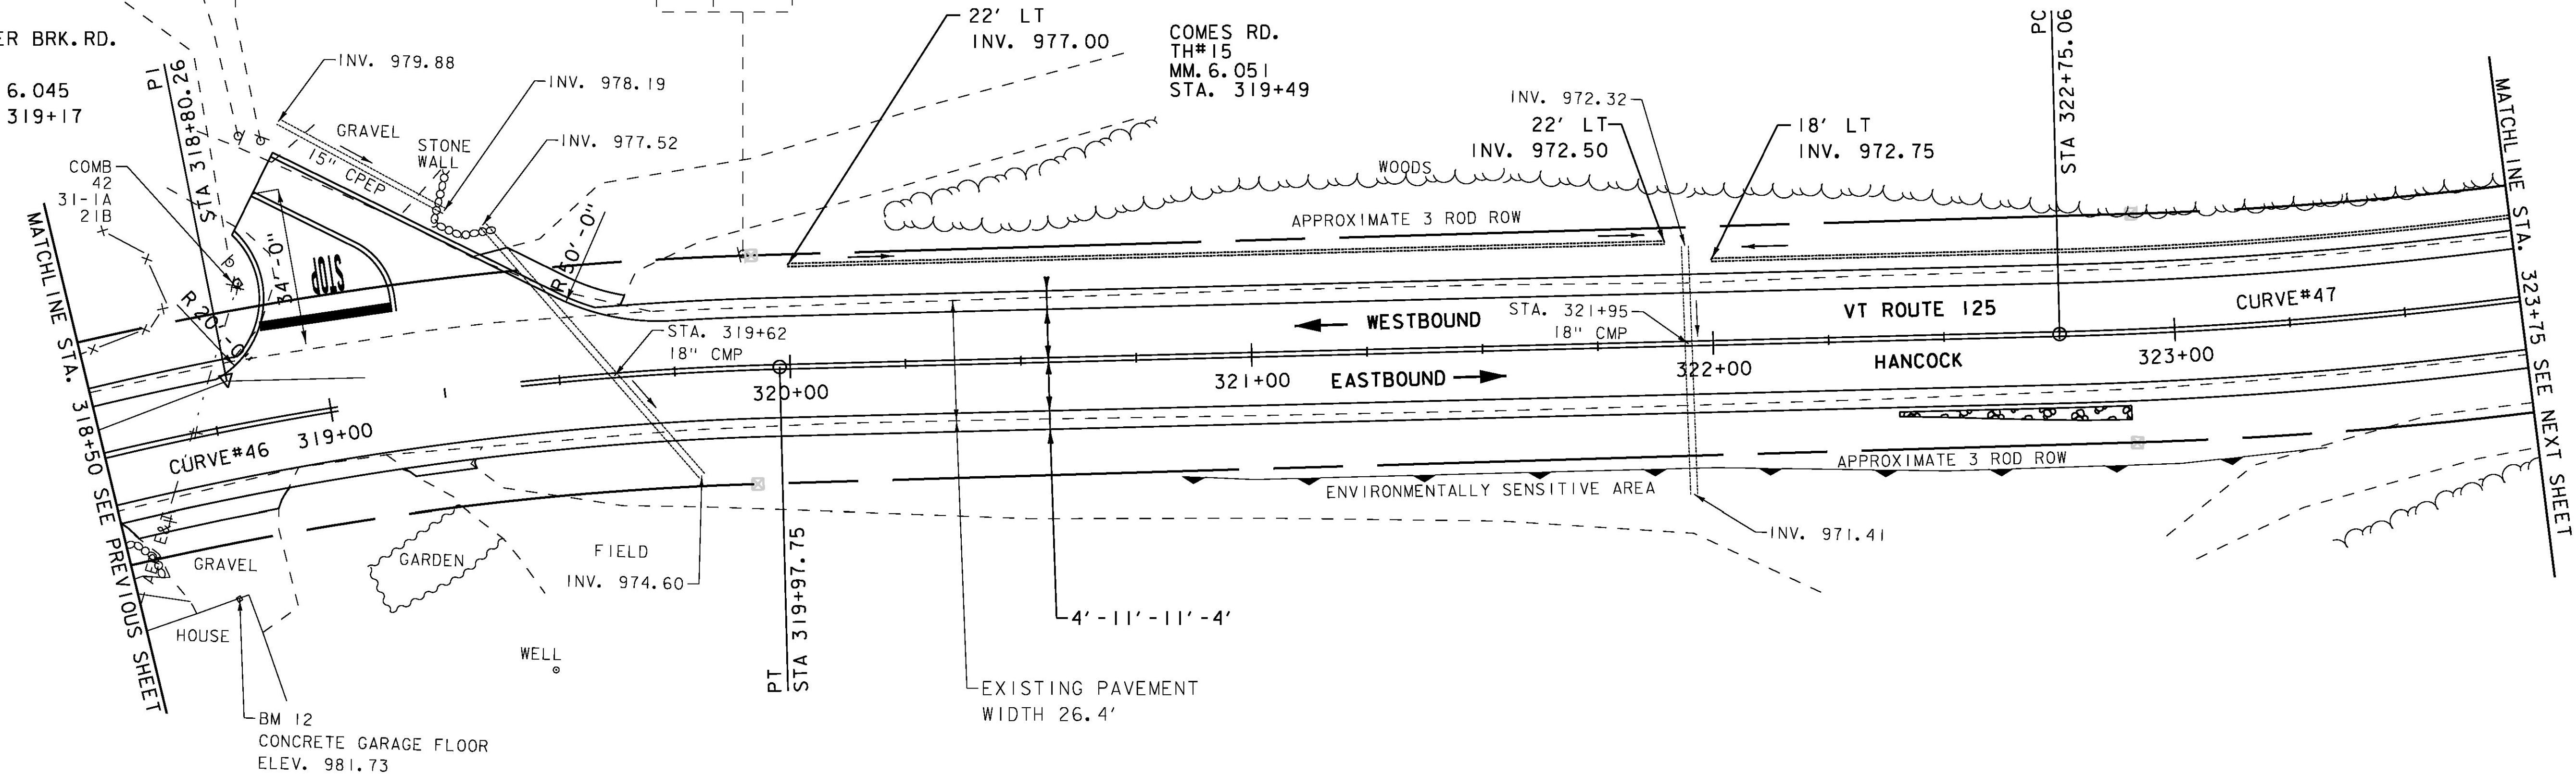

SIGN LEGEND
 R = REMOVE
 R&S = REMOVE AND SALVAGE
 RET = RETAIN
 S = SALVAGED
 N = NEW
 B-B = BACK TO BACK
 - - = EXISTING
 — = NEW

ENVIRONMENTALLY SENSITIVE LOCATIONS:

NO.	LIMITS	POS.	TYPE
10.	STA. 320+84 - STA. 323+31	RT	-

CURVE #46
 DELTA = 19°25'18"
 D = 8°11'06"
 R = 700.00'
 T = 119.79'
 L = 237.28'
 E = 10.18'
 BANKING 0.060 FT/FT
 DESIGN SPEED 45 MPH
 SEE BANKING DIAGRAMS
 FOR MORE INFORMATION



PROJECT NAME: HANCOCK	PLOT DATE: 3/18/2015
PROJECT NUMBER: STP 2923 (1)	DRAWN BY: J. GOODALL
FILE NAME: z10c252bdr.dgn	CHECKED BY: C. LATHROP
DESIGNED BY: B. MARTIN	SHEET 86 OF 207
PROJECT LAYOUT SHEET 54	