

6 INCH UNDERDRAIN PIPE
 STA. 329+50 - STA. 333+00 LT
 STA. 333+00 - STA. 335+25 LT

STONE FILL, TYPE I
 STA. 330+10 - STA. 330+70 RT
 STA. 334+80 - STA. 335+25 RT

REMOVAL AND DISPOSAL OF GUARDRAIL
 STA. 329+50 - STA. 335+25 RT

DURABLE 4 INCH WHITE LINE (SEE OPTION ITEMS)
 STA. 329+50 - STA. 335+25 (SOLID LT & RT)

DURABLE 4 INCH YELLOW LINE (SEE OPTION ITEMS)
 STA. 329+50 - STA. 335+25 (SOLID LT & RT)

TEMPORARY 4 INCH WHITE LINE, PAINT
 STA. 329+50 - STA. 335+25 (SOLID LT & RT)



TEMPORARY 4 INCH YELLOW LINE, PAINT
 STA. 329+50 - STA. 335+25 (SOLID LT & RT)

GEOTEXTILE FOR SILT FENCE
 STA. 330+10 - STA. 330+70 RT
 STA. 334+80 - STA. 335+25 RT


GRUBBING MATERIAL (6")
 STA. 330+10 - STA. 330+70 RT
 STA. 334+80 - STA. 335+25 RT

SPECIAL PROVISION (BOX BEAM
 GUARDRAIL W/7 FEET POSTS)
 STA. 329+50 - STA. 335+25 RT

CURVE #49
 DELTA = 60°04'58"
 D = 10°25'03"
 R = 550.00'
 T = 318.07'
 L = 576.75'
 E = 85.35'
 BANKING 0.080 FT/FT
 DESIGN SPEED 40 MPH
 SEE BANKING DIAGRAMS
 FOR MORE INFORMATION

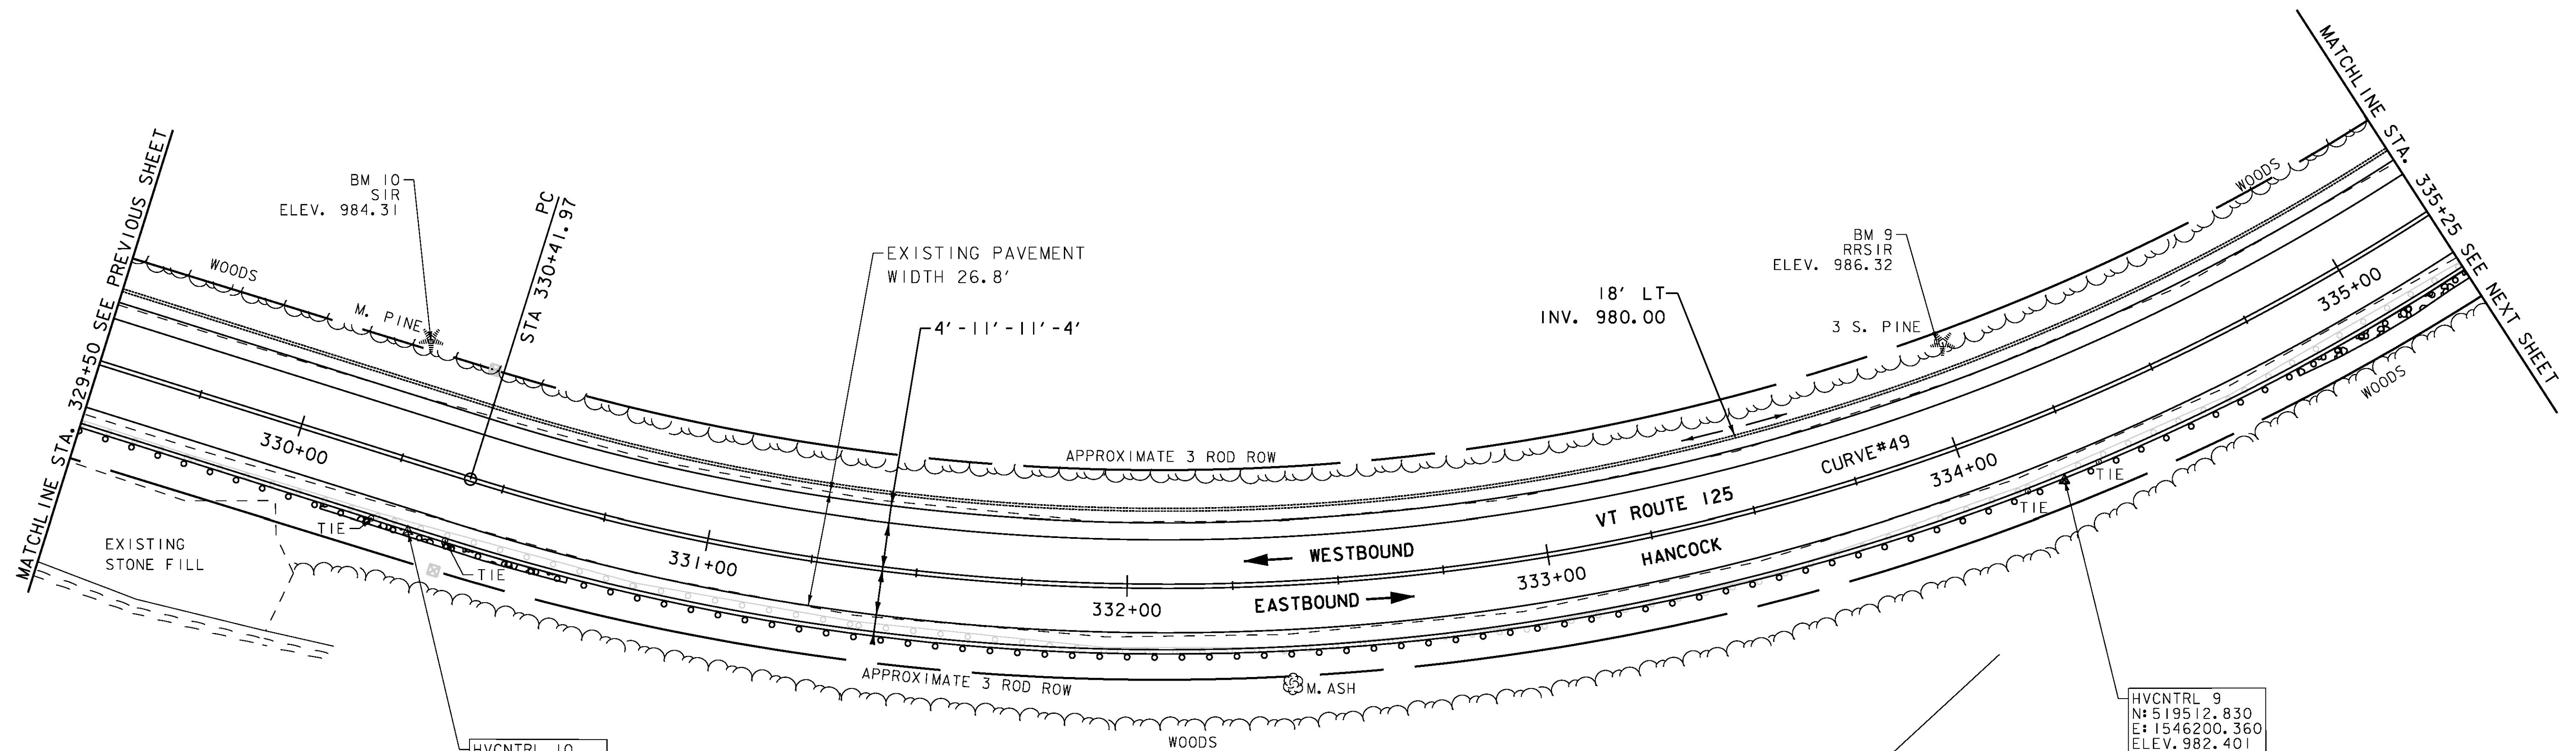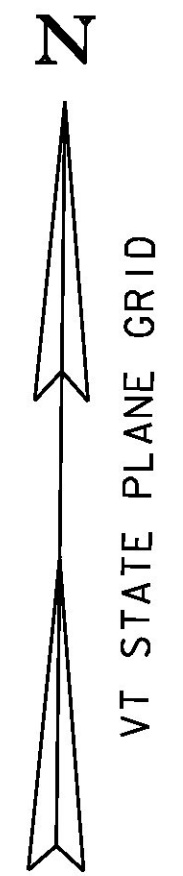

SIGN LEGEND
 R = REMOVE
 R&S = REMOVE AND SALVAGE
 RET = RETAIN
 S = SALVAGED
 N = NEW
 B-B = BACK TO BACK
 - - = EXISTING
 — = NEW

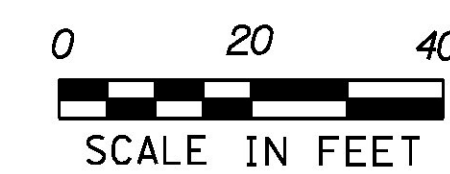

PROJECT NAME: HANCOCK	
PROJECT NUMBER: STP 2923 (1)	
FILE NAME: z10c252bdr.dgn	PLOT DATE: 3/18/2015
PROJECT LEADER: C. LATHROP	DRAWN BY: J. GOODALL
DESIGNED BY: B. MARTIN	CHECKED BY: C. LATHROP
PROJECT LAYOUT SHEET 56	SHEET 88 OF 207