
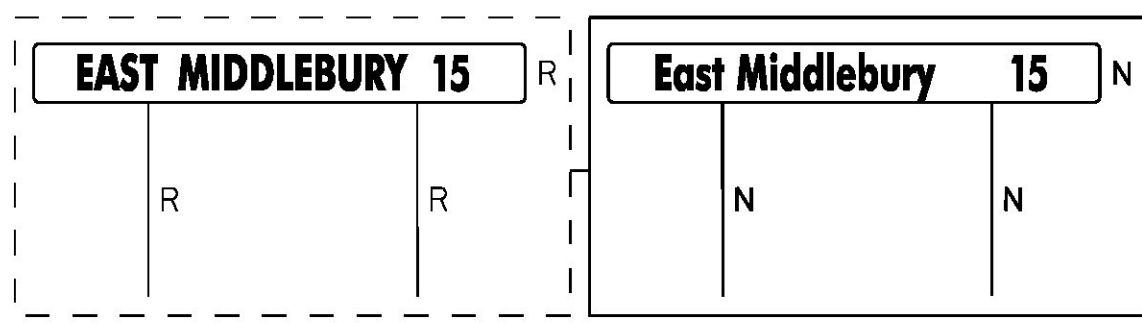
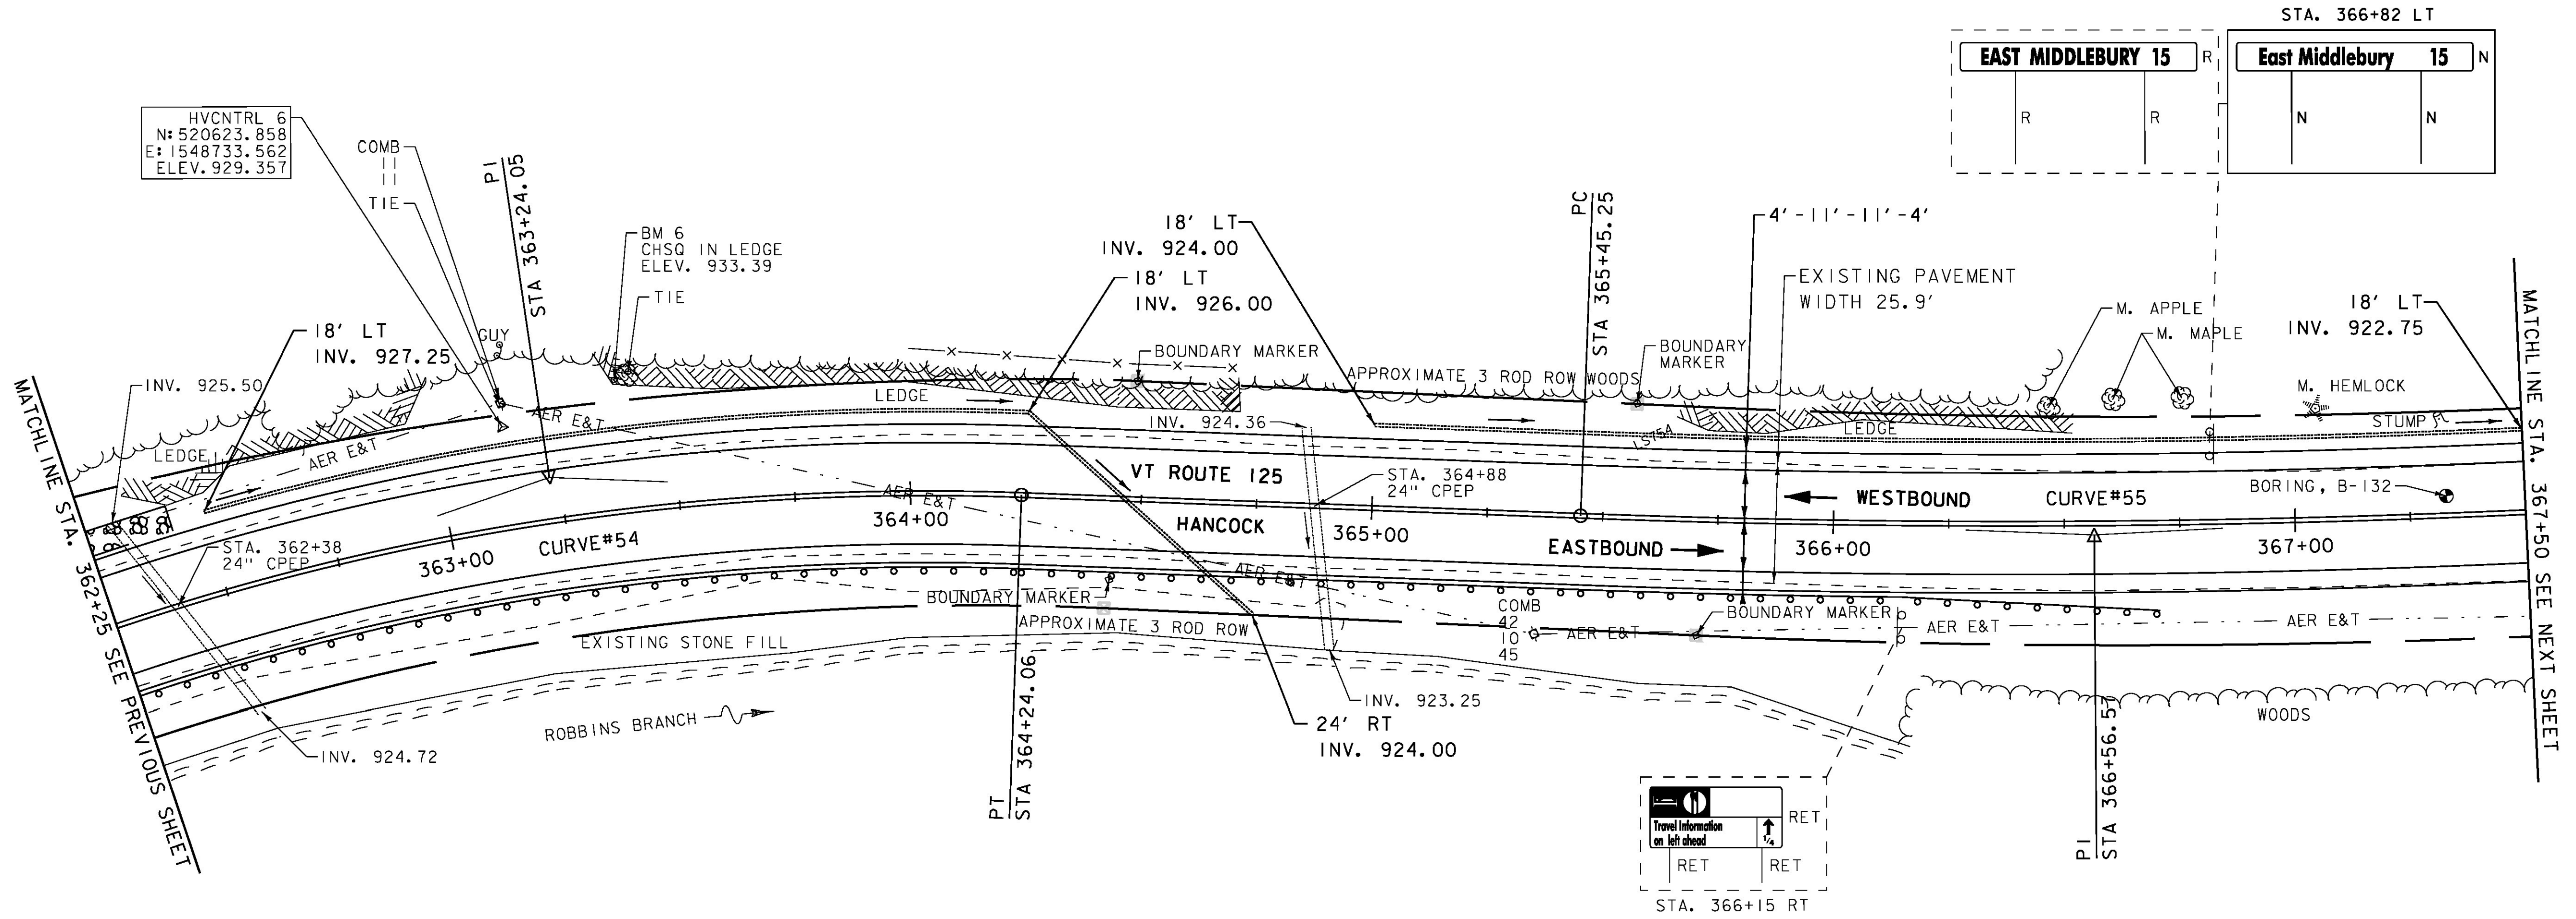


6 INCH UNDERDRAIN PIPE
 STA. 362+50 - STA. 364+75 LT-RT
 STA. 365+00 - STA. 367+00 LT
 STONE FILL, TYPE II
 STA. 362+25 - STA. 362+43 LT

DURABLE 4 INCH WHITE LINE (SEE OPTION ITEMS)
 STA. 362+25 - STA. 367+50 (SOLID LT & RT)
 DURABLE 4 INCH YELLOW LINE (SEE OPTION ITEMS)
 STA. 362+25 - STA. 367+50 (SOLID LT & RT)
 TEMPORARY 4 INCH WHITE LINE, PAINT
 STA. 362+25 - STA. 367+50 (SOLID LT & RT)
 TEMPORARY 4 INCH YELLOW LINE, PAINT
 STA. 362+25 - STA. 367+50 (SOLID LT & RT)

GEOTEXTILE FOR SILT FENCE
 STA. 362+25 - STA. 362+43 LT
 GRUBBING MATERIAL (6")
 STA. 362+25 - STA. 362+43 LT
 REMOVING SIGNS
 AS SHOWN - I
 SPECIAL PROVISION (BOX BEAM
 GUARDRAIL W/7 FEET POSTS)
 STA. 362+25 - STA. 366+70.5 RT

CURVE #55
 DELTA = 5°05'58"
 D = 2°17'31"
 R = 2500.00'
 T = 111.33'
 L = 222.50'
 E = 2.48'
 BANKING 0.030 FT/FT
 DESIGN SPEED 40 MPH
 SEE BANKING DIAGRAMS
 FOR MORE INFORMATION

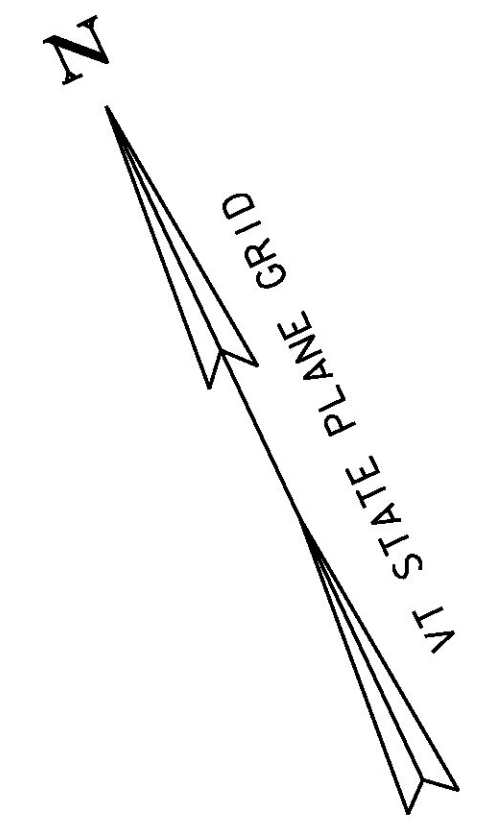

SIGN LEGEND
 R = REMOVE
 R&S = REMOVE AND SALVAGE
 RET = RETAIN
 S = SALVAGED
 N = NEW
 B-B = BACK TO BACK
 - - = EXISTING
 — = NEW

CURVE #54
 DELTA = 21°04'41"
 D = 10°25'03"
 R = 550.00'
 T = 102.32'
 L = 202.33'
 E = 9.44'
 BANKING 0.077 FT/FT
 DESIGN SPEED 40 MPH
 SEE BANKING DIAGRAMS
 FOR MORE INFORMATION



PROJECT NAME: HANCOCK	
PROJECT NUMBER: STP 2923 (1)	
FILE NAME: z10c252bdr.dgn	PLOT DATE: 3/18/2015
PROJECT LEADER: C. LATHROP	DRAWN BY: J. GOODALL
DESIGNED BY: B. MARTIN	CHECKED BY: C. LATHROP
PROJECT LAYOUT SHEET 62	SHEET 94 OF 207