



ROUTE MARKER ASSEMBLY FRAMES

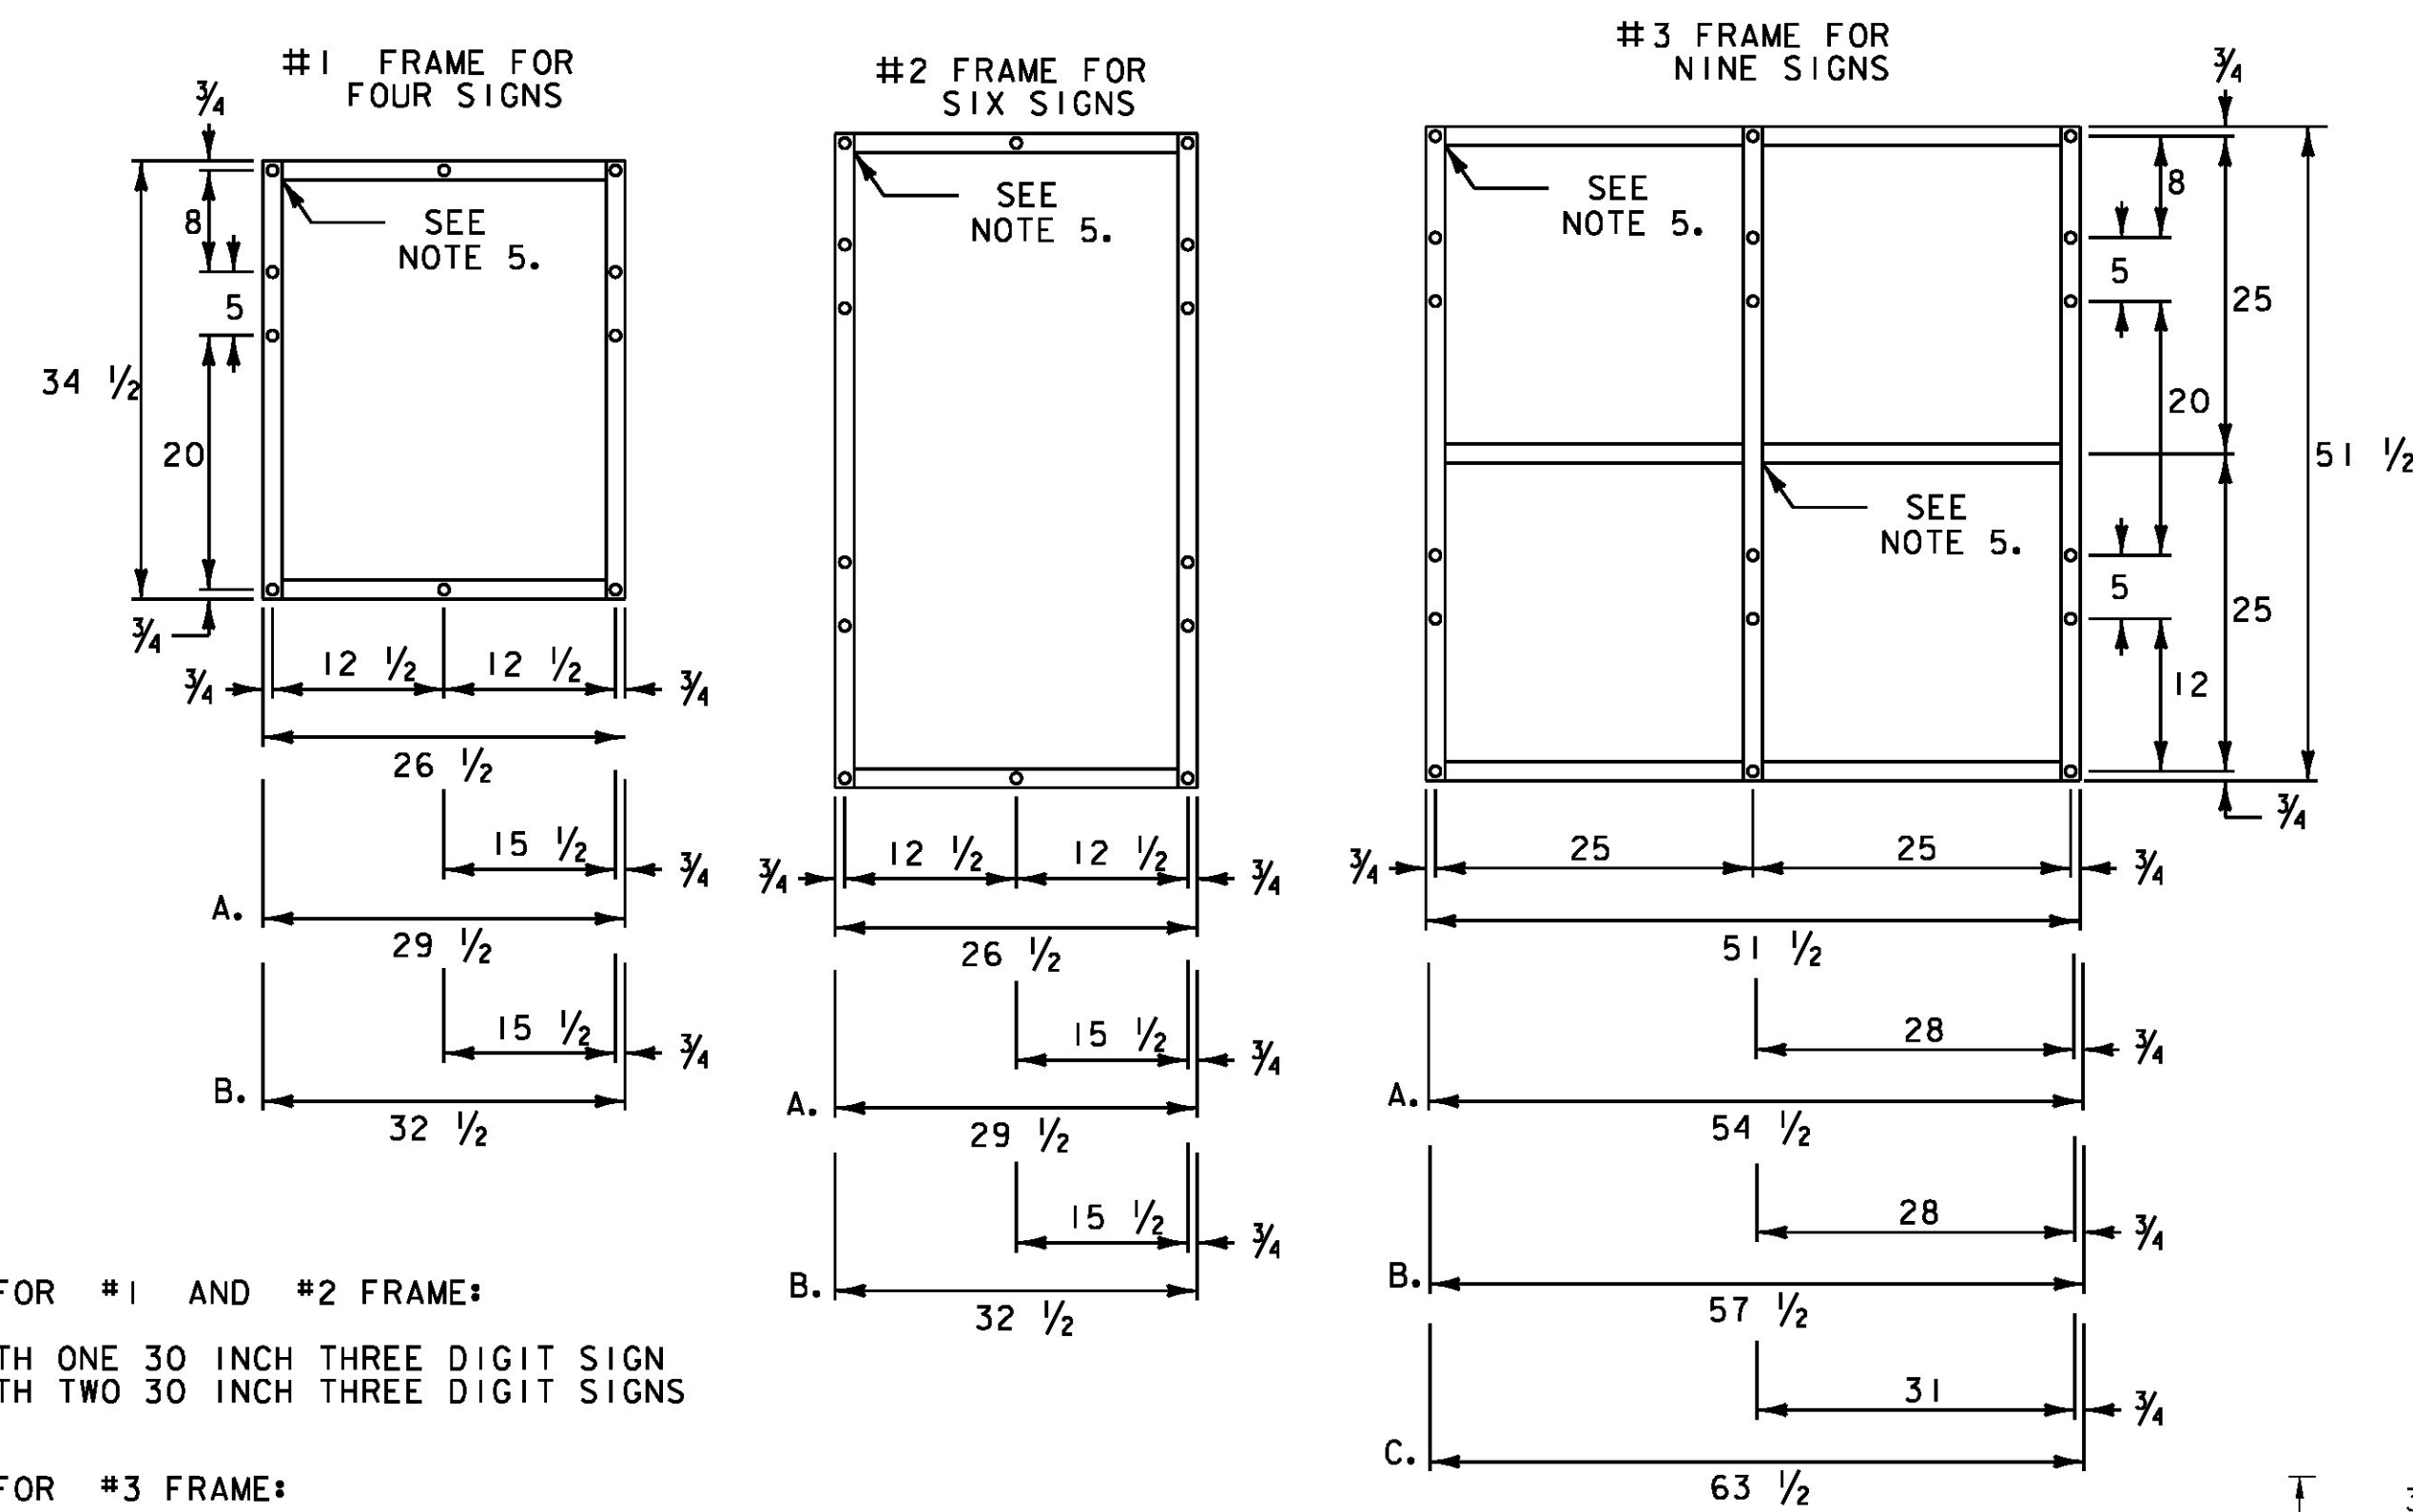

NOTES:

- NOTES FOR #1 AND #2 FRAME:
 - WITH ONE 30 INCH THREE DIGIT SIGN
 - WITH TWO 30 INCH THREE DIGIT SIGNS
- NOTES FOR #3 FRAME:
 - WITH ONE 30 INCH THREE DIGIT SIGN IN AN OUTSIDE POSITION.
 - WITH ONE 30 INCH THREE DIGIT SIGN IN THE CENTER POSITION OR TWO SUCH SIGNS IN THE OUTSIDE POSITIONS.
 - WITH THREE 30 INCH THREE DIGIT SIGNS.
- ALL HOLES SHALL BE 1/8 INCH DIAMETER. FOR SIGN COMBINATIONS OTHER THAN ABOVE, THE FRAME DIMENSIONS AND HOLE SPACING SHALL BE MODIFIED AS NECESSARY. THE FRAME SHALL BE PAINTED WITH ONE COAT OF PRIMER AND A SECOND COAT OF BLACK PAINT. THE PAINT SHALL BE OF THE TYPE USED ON EXTERIOR METAL SURFACES TO PREVENT METAL CORROSION.
- STANDARD FRAMES SHALL BE 3/8 INCH x 1 1/2 INCH WELDED ASTM A-36 STEEL.
- ALL OVERLAPPED CONNECTIONS SHALL BE WELDED WITH TWO, 1/4 INCH WIDE FILLET WELDS, 1 1/2 INCHES LONG.

STANDARD MOUNTING OF ROUTE MARKER ASSEMBLIES

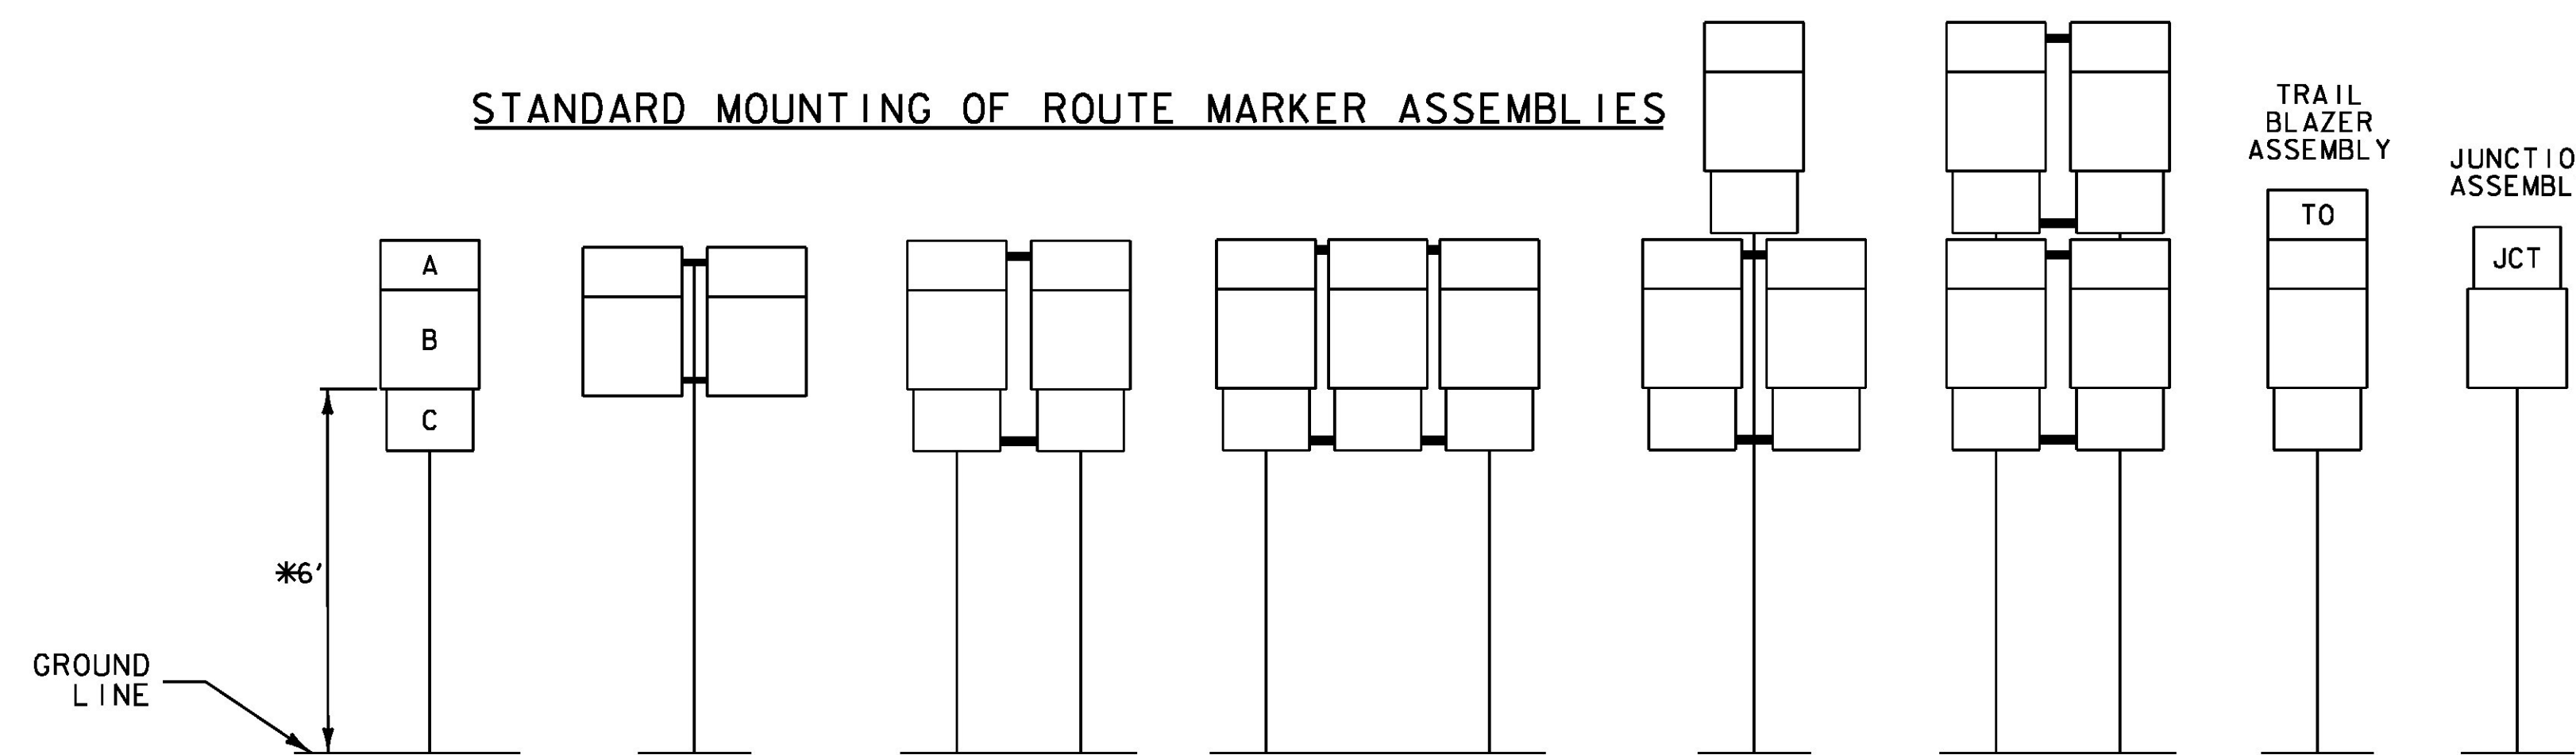

A - CARDINAL DIRECTION MARKER
 B - ROUTE NUMBER
 C - ADVANCE TURN ARROW OR DIRECTIONAL ARROW

*WHERE PARKING OR PEDESTRIAN TRAFFIC WILL OCCUR IN THE IMMEDIATE VICINITY OF THESE SIGNS MINIMUM VERTICAL CLEARANCE SHALL BE INCREASED TO SEVEN FEET


INSTALLATION SEQUENCE:

IN MULTIPLE HORIZONTAL MOUNTINGS PLACE A ROUTE MARKER ASSEMBLY INDICATING A LEFT TURN ON THE LEFT SIDE OF THE ASSEMBLY; RIGHT TURN ON THE RIGHT SIDE. FOR VERTICALLY STACKED MOUNTINGS PLACE THE STRAIGHT THROUGH MOVE INDICATION ON TOP, THE LEFT OR RIGHT TURNS AS APPROPRIATE BENEATH.


NOTES:

- ALL DIMENSIONS SHOWN IN INCHES EXCEPT WHERE NOTED.
- VERTICAL FRAME MEMBERS SHALL LINE UP WITH SIGN POST ON WHICH THEY ARE MOUNTED.


DETAILS ARE NOT TO SCALE

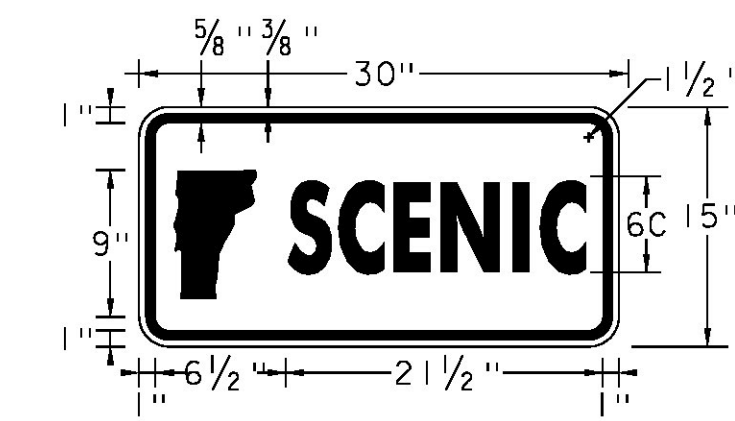

VM-064
 OPTICALLY CENTER
 VERMONT LOGO
 STA. 376+04 RT
 STA. 379+81 LT
 GREEN ON WHITE

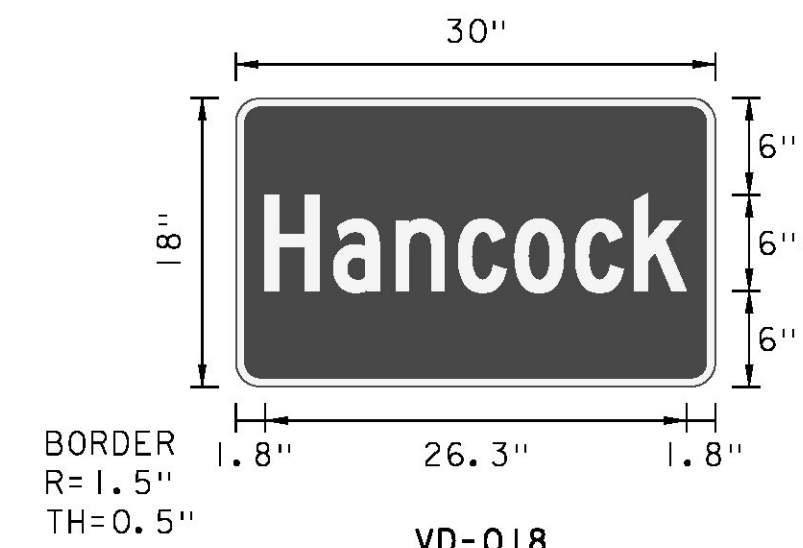


VD-018
 STA. 358+03 RT
 GREEN ON WHITE

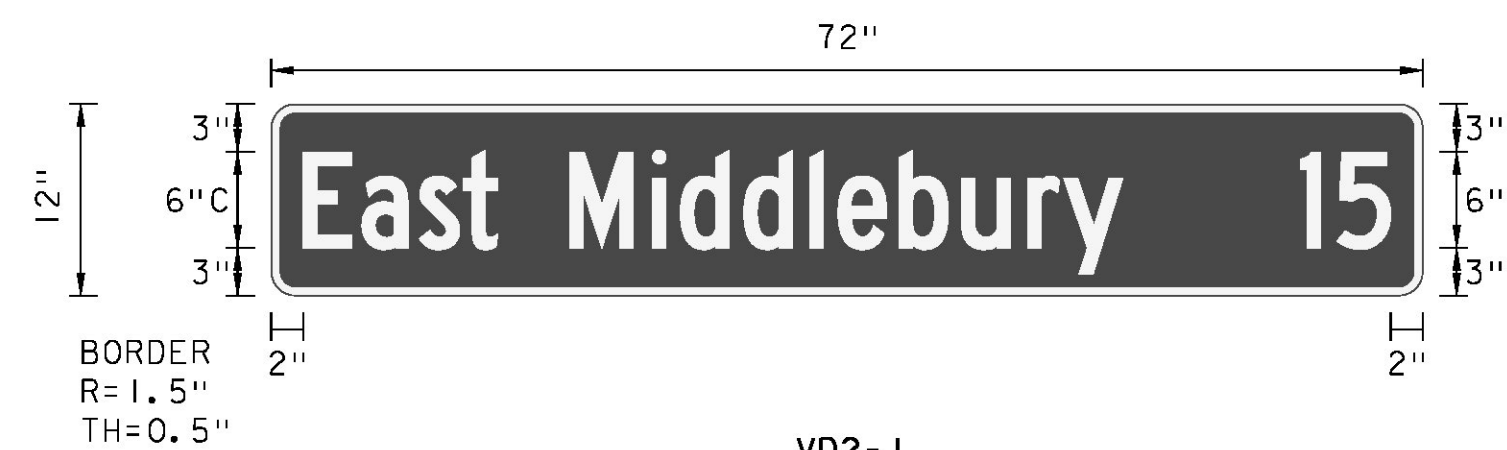


VD2-1
 STA. 366+82 LT
 GREEN ON WHITE




VD1-1A
 STA. 379+25 RT
 GREEN ON WHITE

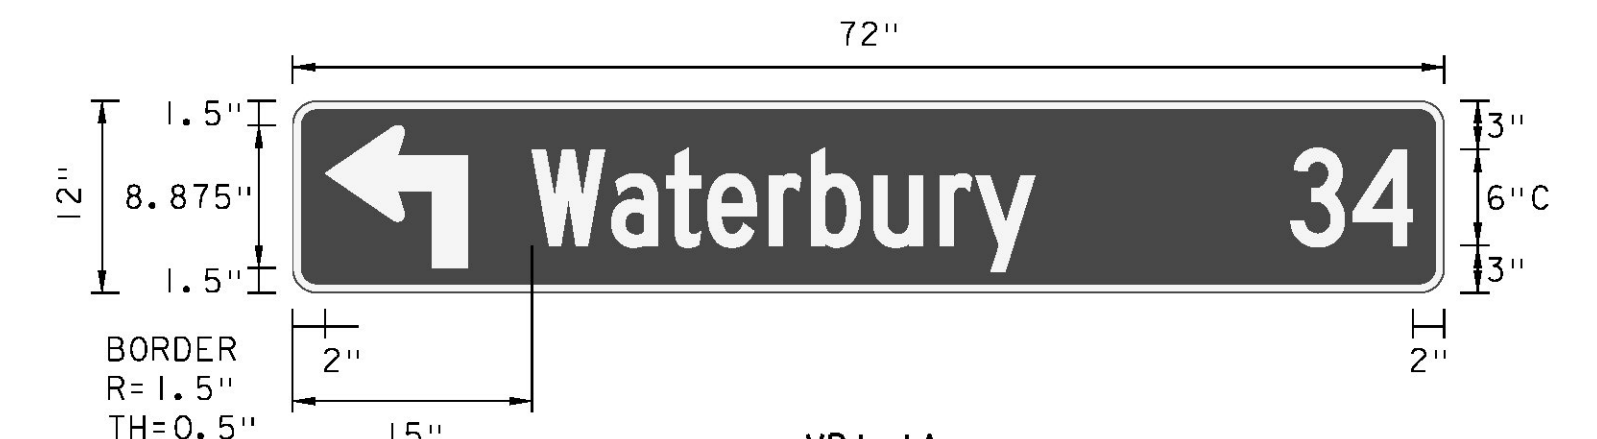

VD1-1A
 STA. 379+25 RT
 GREEN ON WHITE

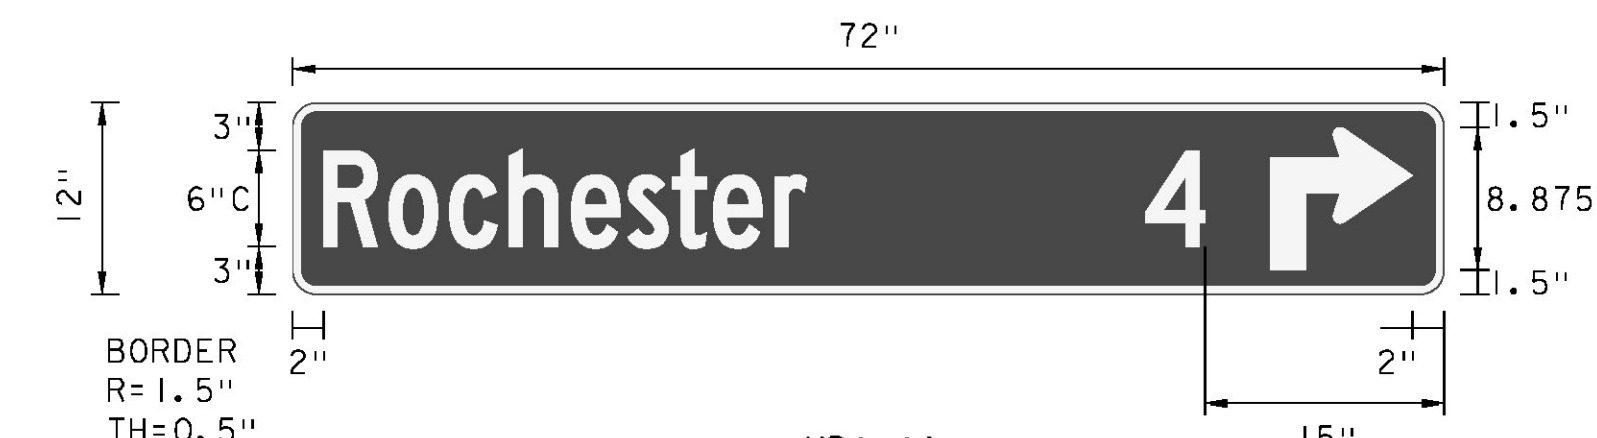

VD1-1A
 STA. 379+25 RT
 GREEN ON WHITE

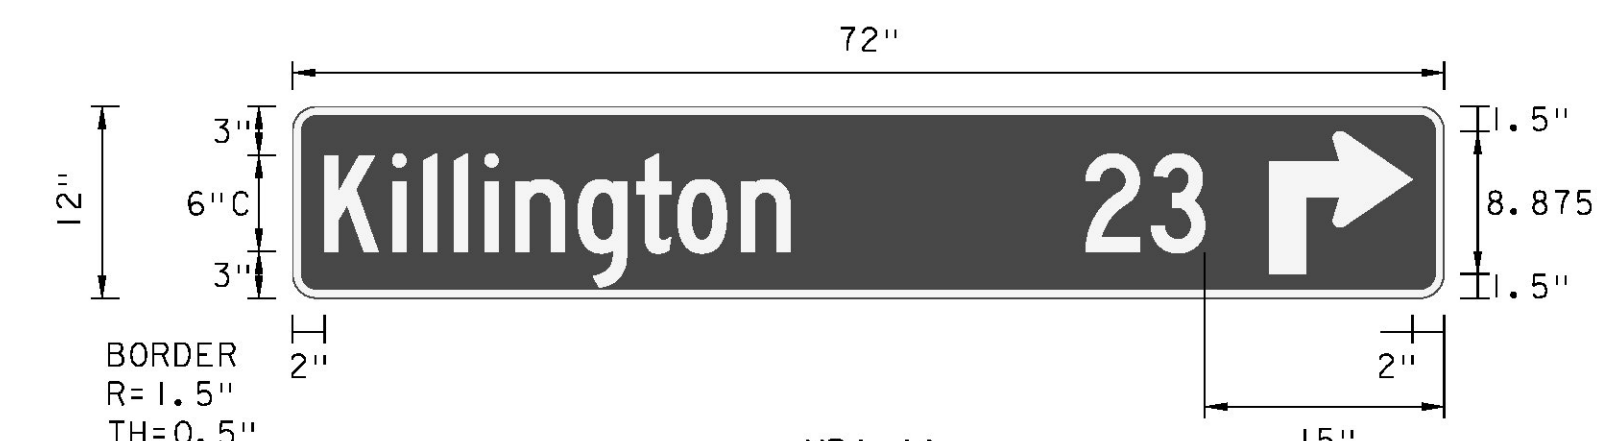

VD1-1A
 STA. 379+25 RT
 GREEN ON WHITE

**STANDARD DESTINATION SIGN NOTES
 VD1-1A, VD2-1**

- THE DESTINATION SIGNS SHOWN ON THIS SHEET SHALL HAVE WHITE RETROREFLECTIVE ASTM D 4956 TYPE III OR IV TEXT, ARROWS AND BORDERS ON A GREEN RETROREFLECTIVE ASTM D 4956 TYPE III OR IV BACKGROUND.
- USE THE LARGEST LETTER / THICKEST FONT AVAILABLE THAT WILL SATISFY THE MINIMUM SPACING REQUIREMENTS, AS SHOWN IN THE DETAILS ABOVE; I.E. IF A 6" SERIES C LETTER DOES NOT WORK, DUE TO THE LENGTH OF THE WORD, USE A 6" SERIES B LETTER. IF A 6" SERIES B LETTER DOES NOT WORK, USE A 5" SERIES C. IF A 5" SERIES C LETTER DOES NOT WORK, USE A 5" SERIES B. USE NO LESS THAN 80% KERNING.
- ALL NUMERALS SHALL BE TYPE C FONT.

NOTE:
 ALL STREET NAME SIGNS ARE DOUBLE SIDED

KEY

R = RADIUS
 TH = THICKNESS
 IND = INDENT

PROJECT NAME: HANCOCK
 PROJECT NUMBER: STP 2923 (1)

FILE NAME: z10c252tsss.dgn
 PROJECT LEADER: C. LATHROP
 DESIGNED BY: B. MARTIN
 SIGN DETAIL SHEET

PLOT DATE: 3/18/2015
 DRAWN BY: J. GOODALL
 CHECKED BY: C. LATHROP
 SHEET 123 OF 207