




42+30
SKEWED

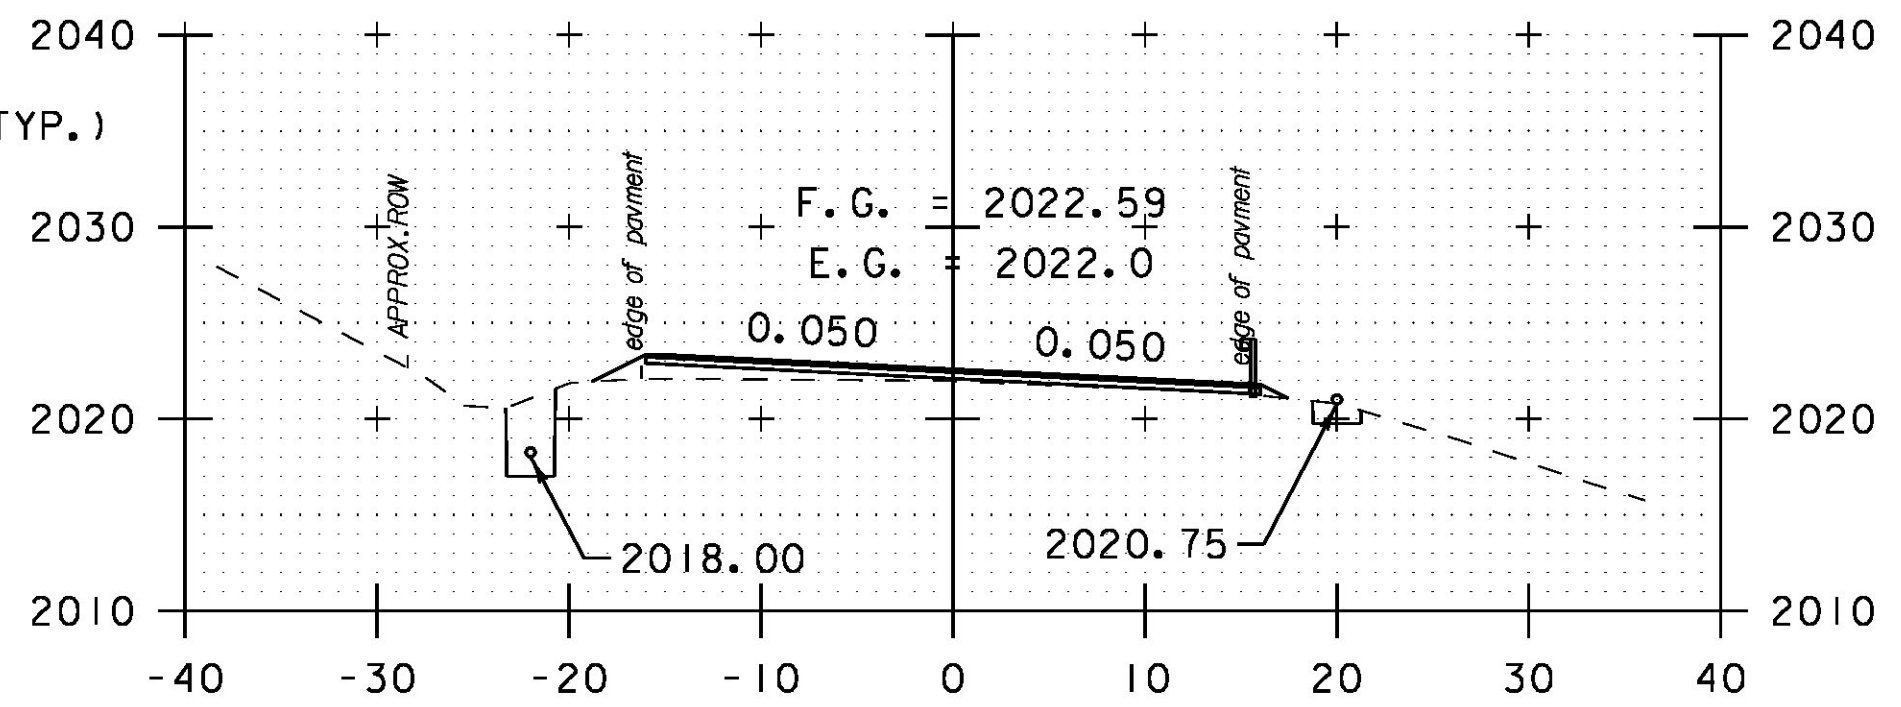


44+00

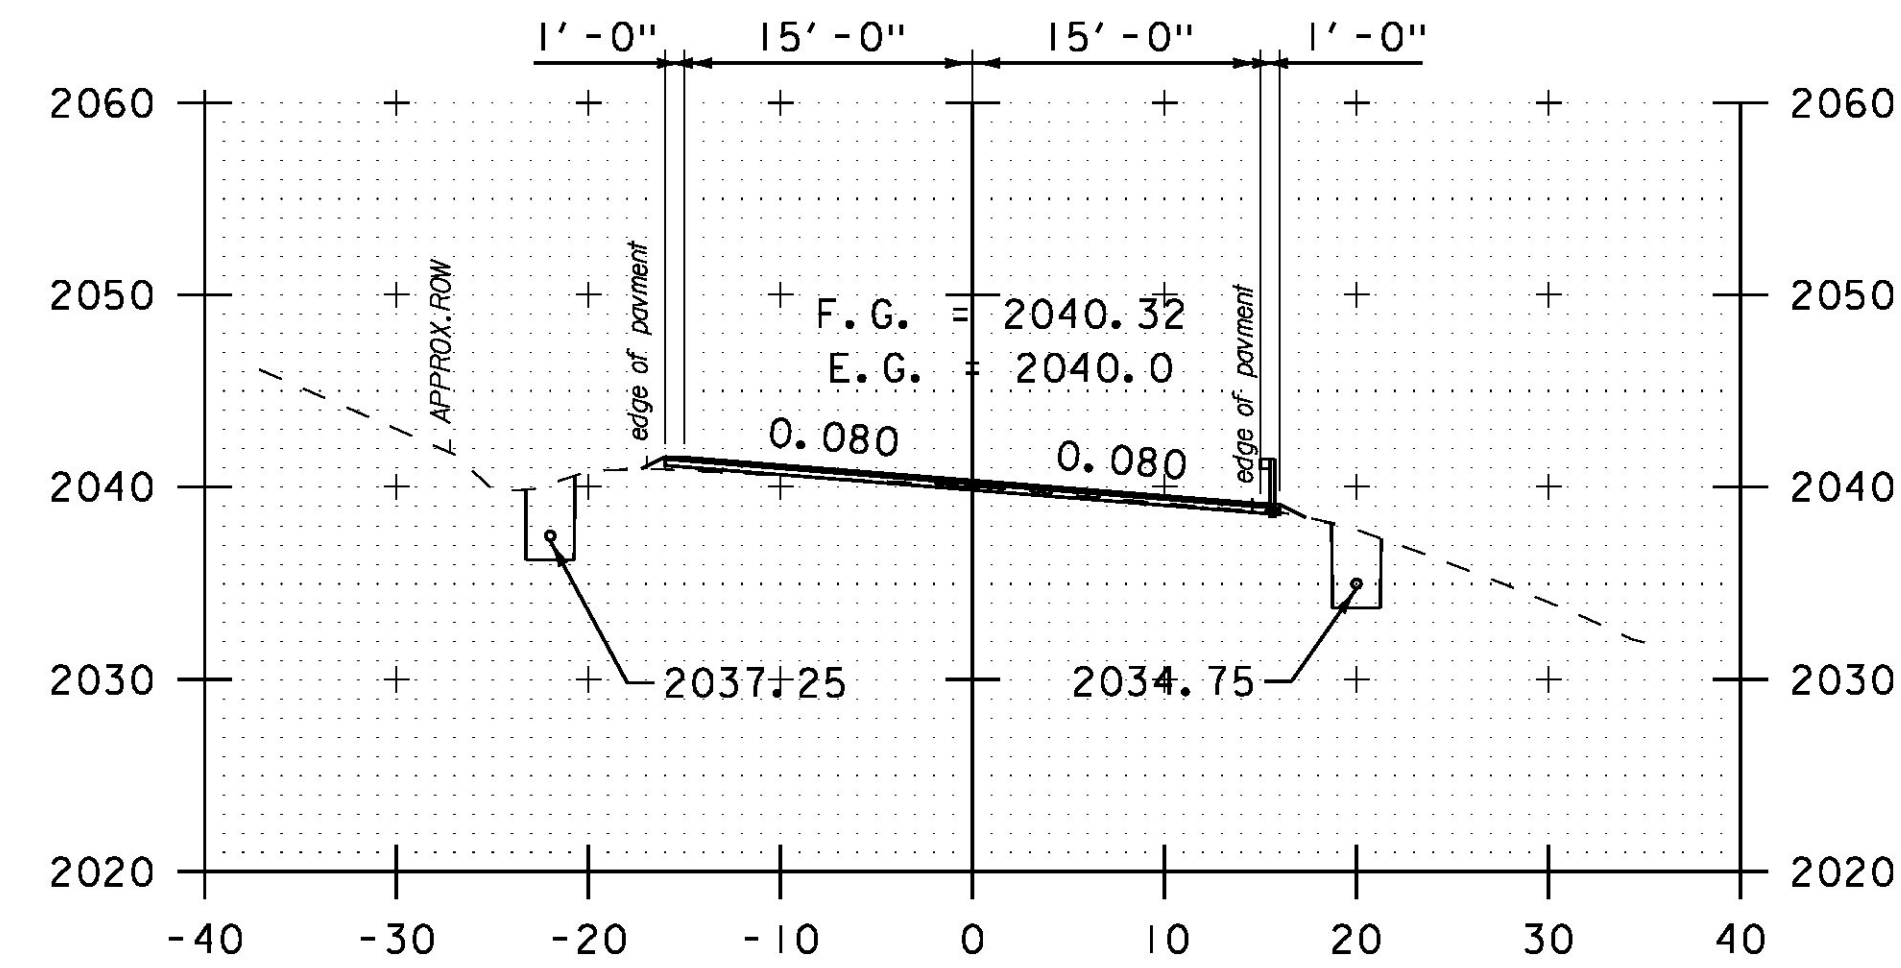


45+50

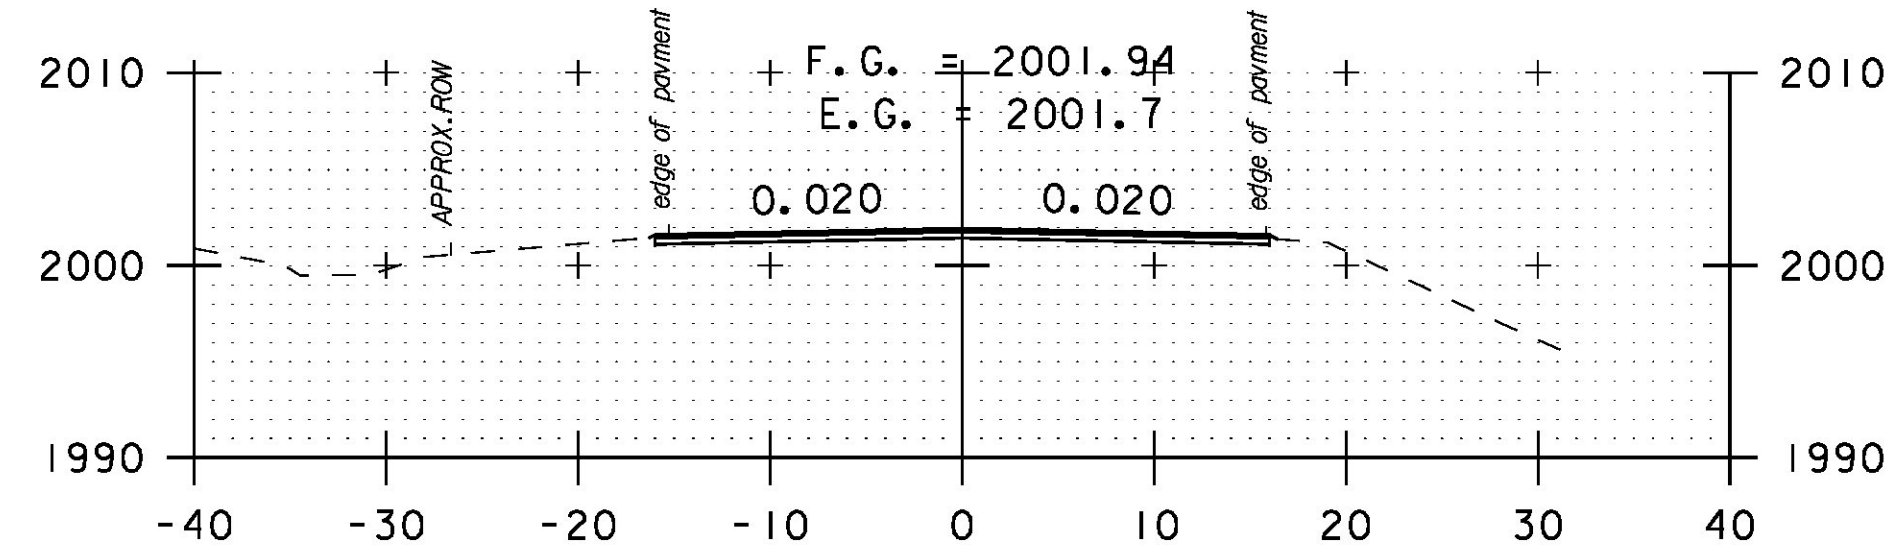


42+00

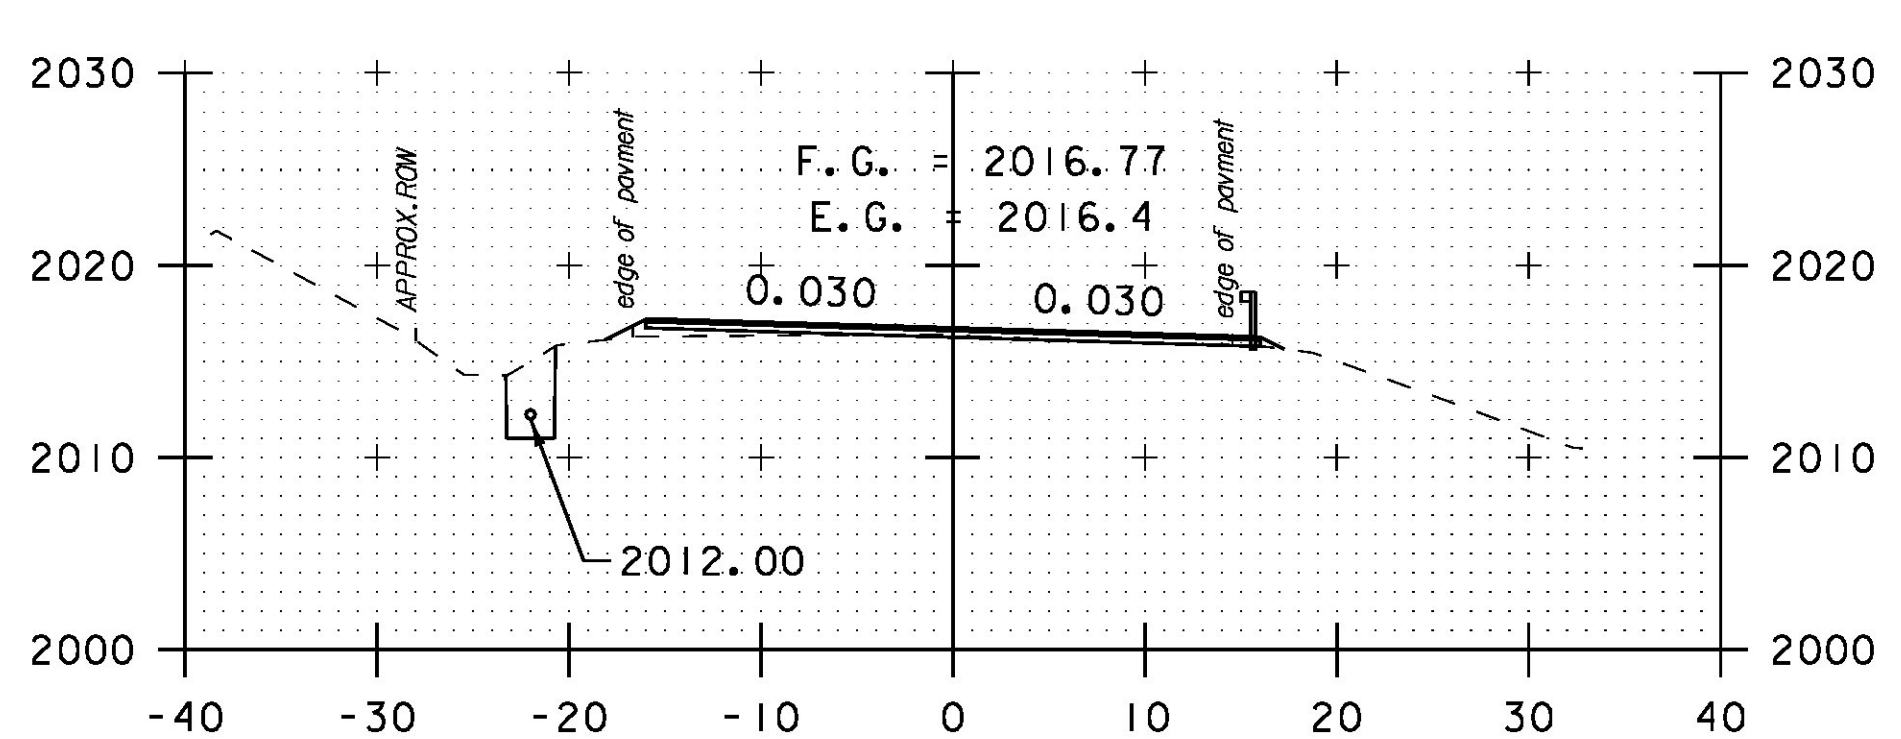


43+50

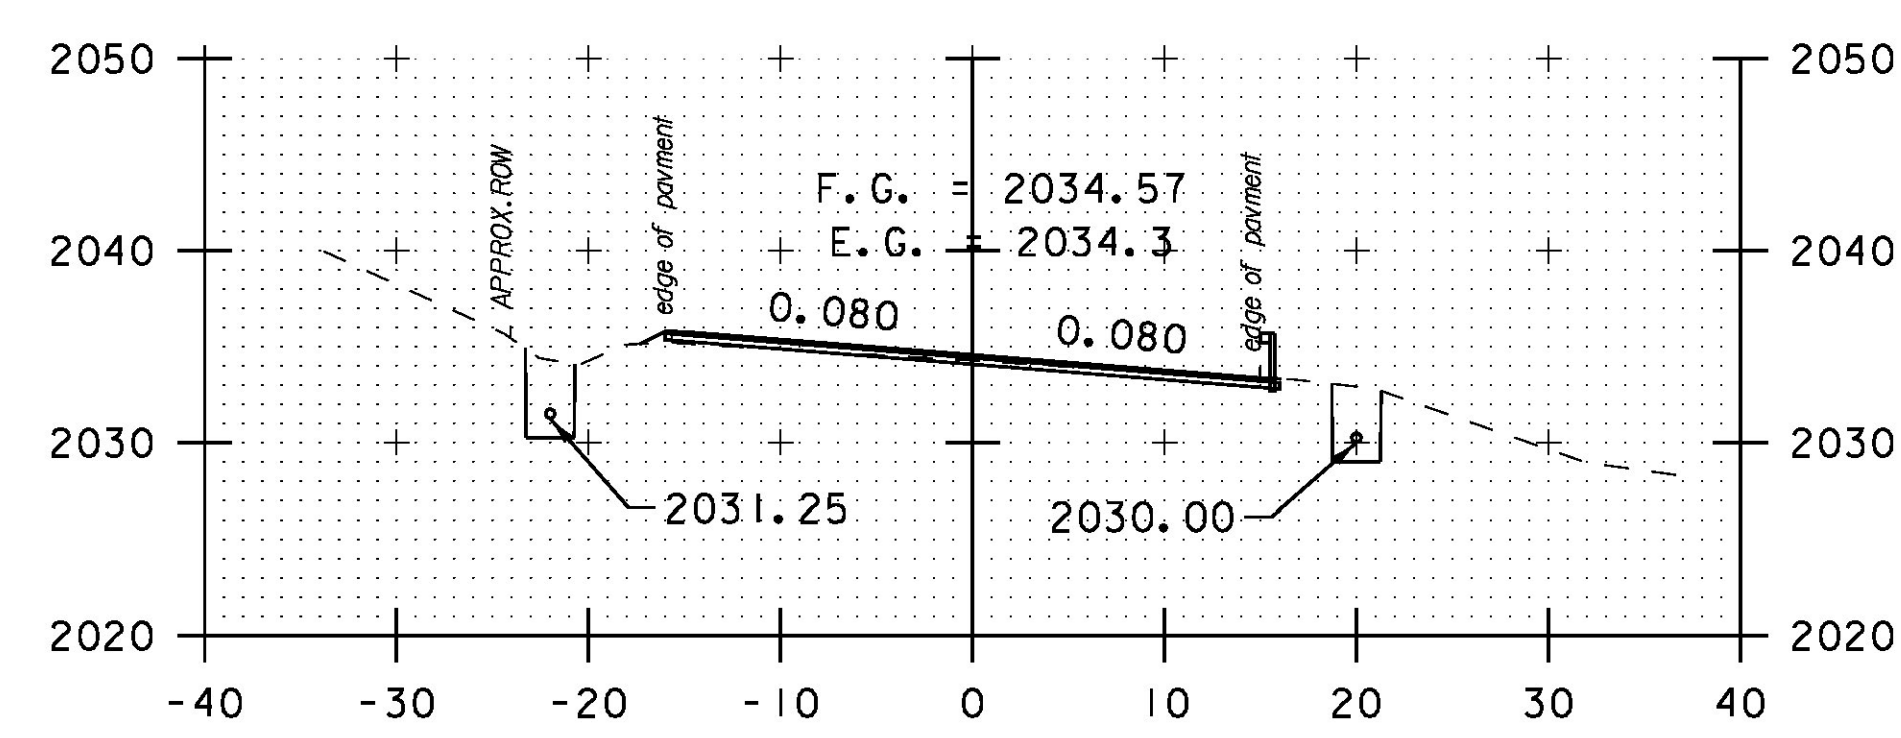


45+00

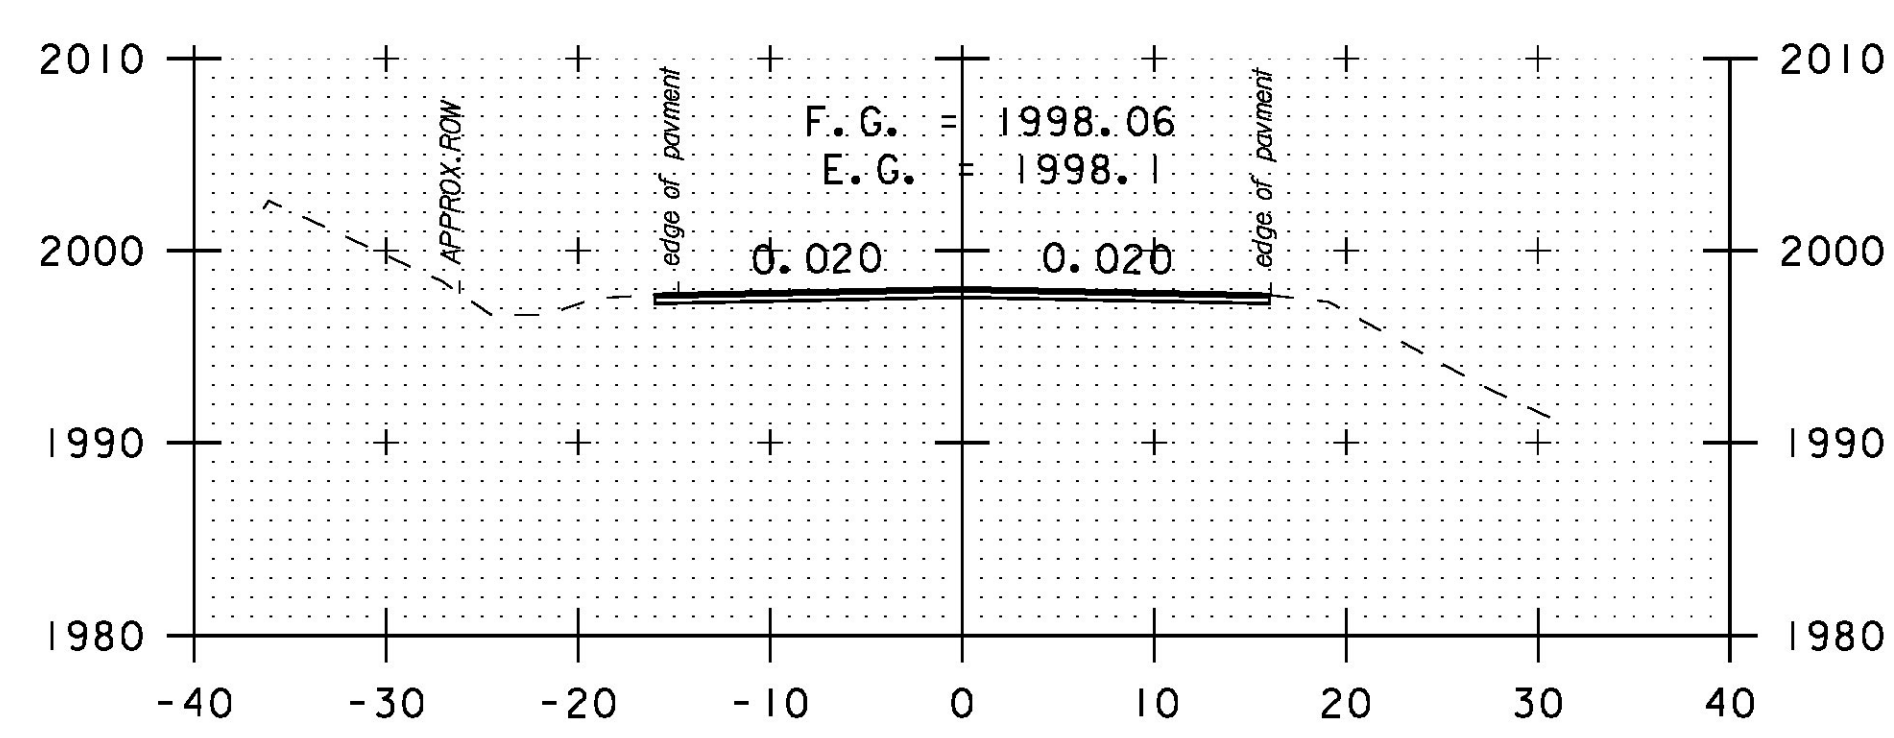


41+50

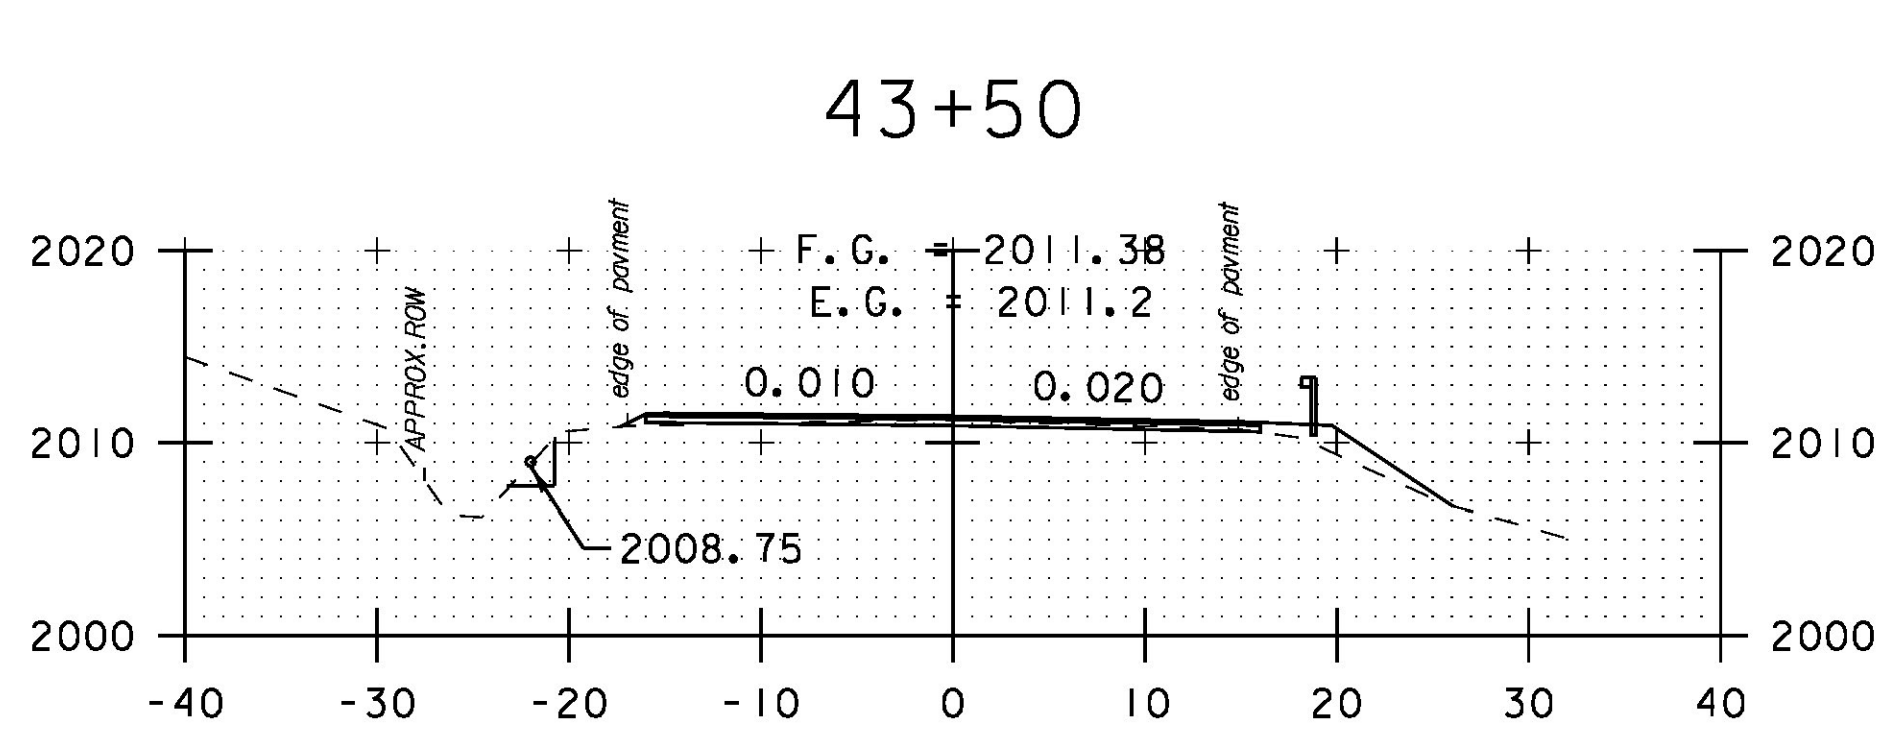


43+00

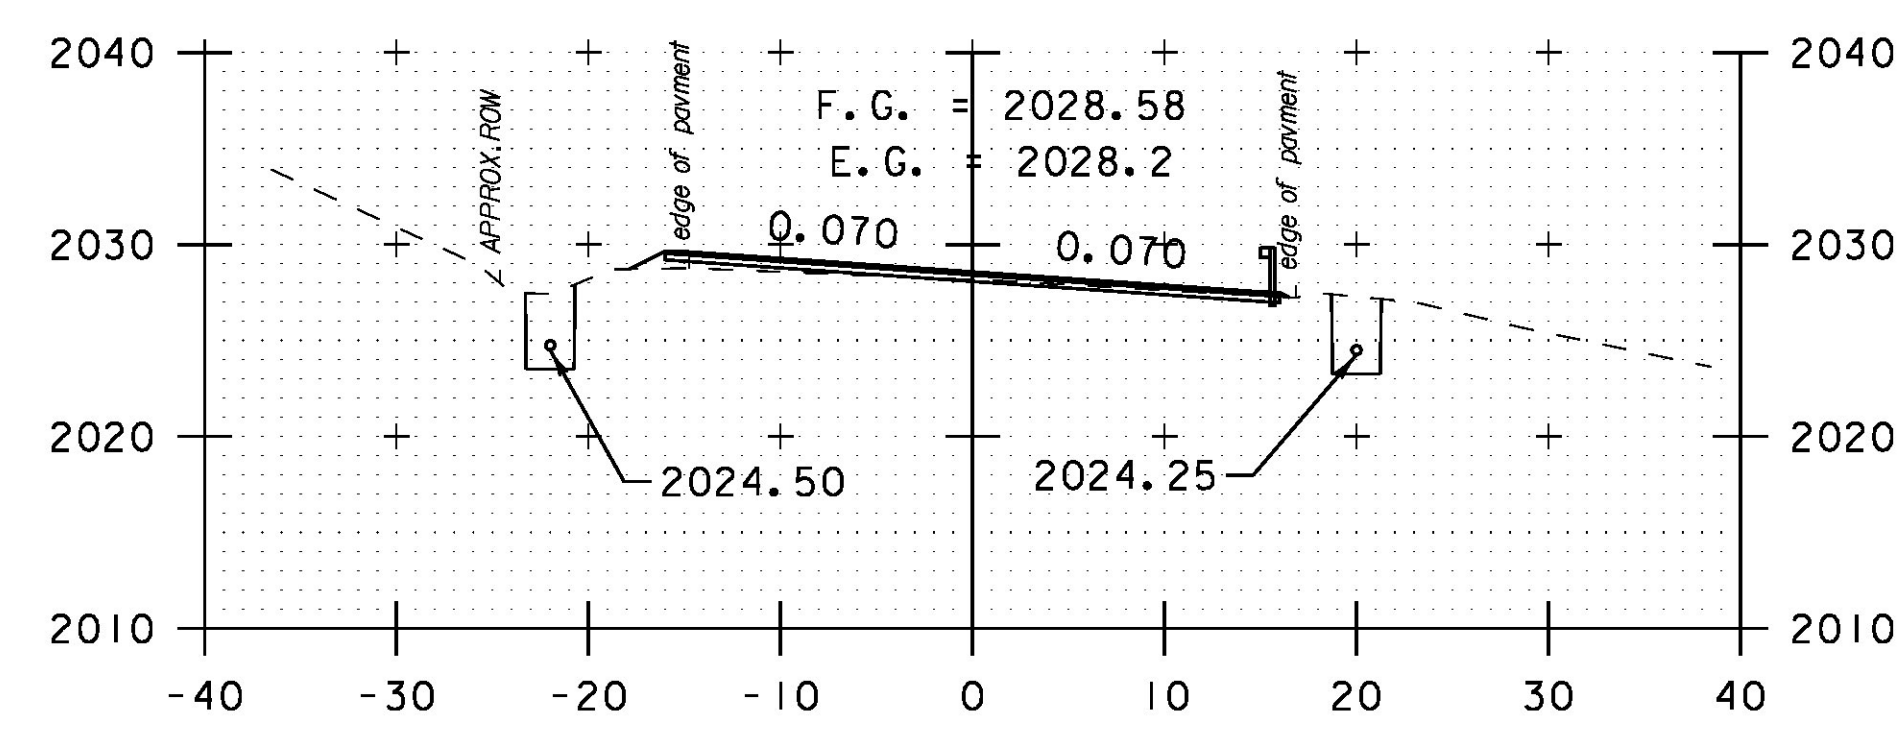

44+50

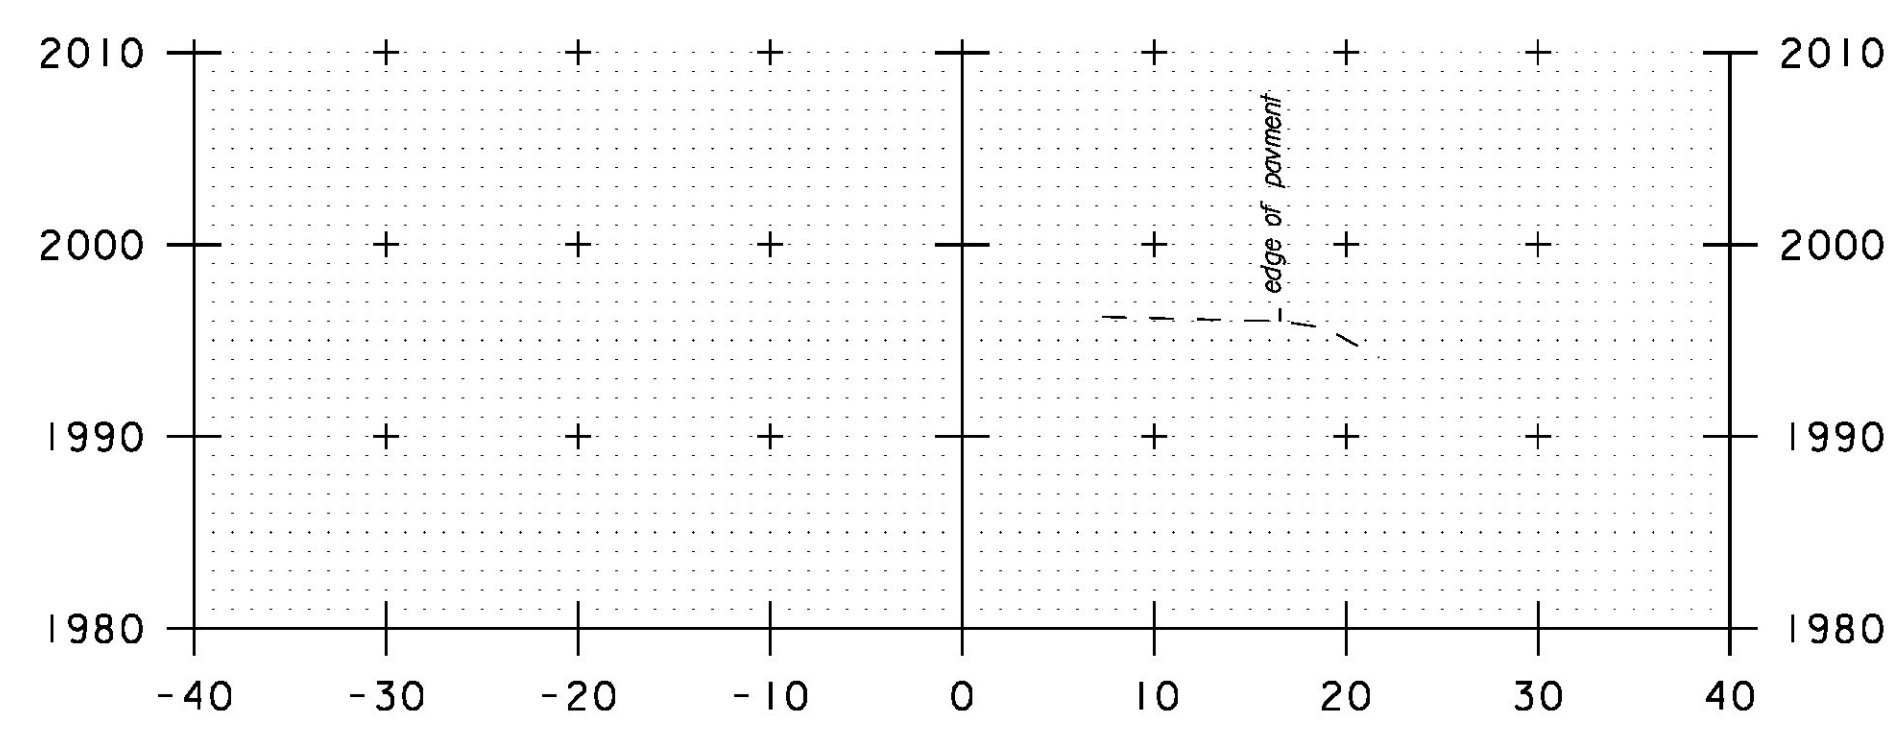


41+25

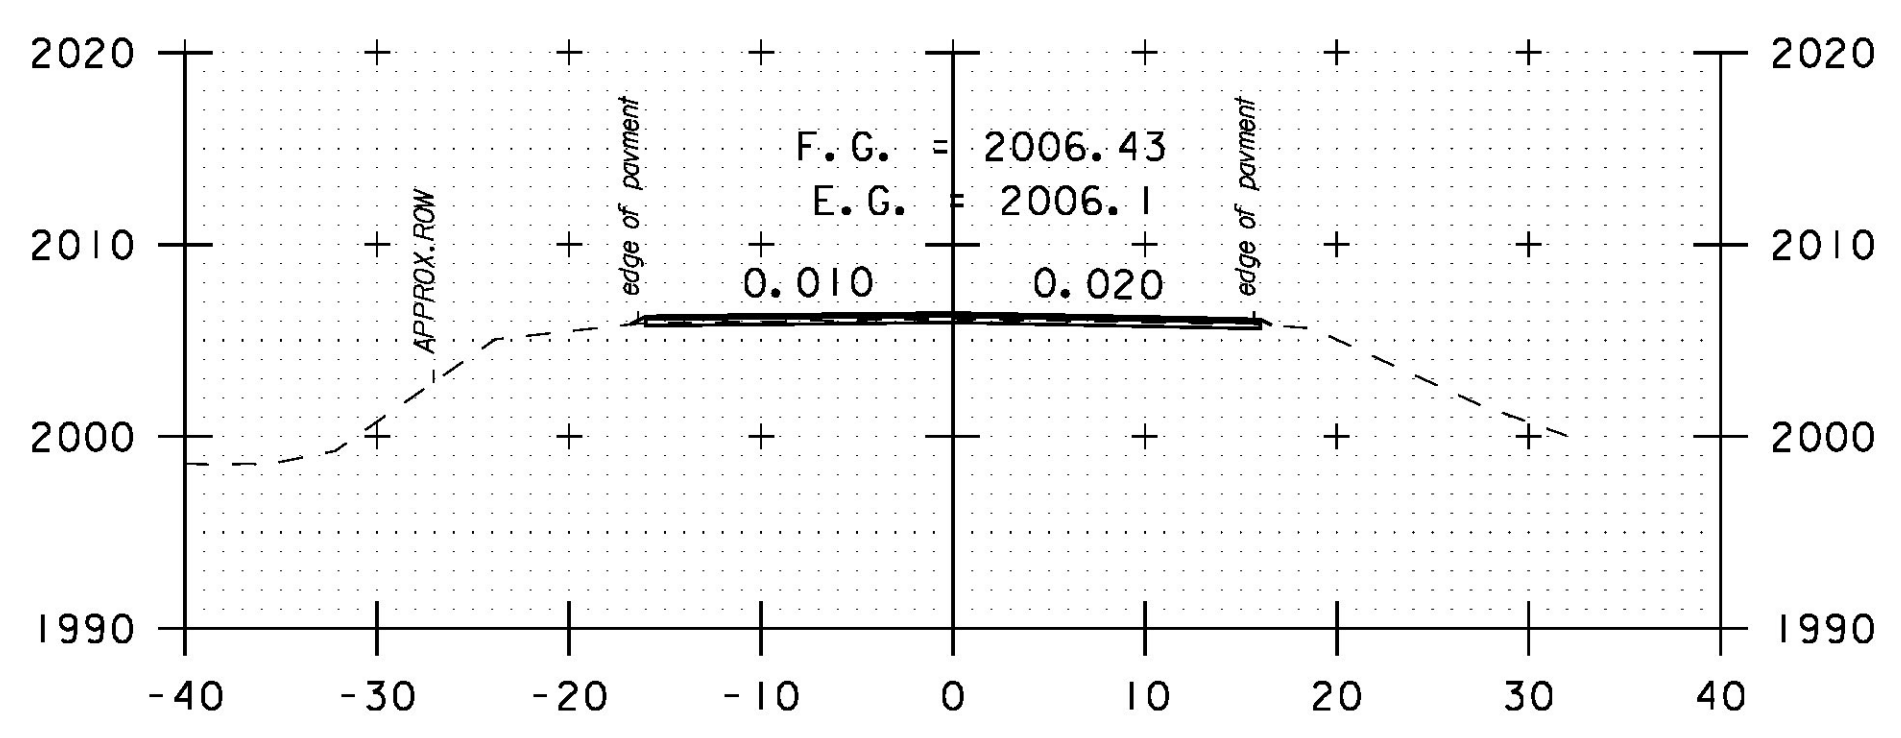

42+50

BEGIN PROJECT
STA. 40+50
MATCH EXISTING

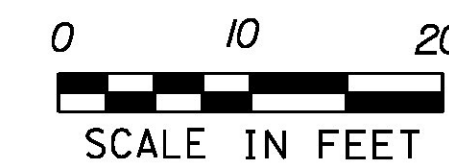

PROJECT NAME:	HANCOCK	PLOT DATE:	3/18/2015
PROJECT NUMBER:	STP 2923 (1)	DRAWN BY:	B. MARTIN
FILE NAME:	z10c252xs.dgn	CHECKED BY:	C. LATHROP
PROJECT LEADER:	C. LATHROP	CROSS SECTION SHEET:	1
DESIGNED BY:	B. MARTIN	SHEET:	128 OF 207