




50+00

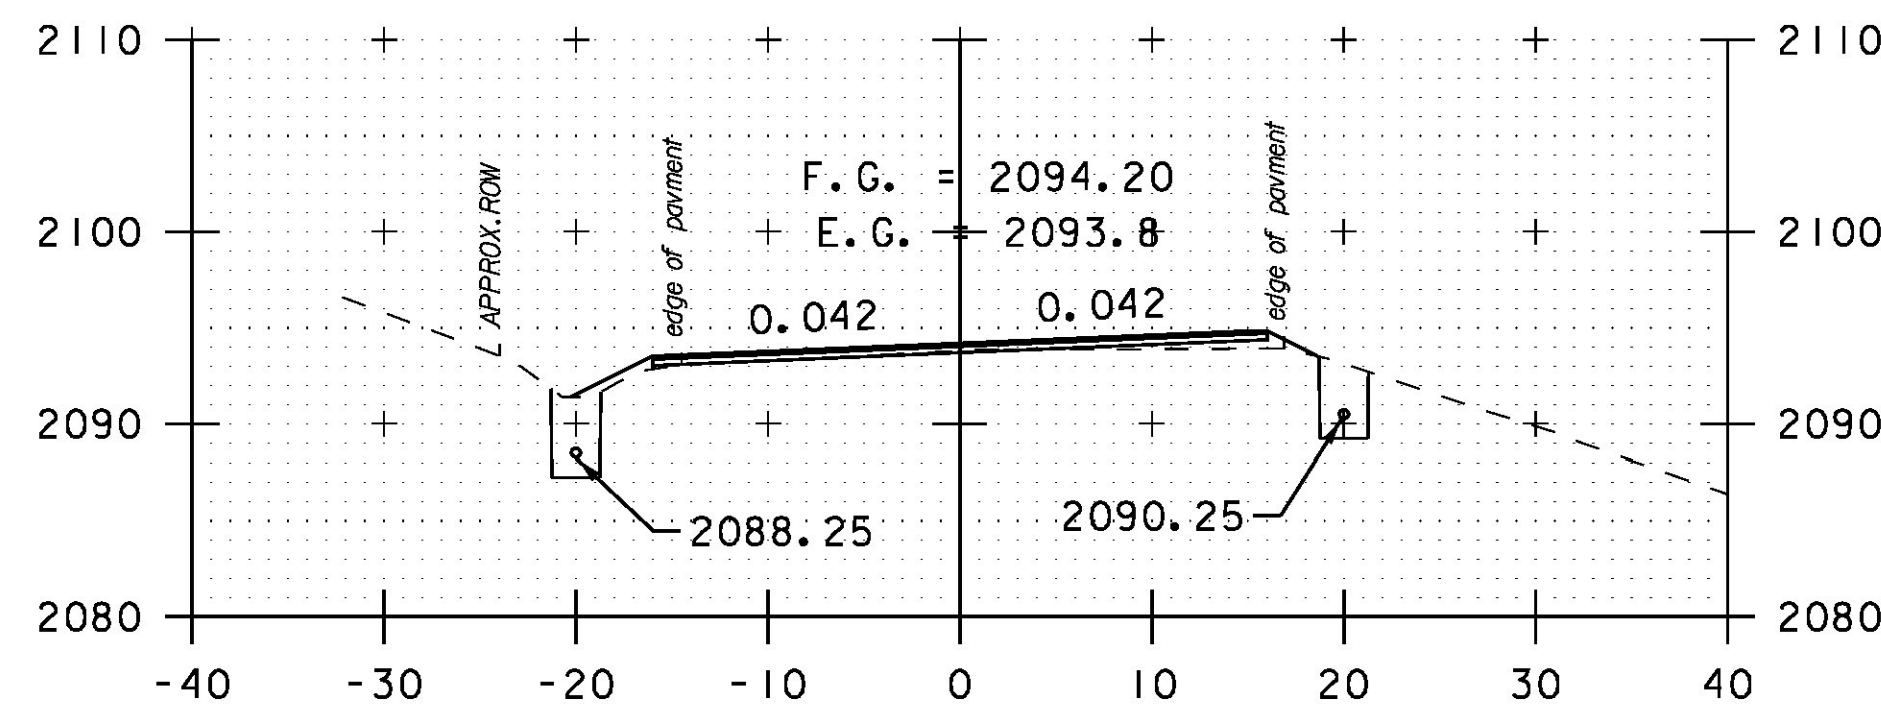


51+50

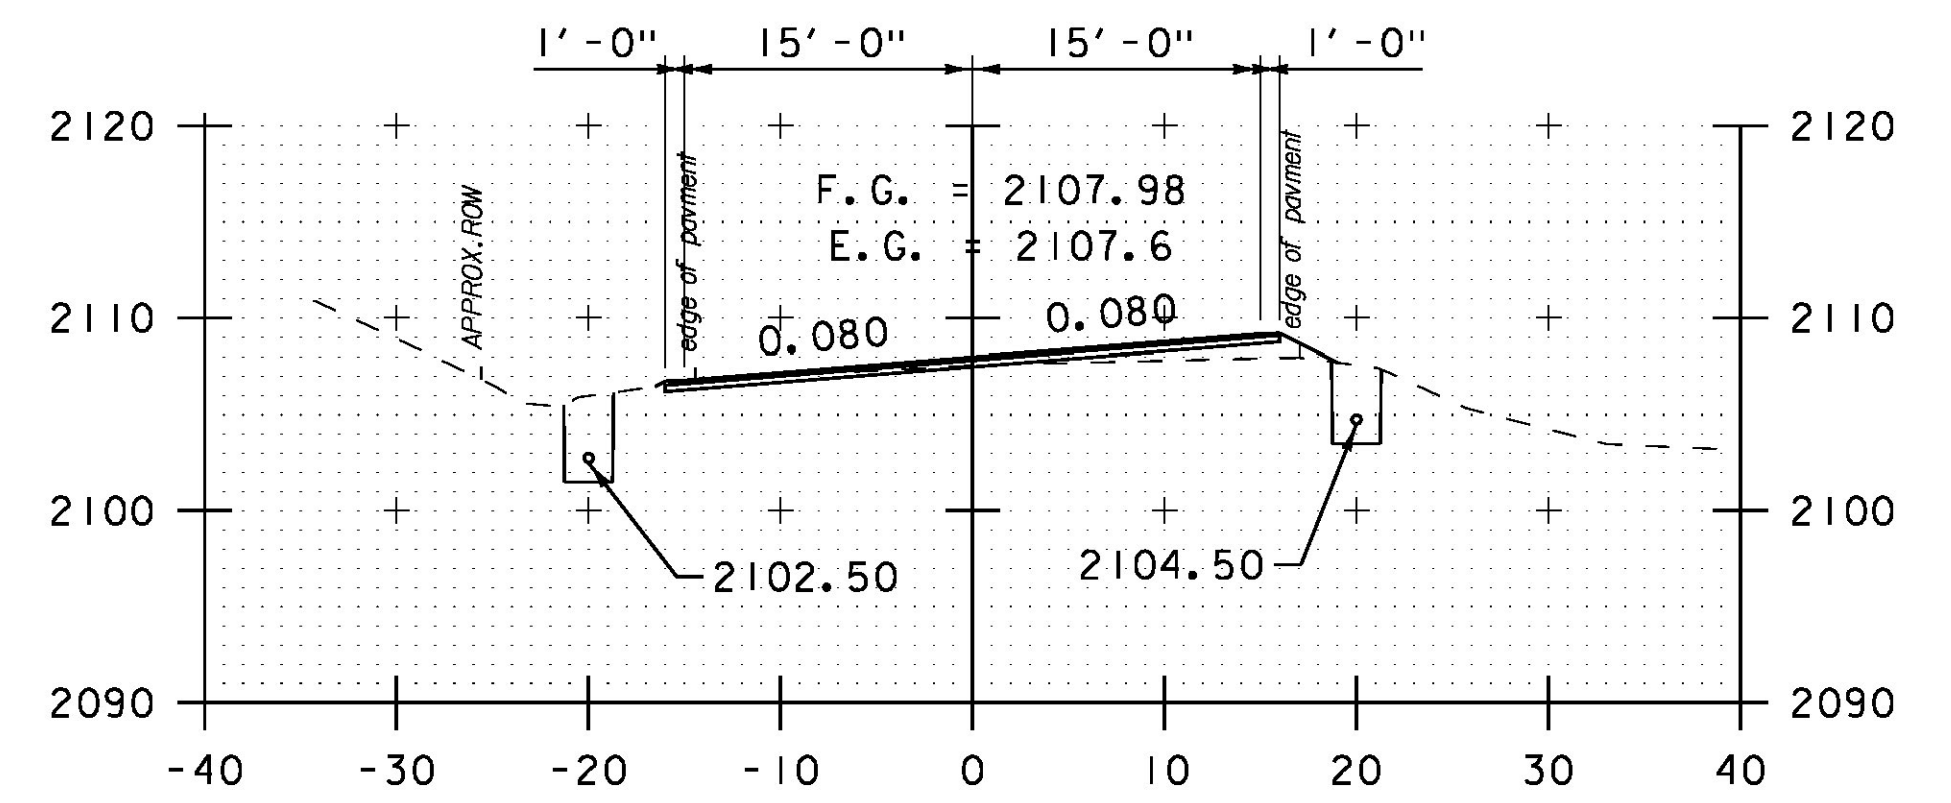


53+00

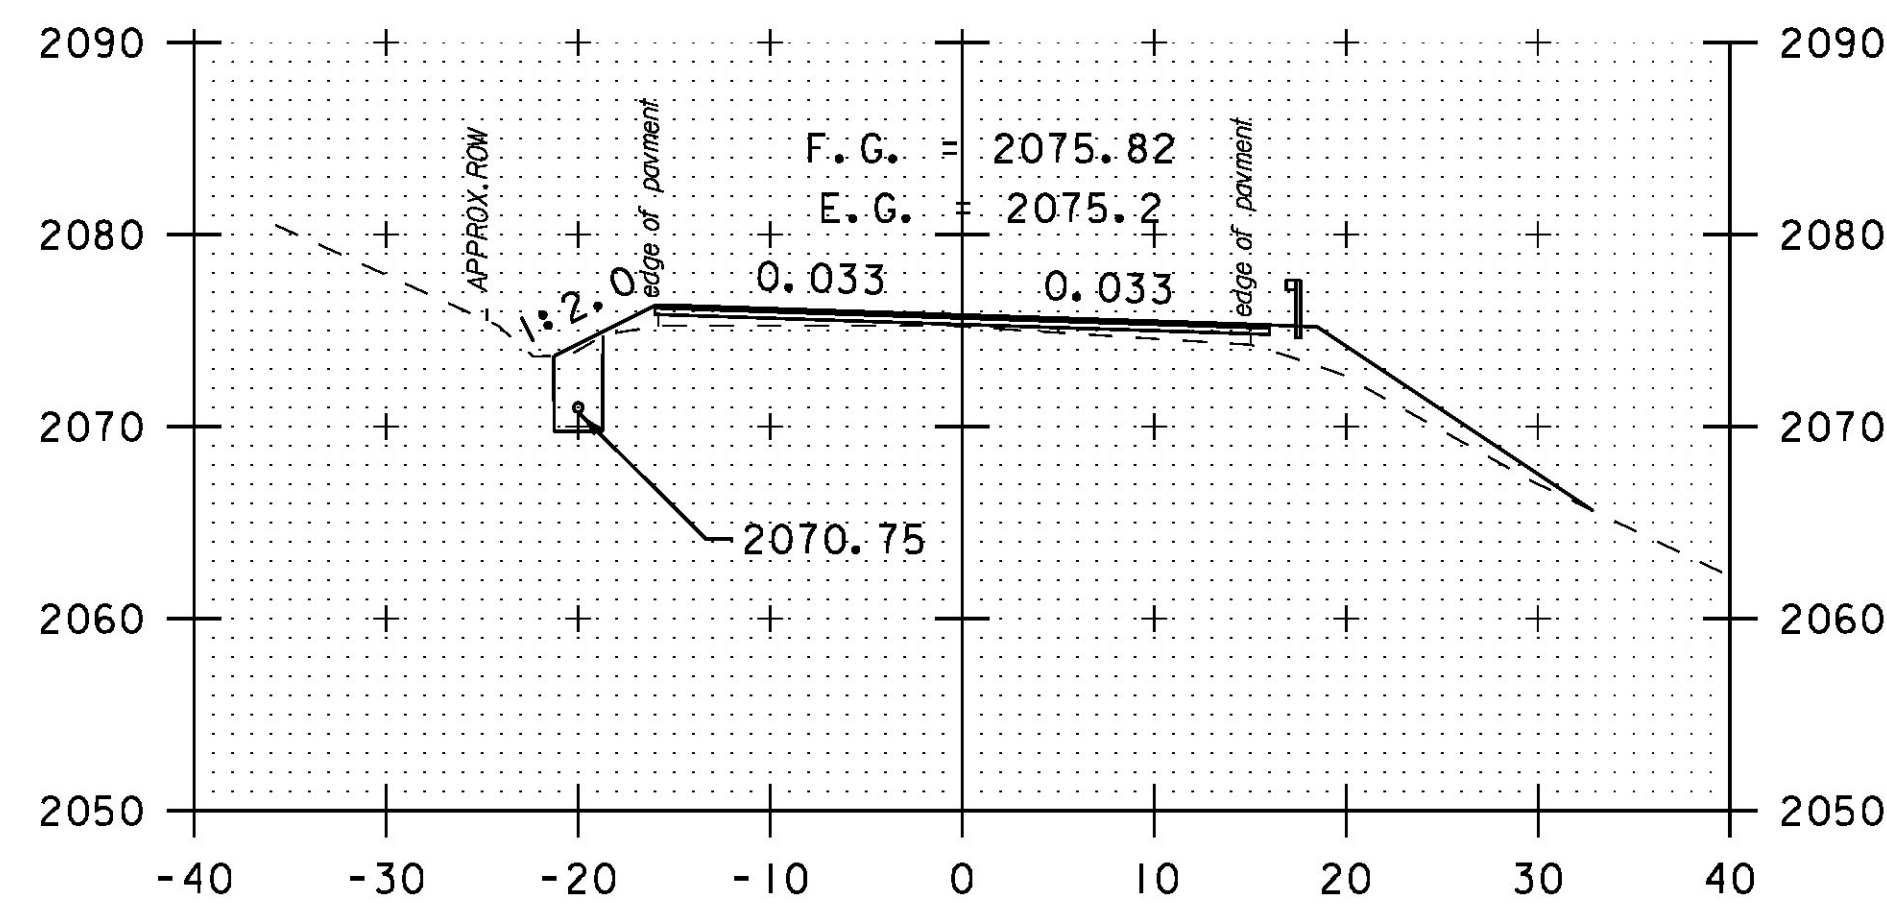


49+50

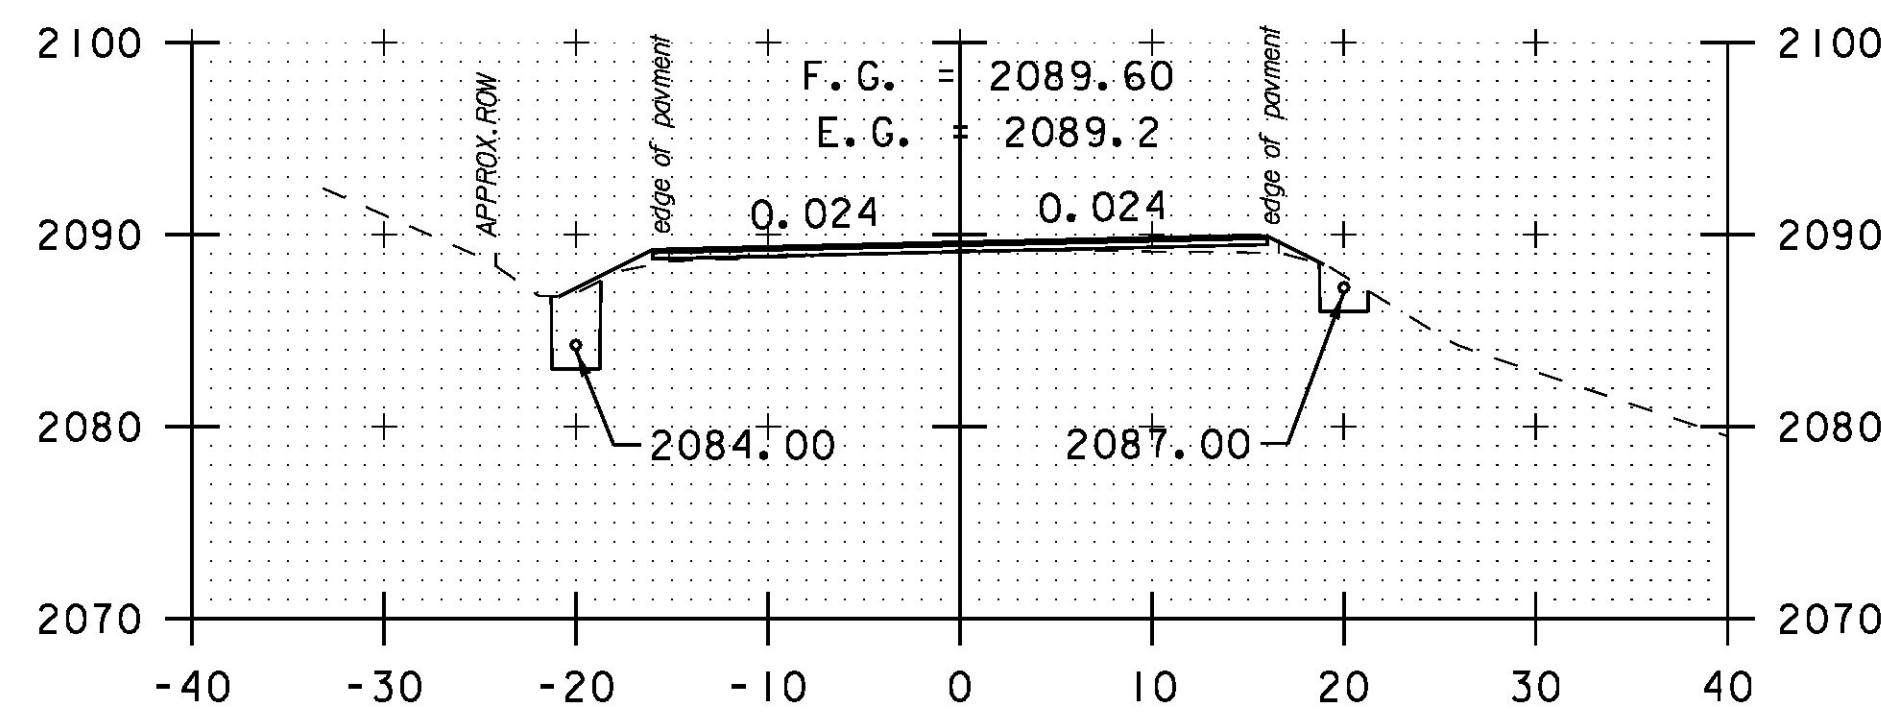


51+00

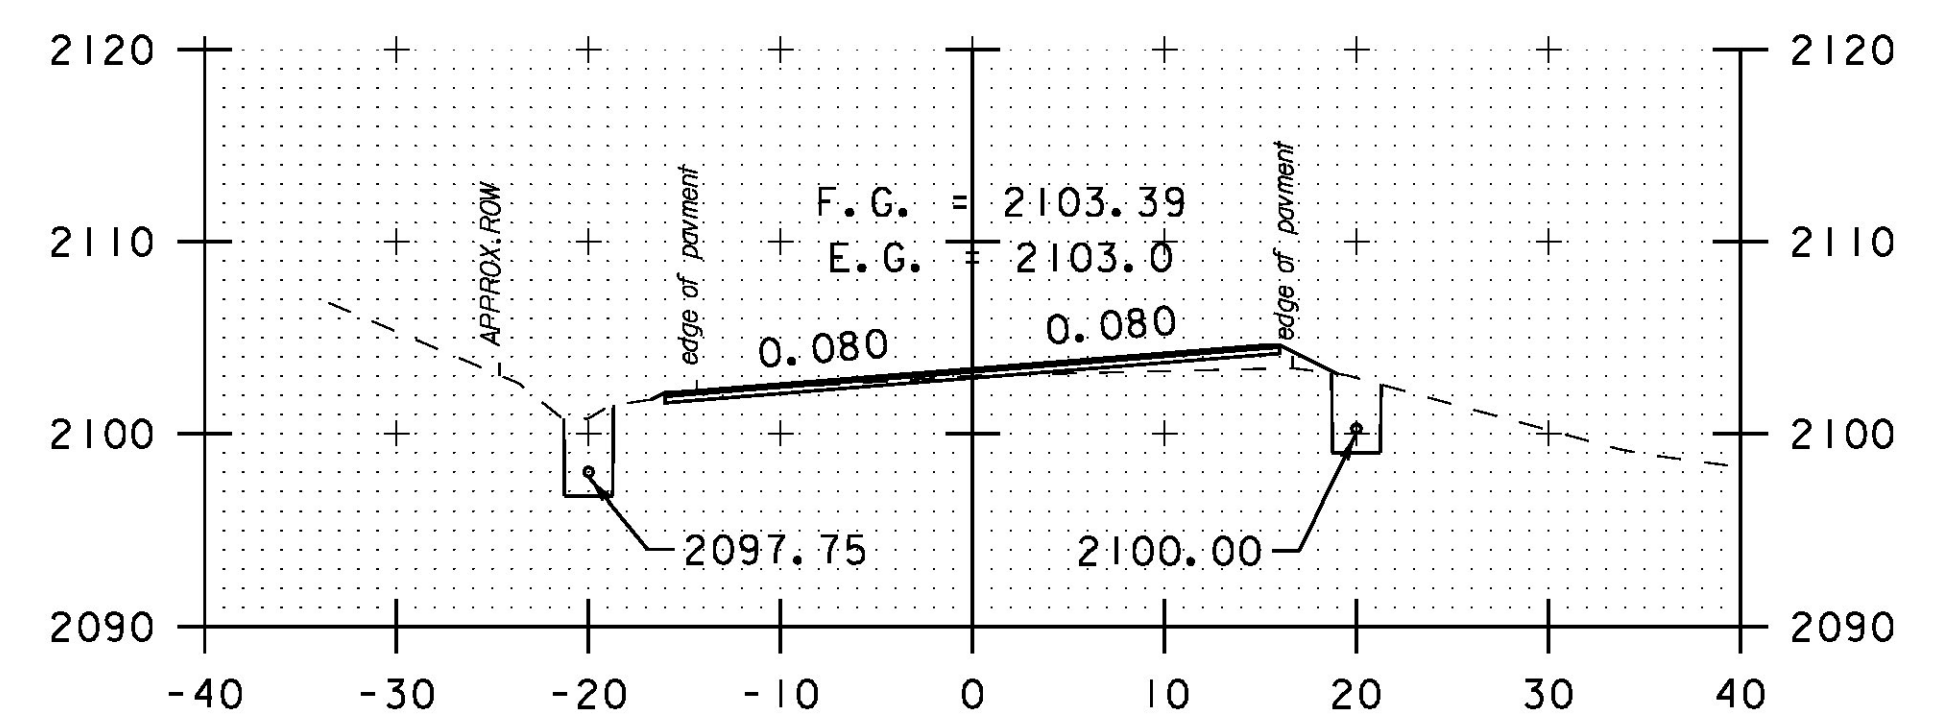


52+50

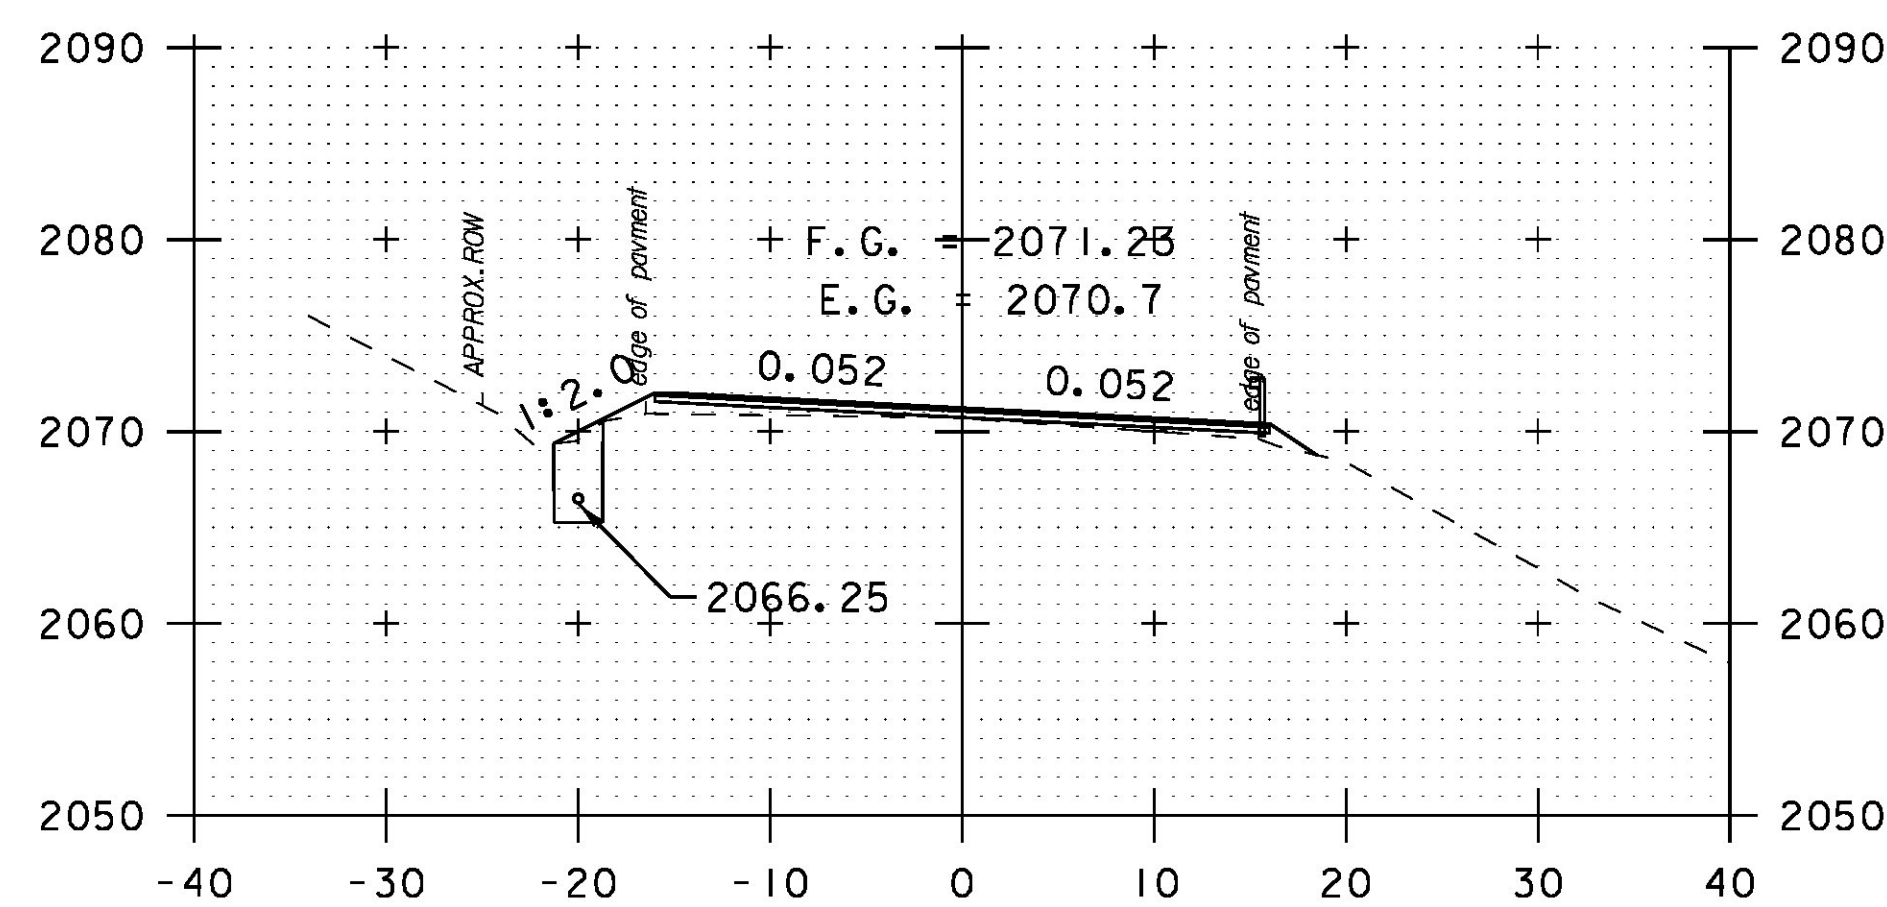

49+00

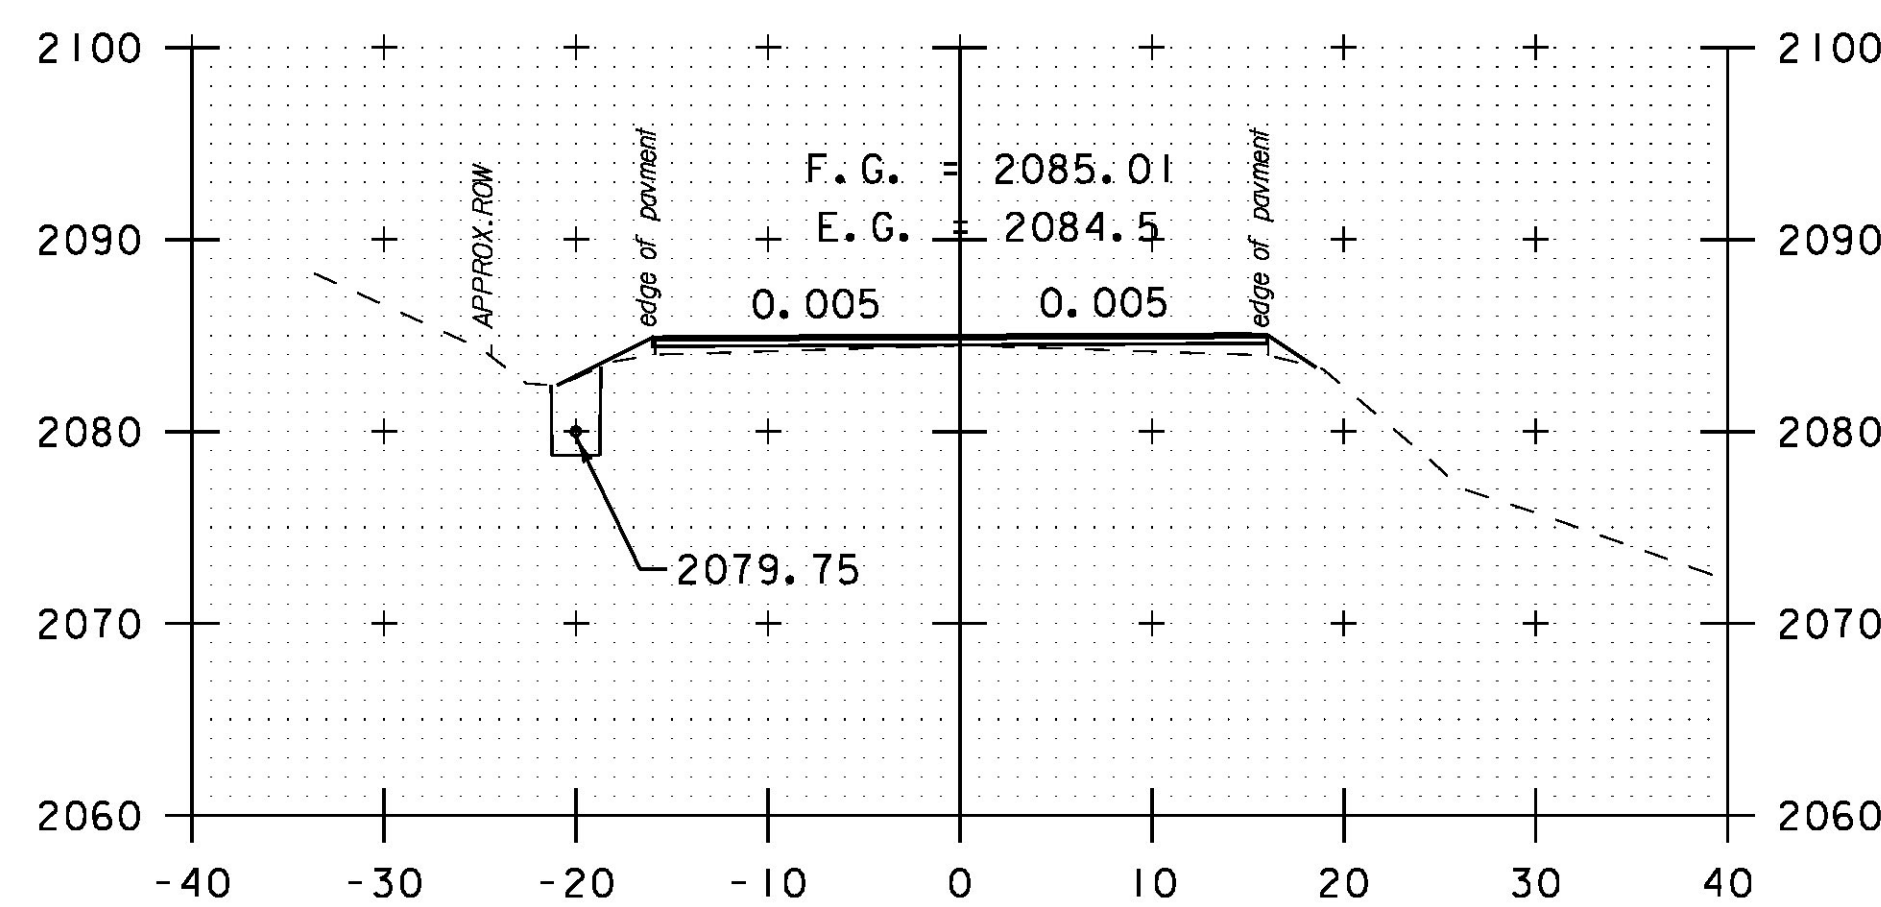

50+50

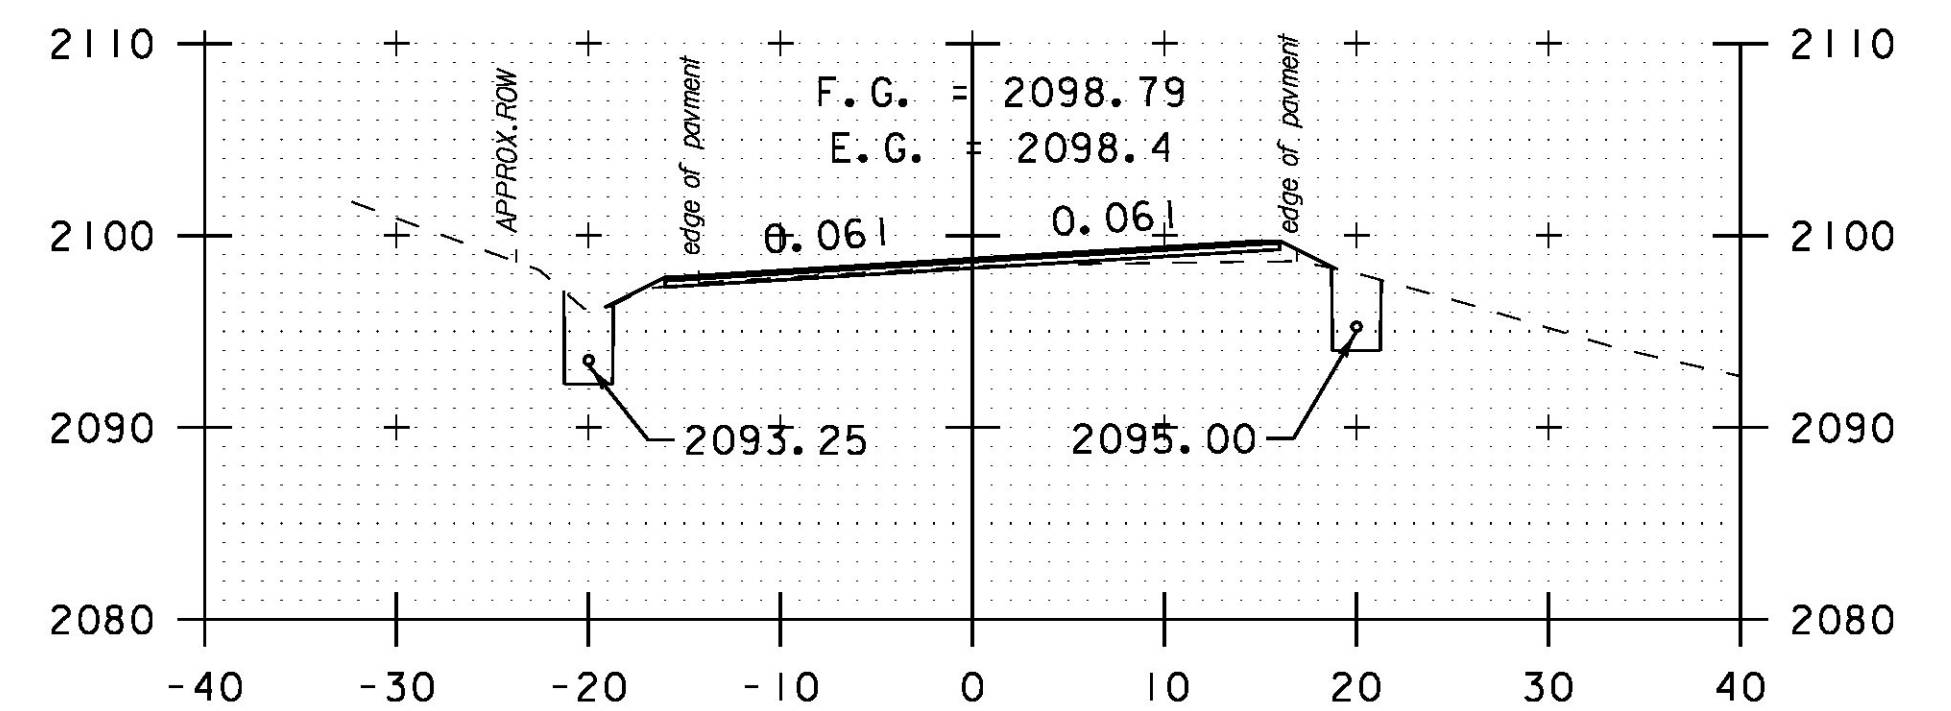

52+00



PROJECT NAME:	HANCOCK	PLOT DATE:	3/18/2015
PROJECT NUMBER:	STP 2923 (1)	DRAWN BY:	B. MARTIN
FILE NAME:	z10c252xs.dgn	CHECKED BY:	C. LATHROP
PROJECT LEADER:	C. LATHROP	CROSS SECTION SHEET	3
DESIGNED BY:	B. MARTIN	SHEET	130 OF 207