




54+50

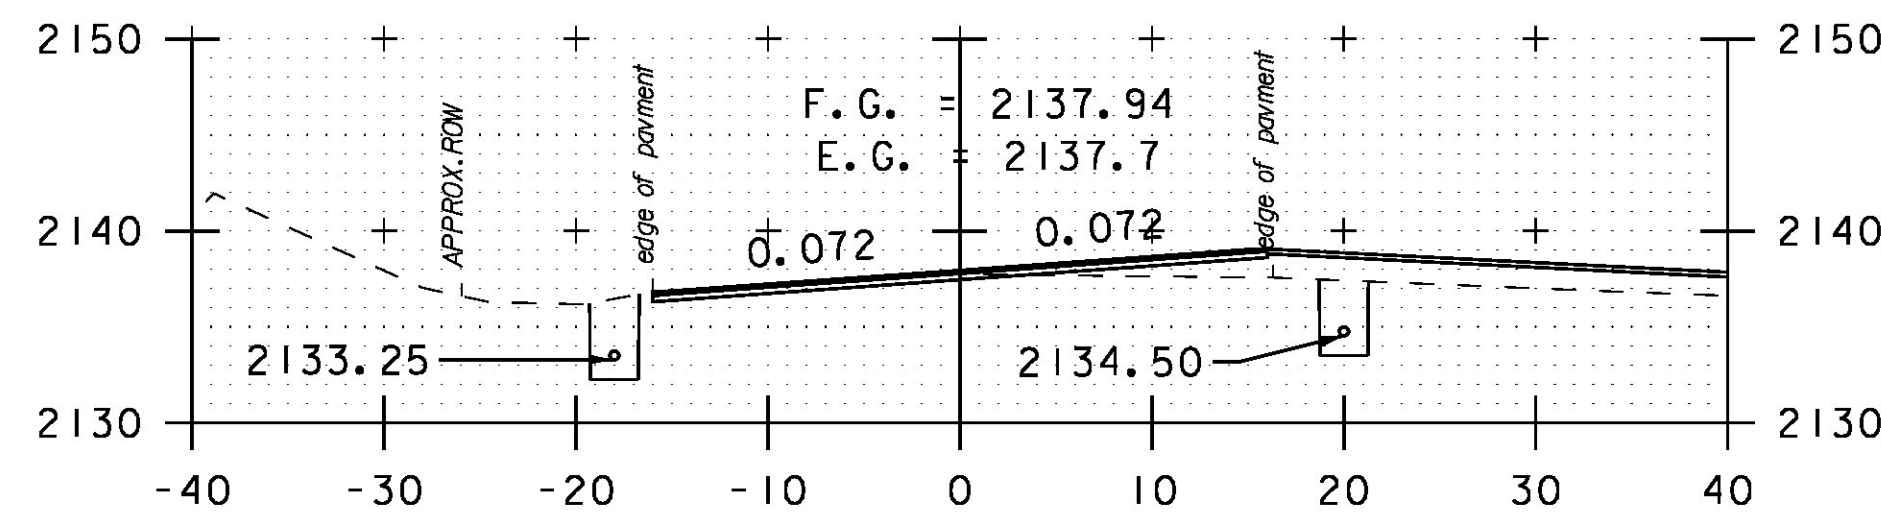


56+50
PULL OFF RT

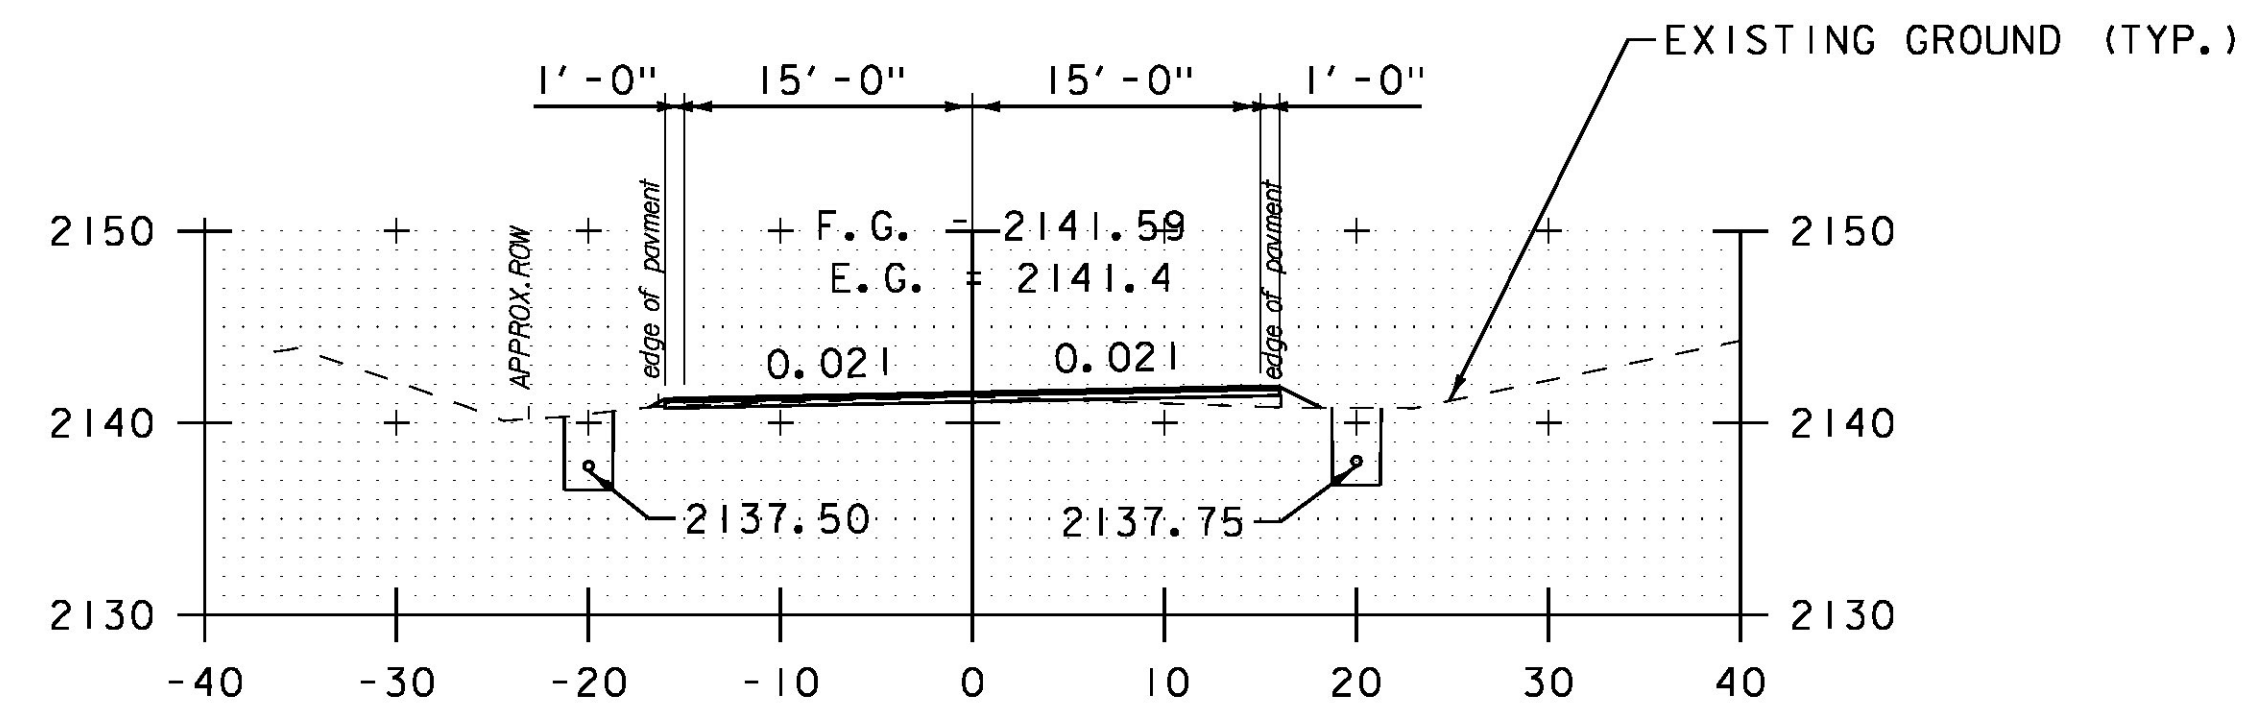


58+50

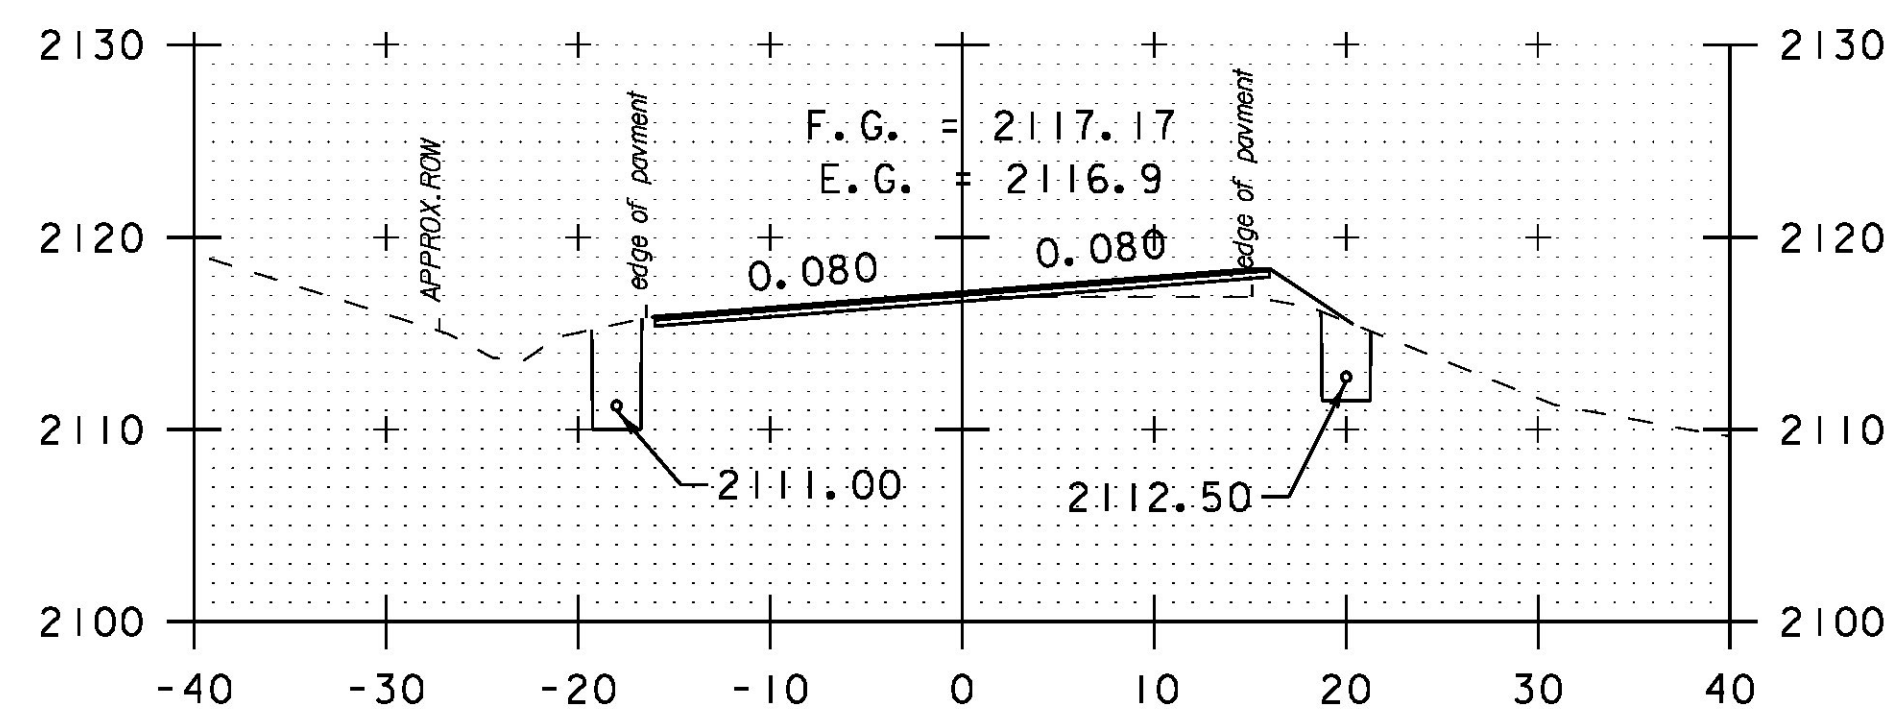


54+00

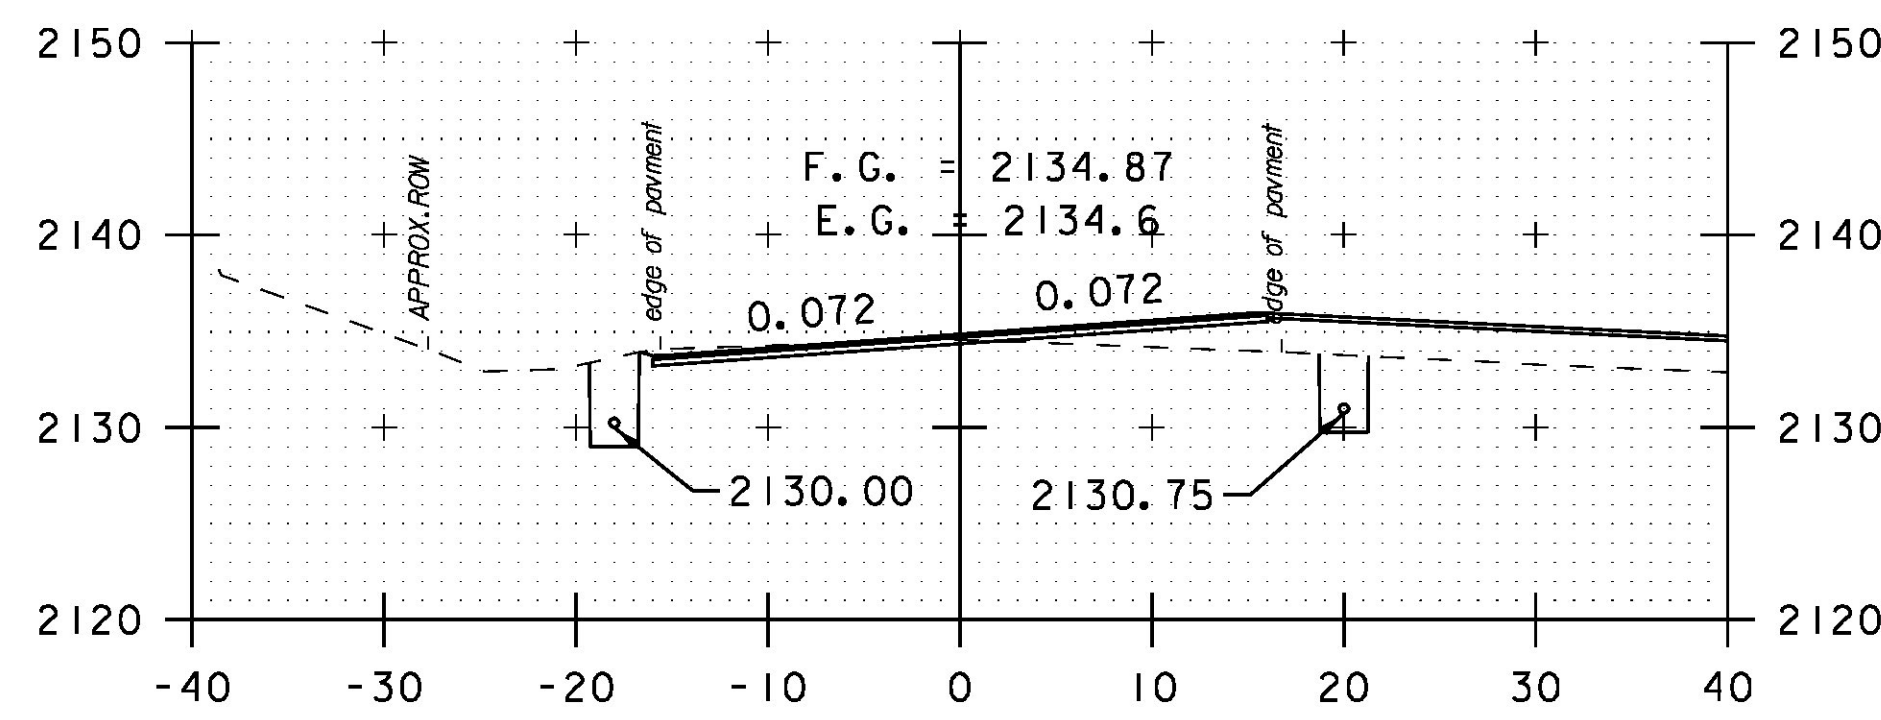


56+00
PULL OFF RT

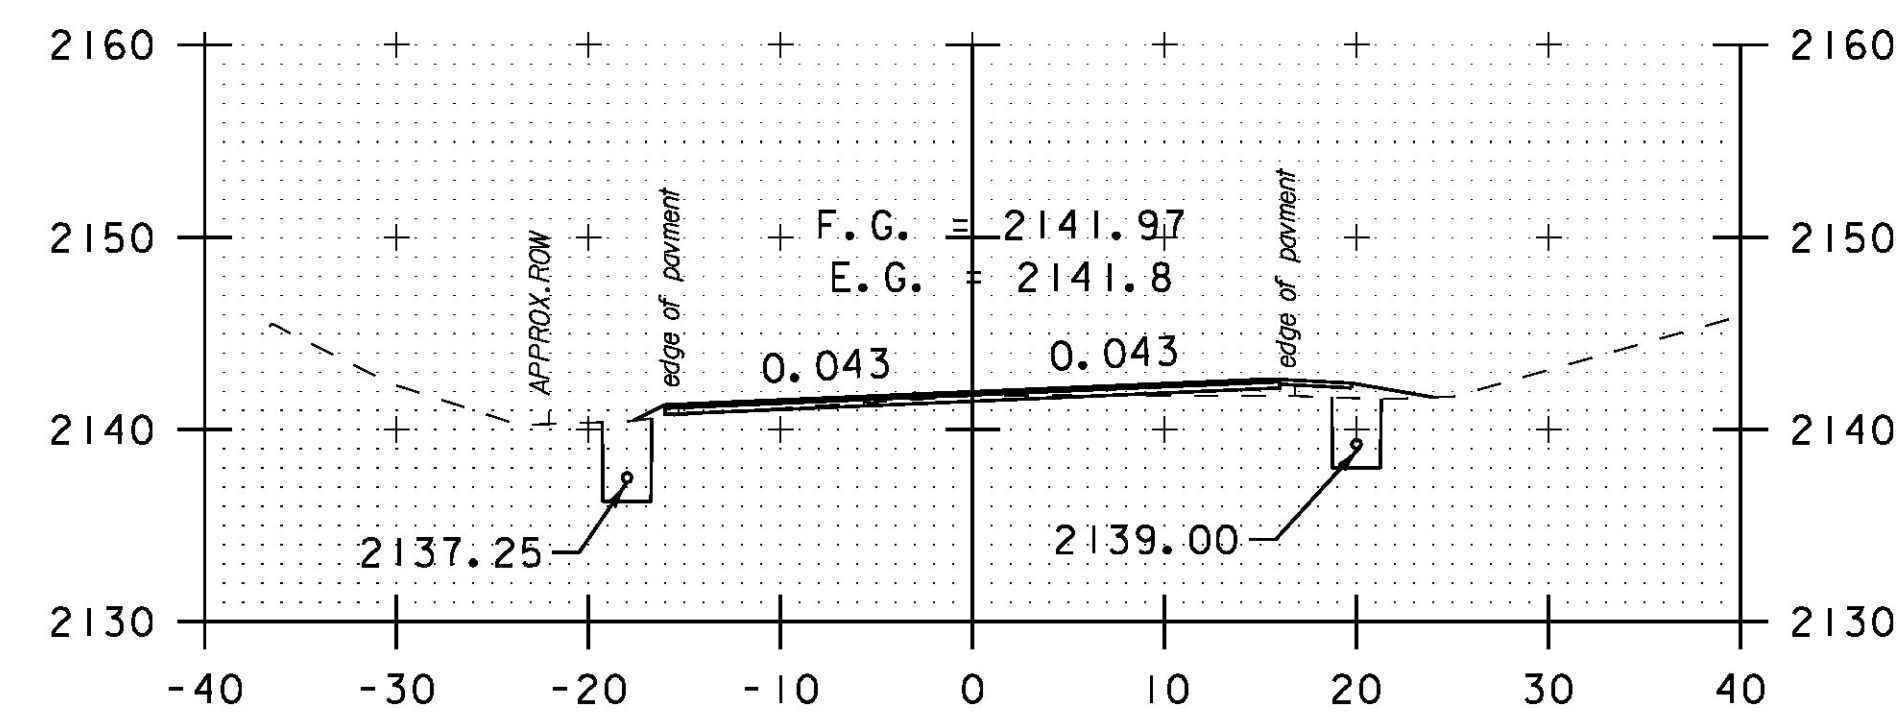


58+00
PULL OFF RT

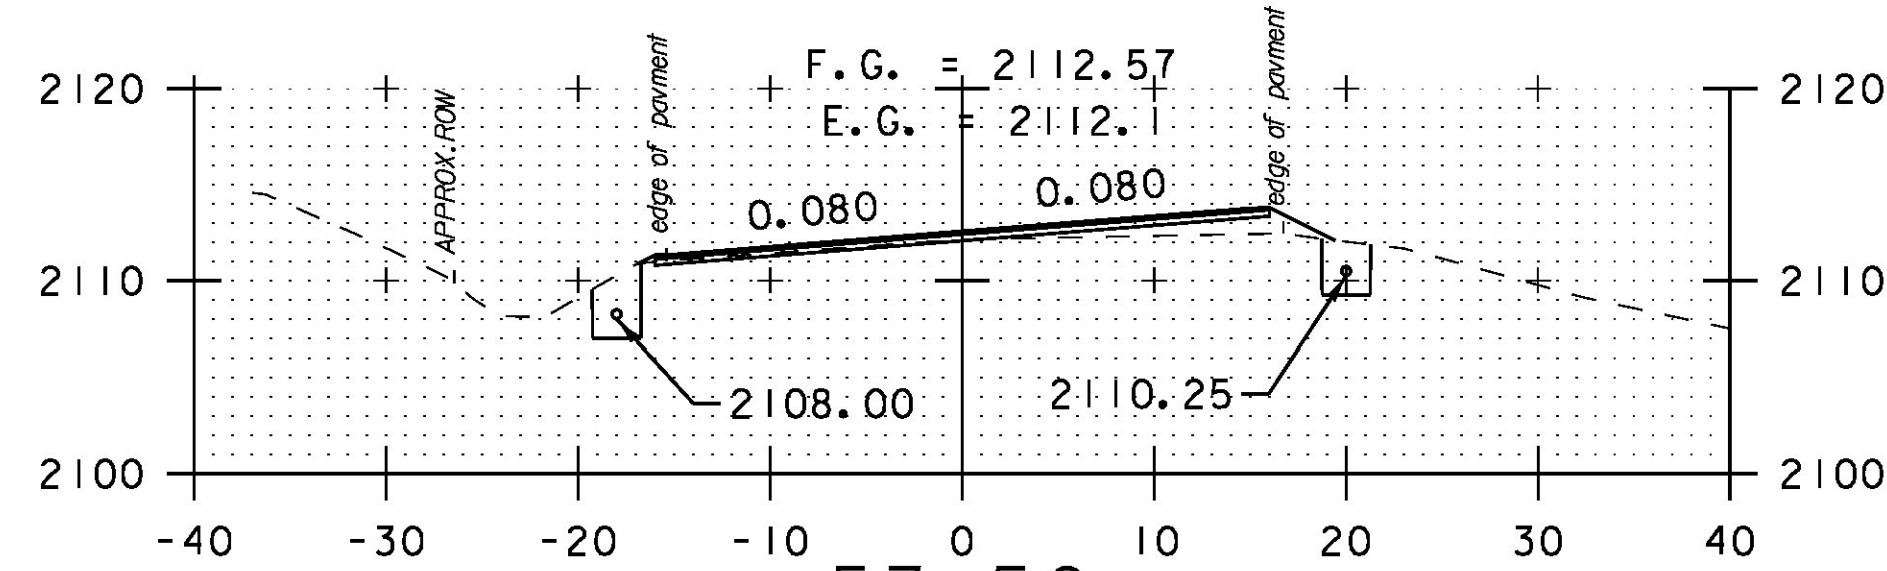


53+50
WOODS DRIVE RT

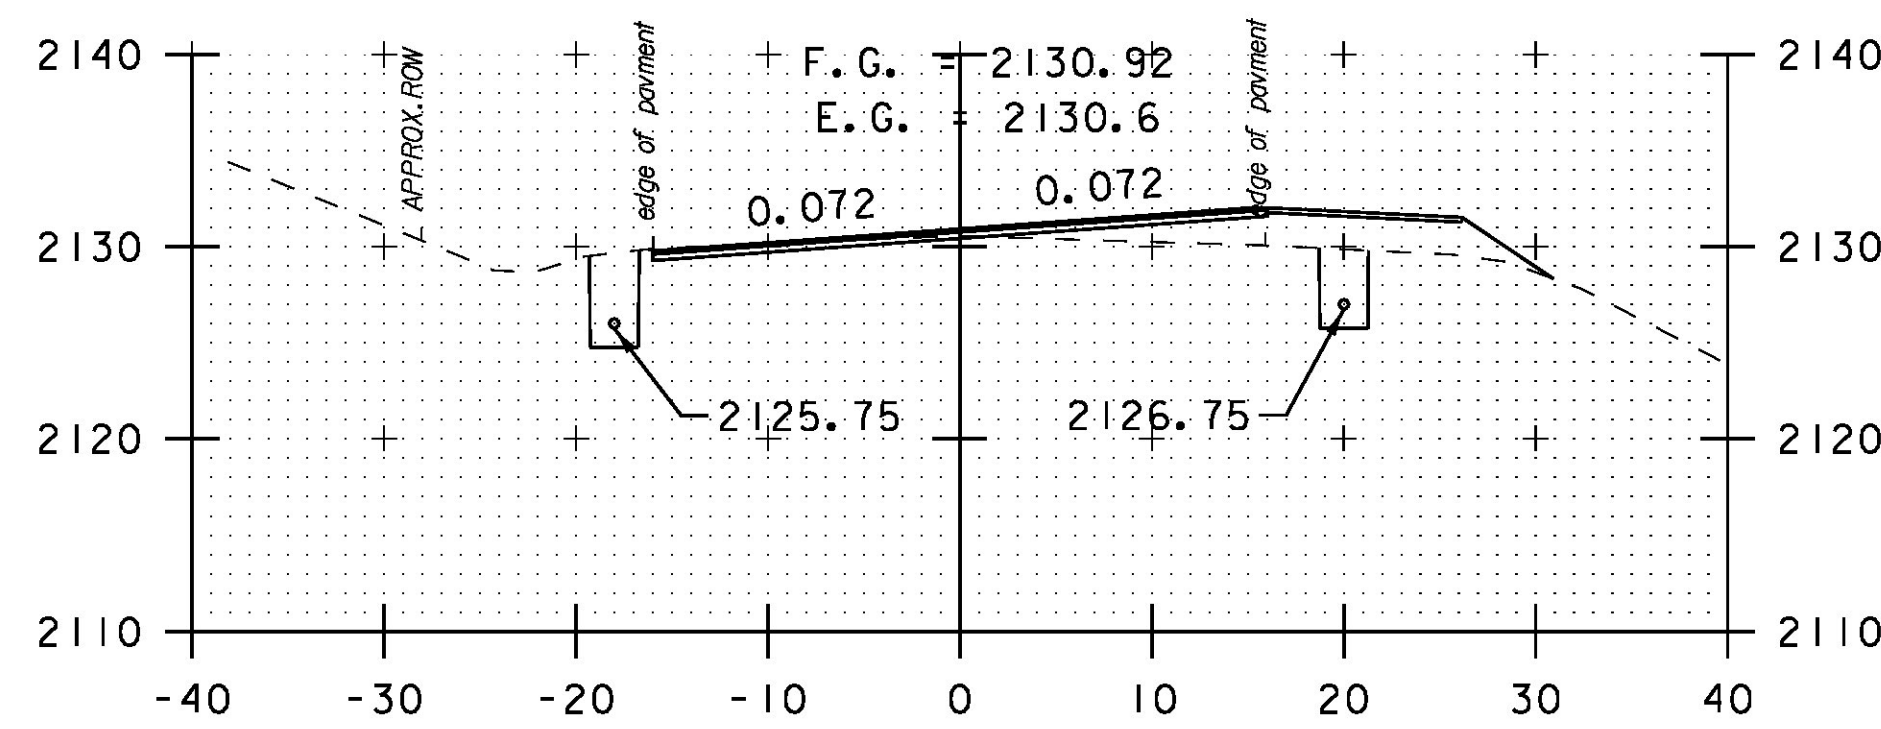


55+50
PULL OFF RT

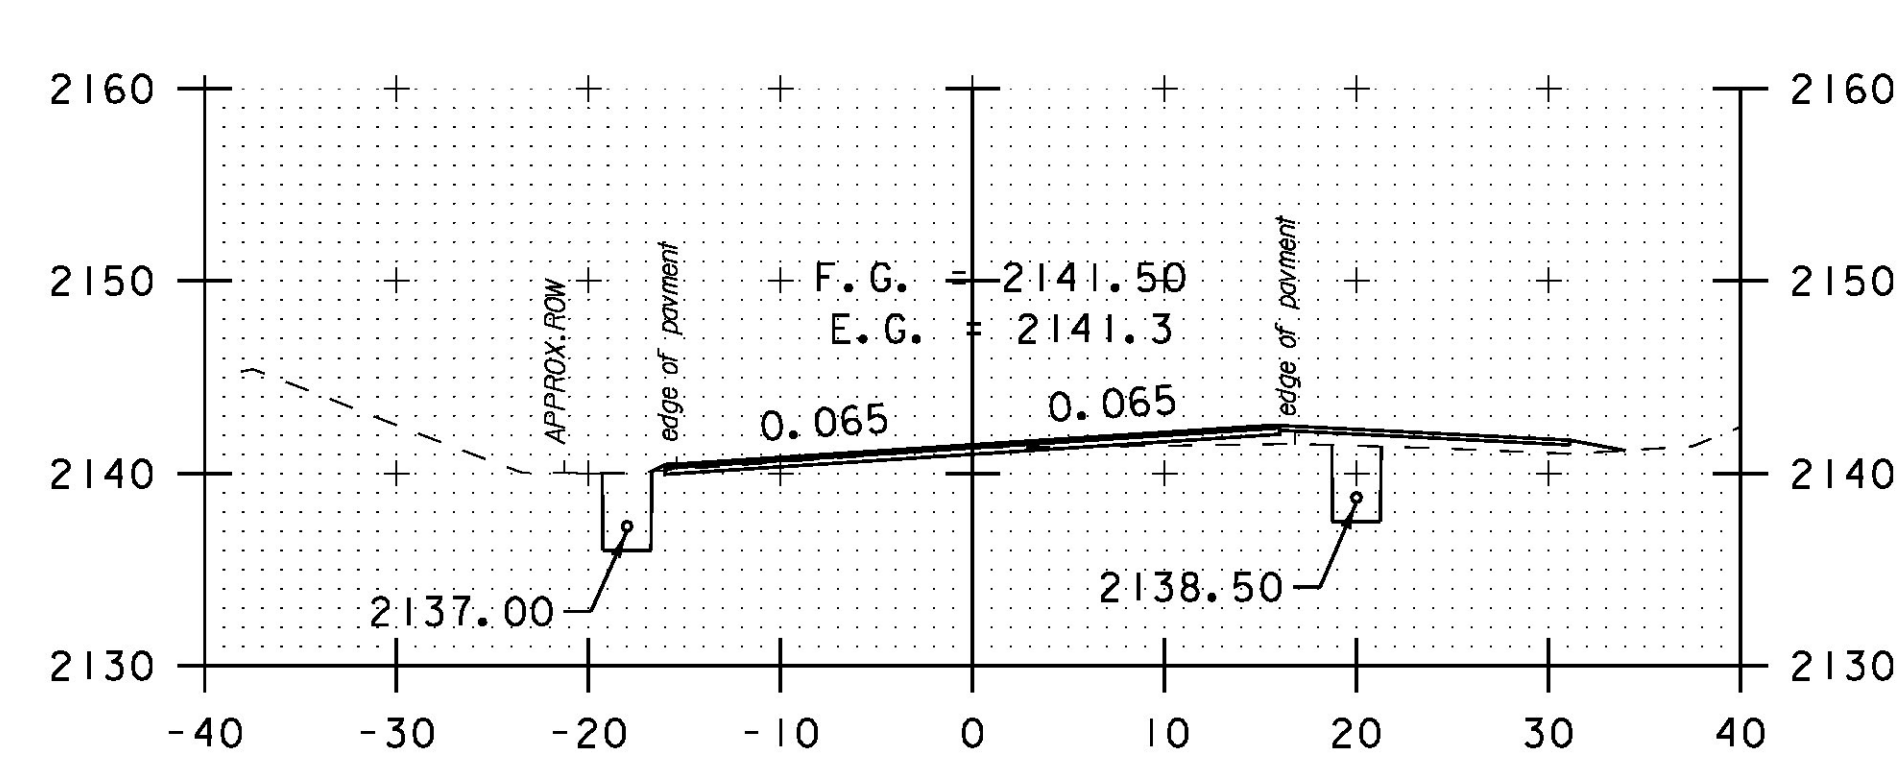


57+50
PULL OFF RT

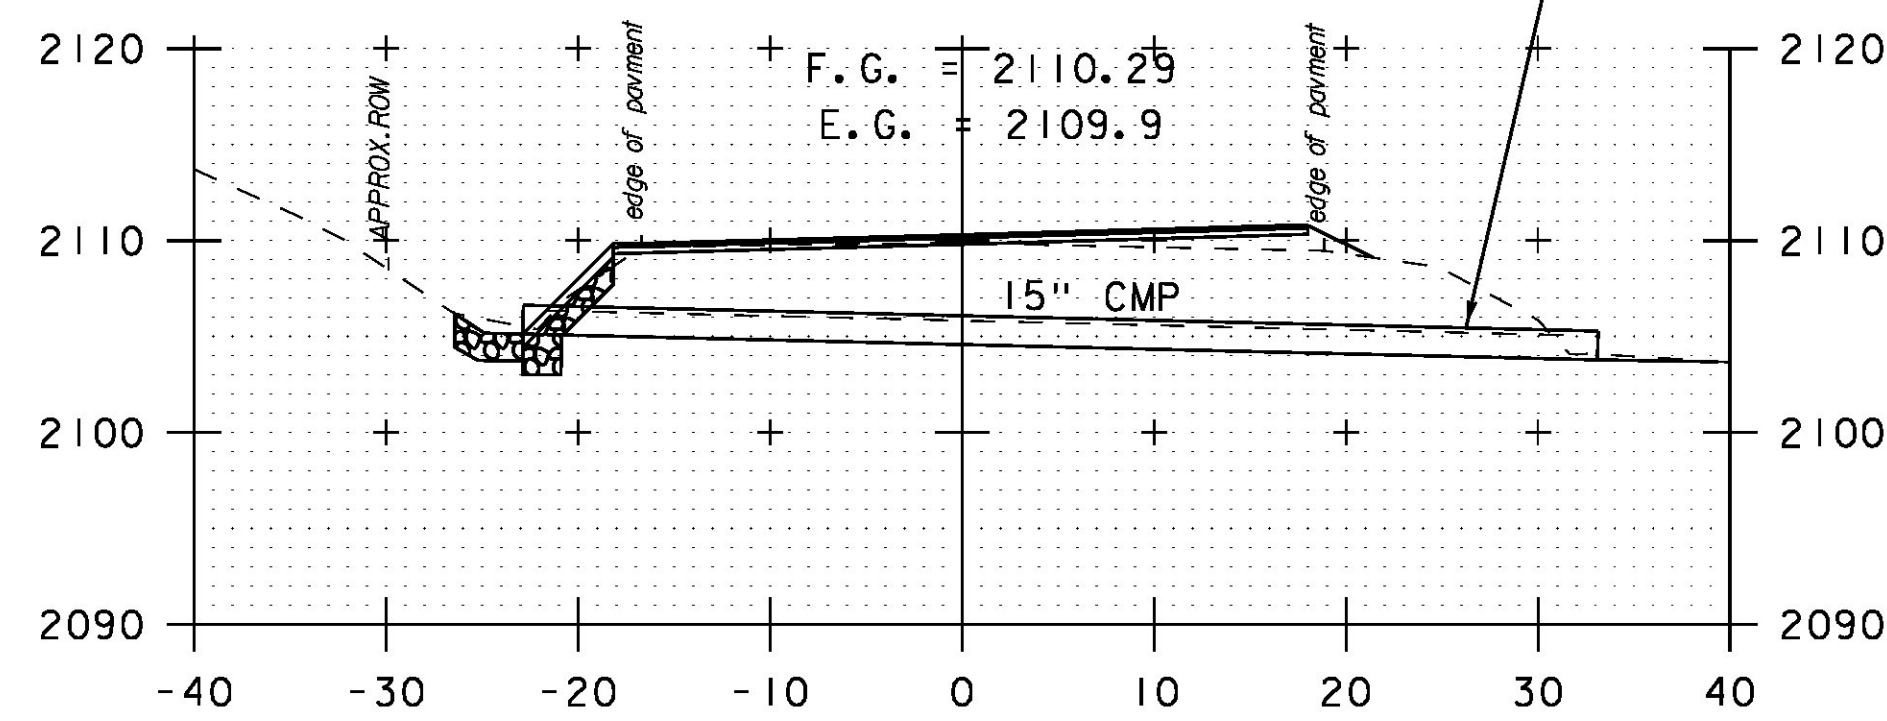

53+25
SKEWED

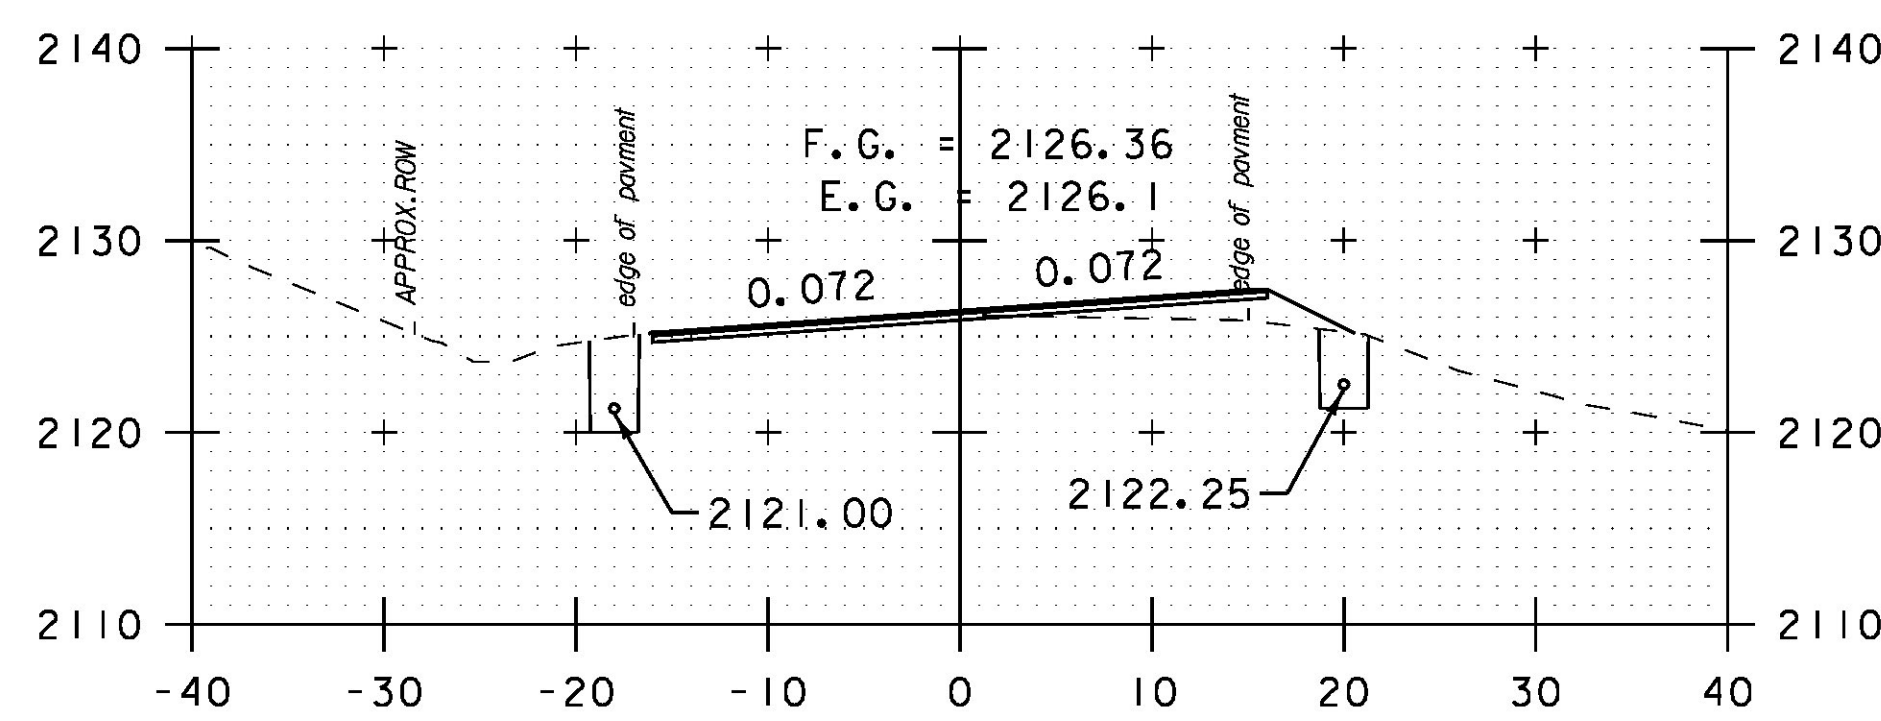

55+00

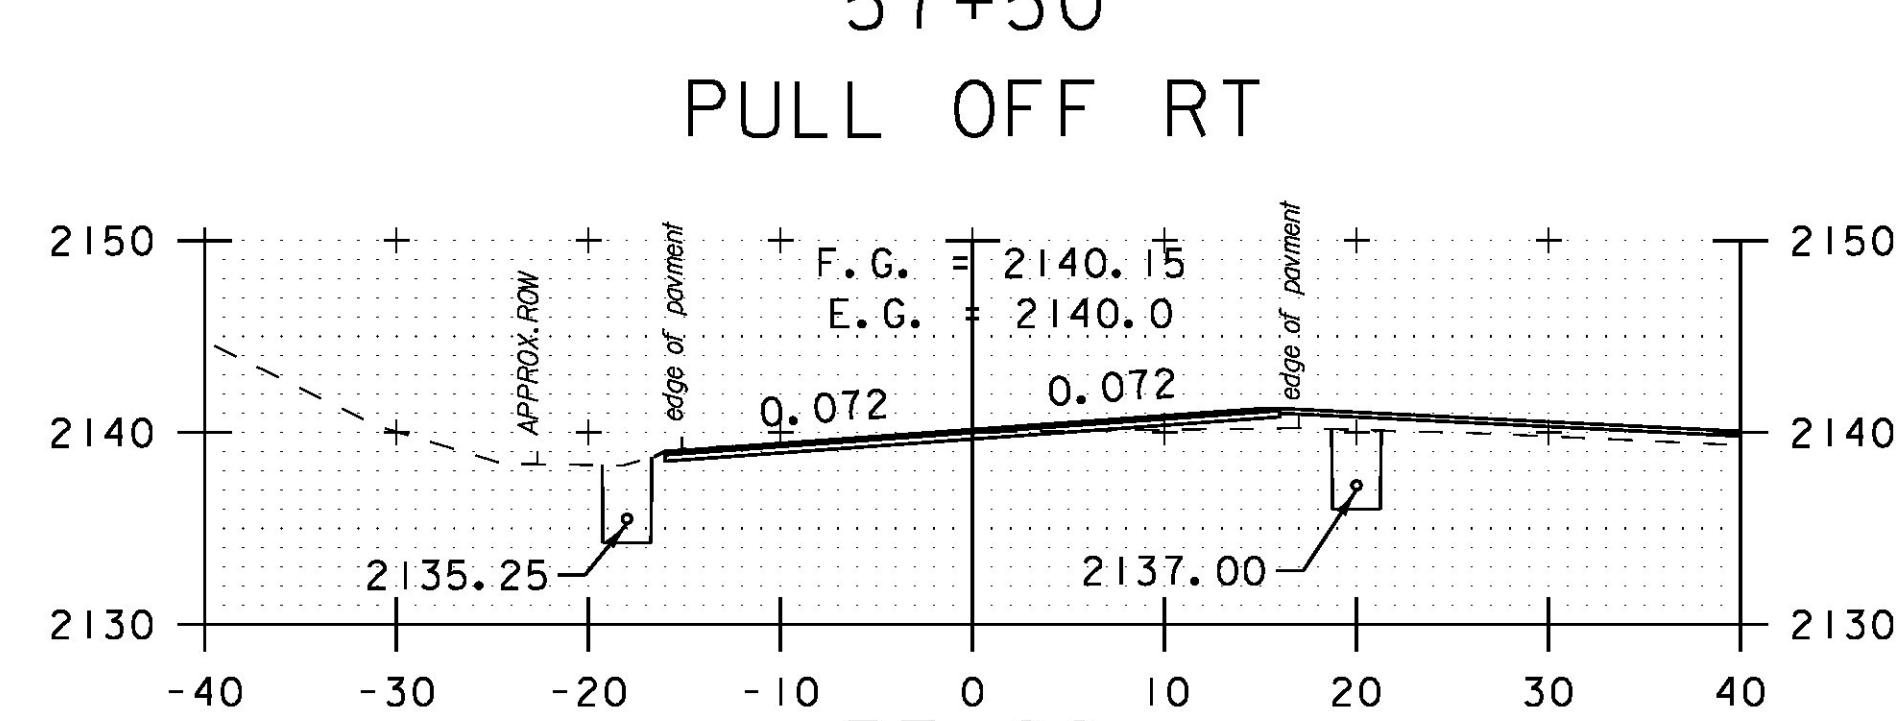


57+00
PULL OFF RT

2

2

STA. 53+10.36 RT 29.47' TO
STA. 53+36.16 LT 20.13'
ASKEW ANGLE = 62.0794° LT
REMOVE EXISTING PIPE
INSTALL 18" CPEP (56'-0")
STONE ON CUT SLOPE LT
INV. IN = 2105.13'
INV. OUT = 2103.78'

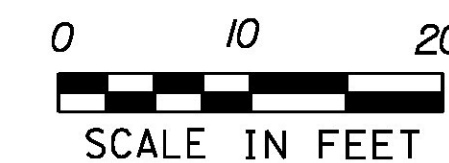

PROJECT NAME: HANCOCK
PROJECT NUMBER: STP 2923 (1)

FILE NAME: z10c252xs.dgn
PROJECT LEADER: C. LATHROP
DESIGNED BY: B. MARTIN
CROSS SECTION SHEET 4

PLOT DATE: 3/18/2015
DRAWN BY: B. MARTIN
CHECKED BY: C. LATHROP
SHEET 131 OF 207