




60+50

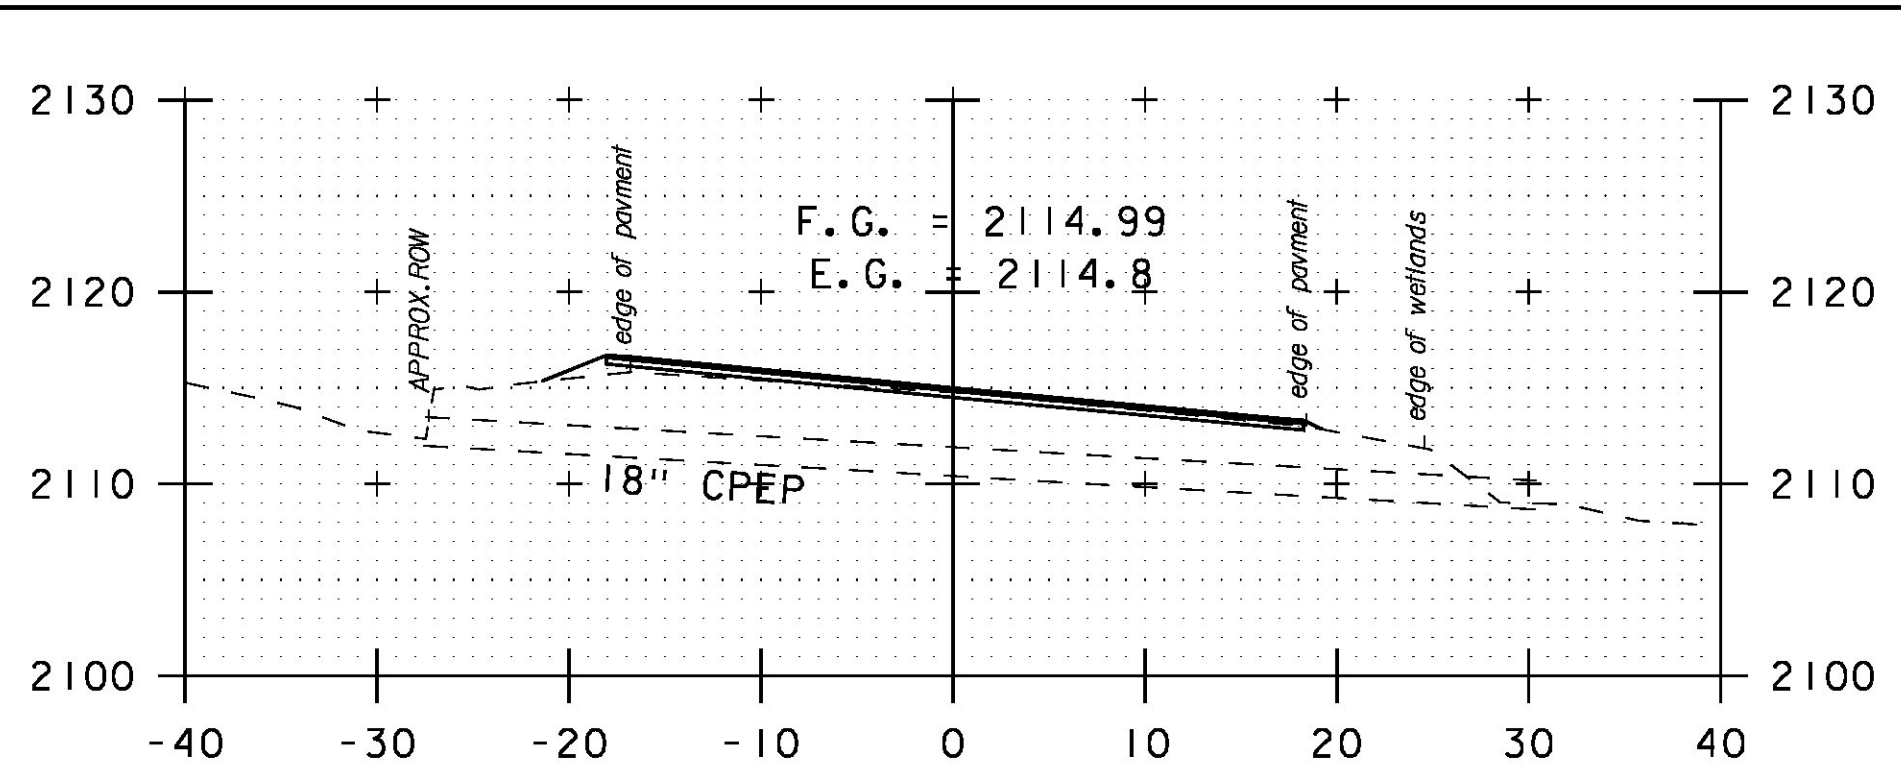


62+46  
SKEWED

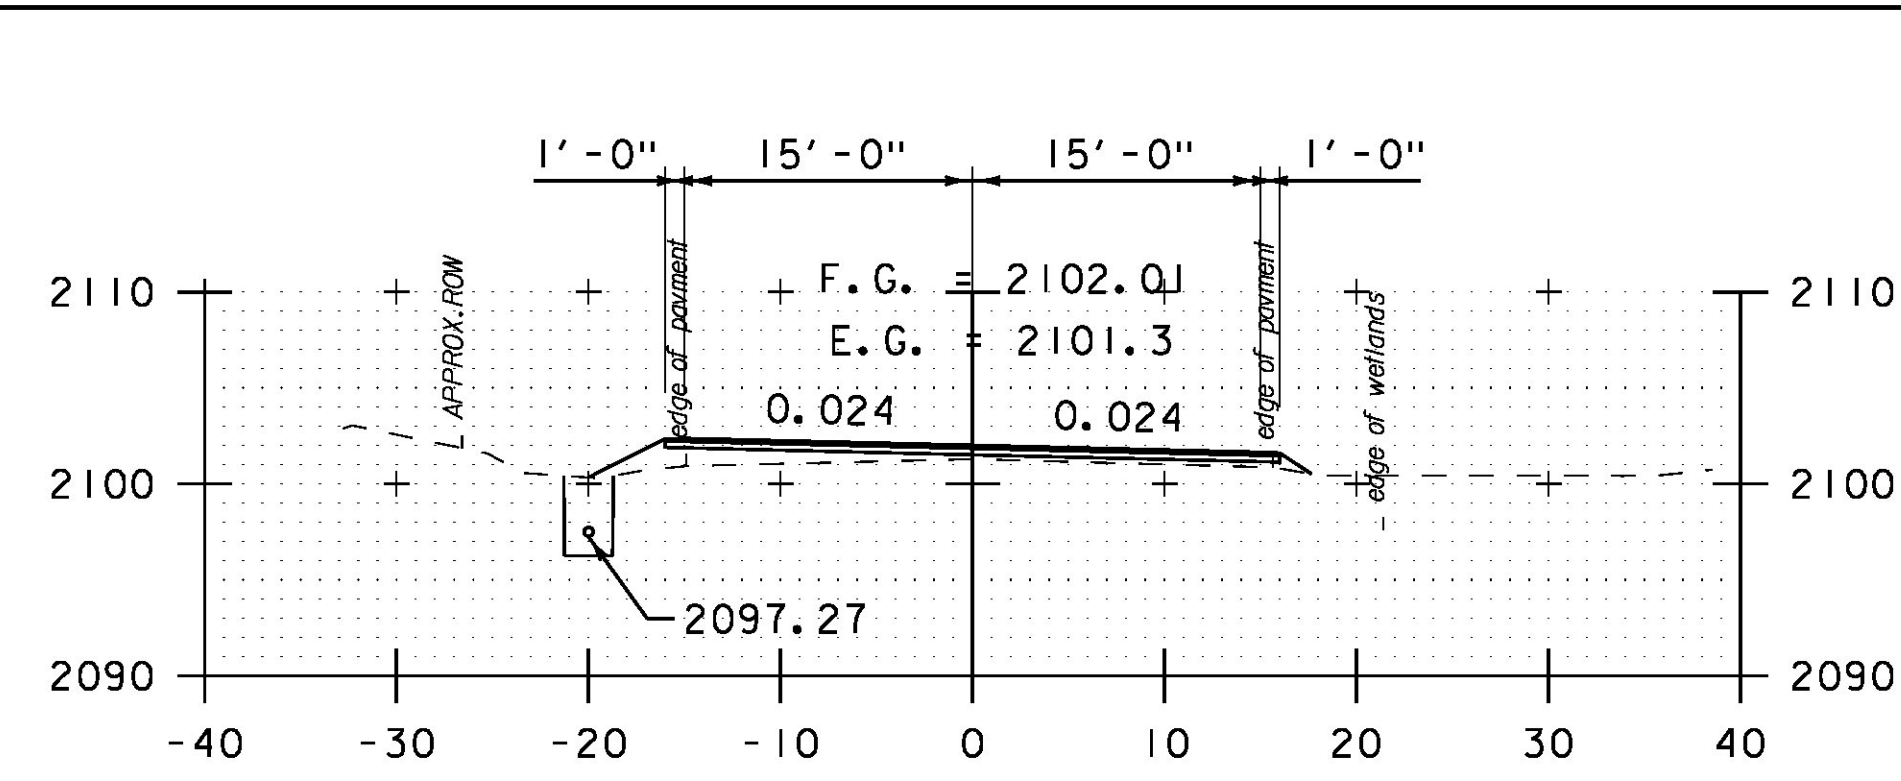


64+00

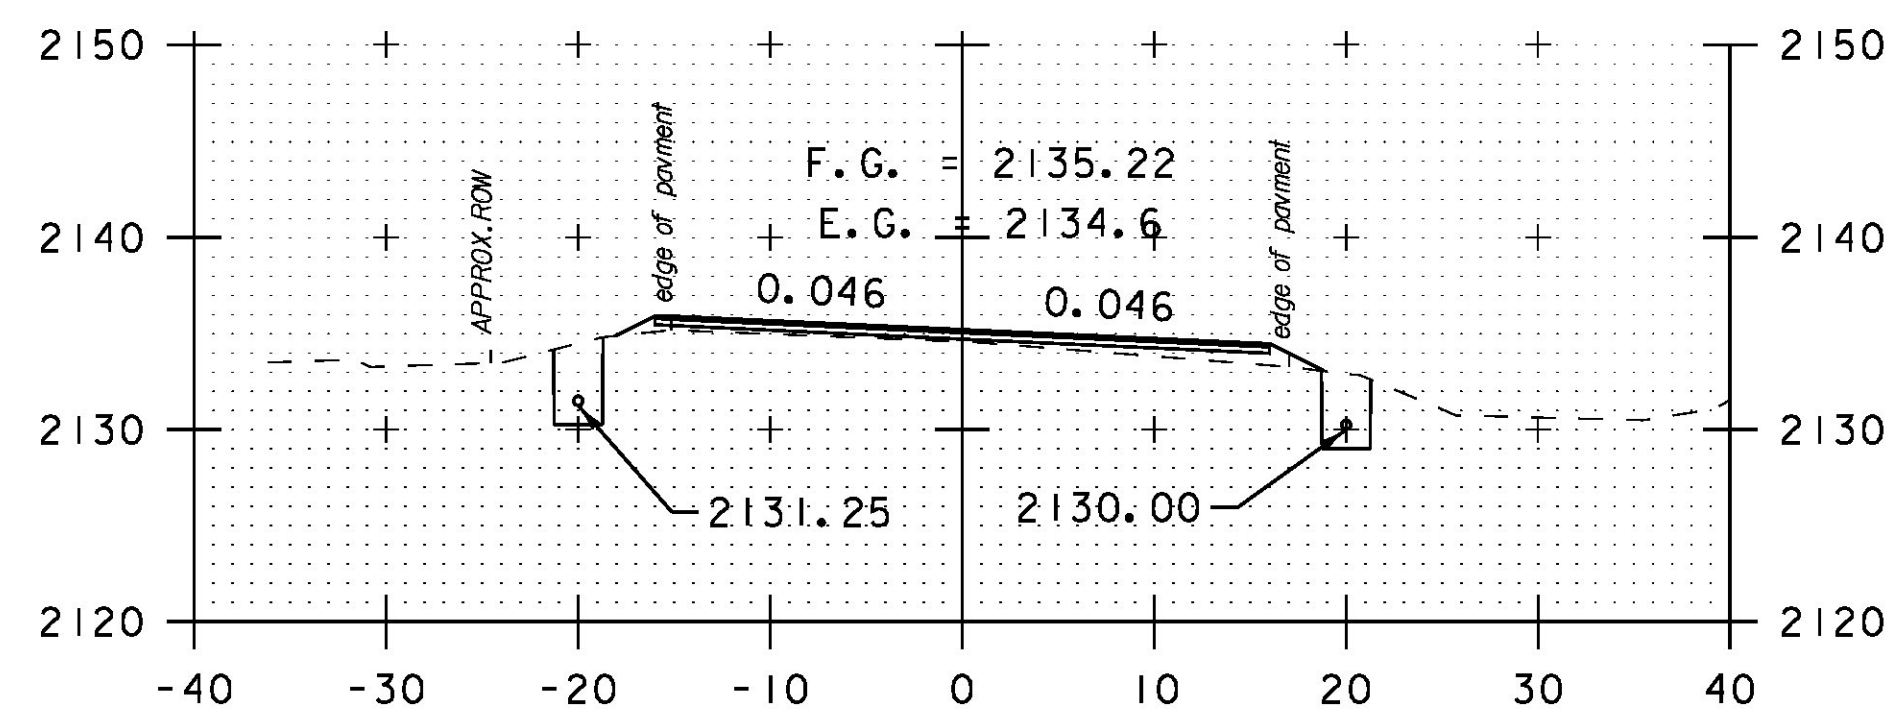


60+00

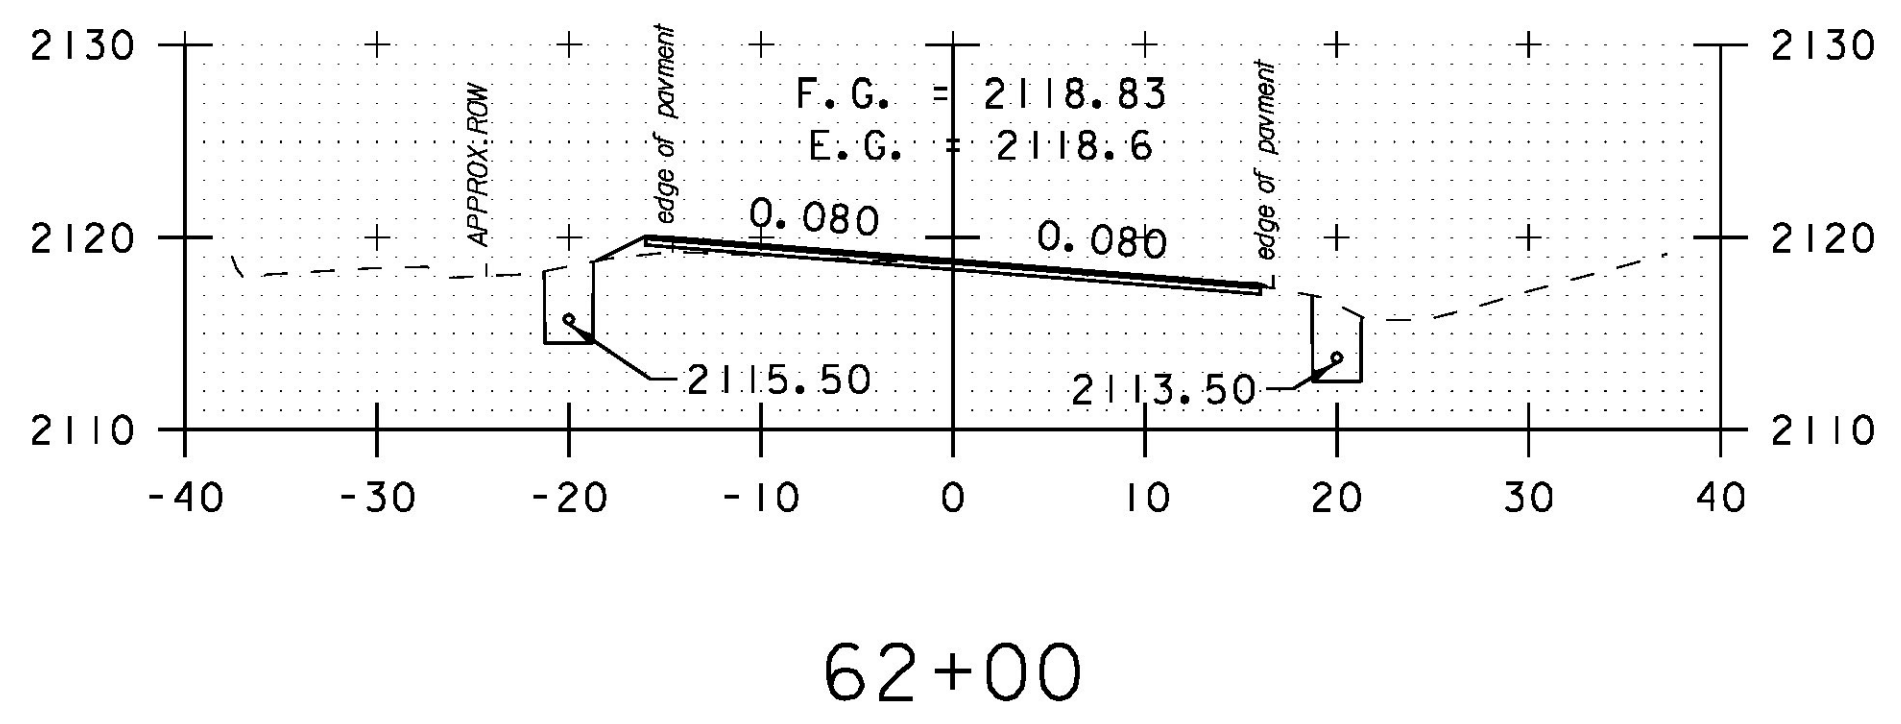


62+00

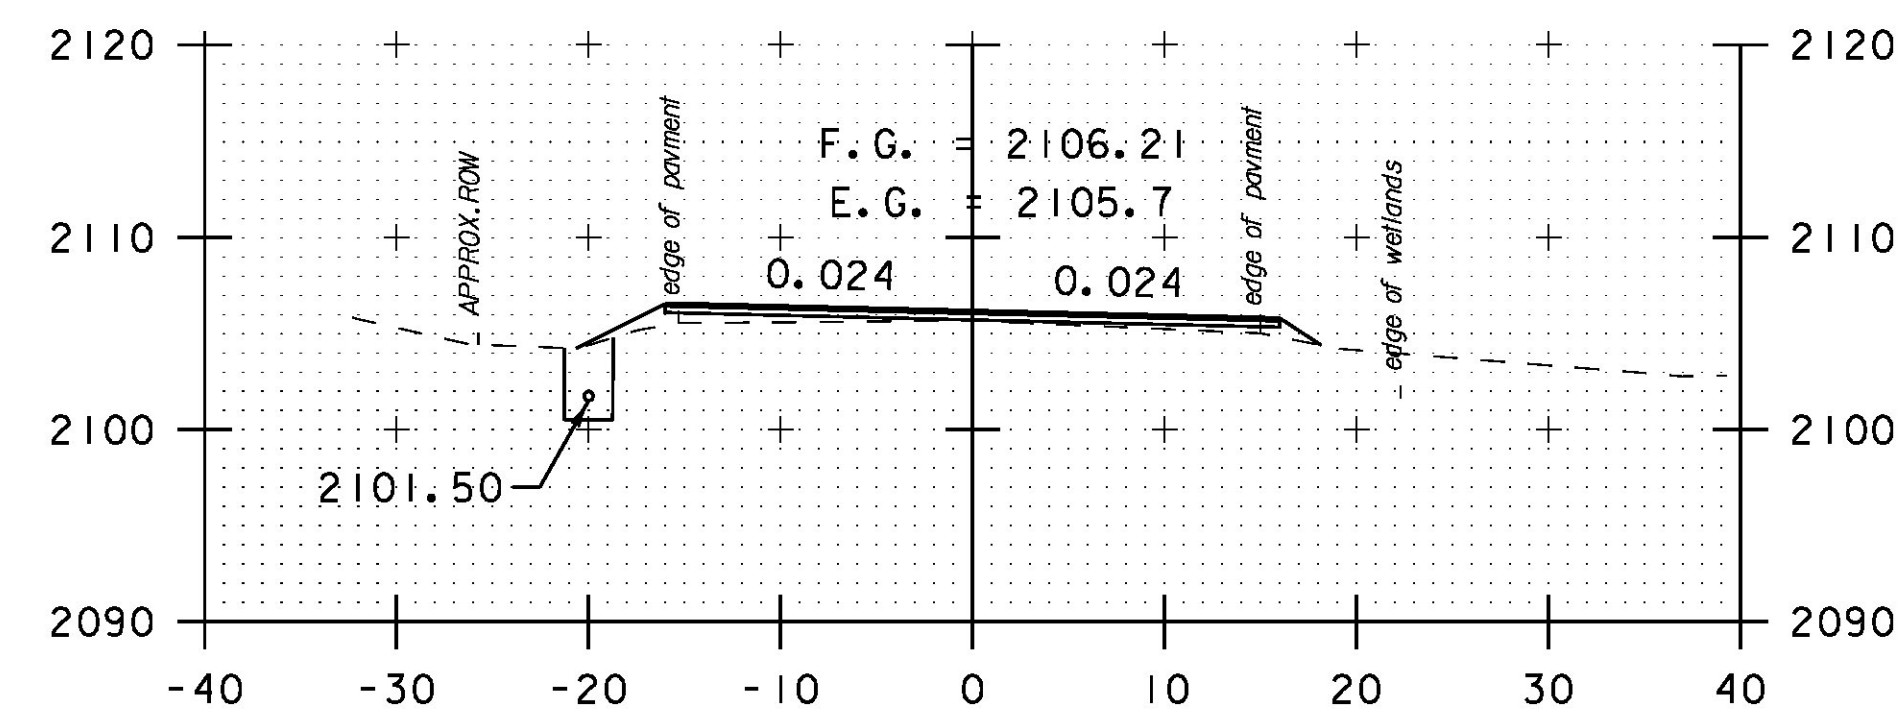


63+50

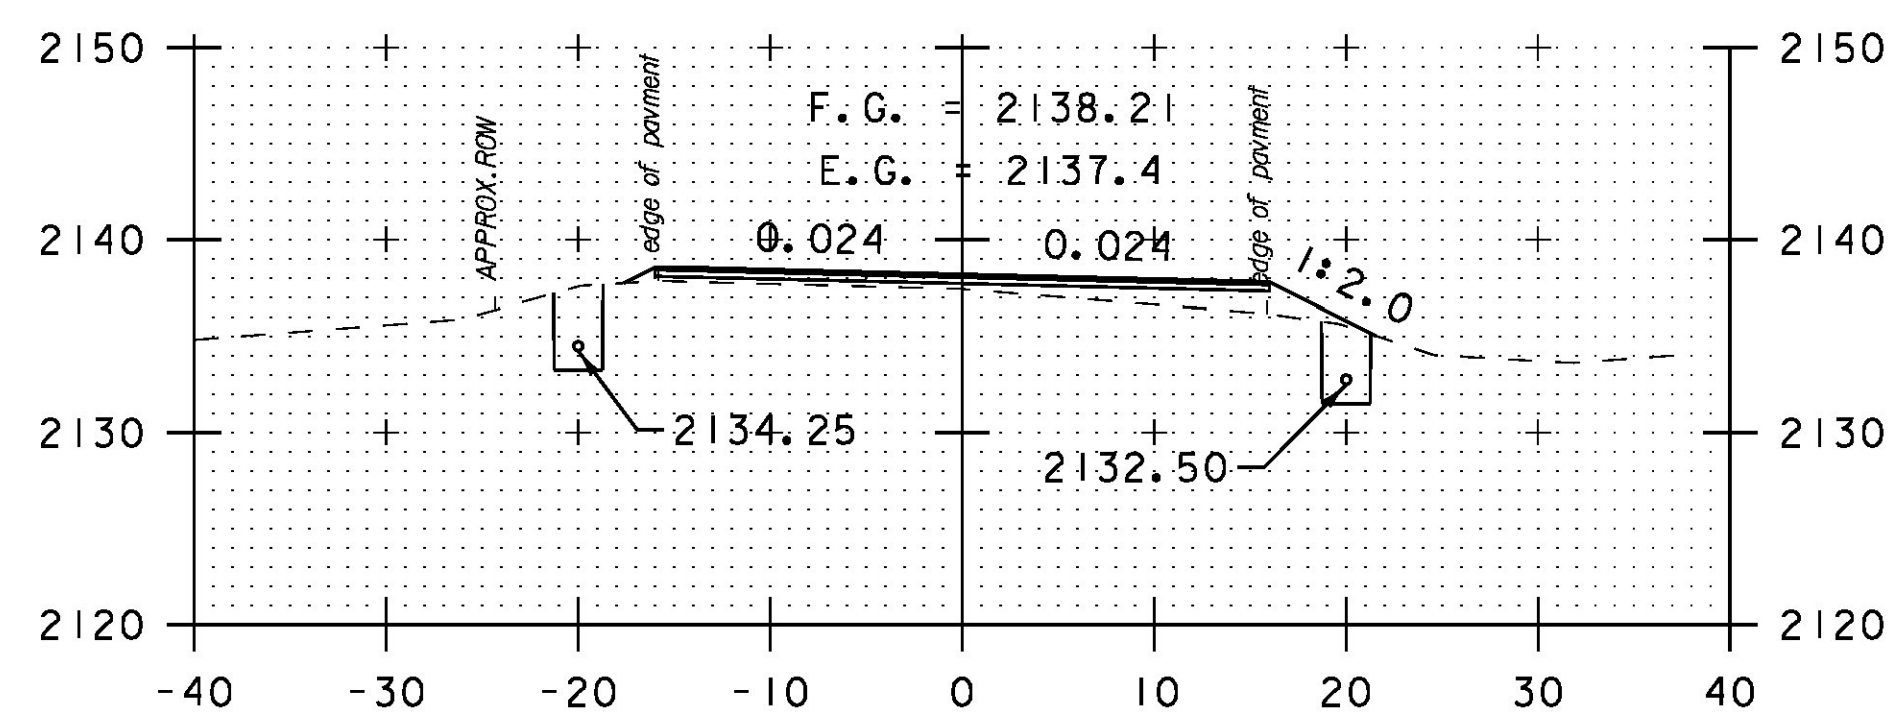


59+50

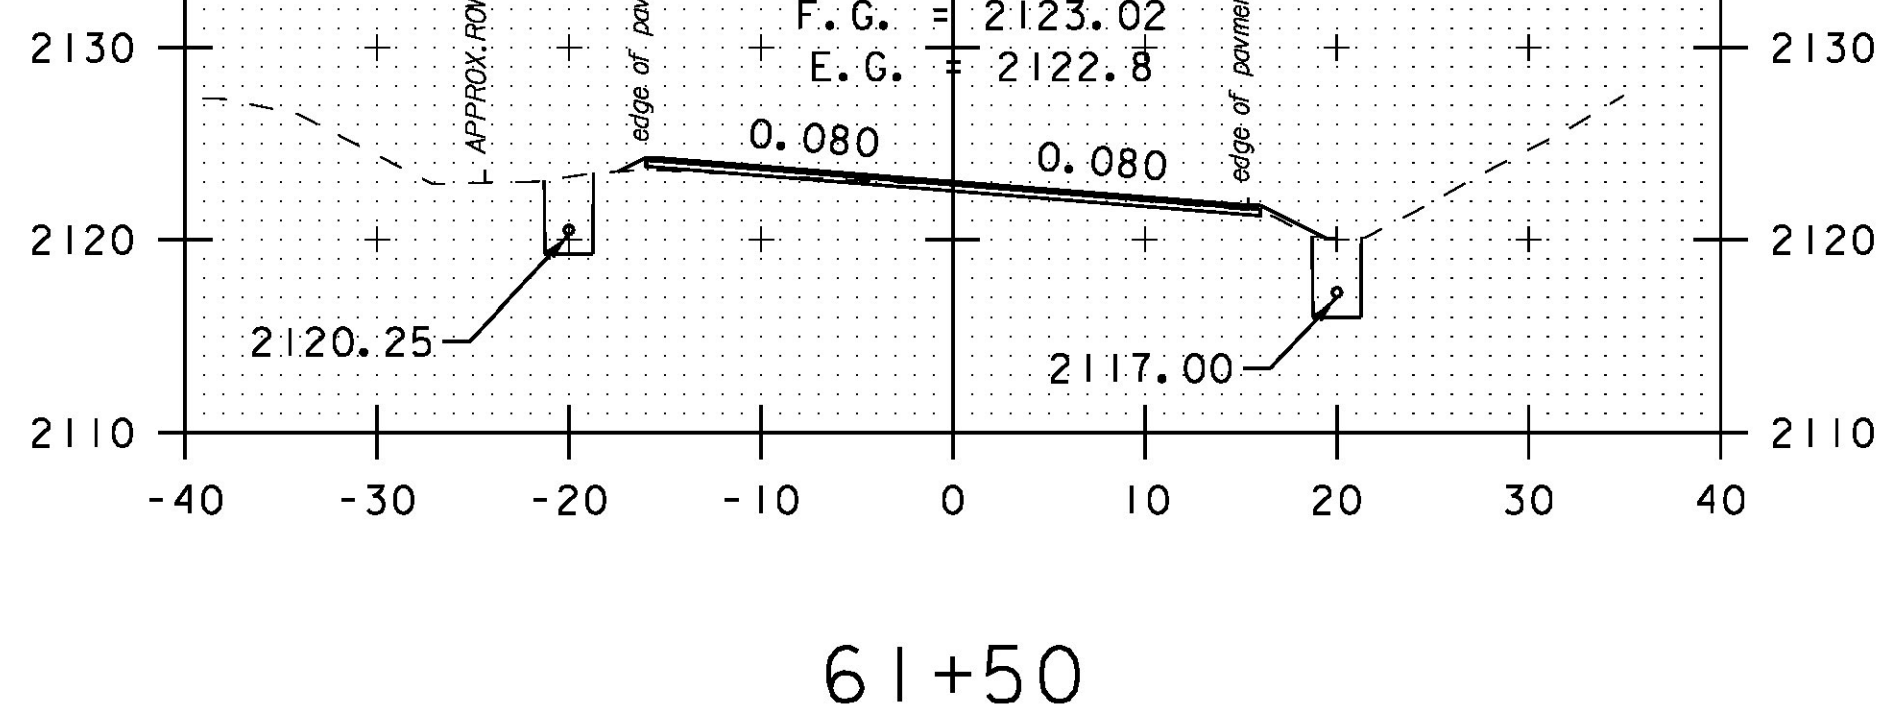


61+50

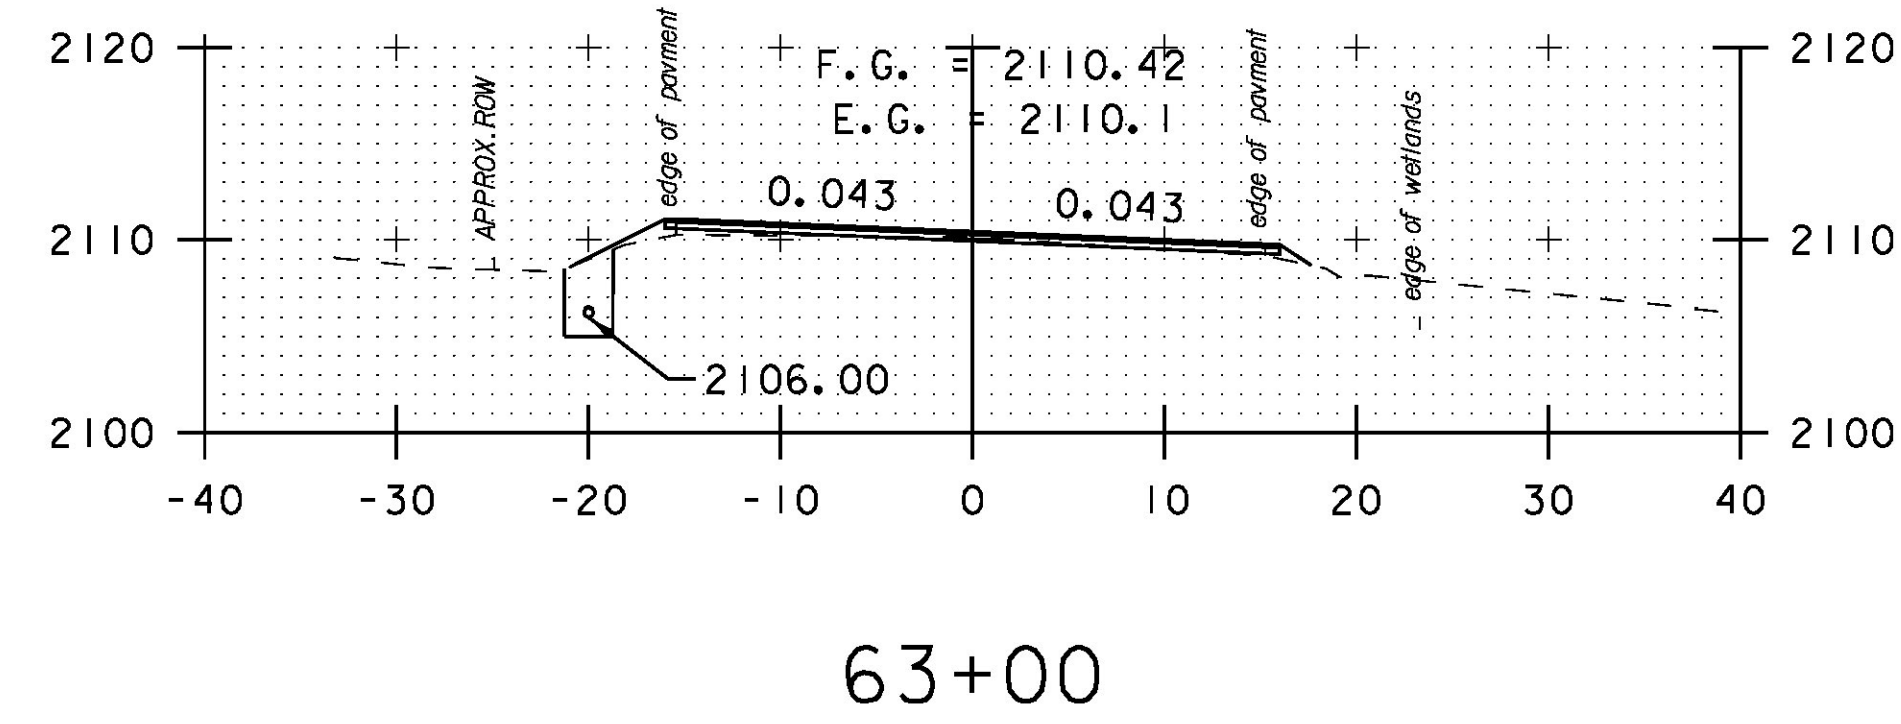


63+00

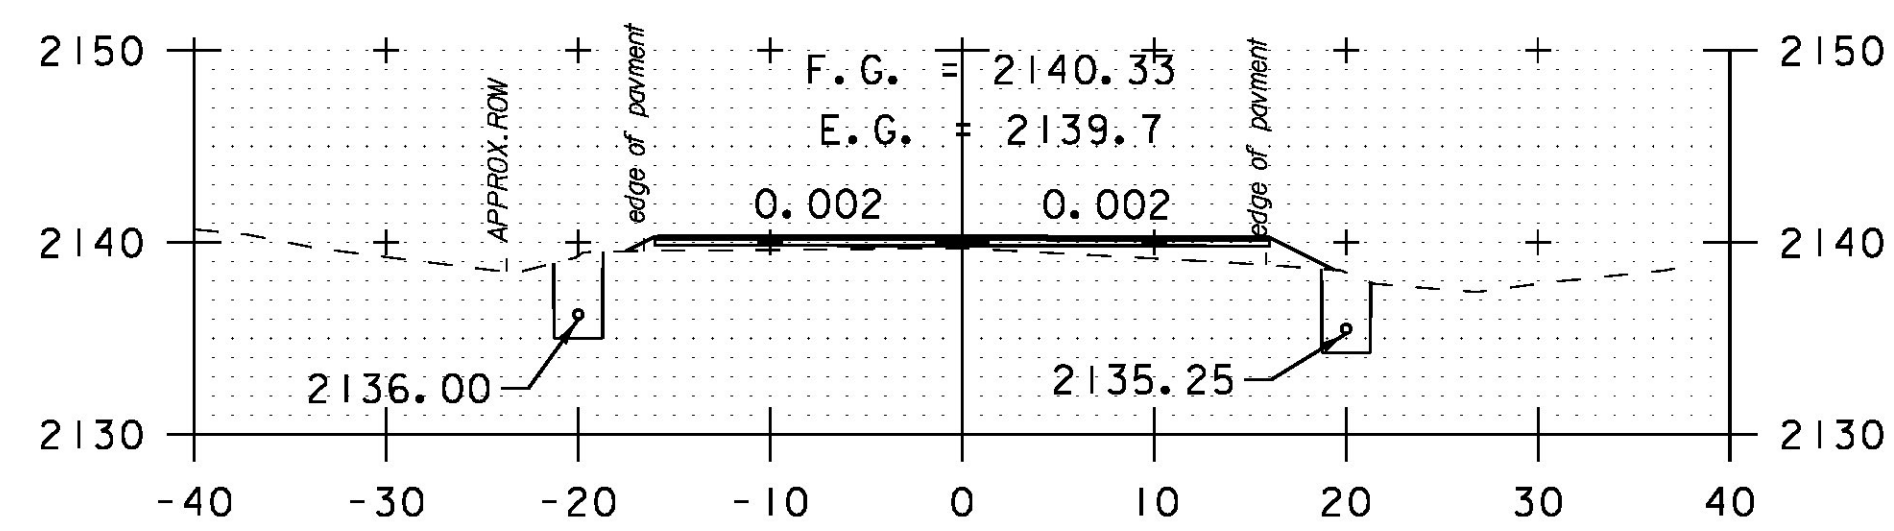


59+00

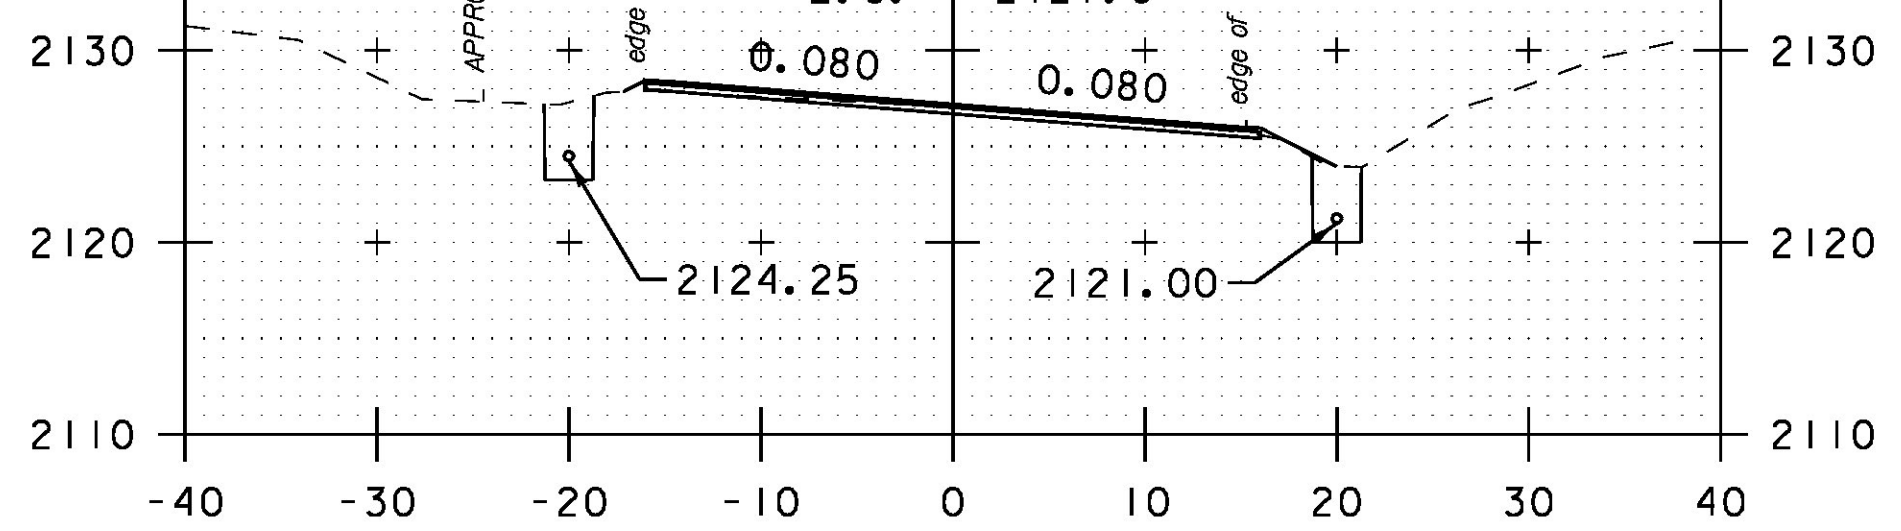

61+00

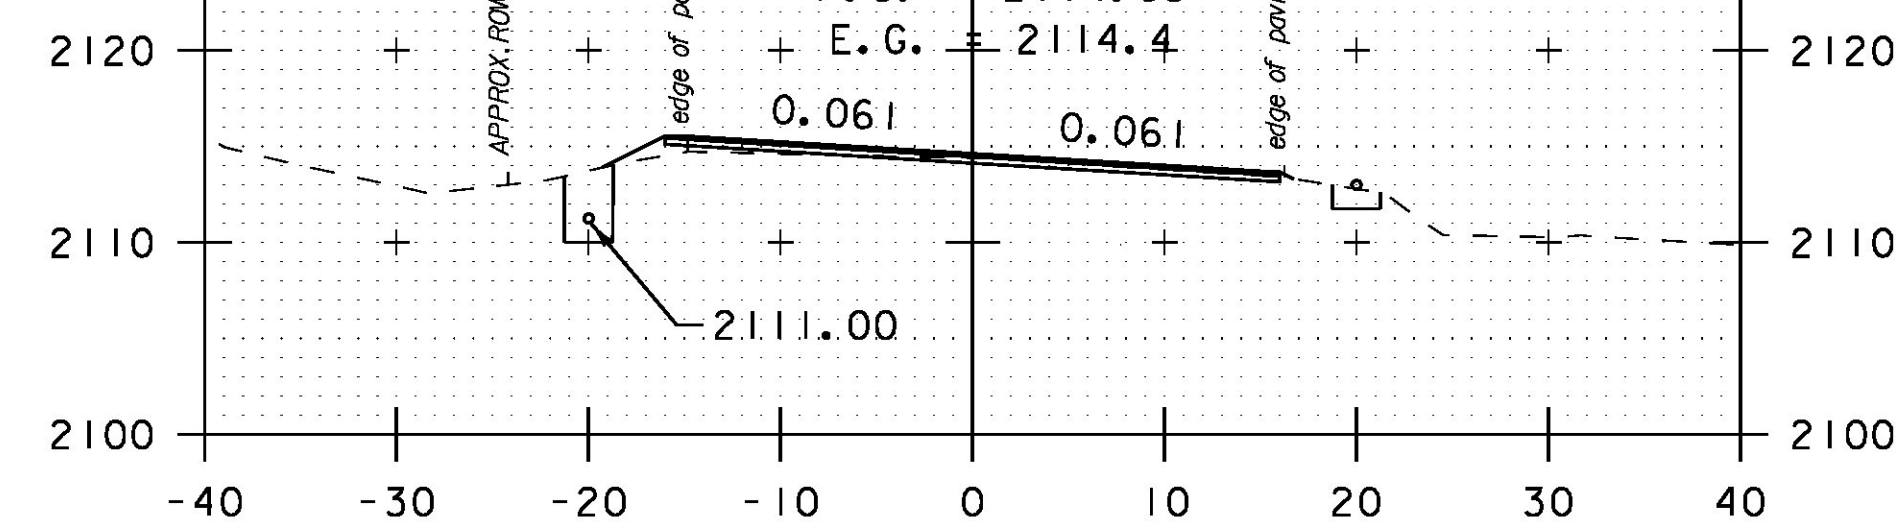

62+50

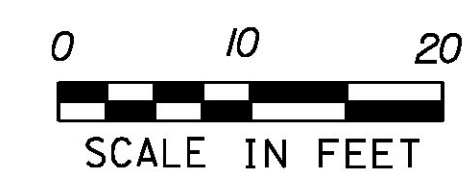

PROJECT NAME:	HANCOCK
PROJECT NUMBER:	STP 2923 (1)
FILE NAME:	z10c252xs.dgn
PROJECT LEADER:	C. LATHROP
DESIGNED BY:	B. MARTIN
CROSS SECTION SHEET	5
PLOT DATE:	3/18/2015
DRAWN BY:	B. MARTIN
CHECKED BY:	C. LATHROP
SHEET	132 OF 207