




66+00

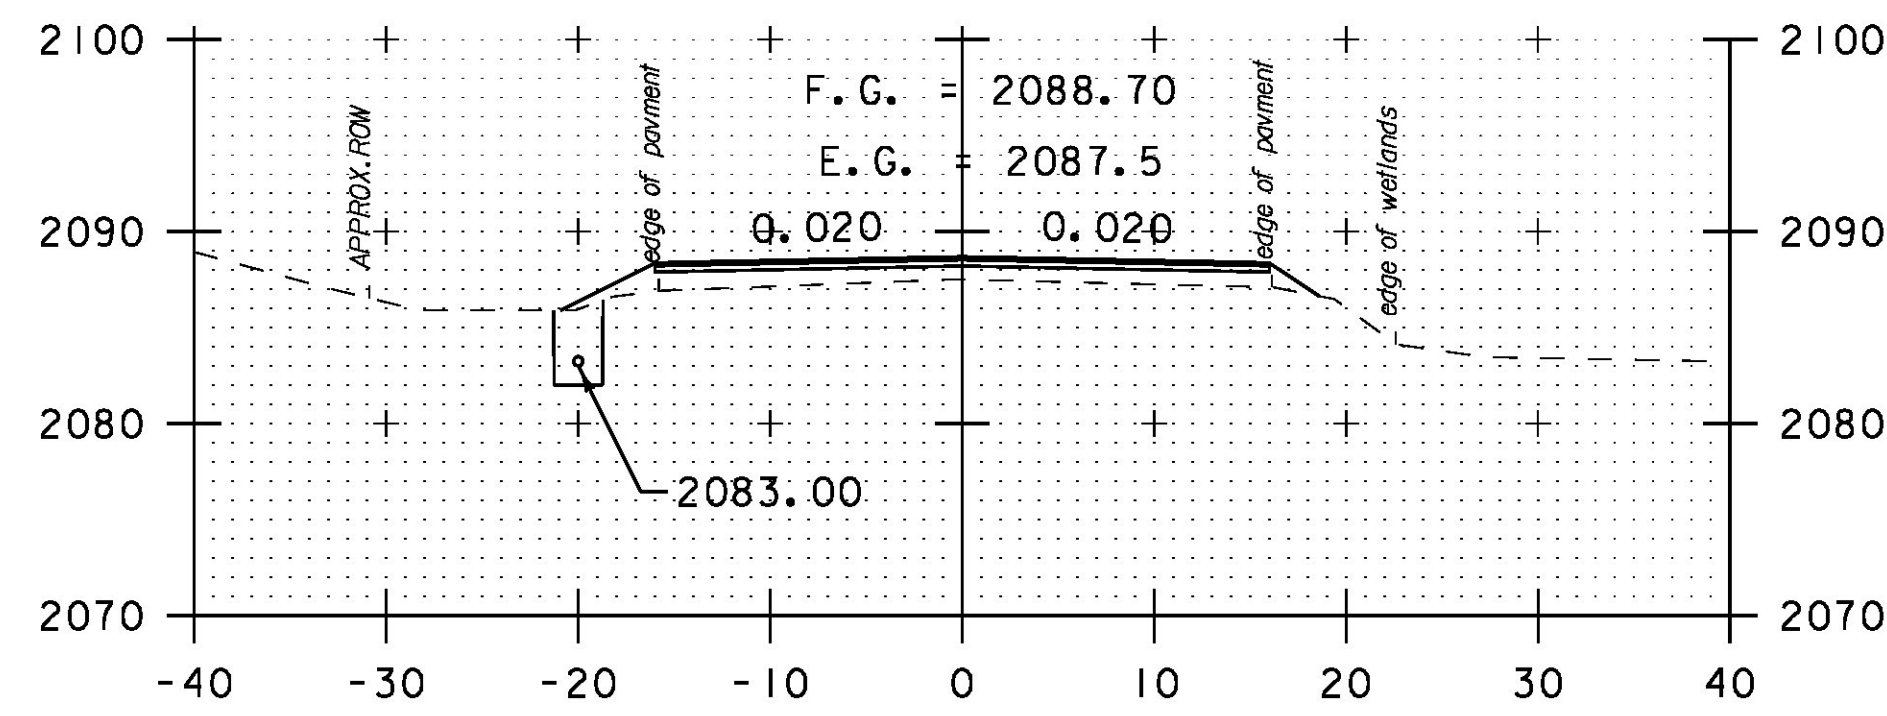


65+50

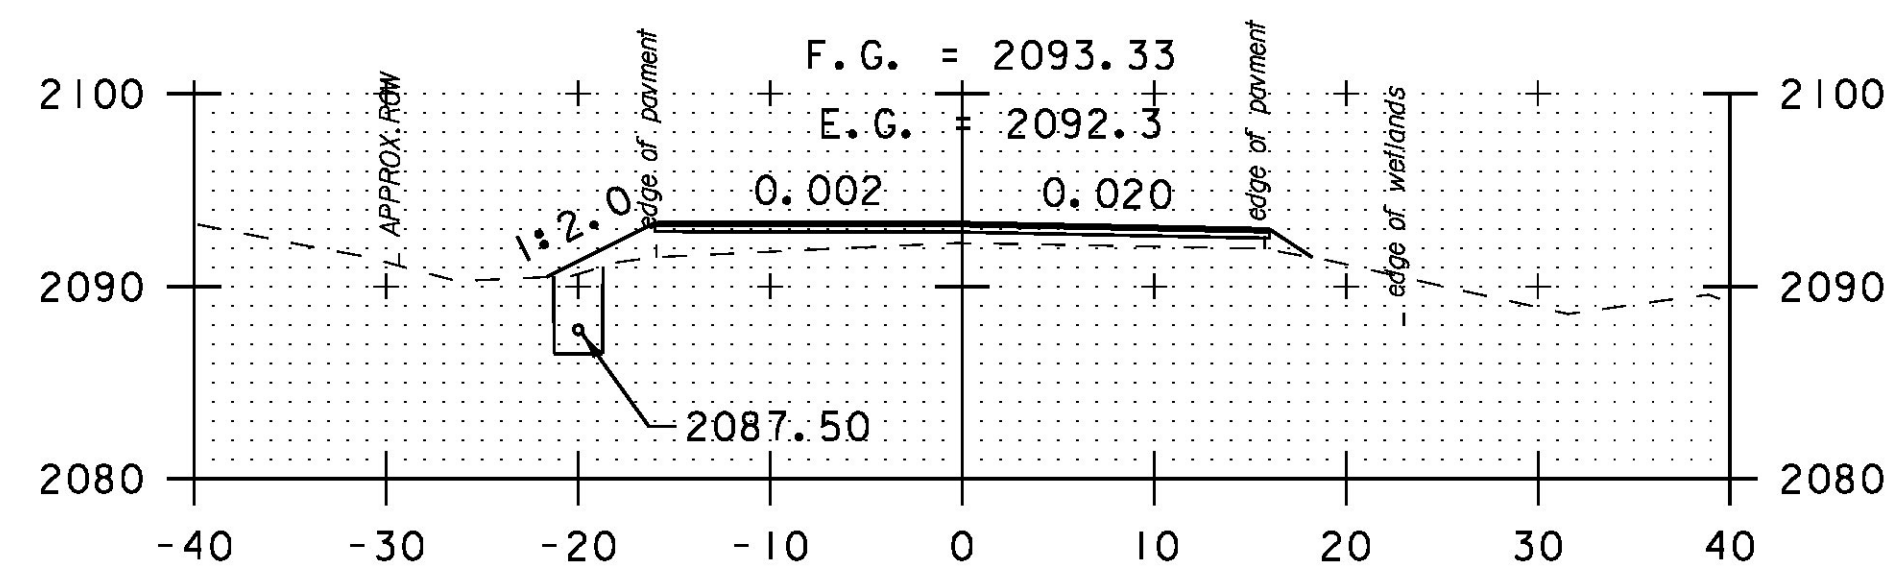


65+00

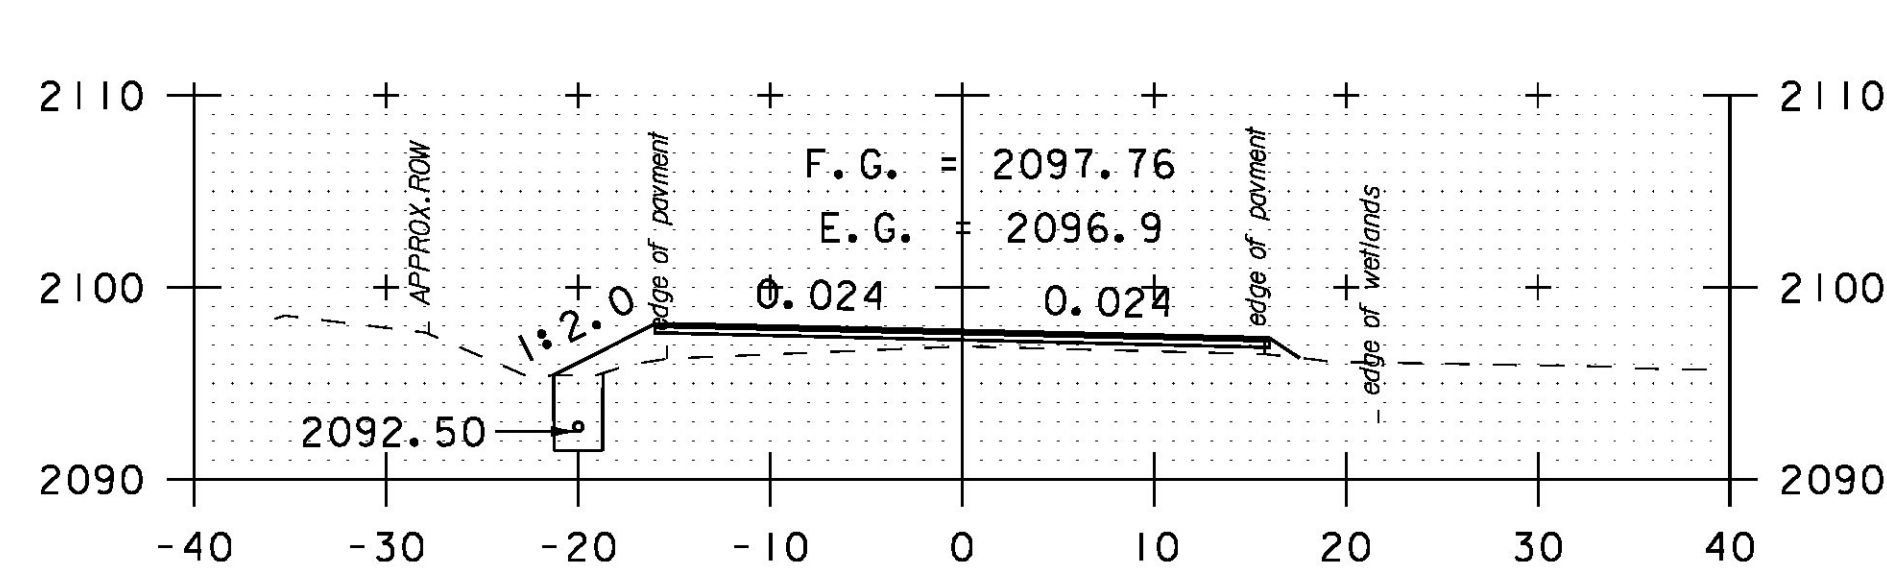


64+50

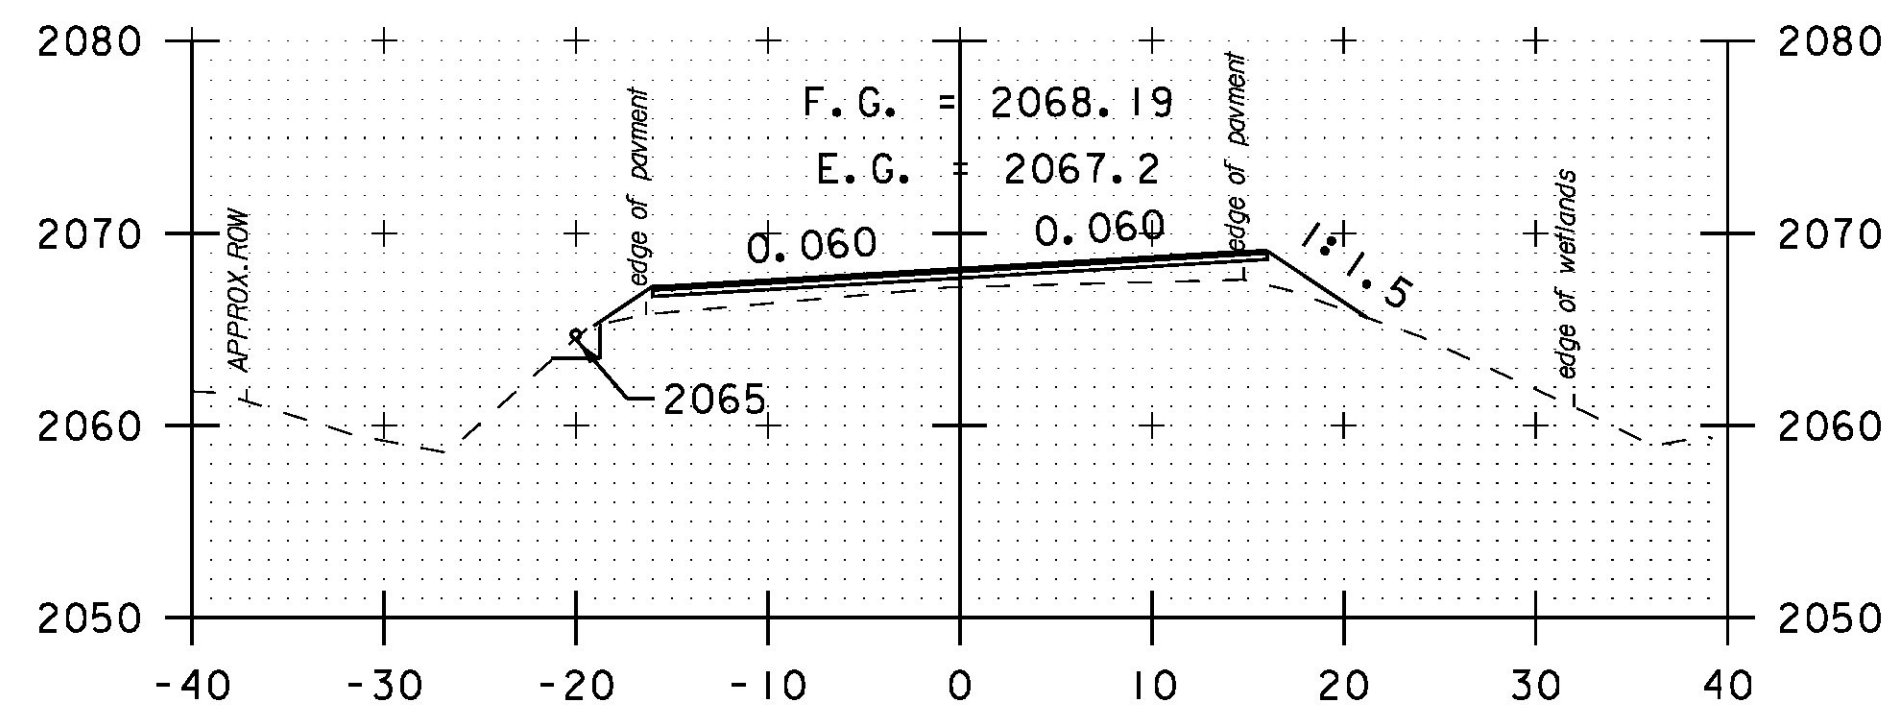


67+50

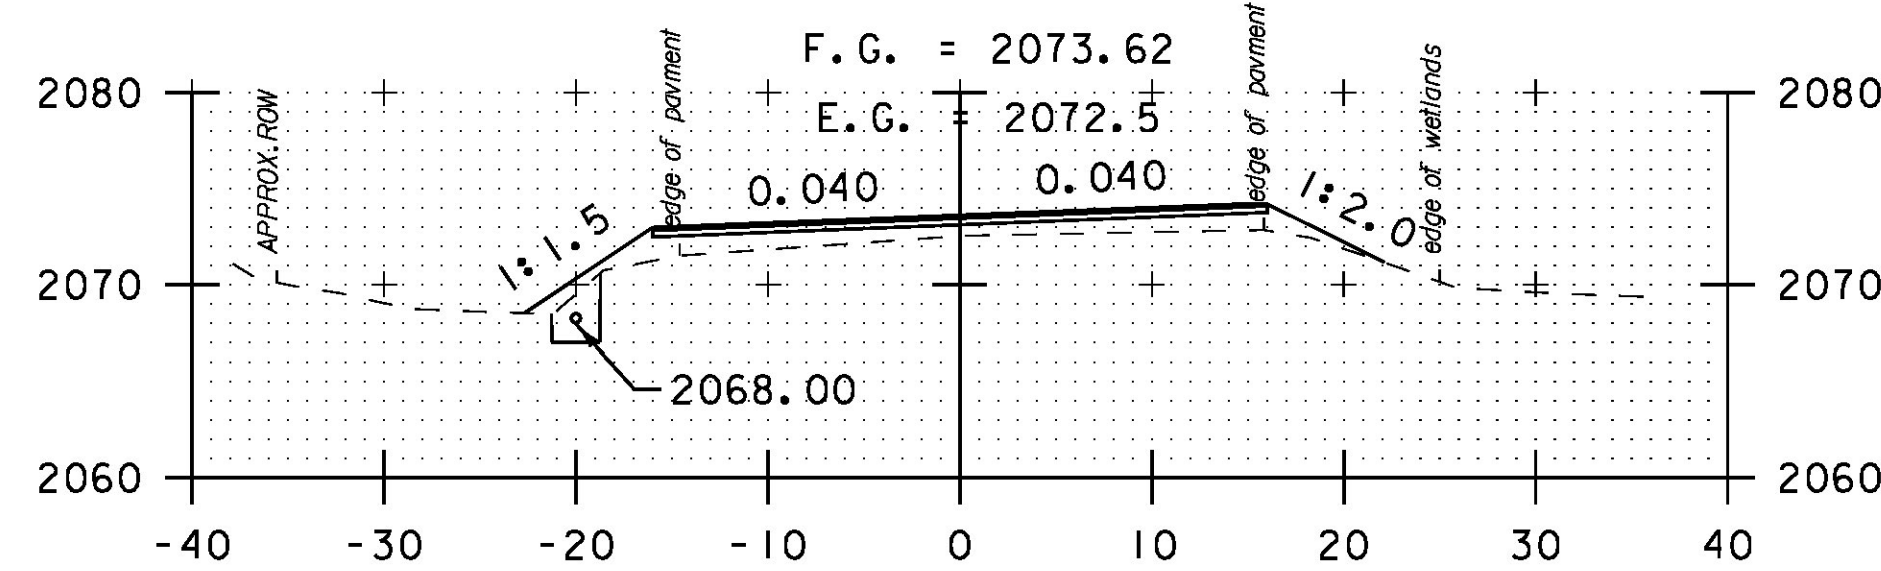


67+00

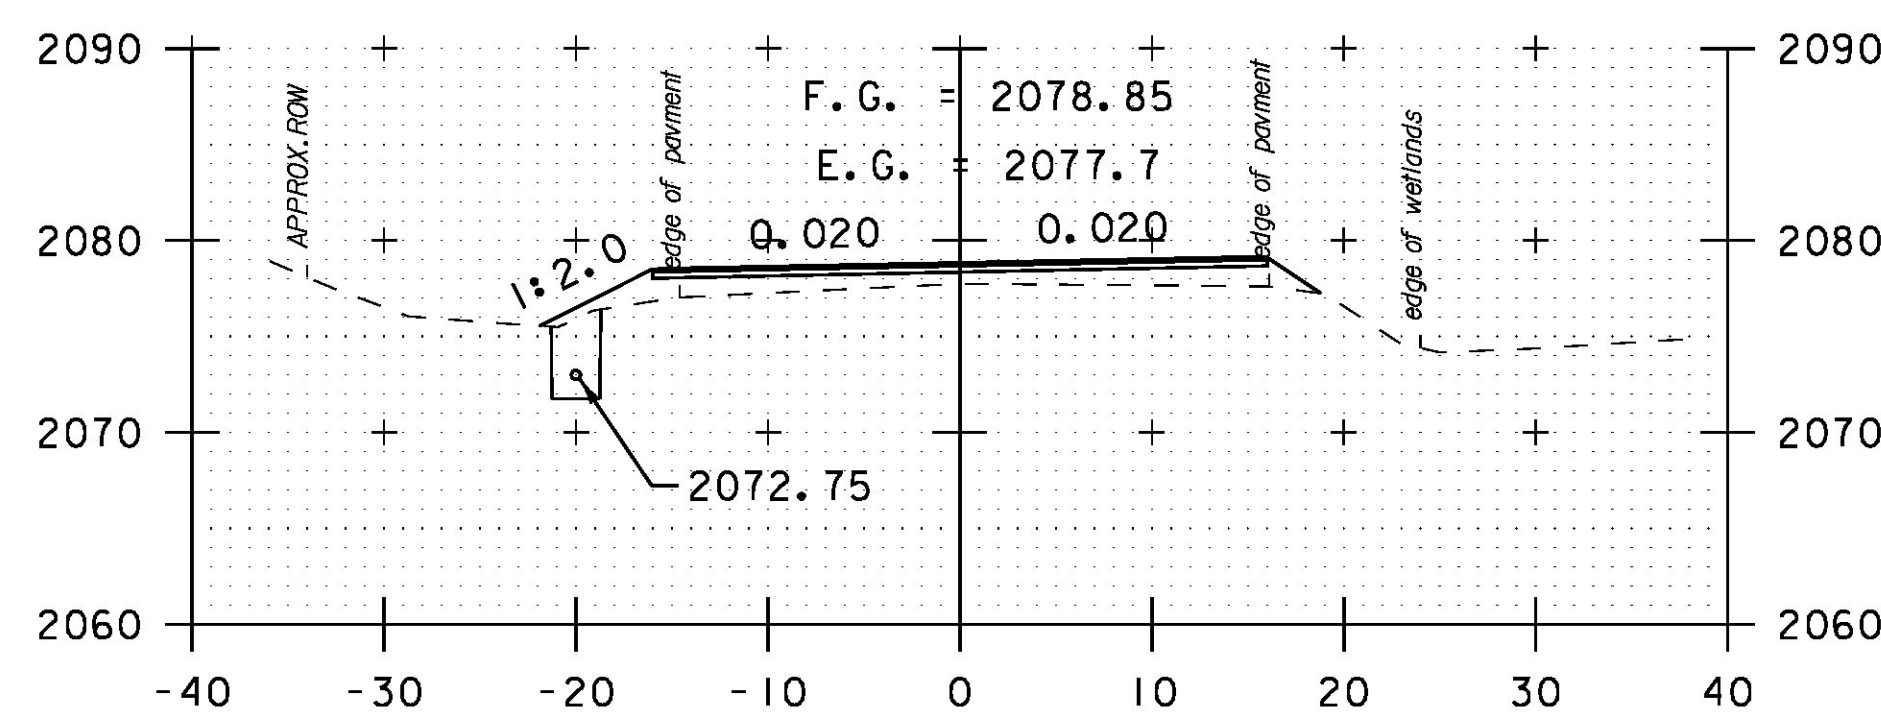


66+50

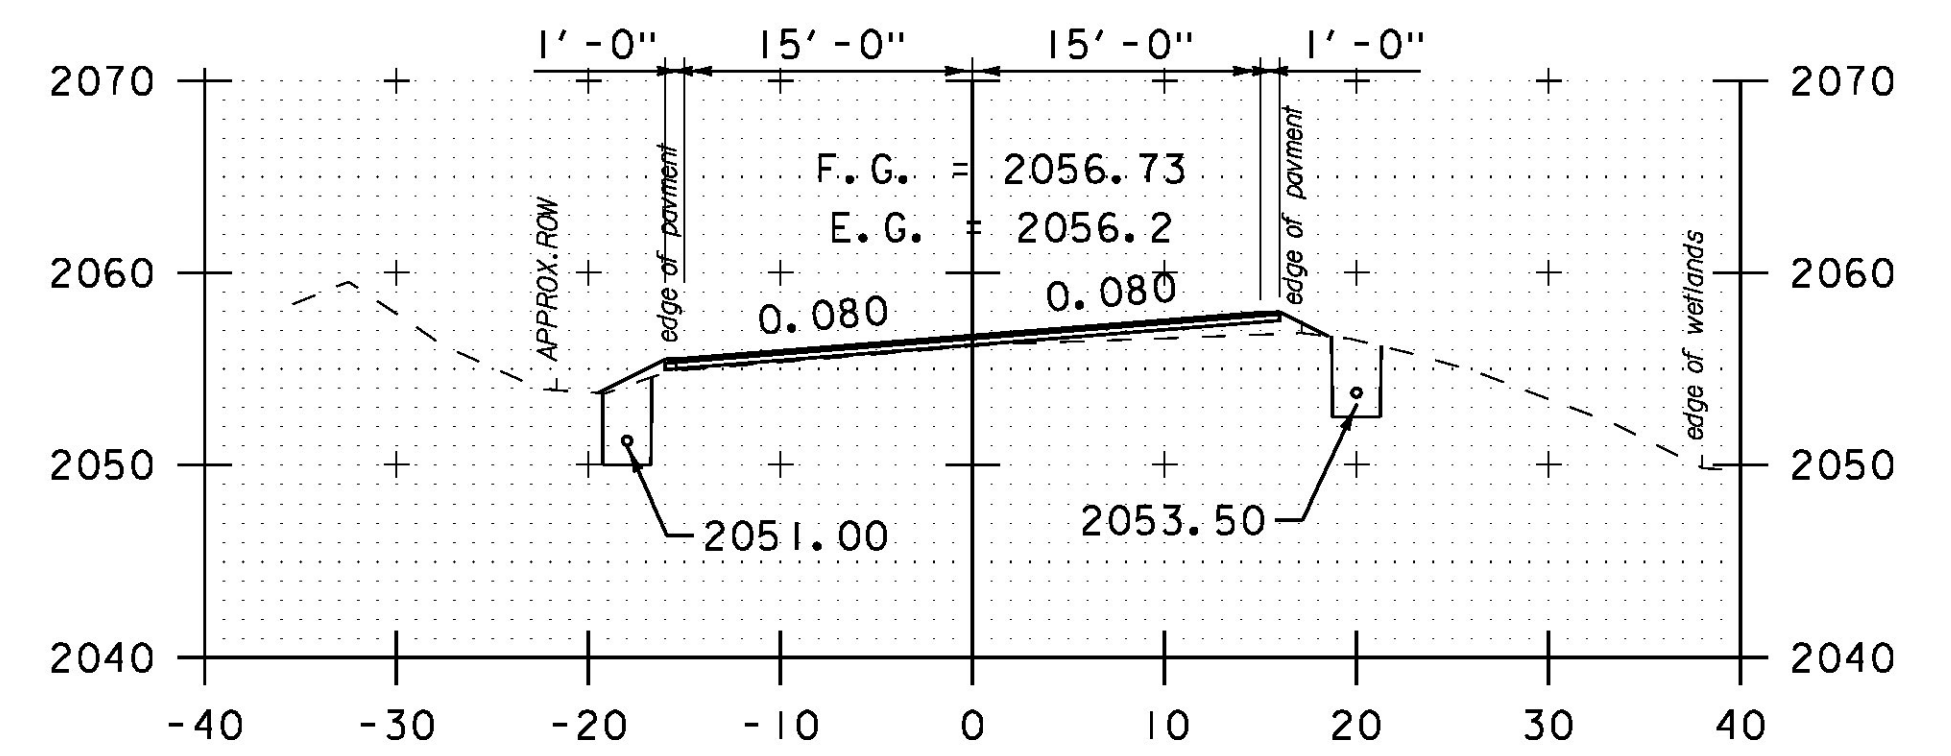

68+50

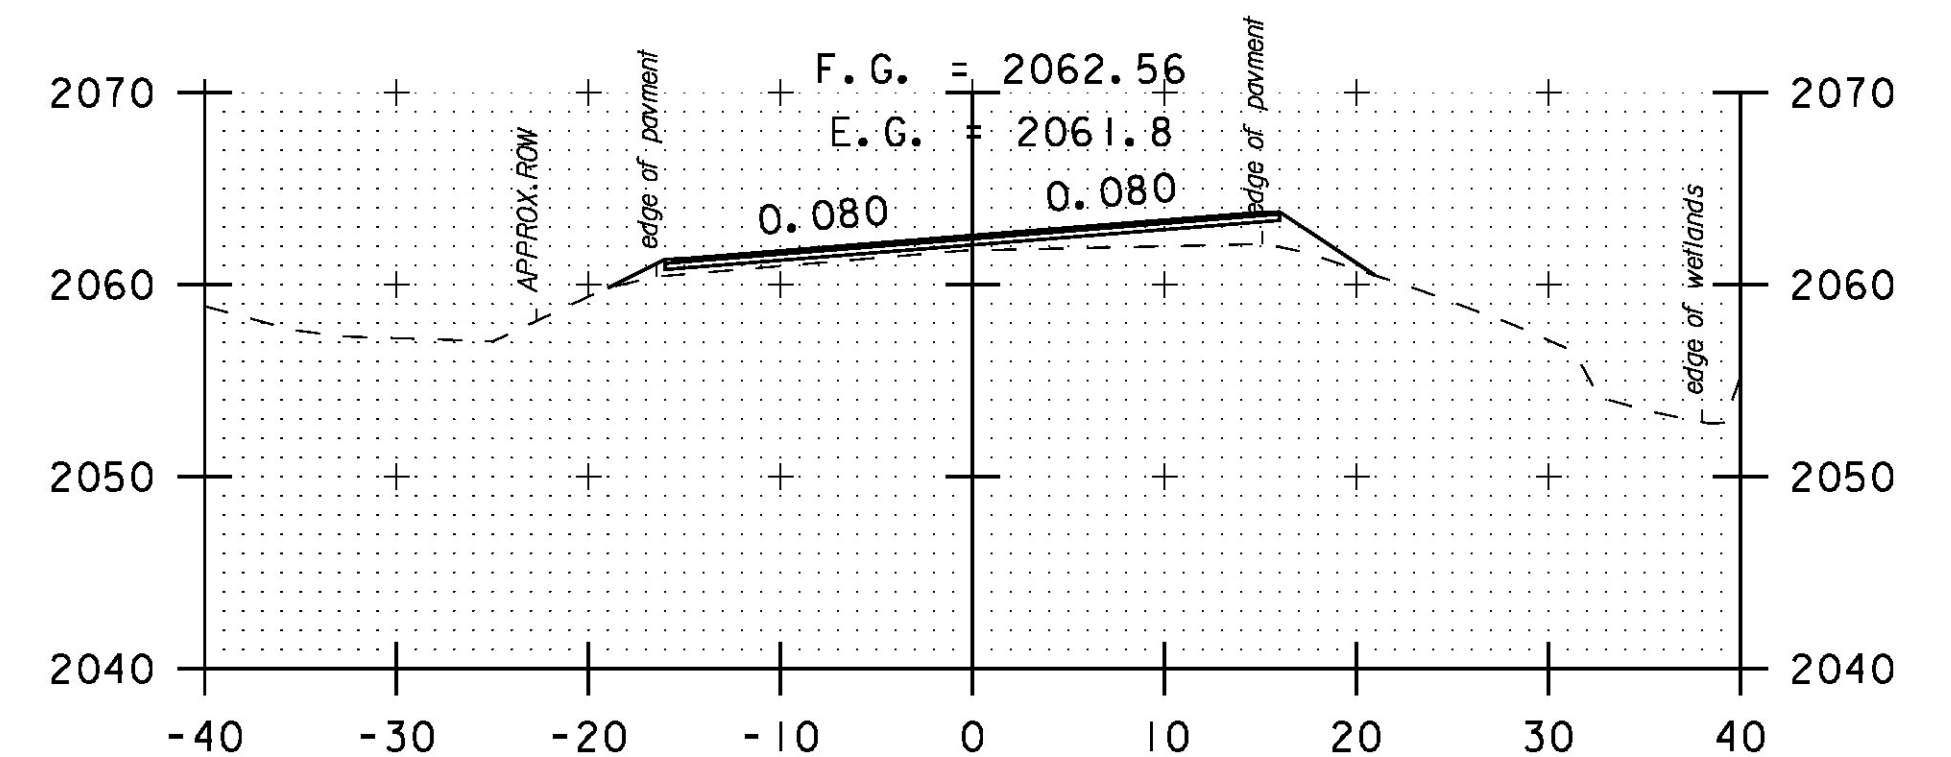


68+00

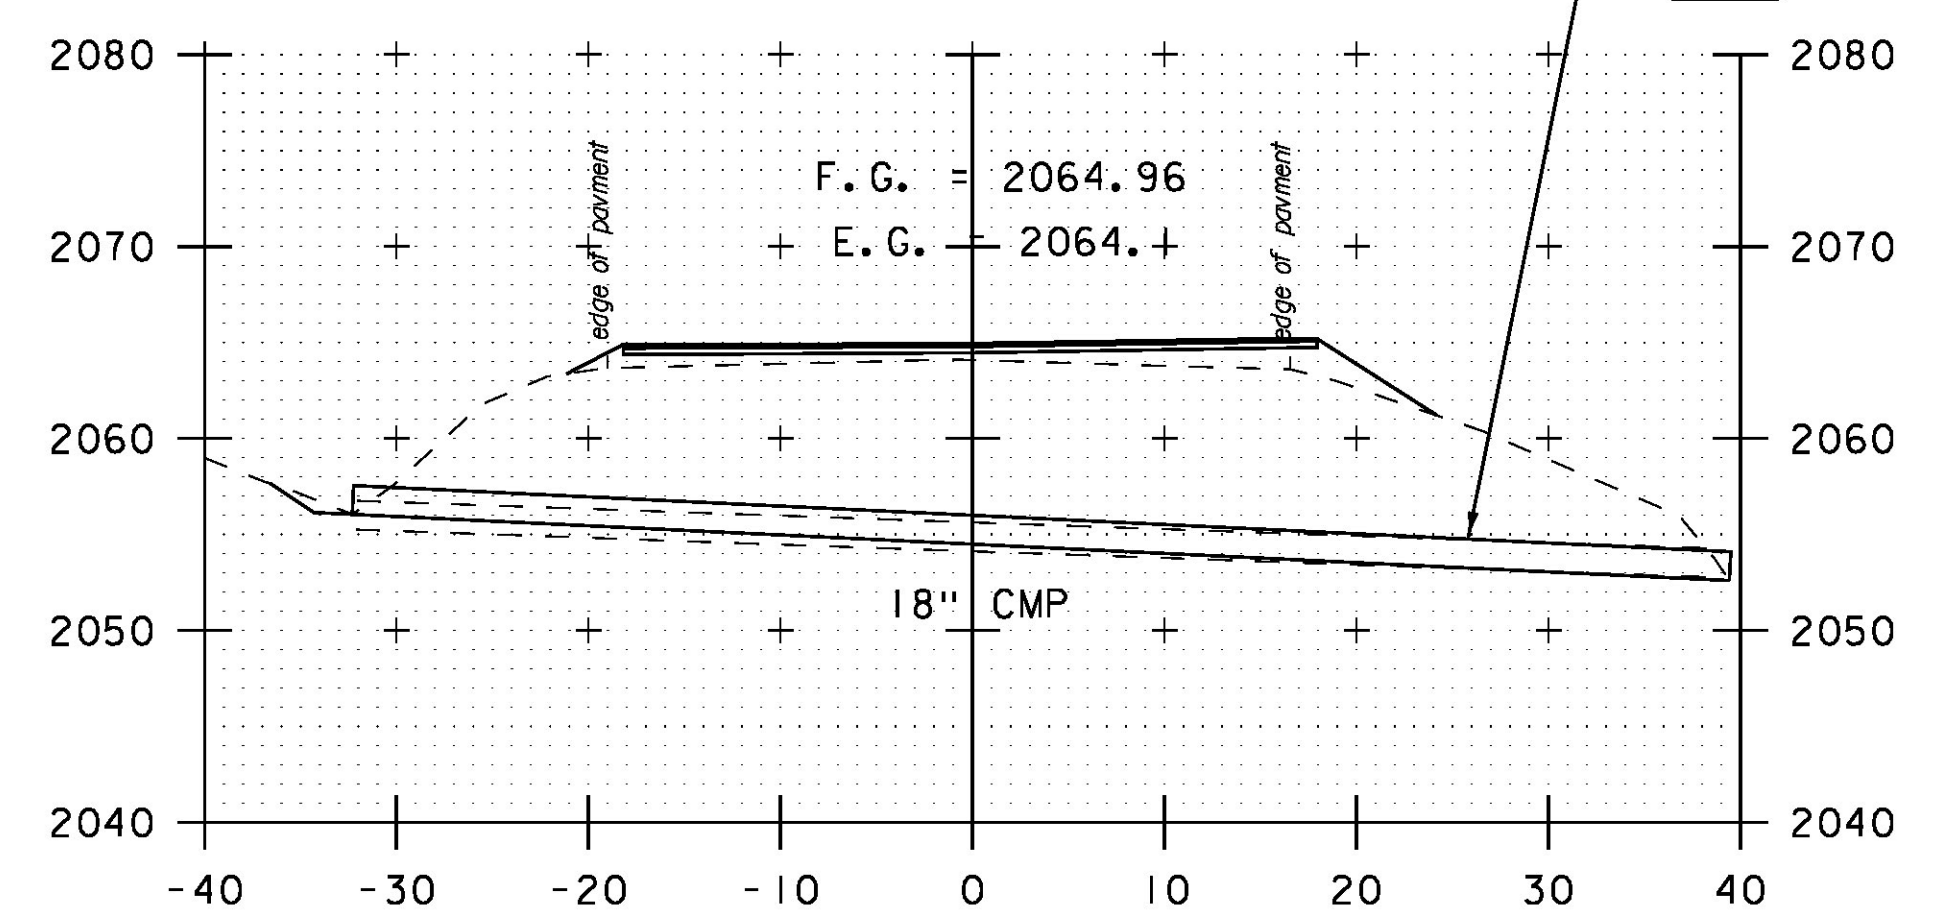

67+79

STA. 67+62.66 LT 28.18' TO
 STA. 67+95.74 RT 35.33'
 ASKEW ANGLE = 62.8575° RT
 REMOVE EXISTING PIPE
 INSTALL 18" CPEP (72'-0")
 INV. IN = 2056.05'
 INV. OUT = 2052.60'

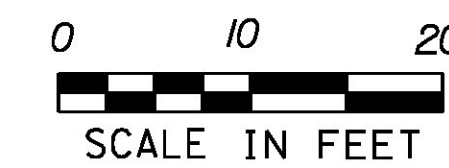

PROJECT NAME: HANCOCK	PLOT DATE: 3/18/2015
PROJECT NUMBER: STP 2923 (1)	DRAWN BY: B. MARTIN
FILE NAME: z10c252xs.dgn	CHECKED BY: C. LATHROP
PROJECT LEADER: C. LATHROP	SHEET 133 OF 207
DESIGNED BY: B. MARTIN	
CROSS SECTION SHEET 6	