




70+50

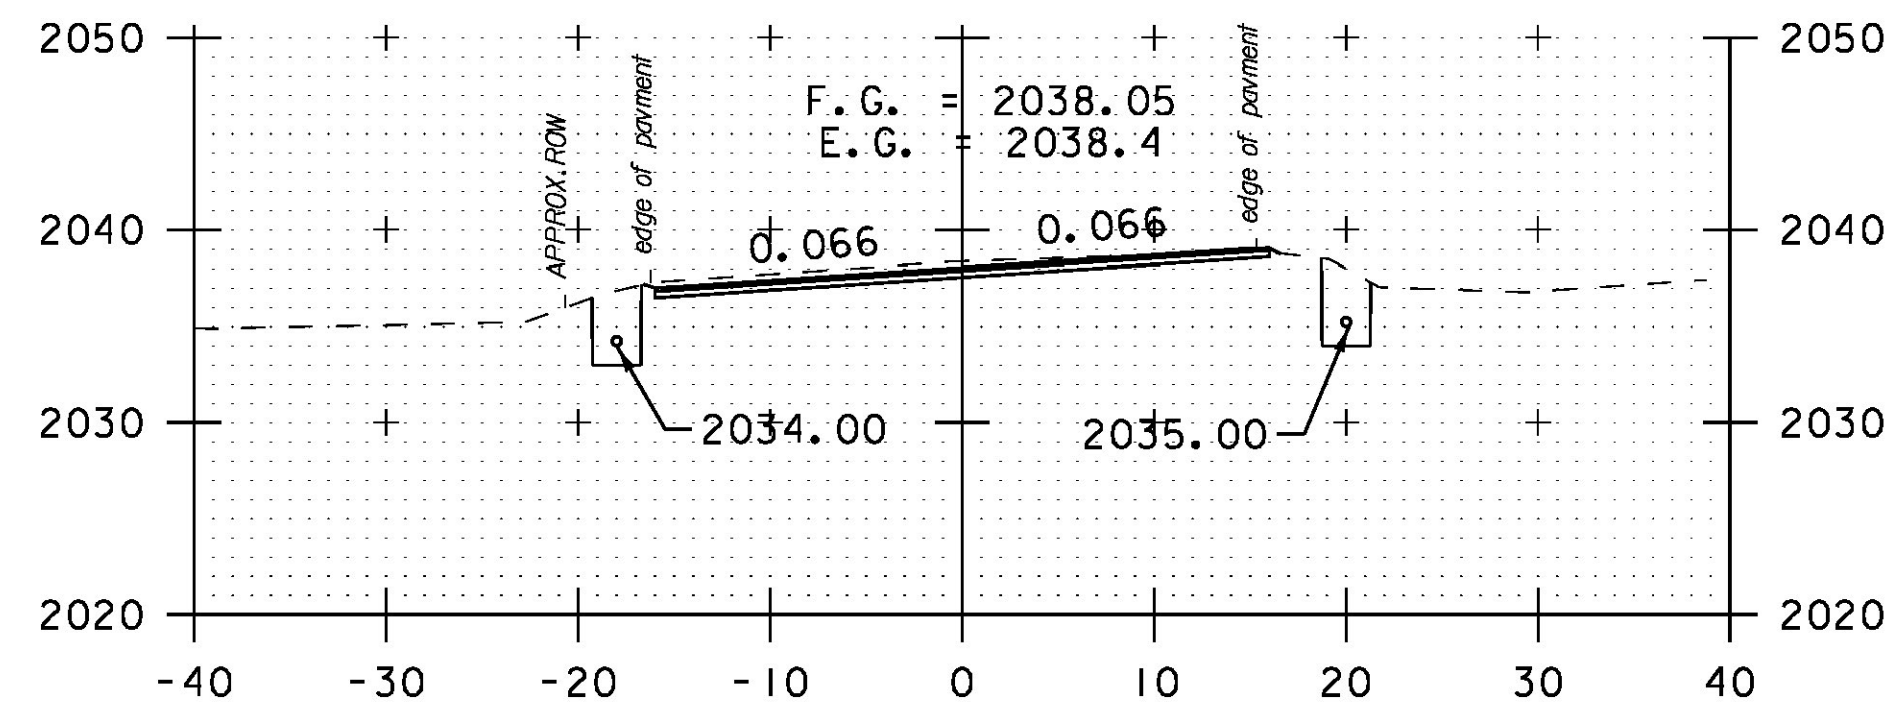


70+00

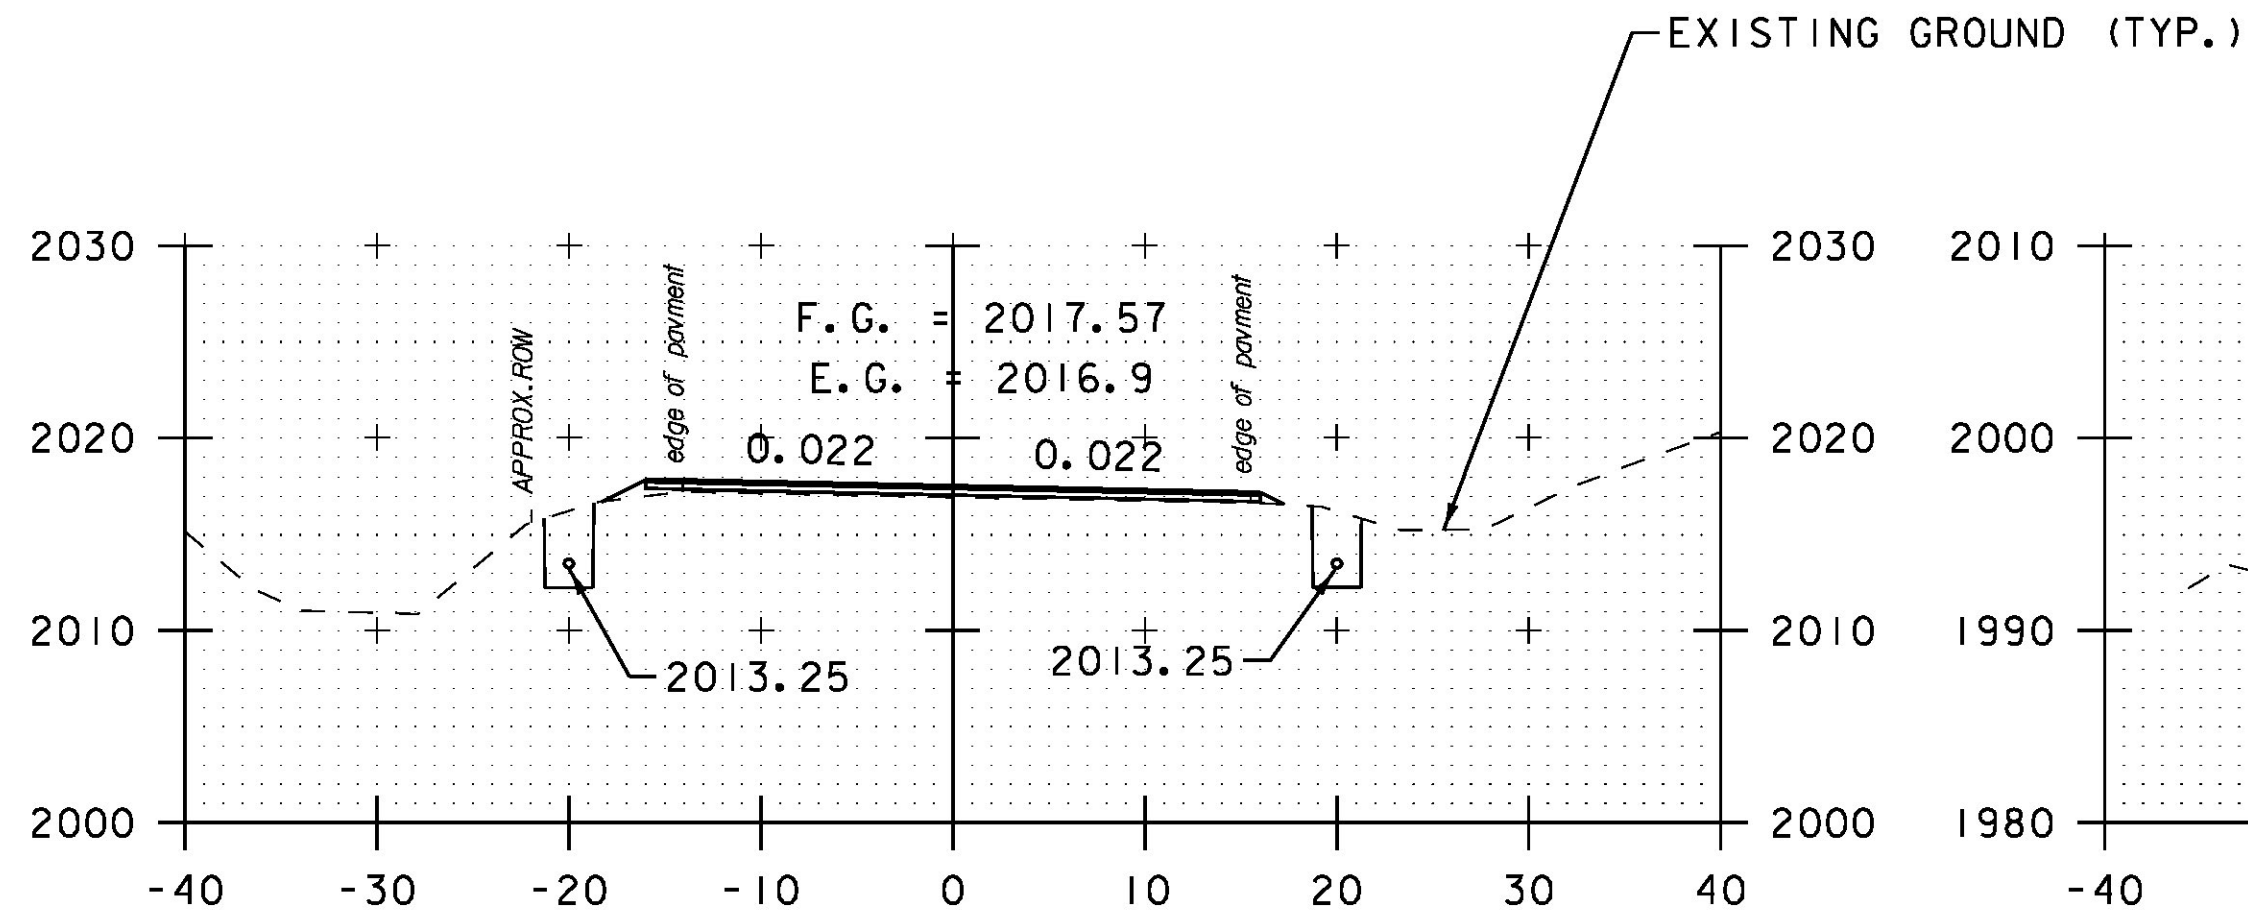


71+50

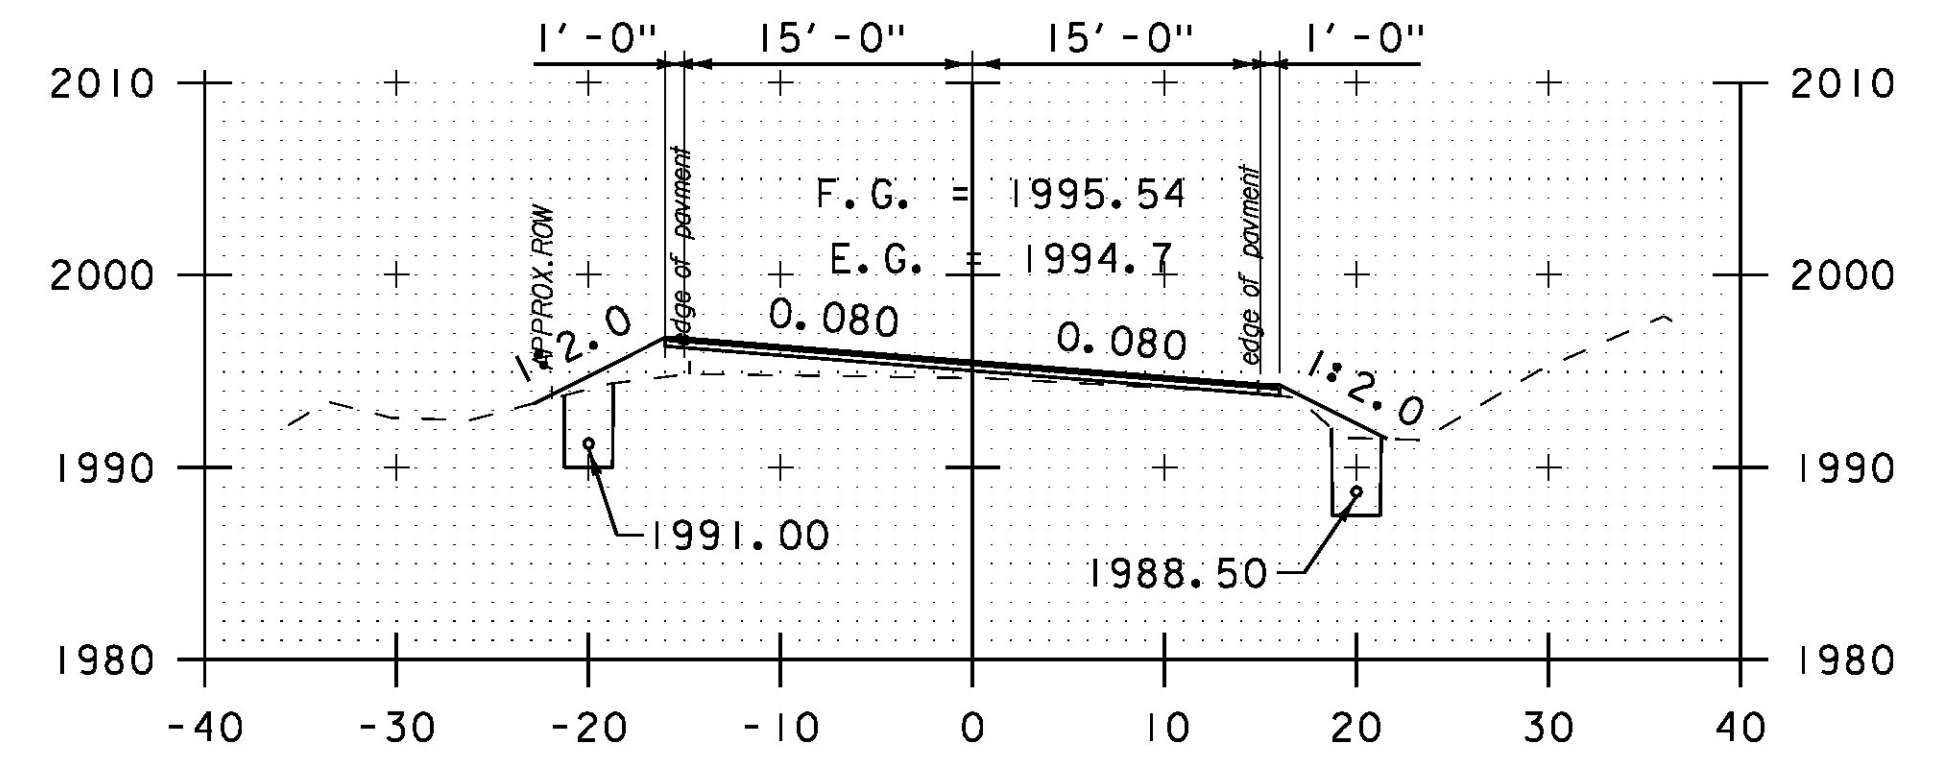


73+00

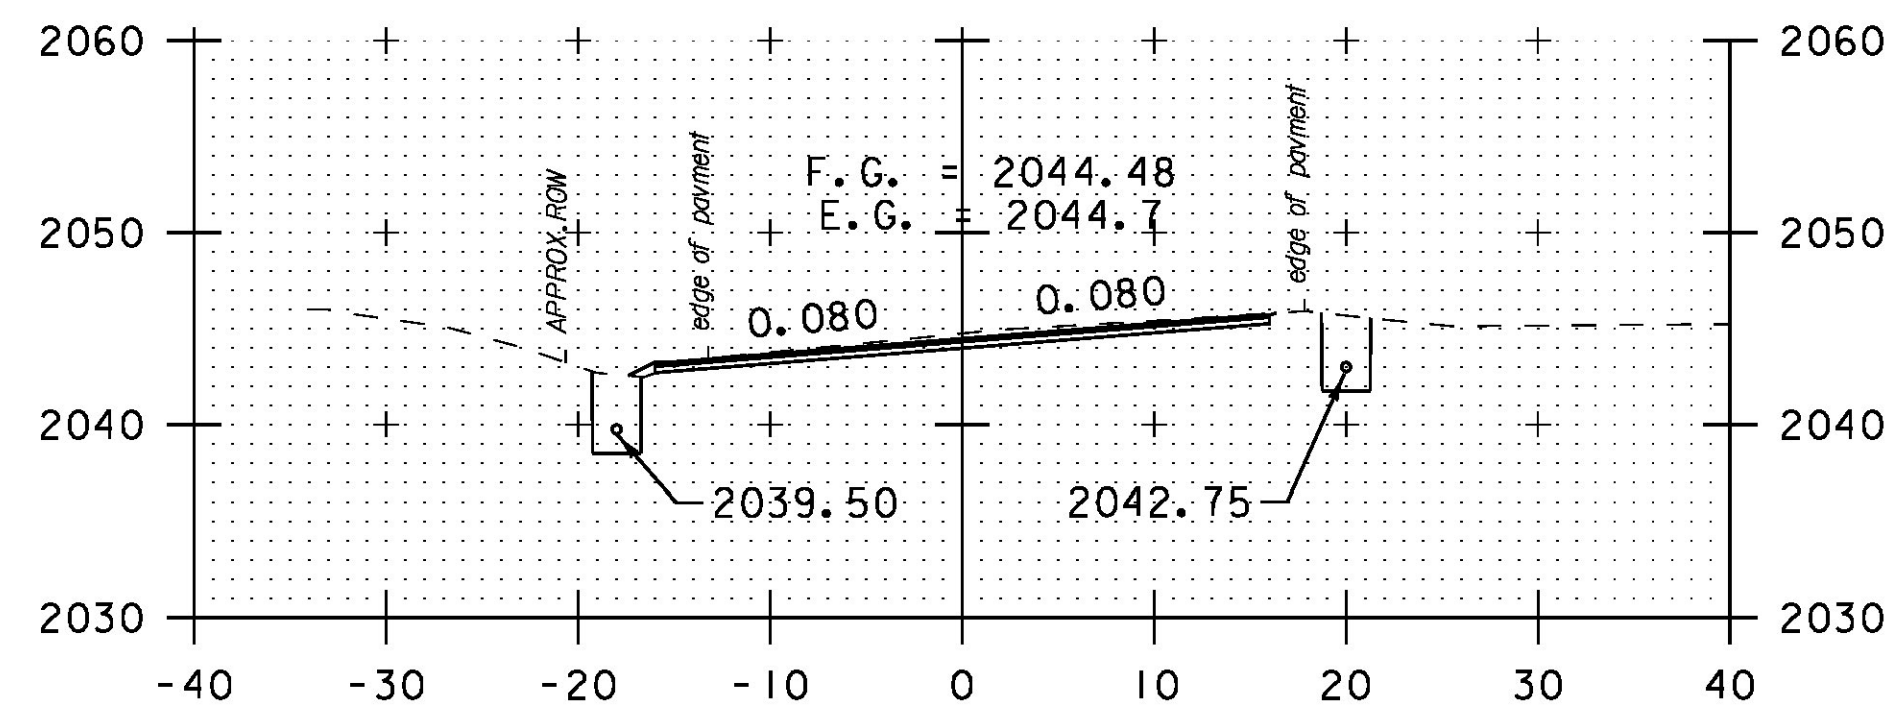


69+50

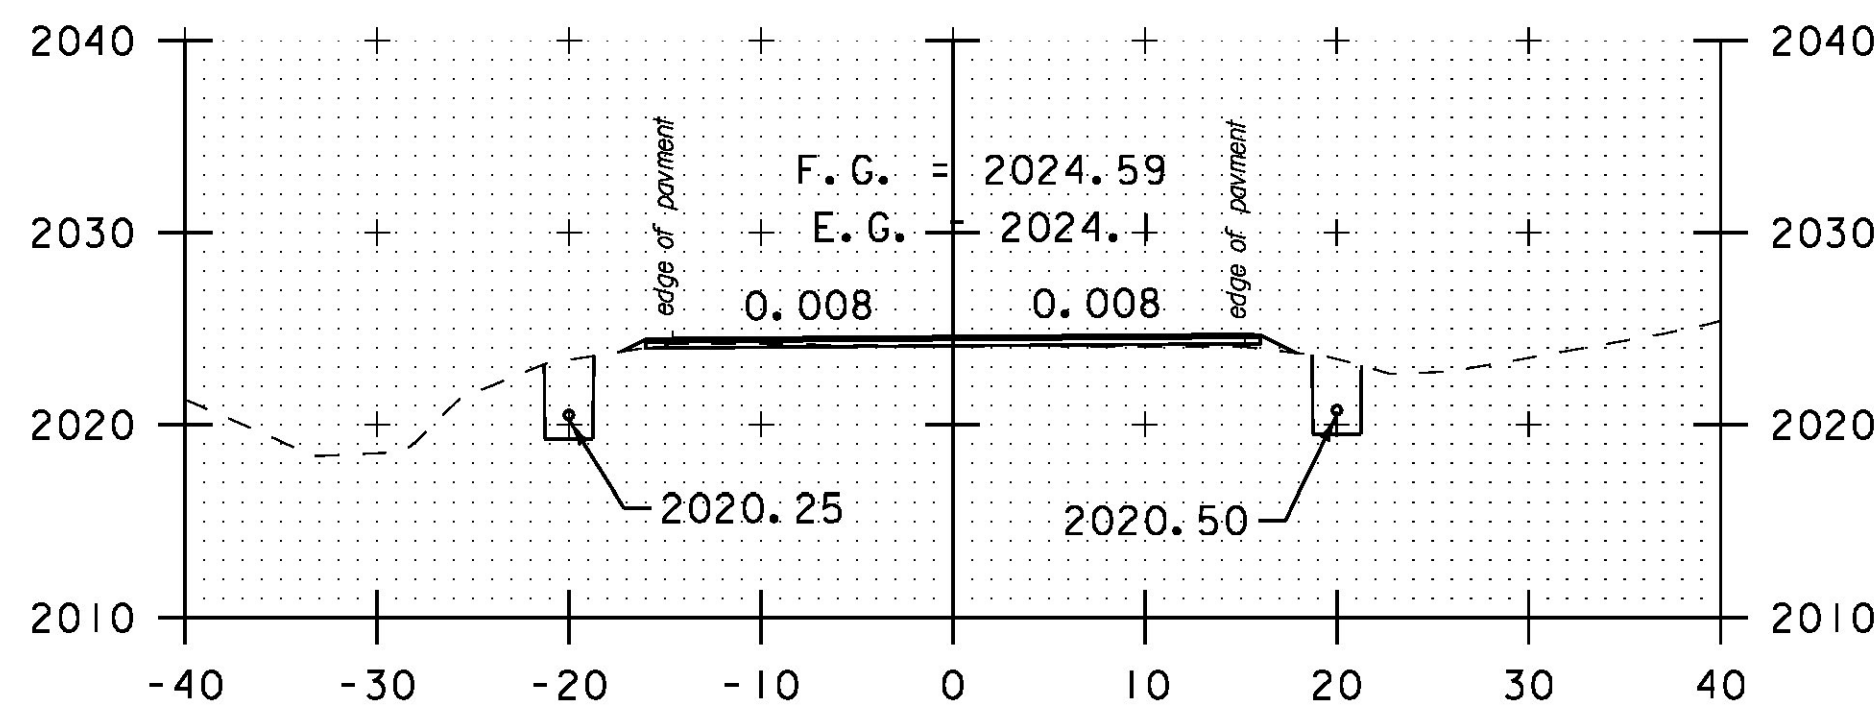


71+00

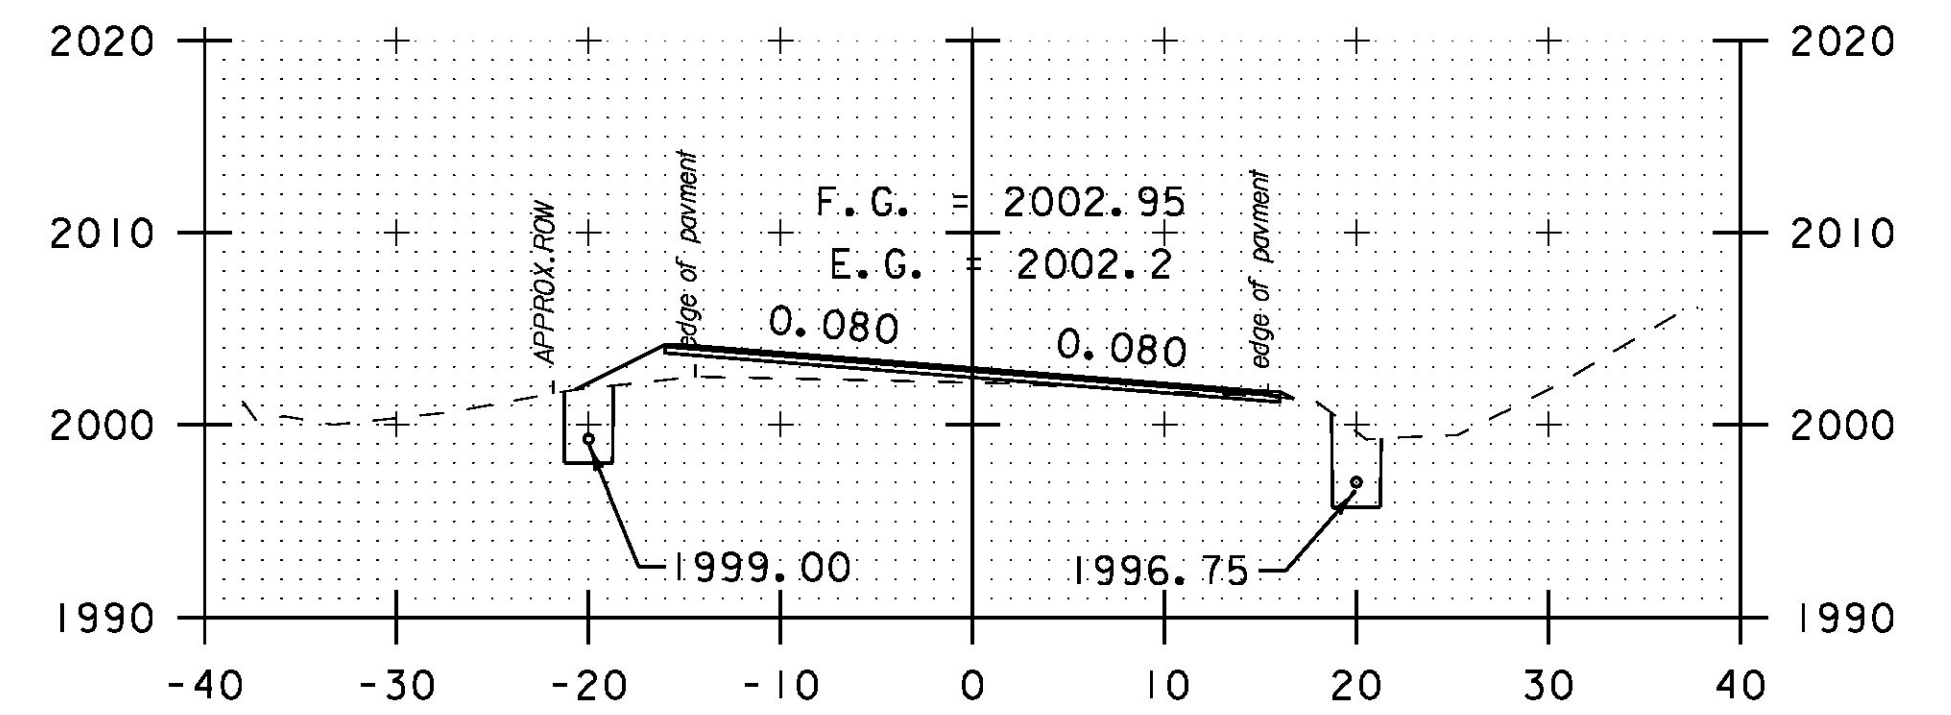


72+50

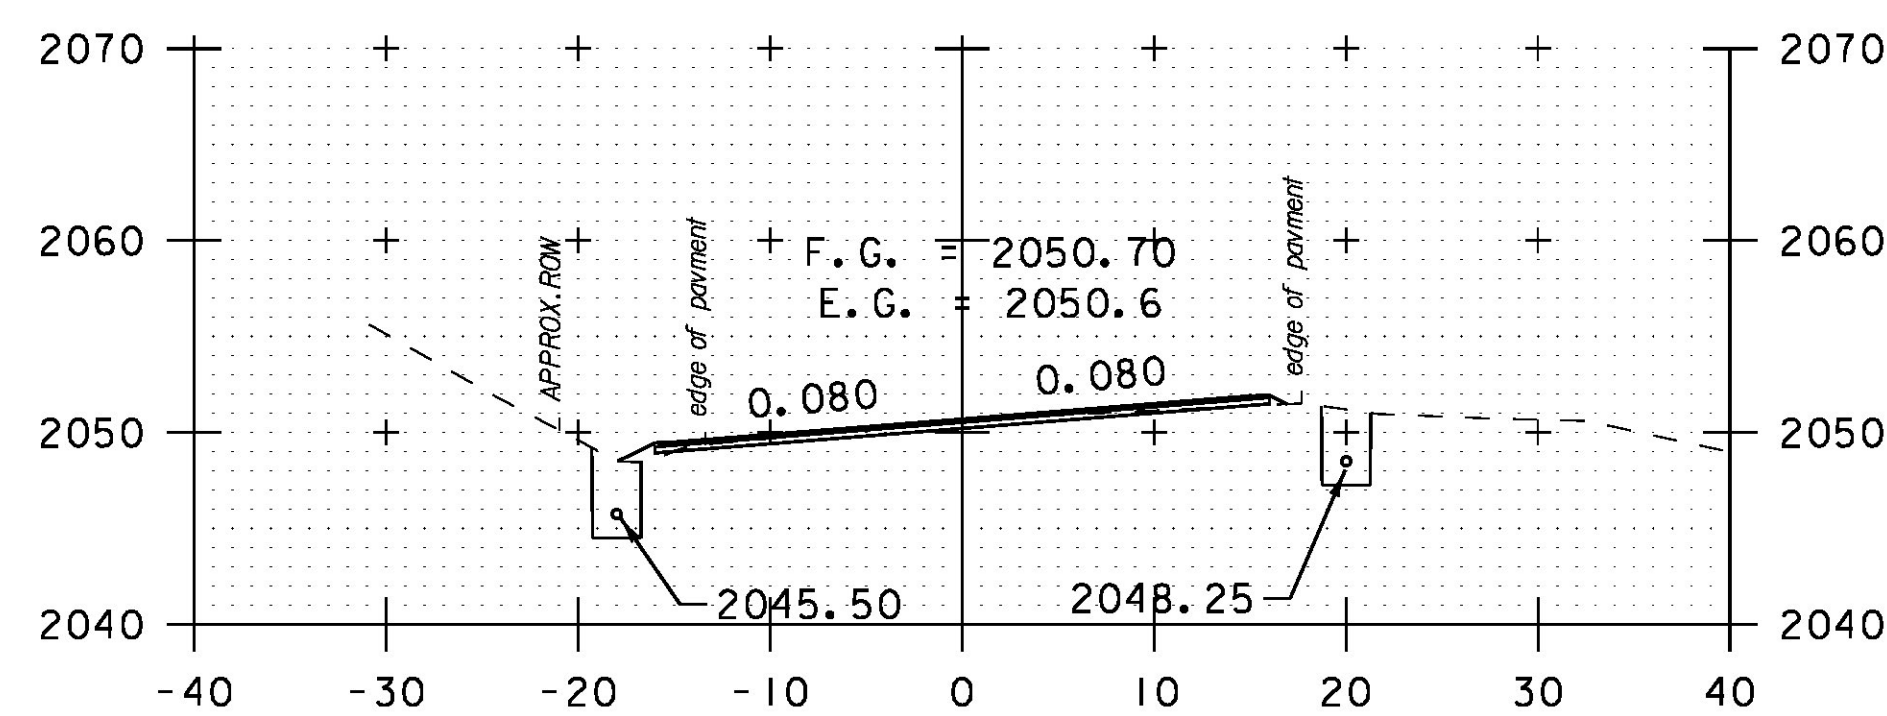

69+00

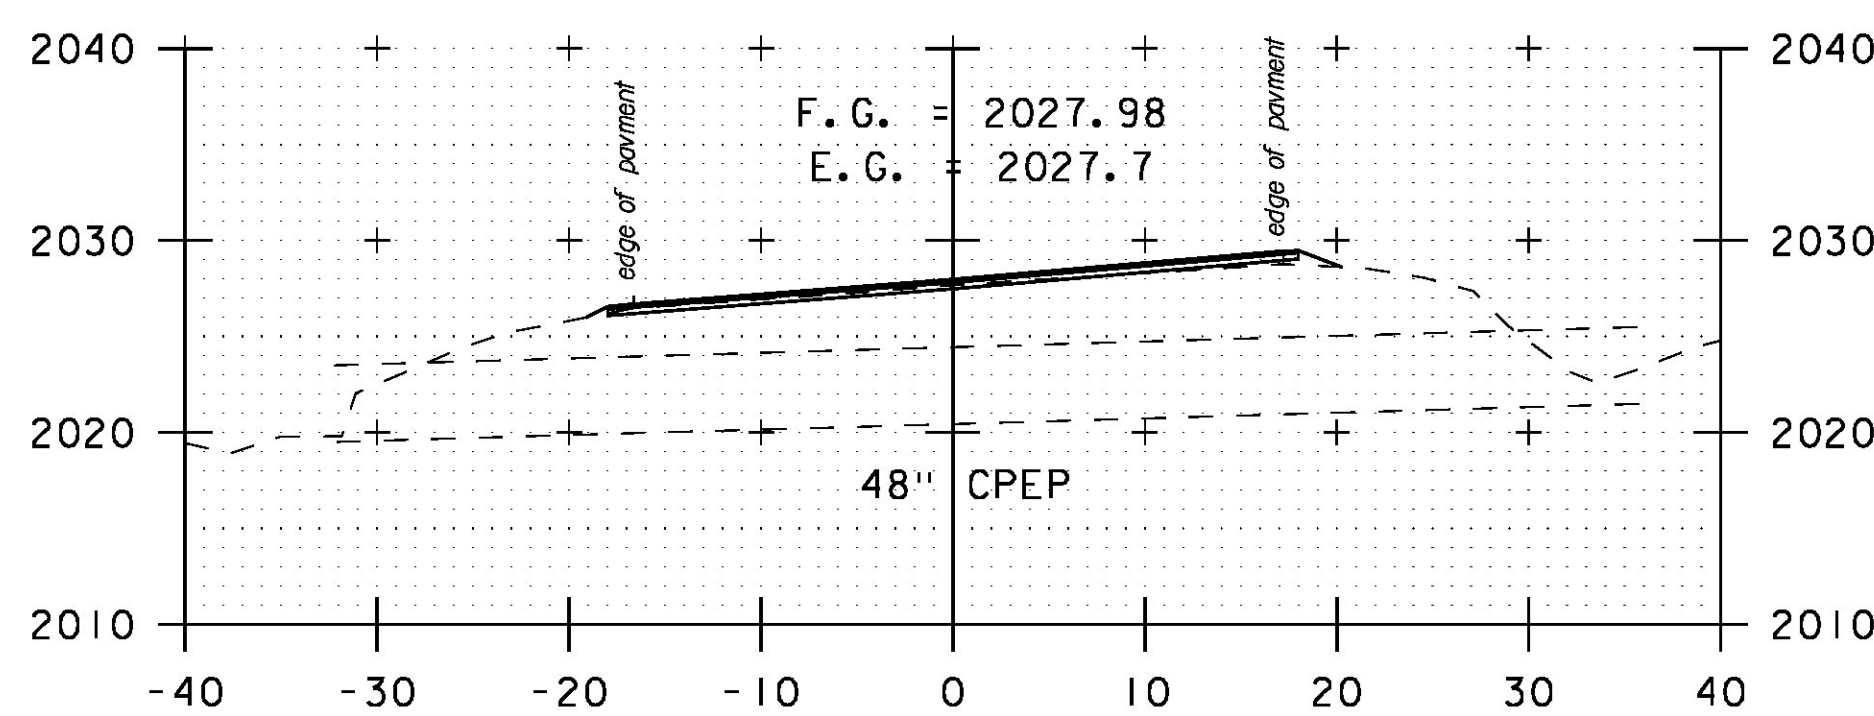

70+75

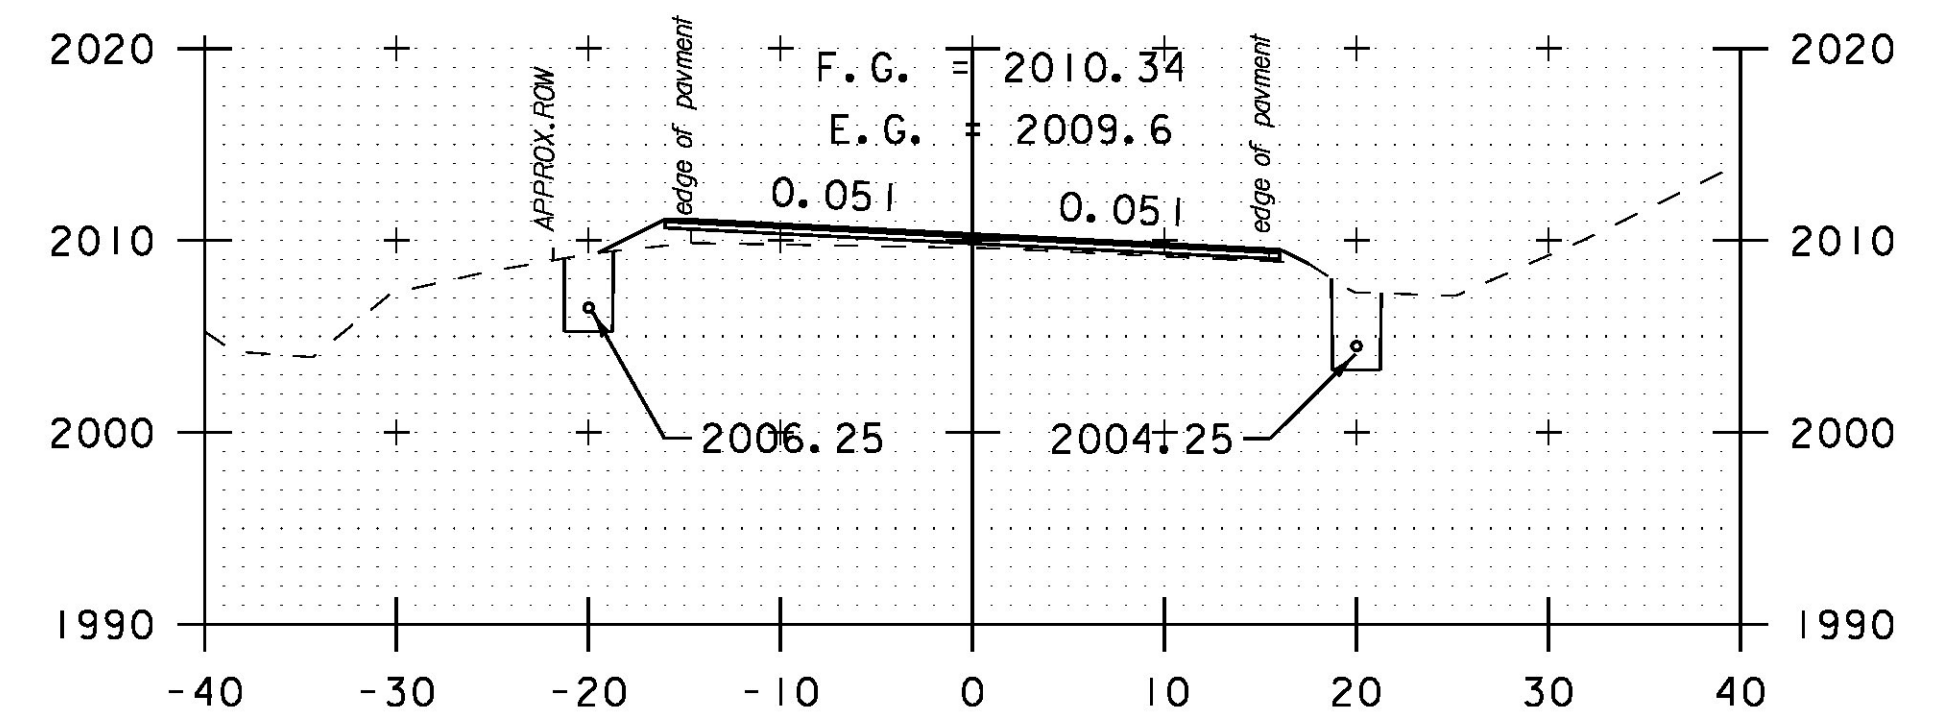

72+00



PROJECT NAME:	HANCOCK	PLOT DATE:	3/18/2015
PROJECT NUMBER:	STP 2923 (1)	DRAWN BY:	B. MARTIN
FILE NAME:	z10c252xs.dgn	DESIGNED BY:	B. MARTIN
PROJECT LEADER:	C. LATHROP	CHECKED BY:	C. LATHROP
CROSS SECTION SHEET:	7	SHEET:	134 OF 207