




74+50

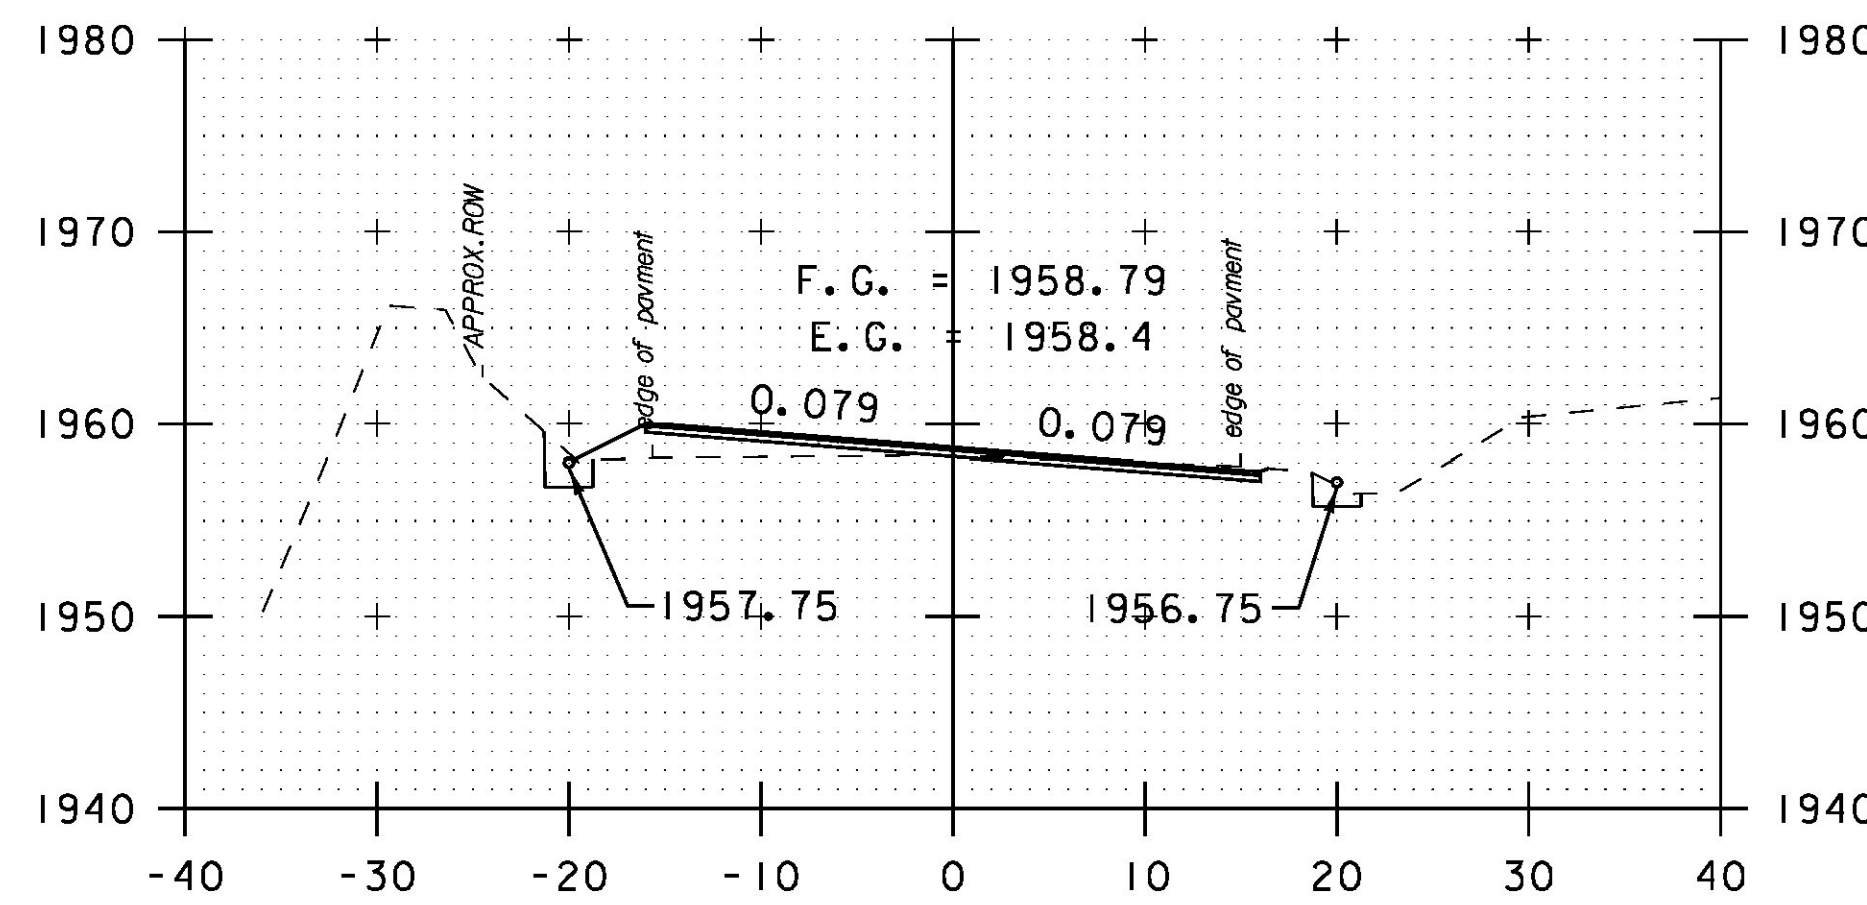


76+00

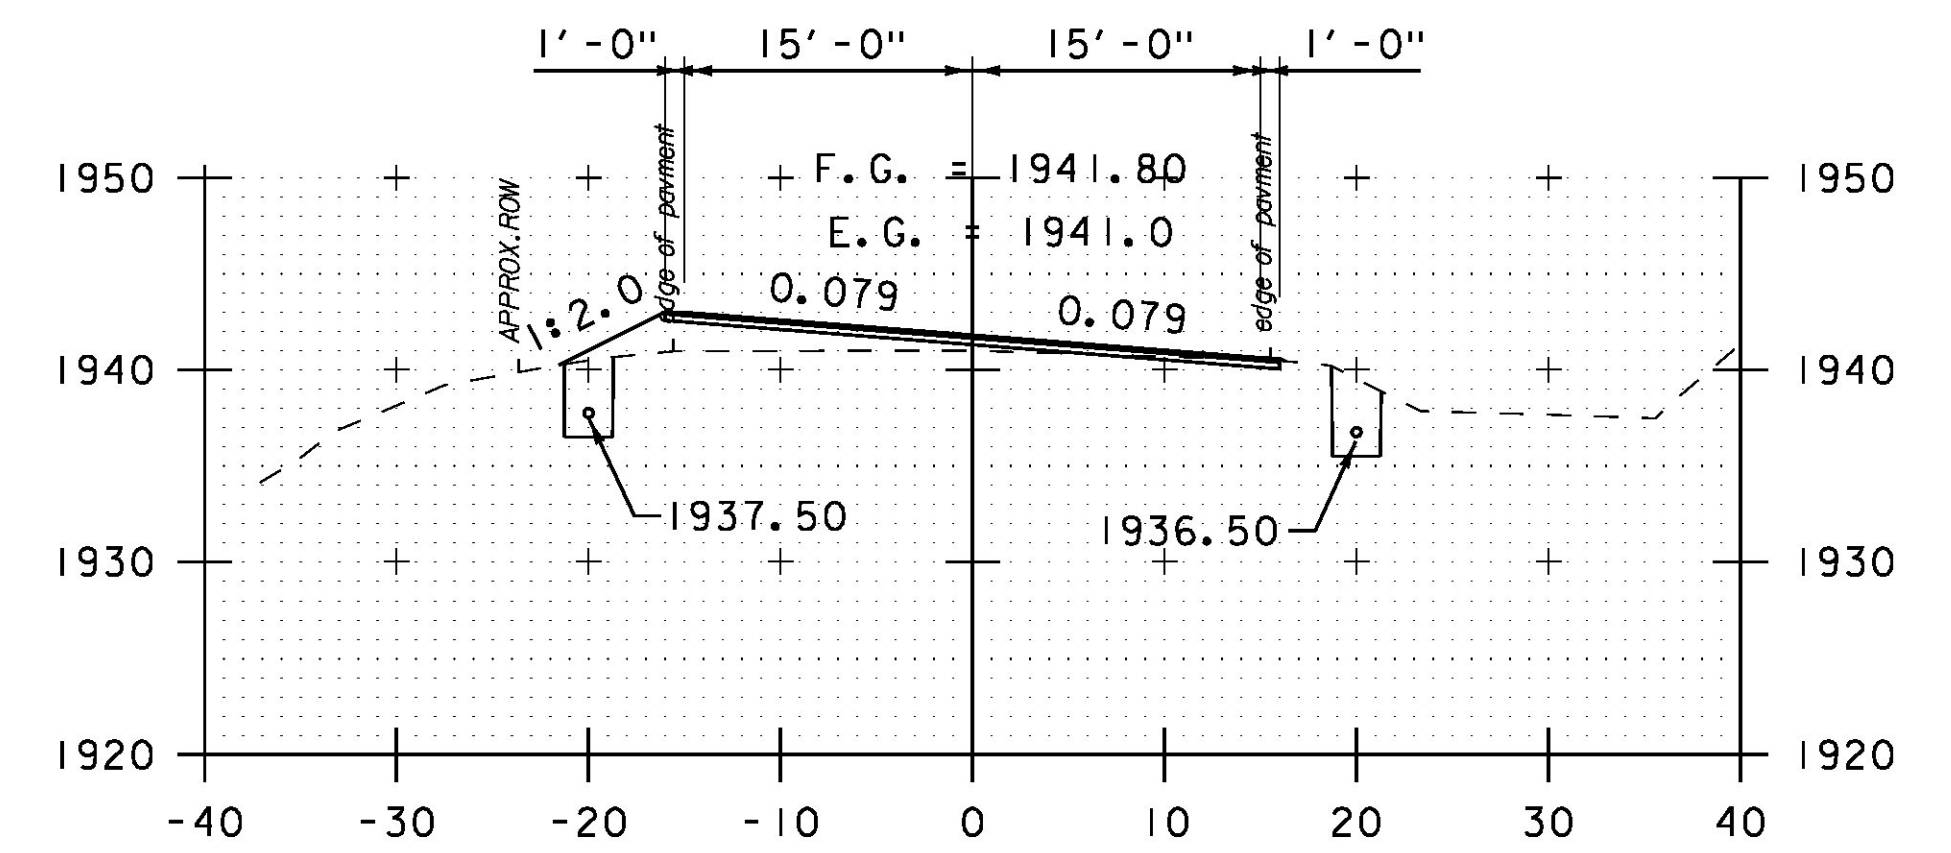


77+50

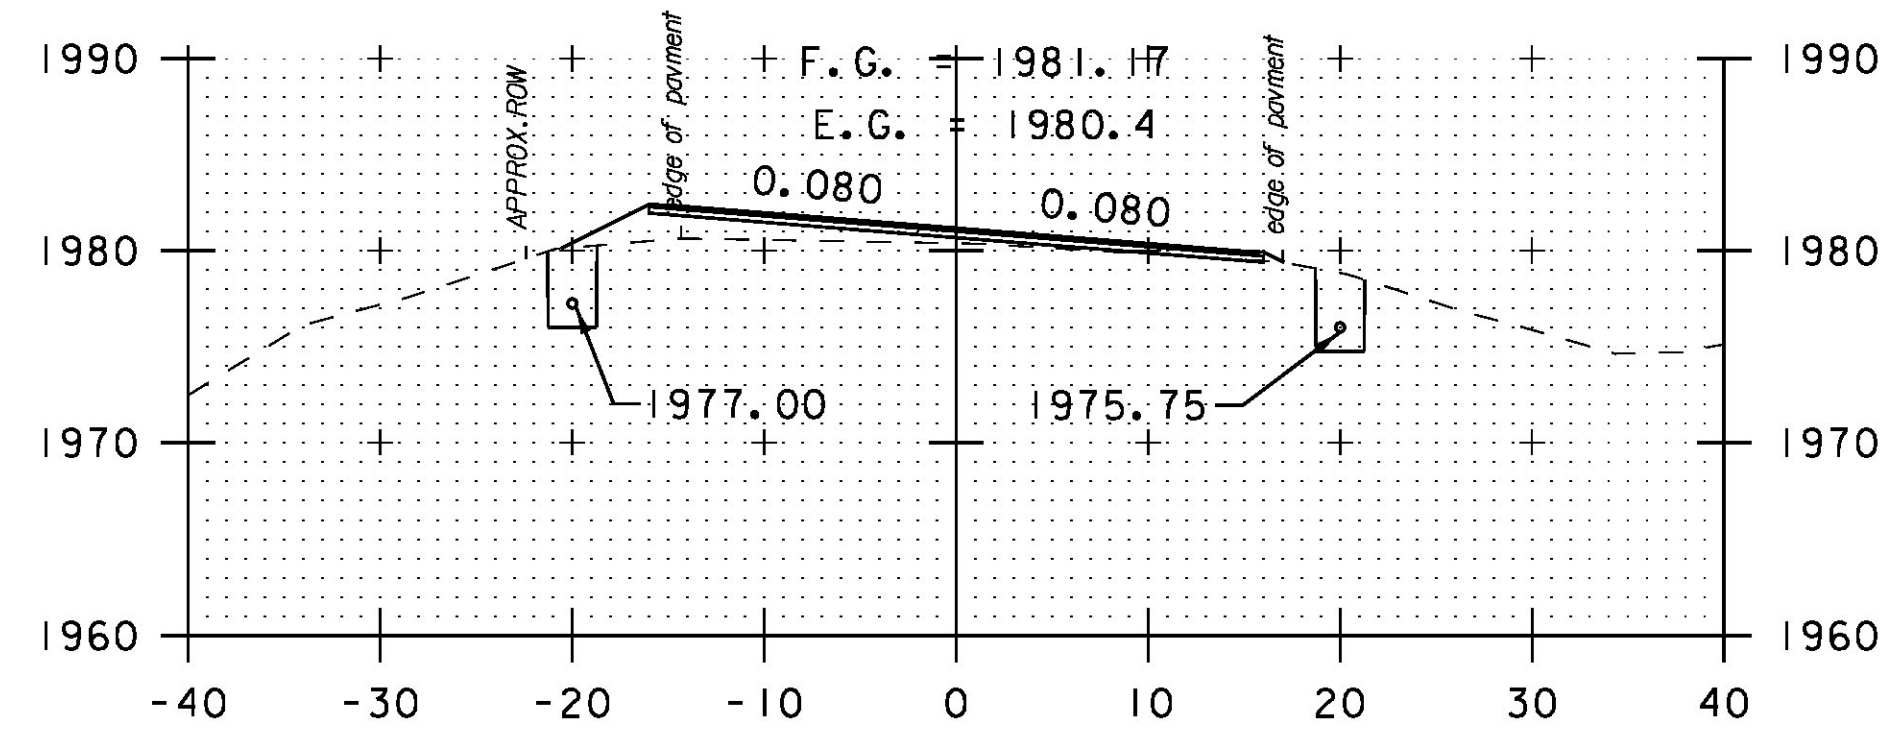


74+00

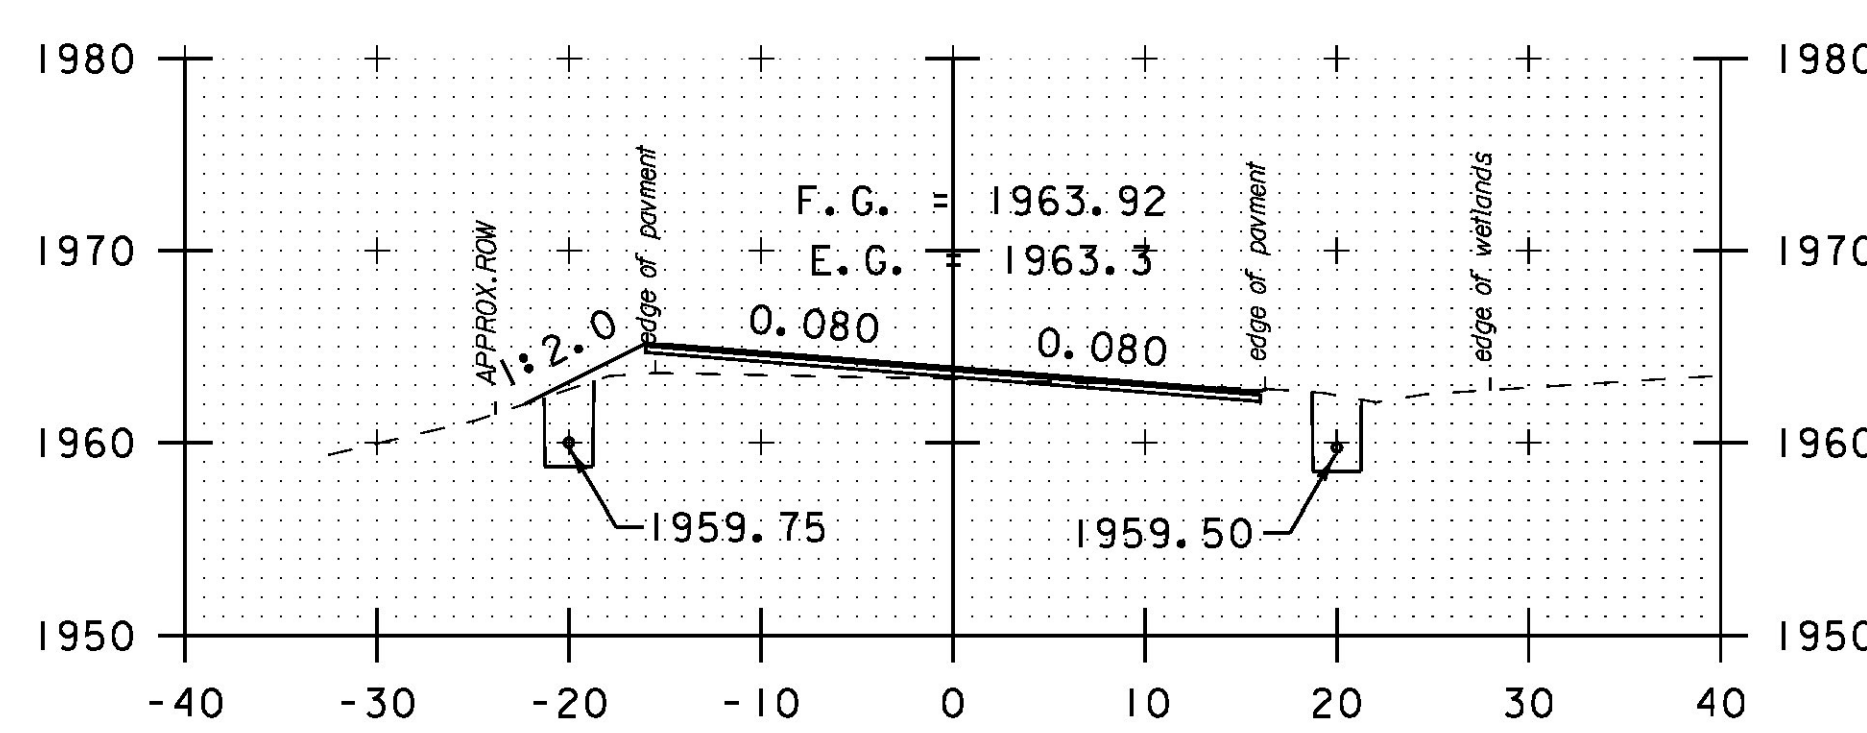


75+50

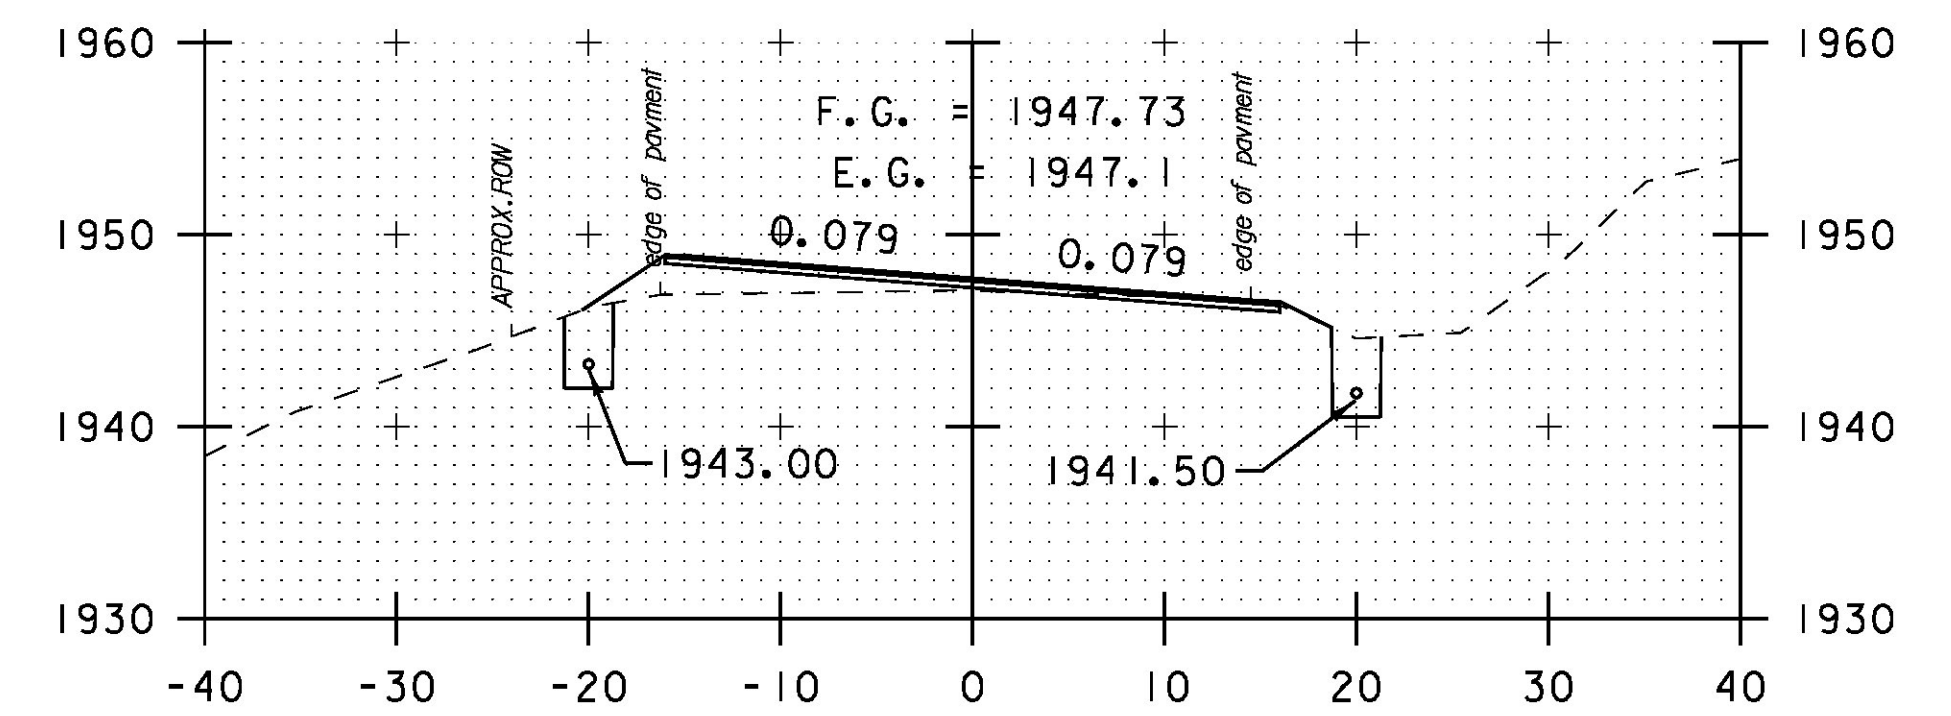


77+00

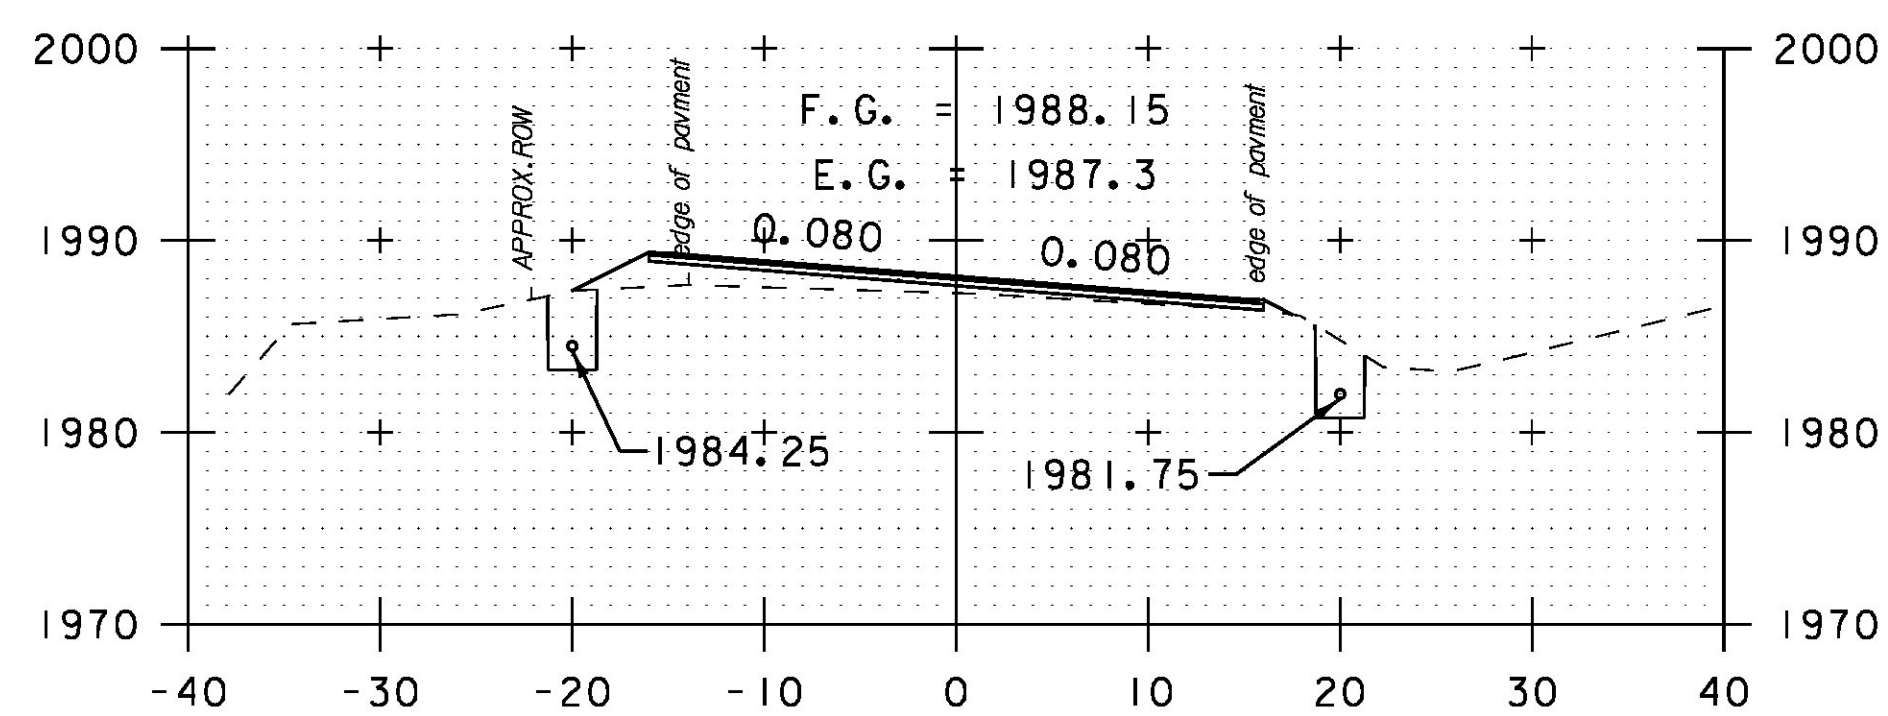

73+50

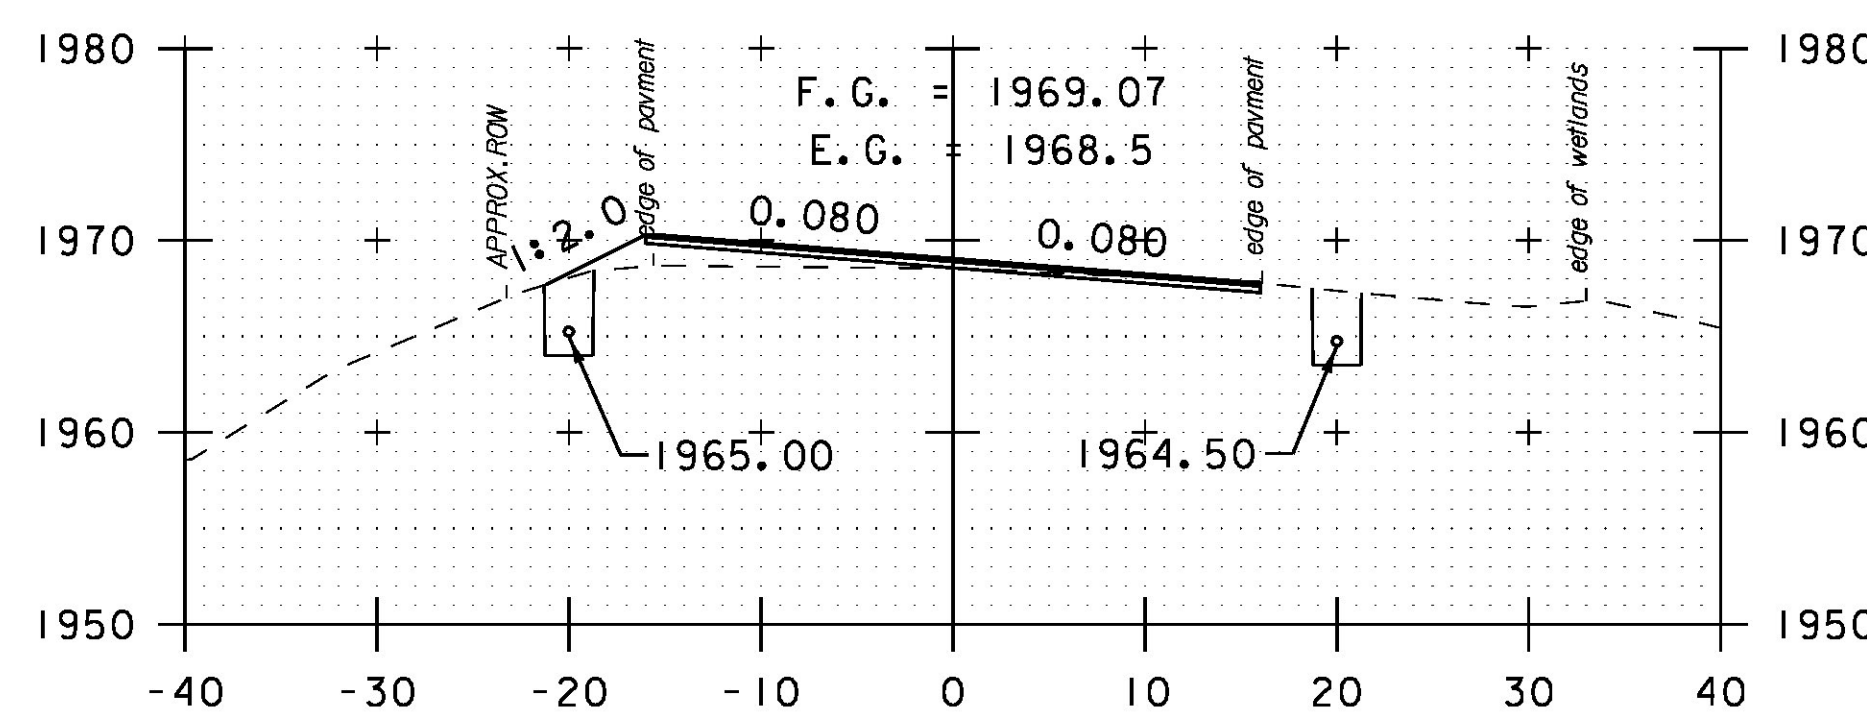

75+00

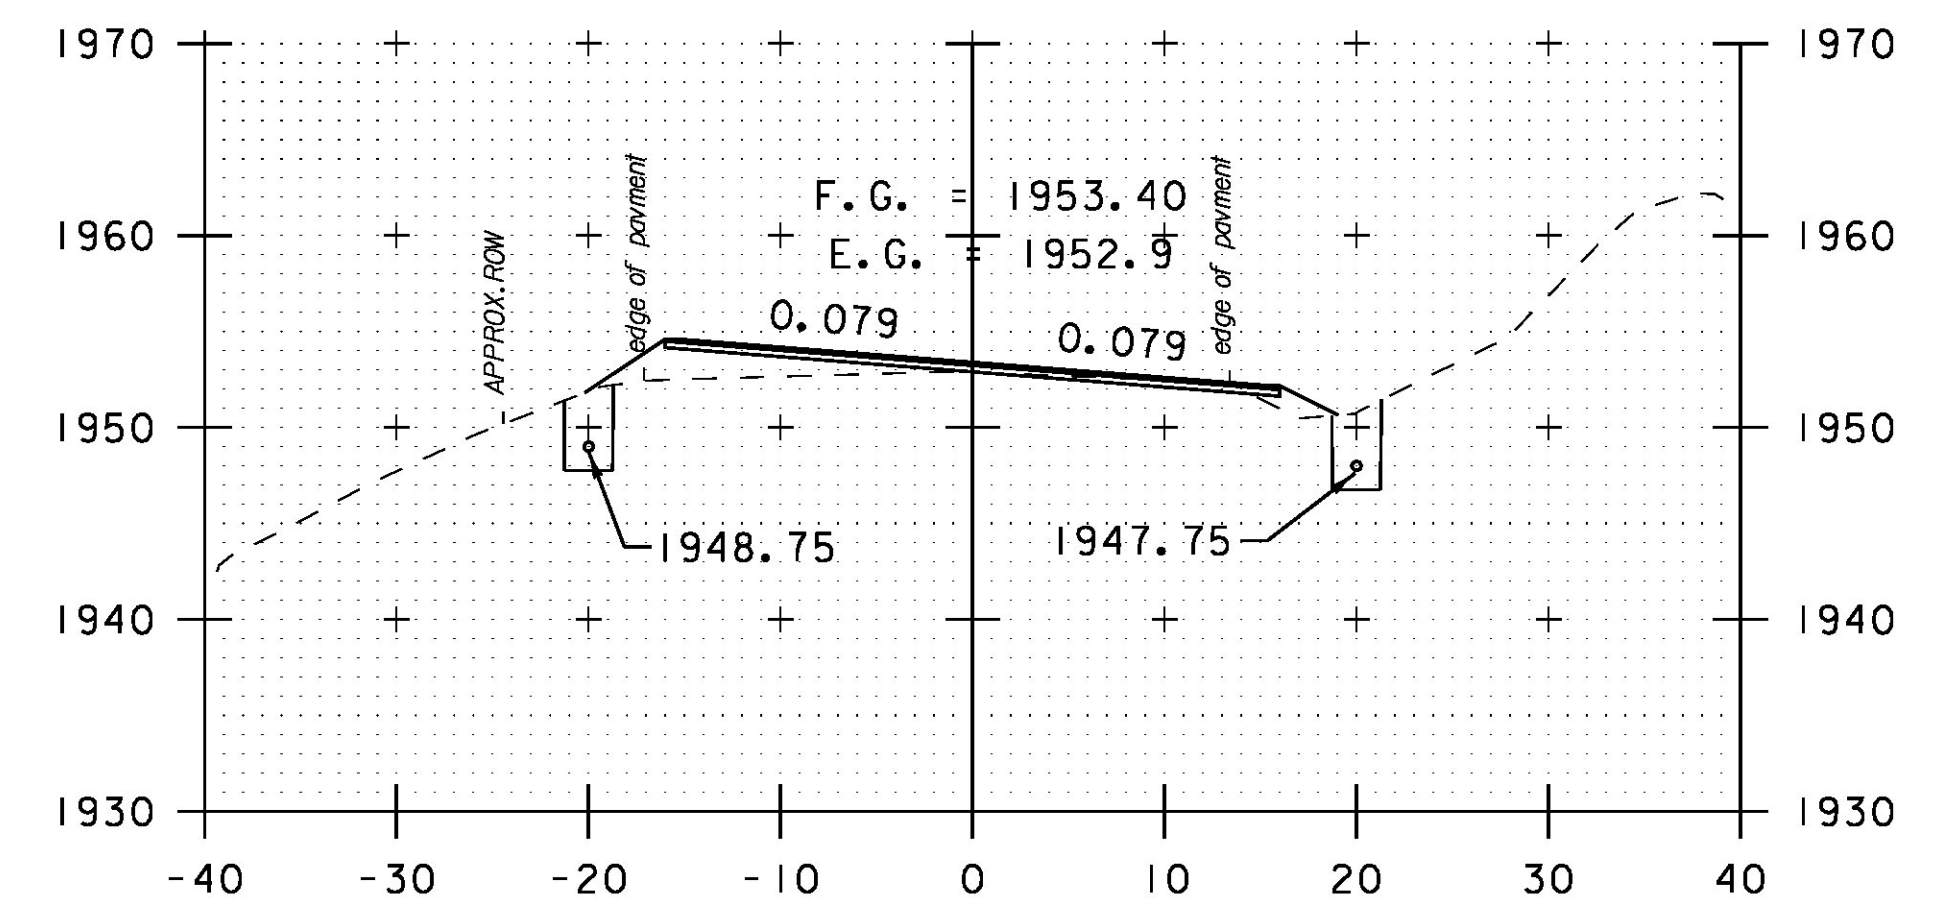

76+50



PROJECT NAME:	HANCOCK
PROJECT NUMBER:	STP 2923 (1)
FILE NAME:	z10c252xs.dgn
PROJECT LEADER:	C. LATHROP
DESIGNED BY:	B. MARTIN
CROSS SECTION SHEET:	8
PLOT DATE:	3/18/2015
DRAWN BY:	B. MARTIN
CHECKED BY:	C. LATHROP
SHEET:	135 OF 207