




79+50

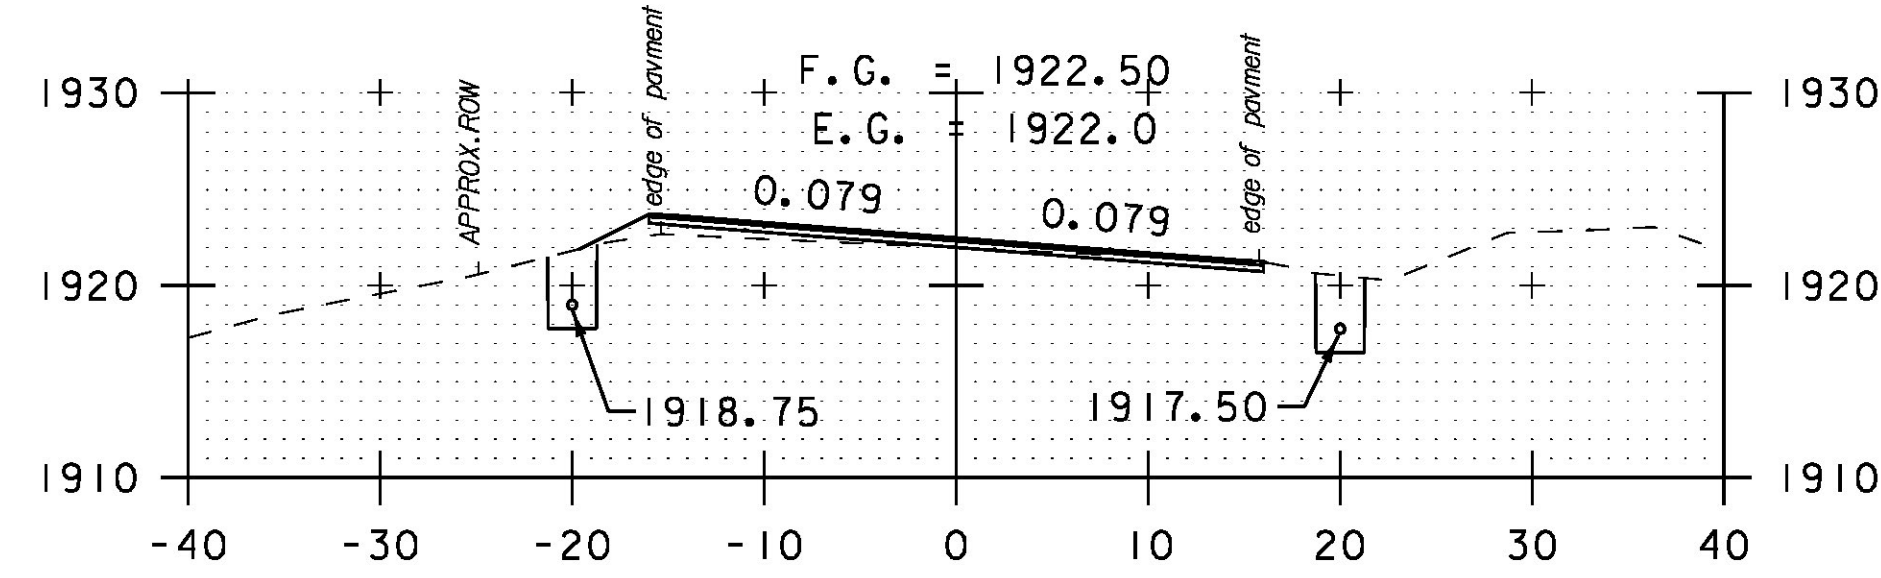


79+00

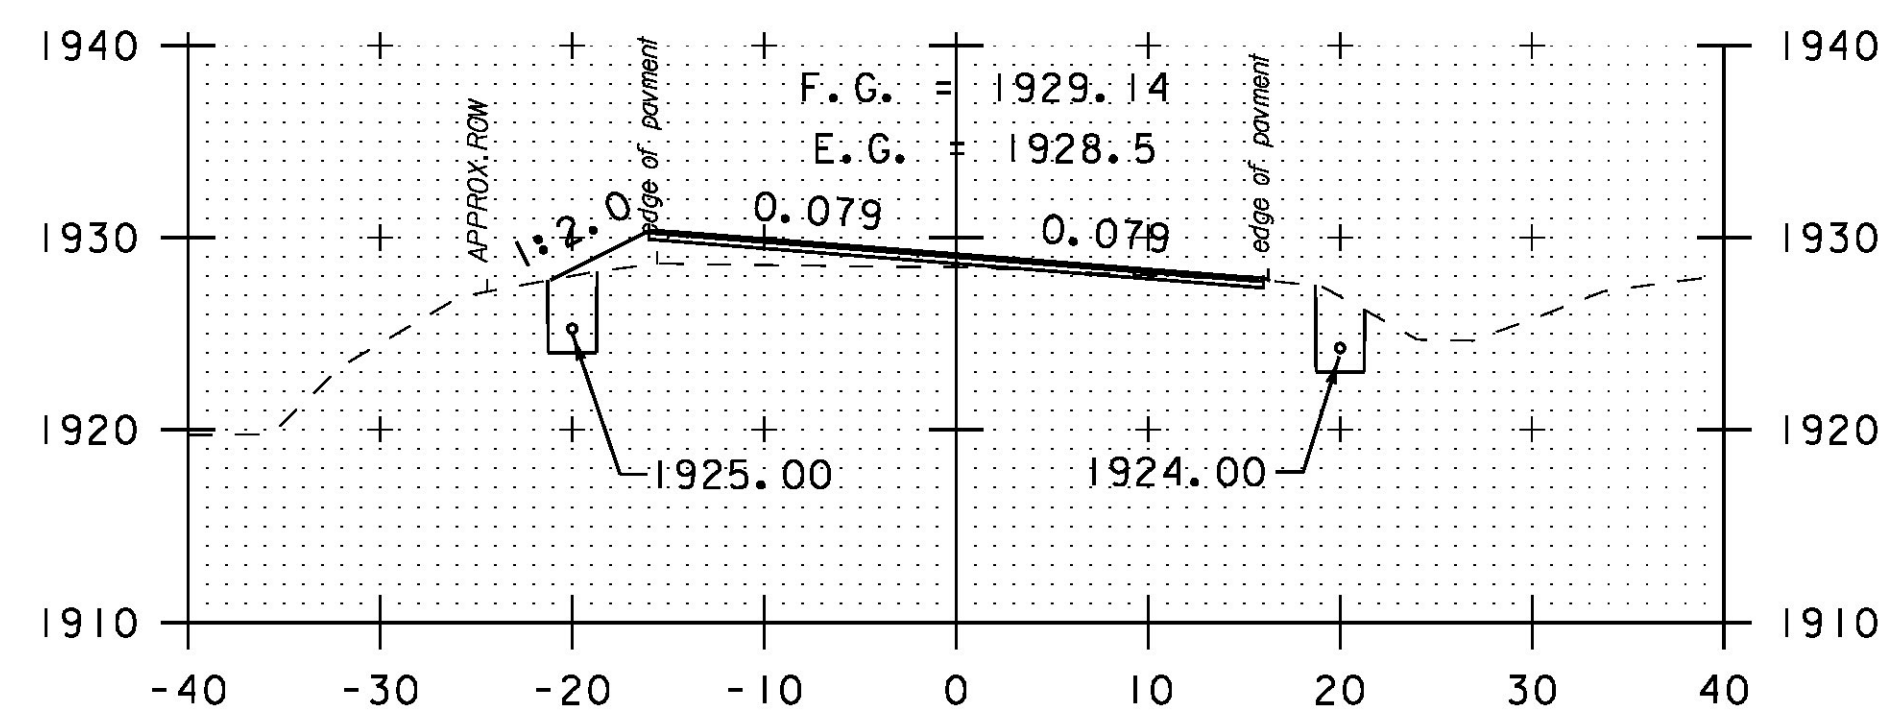


78+50

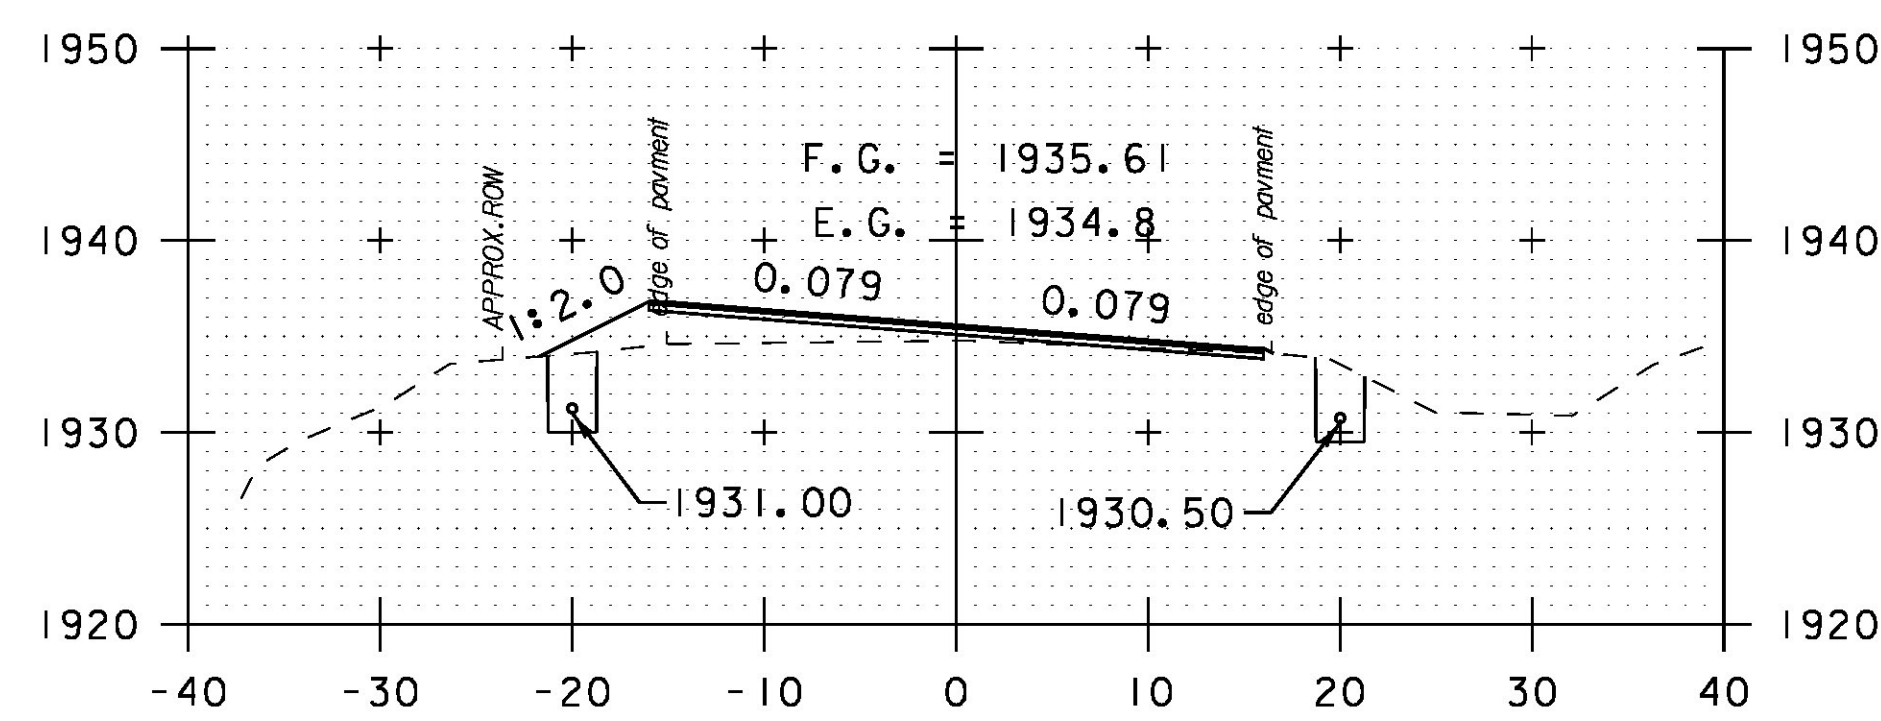


78+00

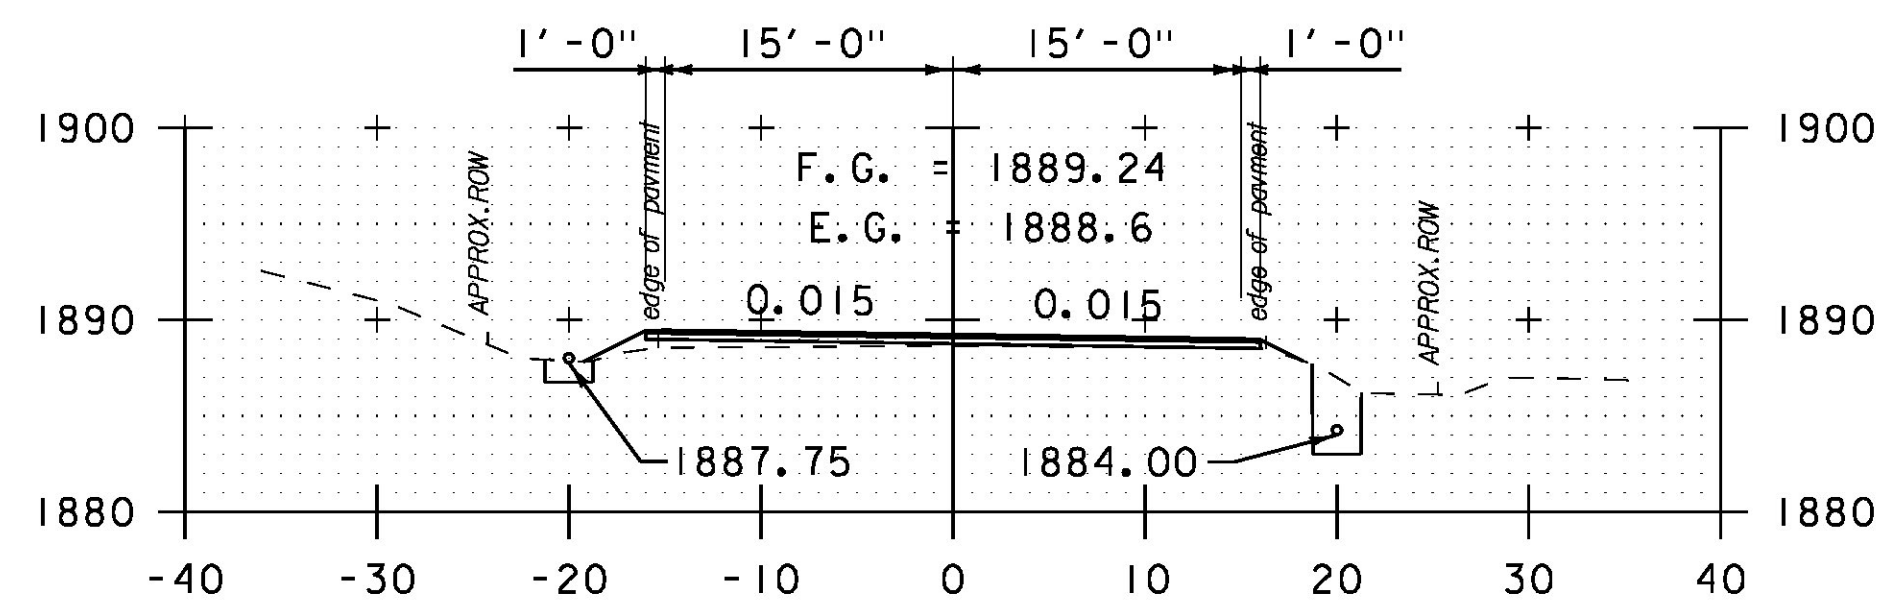


81+50

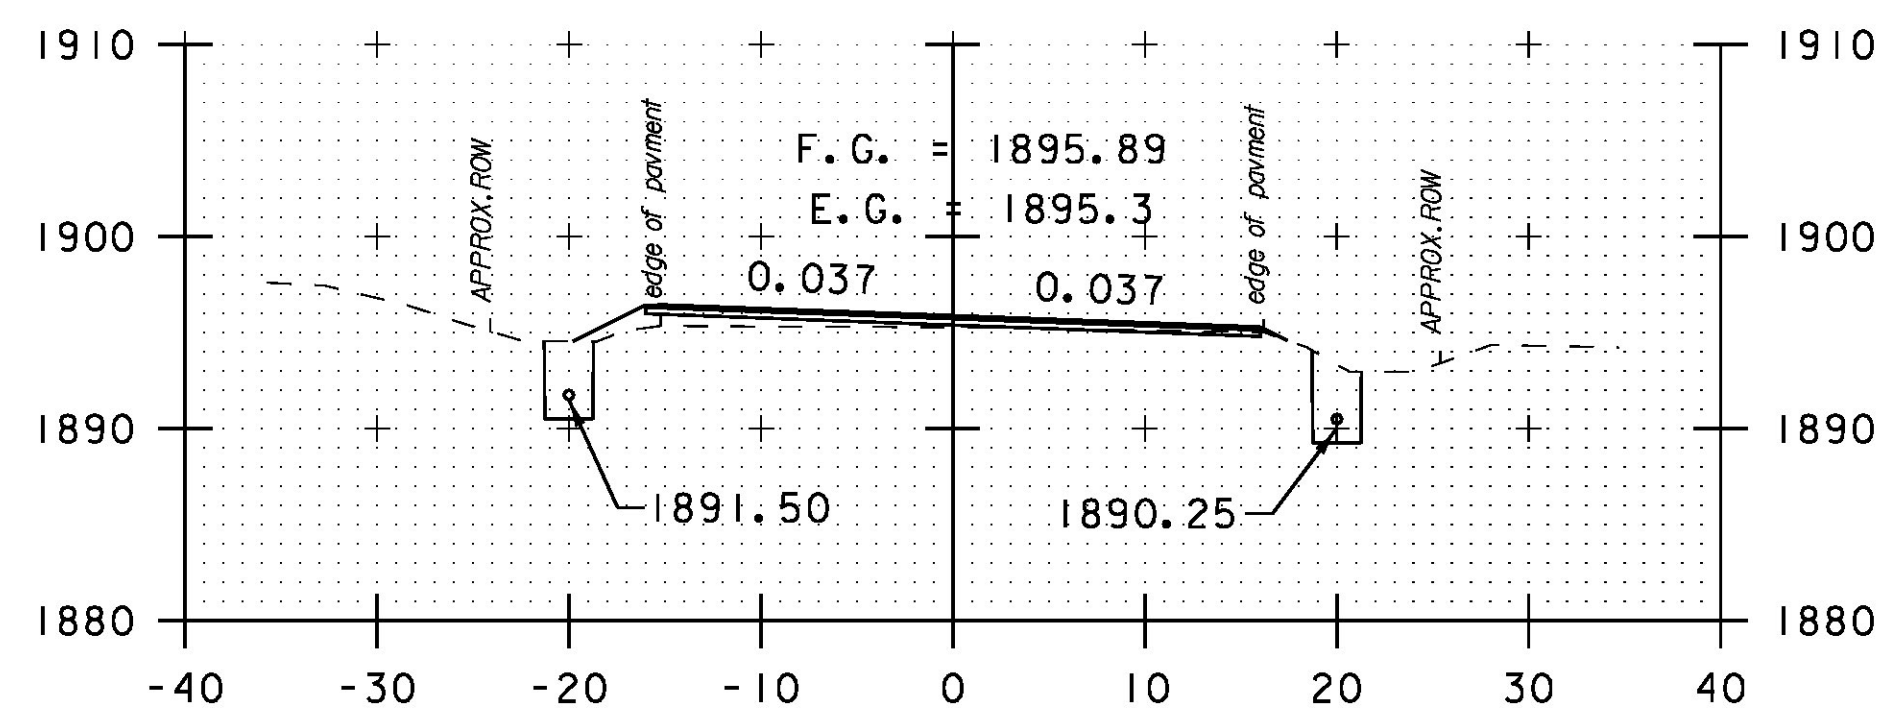


81+00

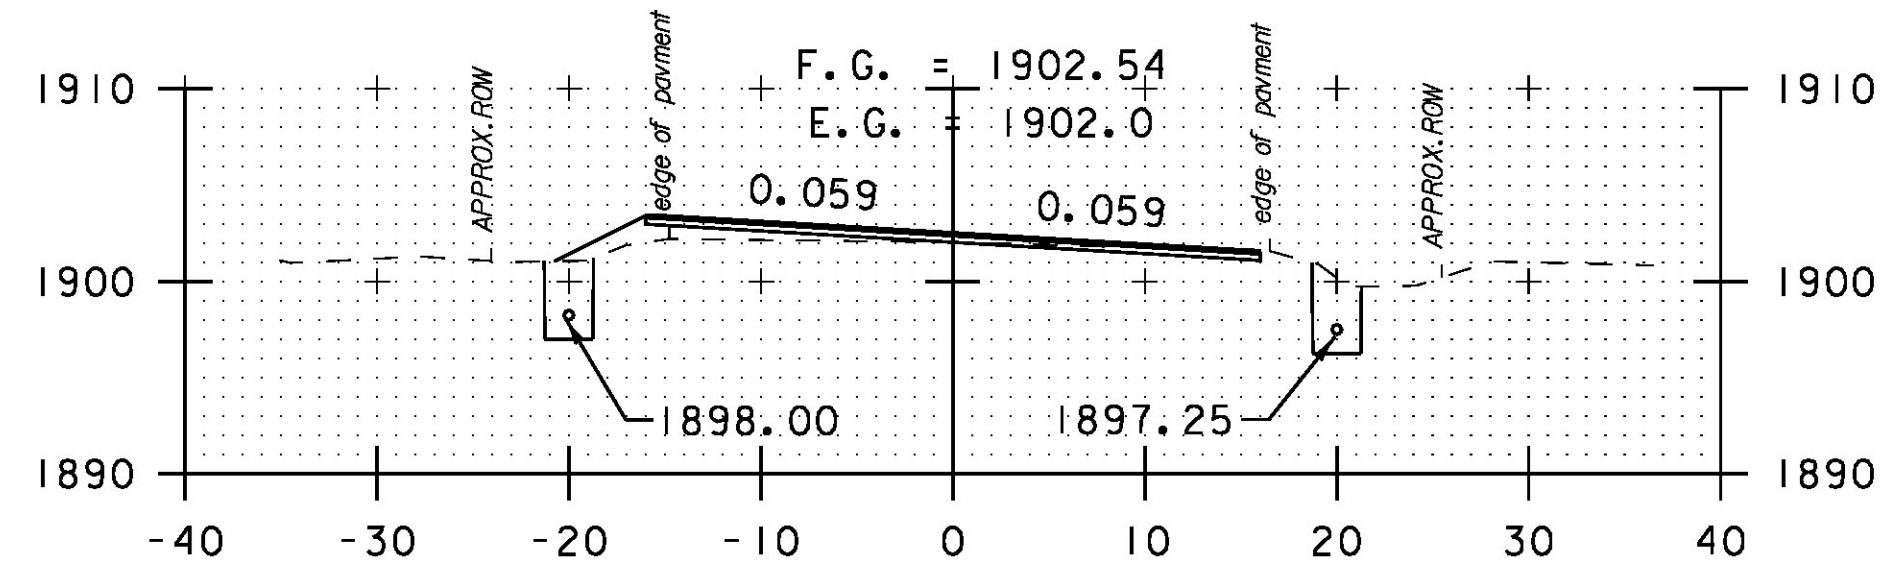


80+50

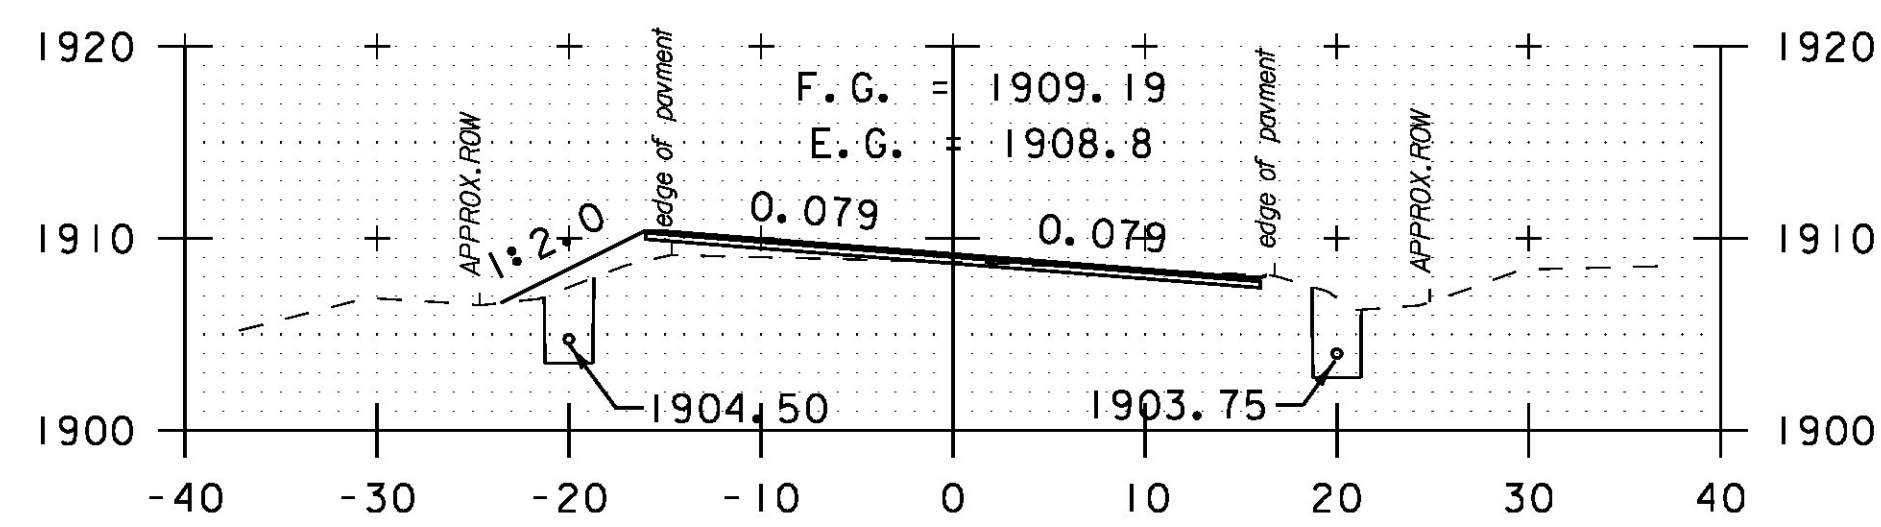


80+00

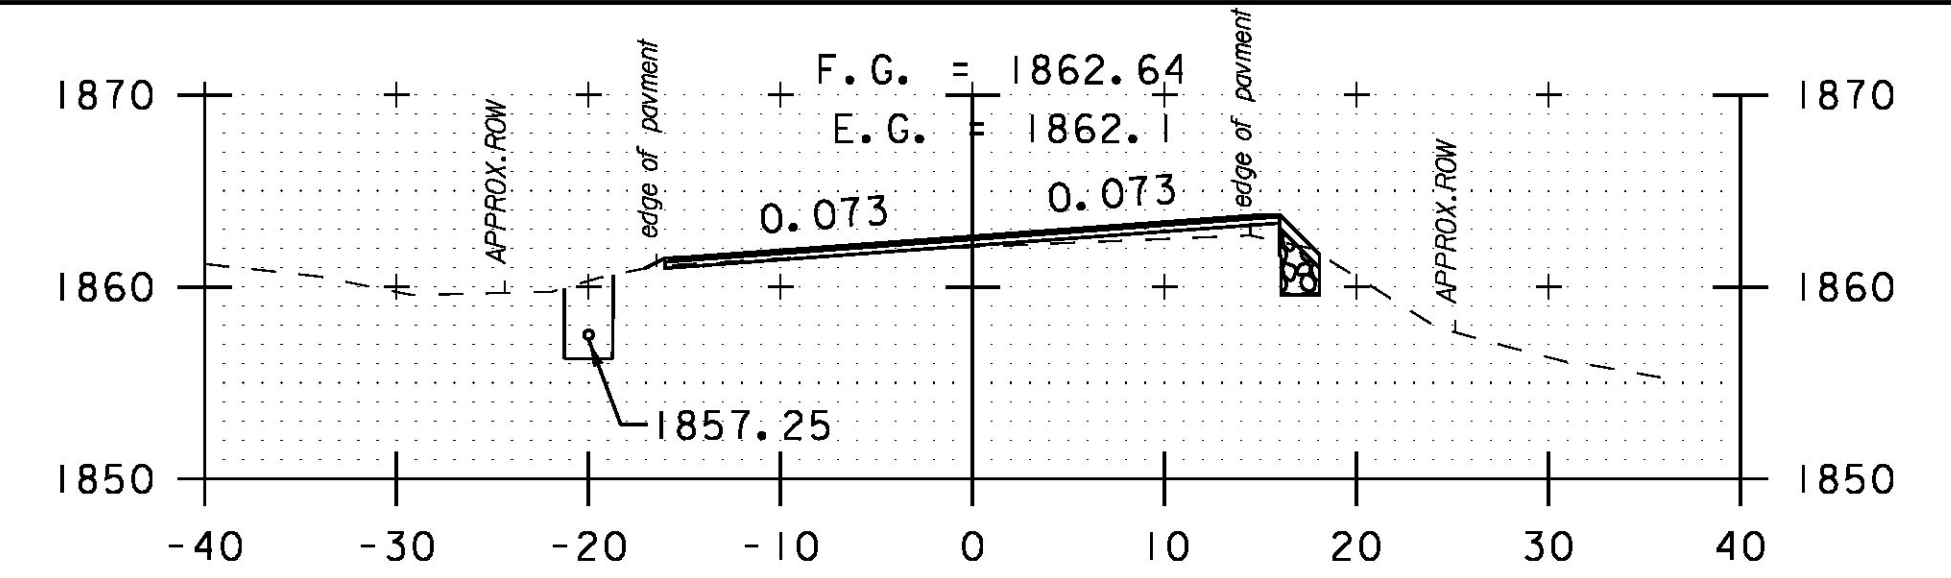


83+50

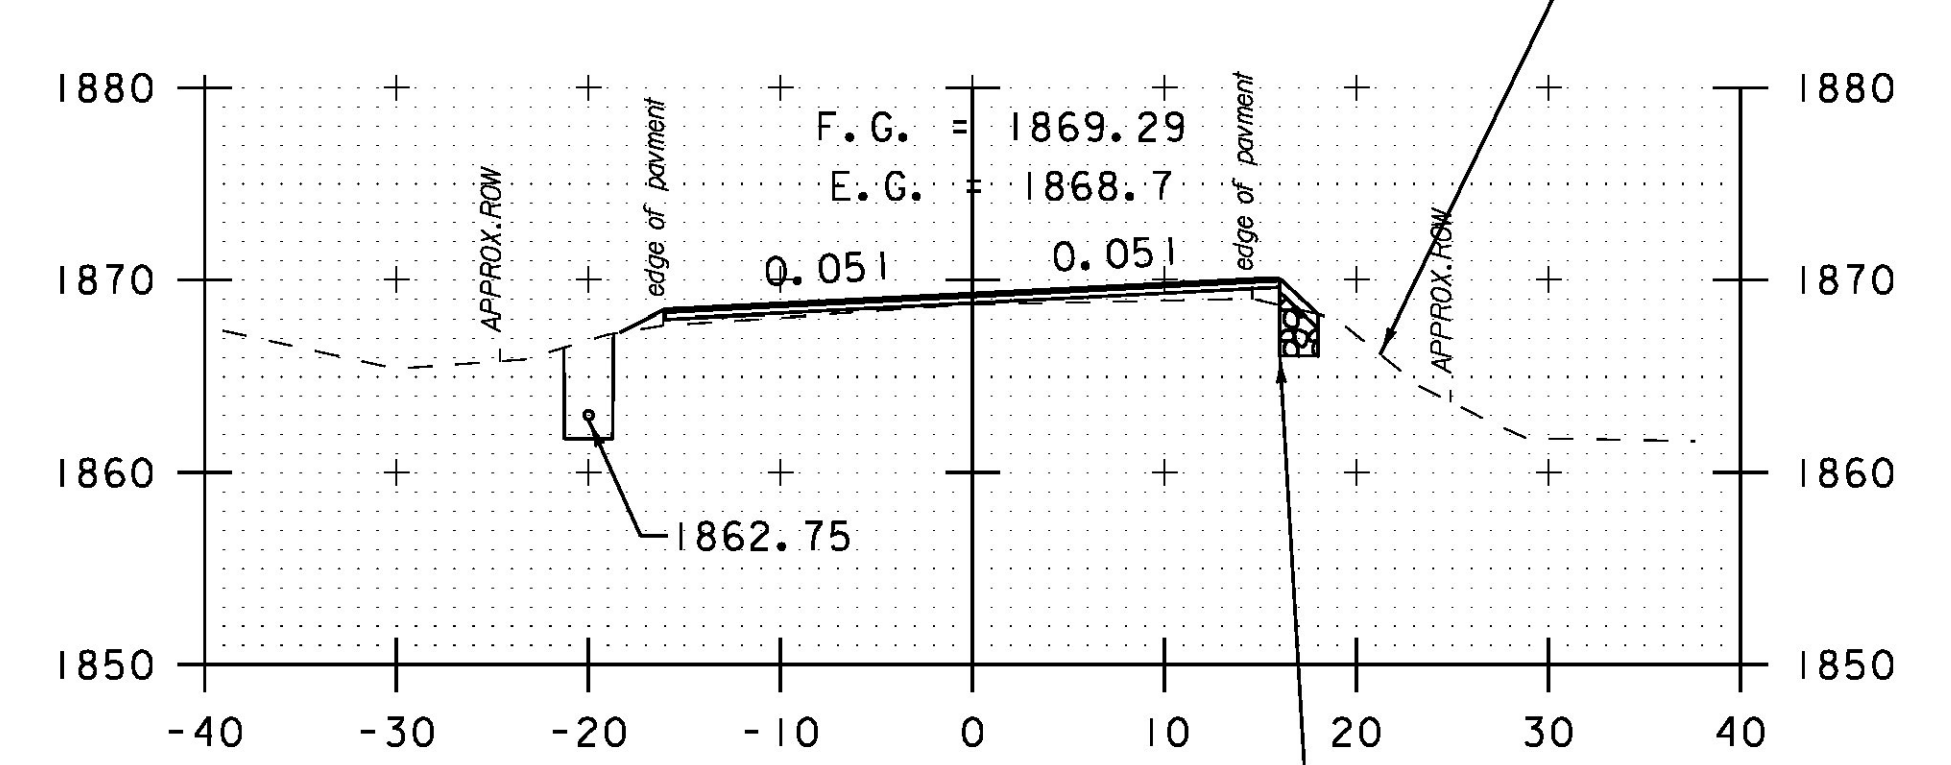

83+00

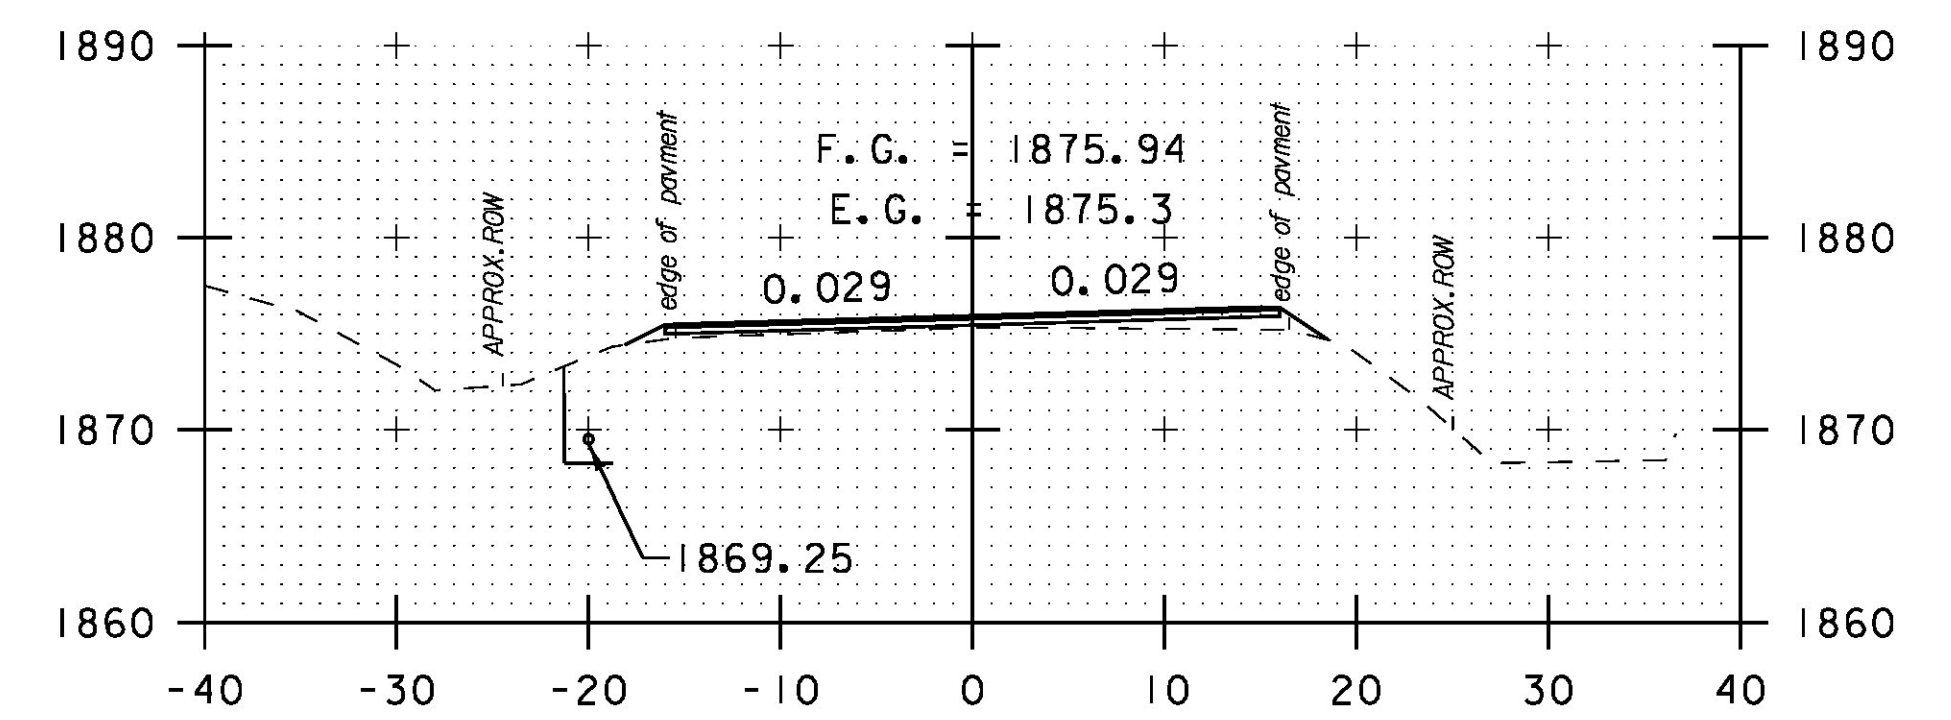

82+50

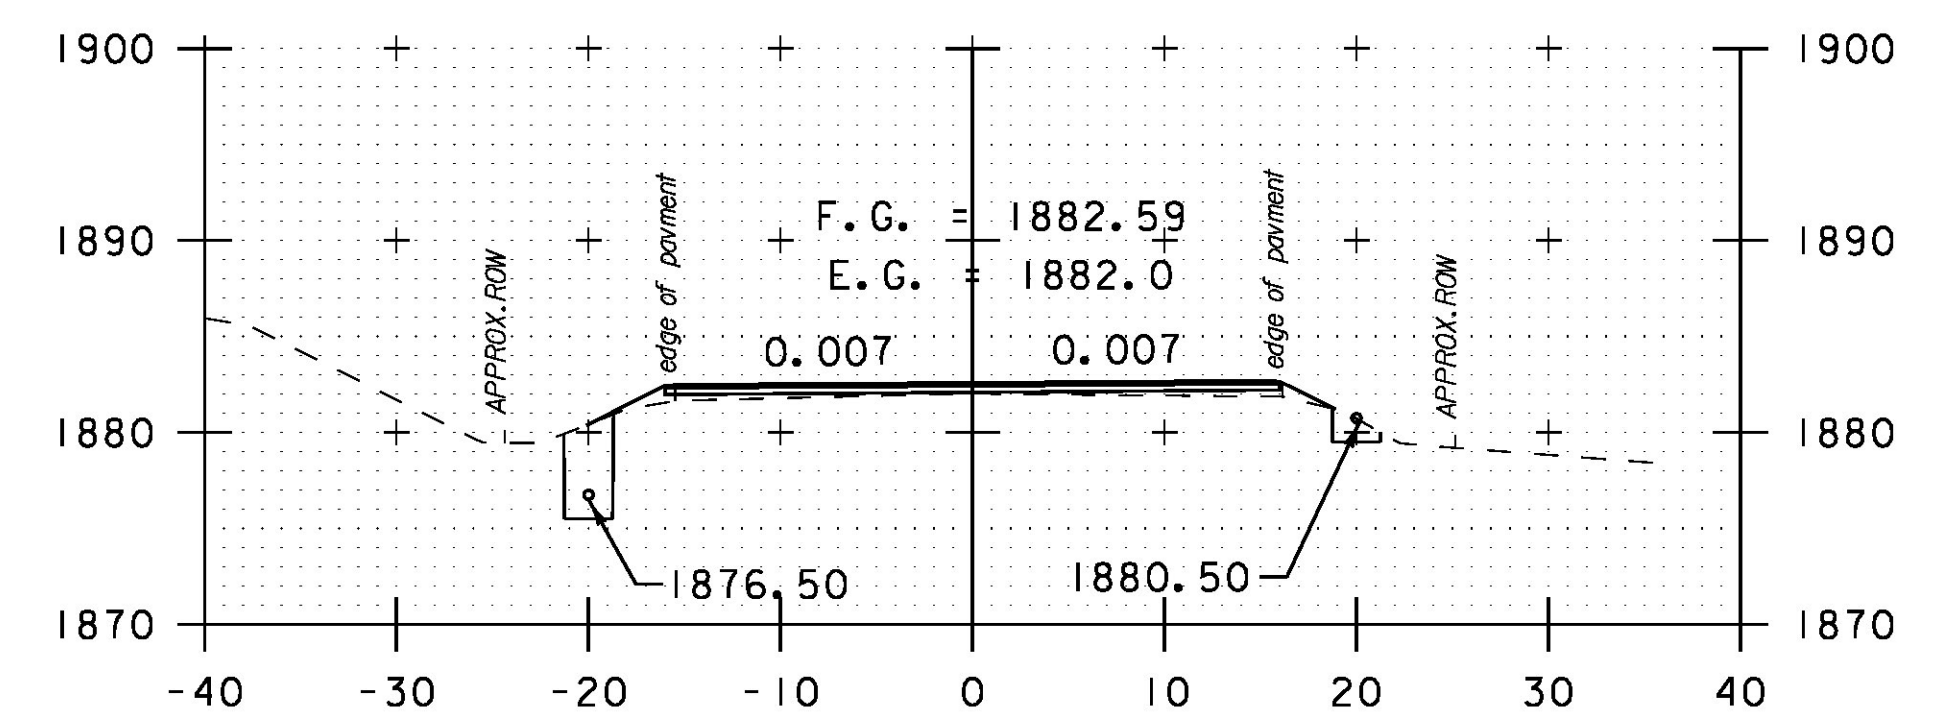

82+00

EXISTING GROUND (TYP.)

12" STONE FILL, TYPE I (TYP.)

GRUBBING MATERIAL (6") (TYP.)



PROJECT NAME: HANCOCK  
 PROJECT NUMBER: STP 2923 (1)  
 FILE NAME: z10c252xs.dgn  
 PROJECT LEADER: C. LATHROP  
 DESIGNED BY: B. MARTIN  
 CROSS SECTION SHEET 9

PLOT DATE: 3/18/2015  
 DRAWN BY: B. MARTIN  
 CHECKED BY: C. LATHROP  
 SHEET 136 OF 207