




85+50

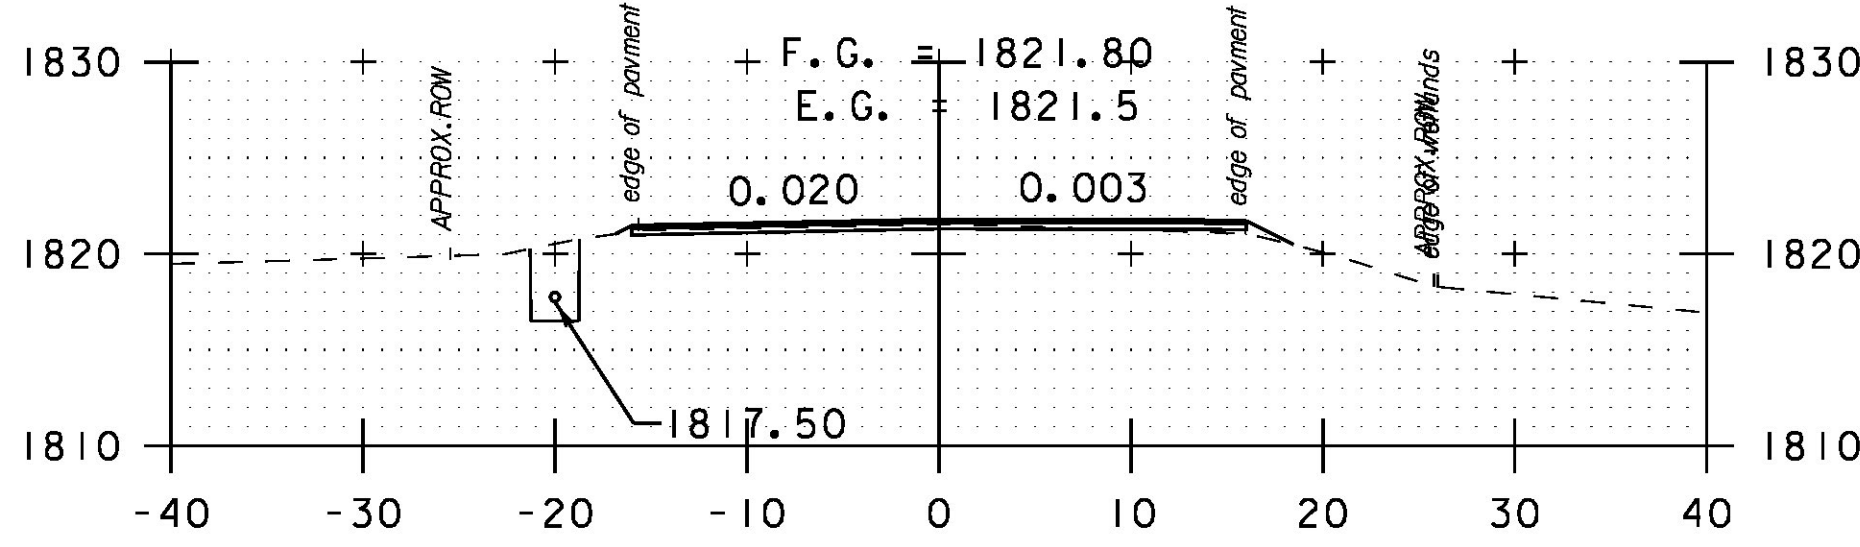


87+50

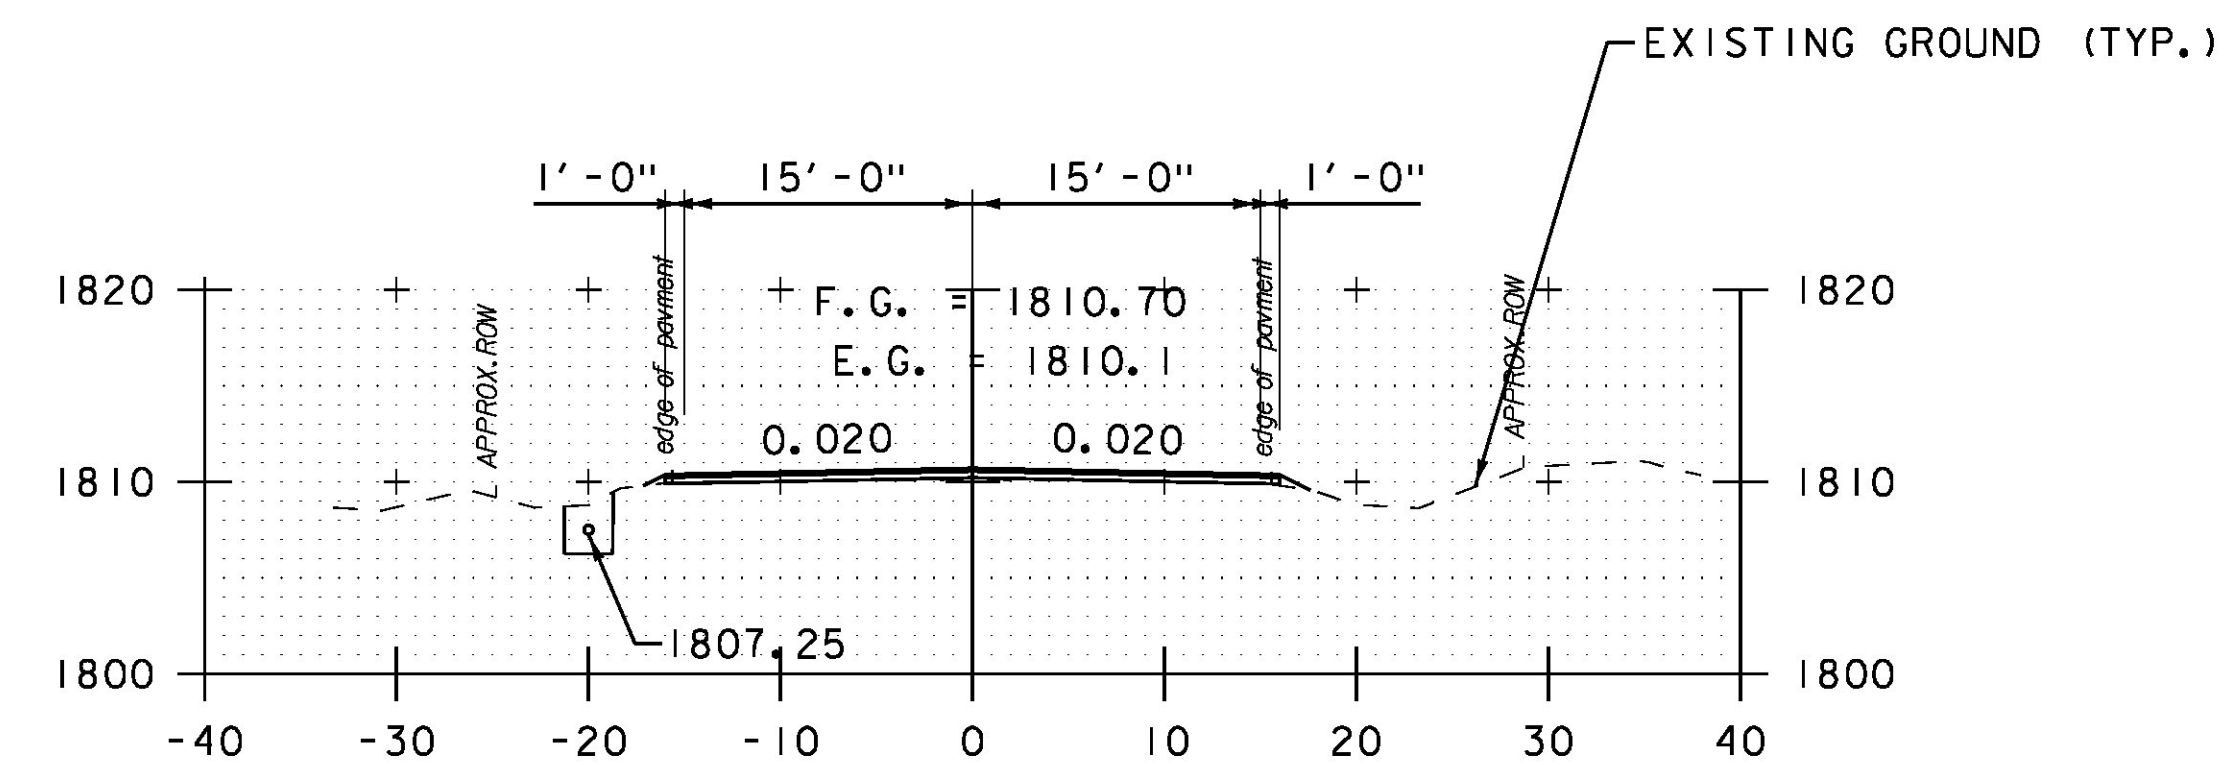


89+50

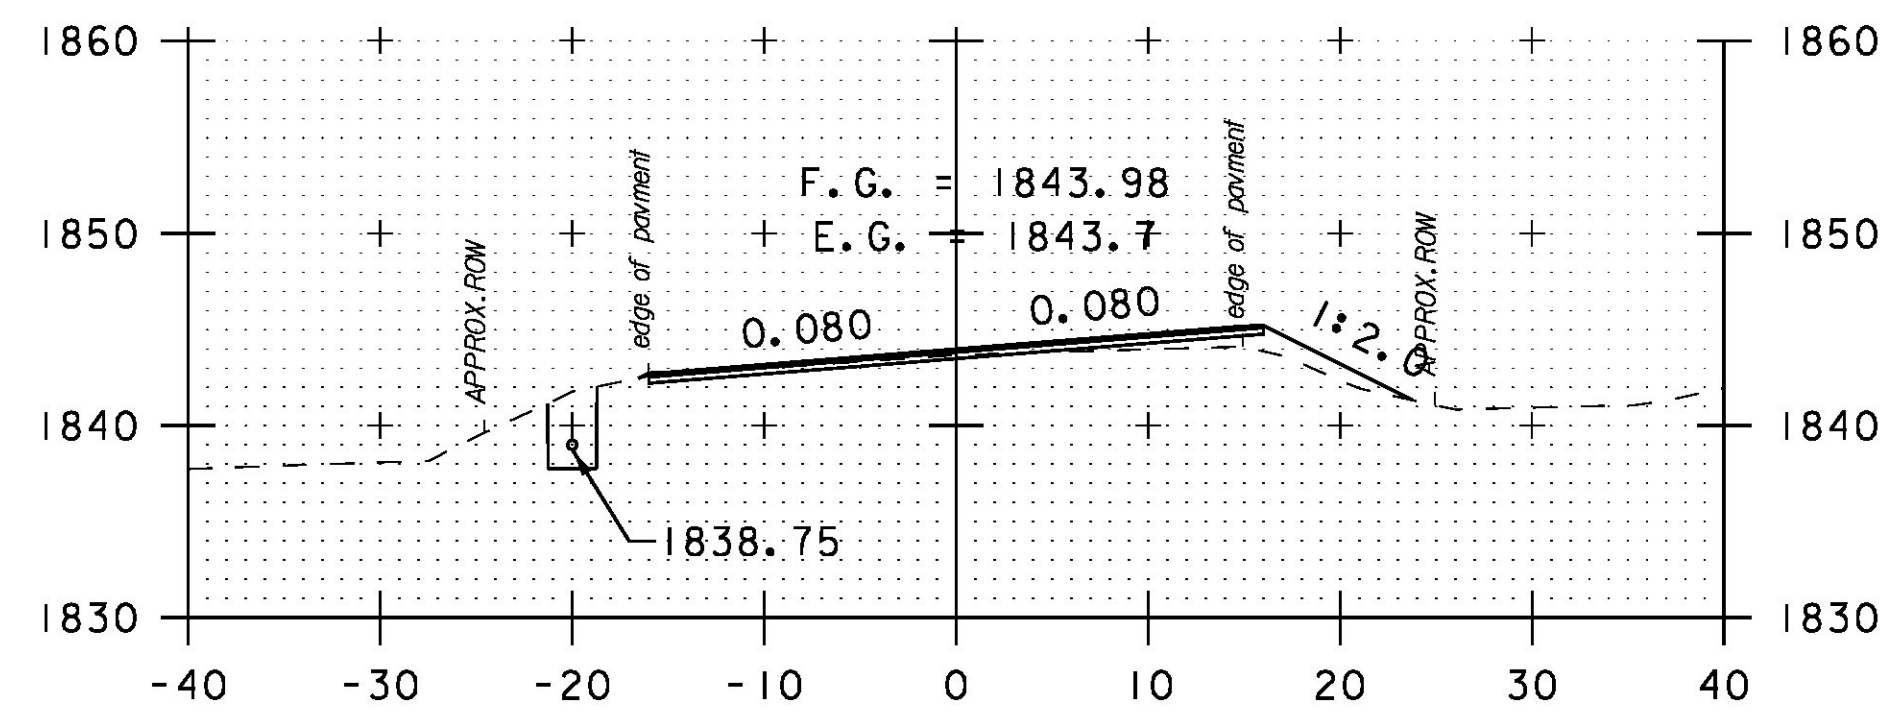


85+00

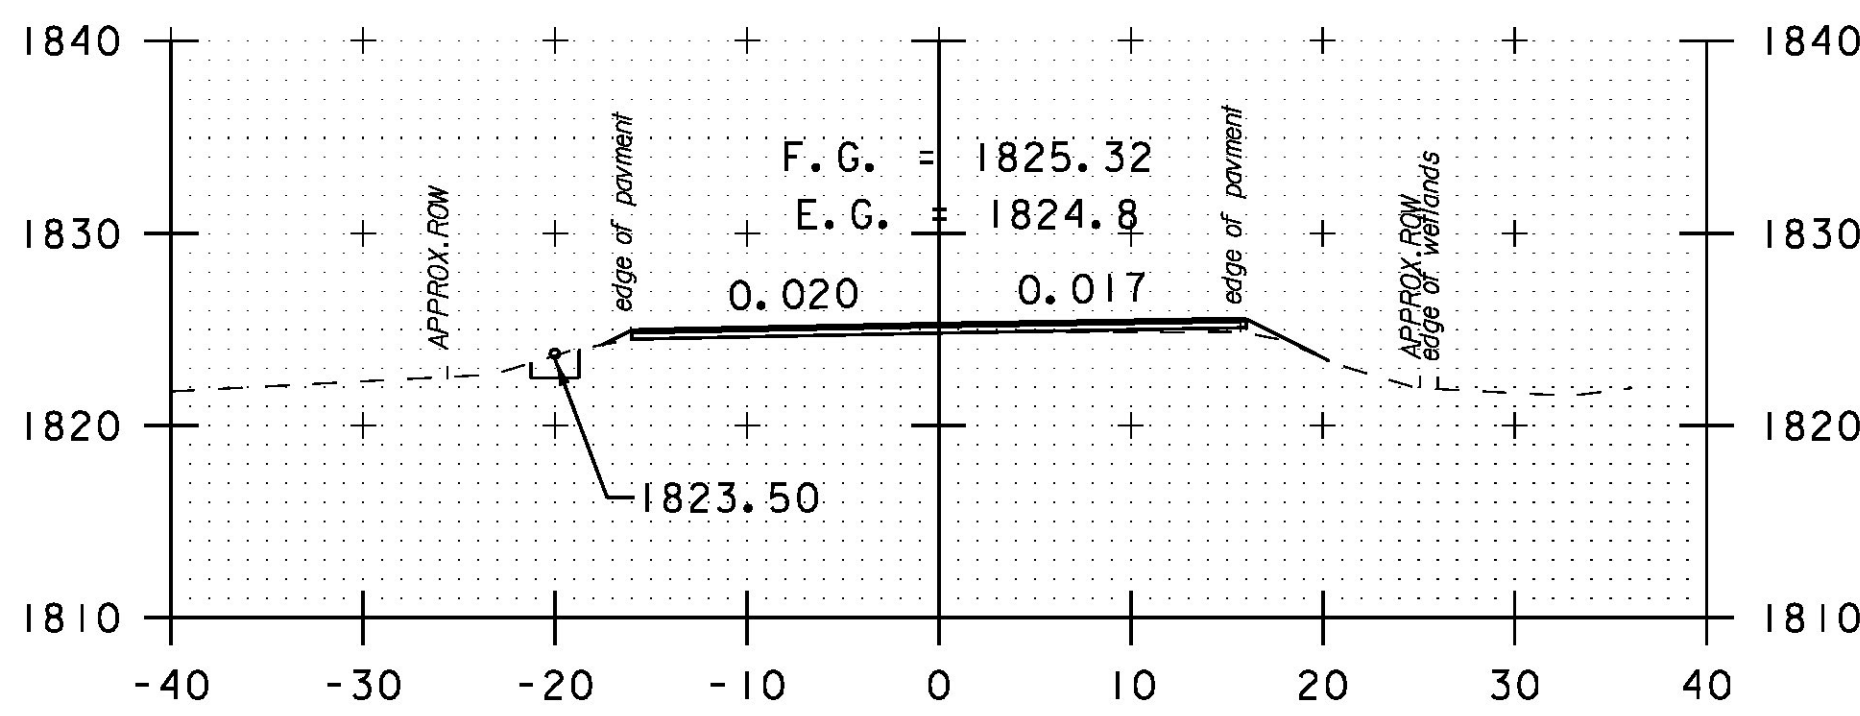


87+00

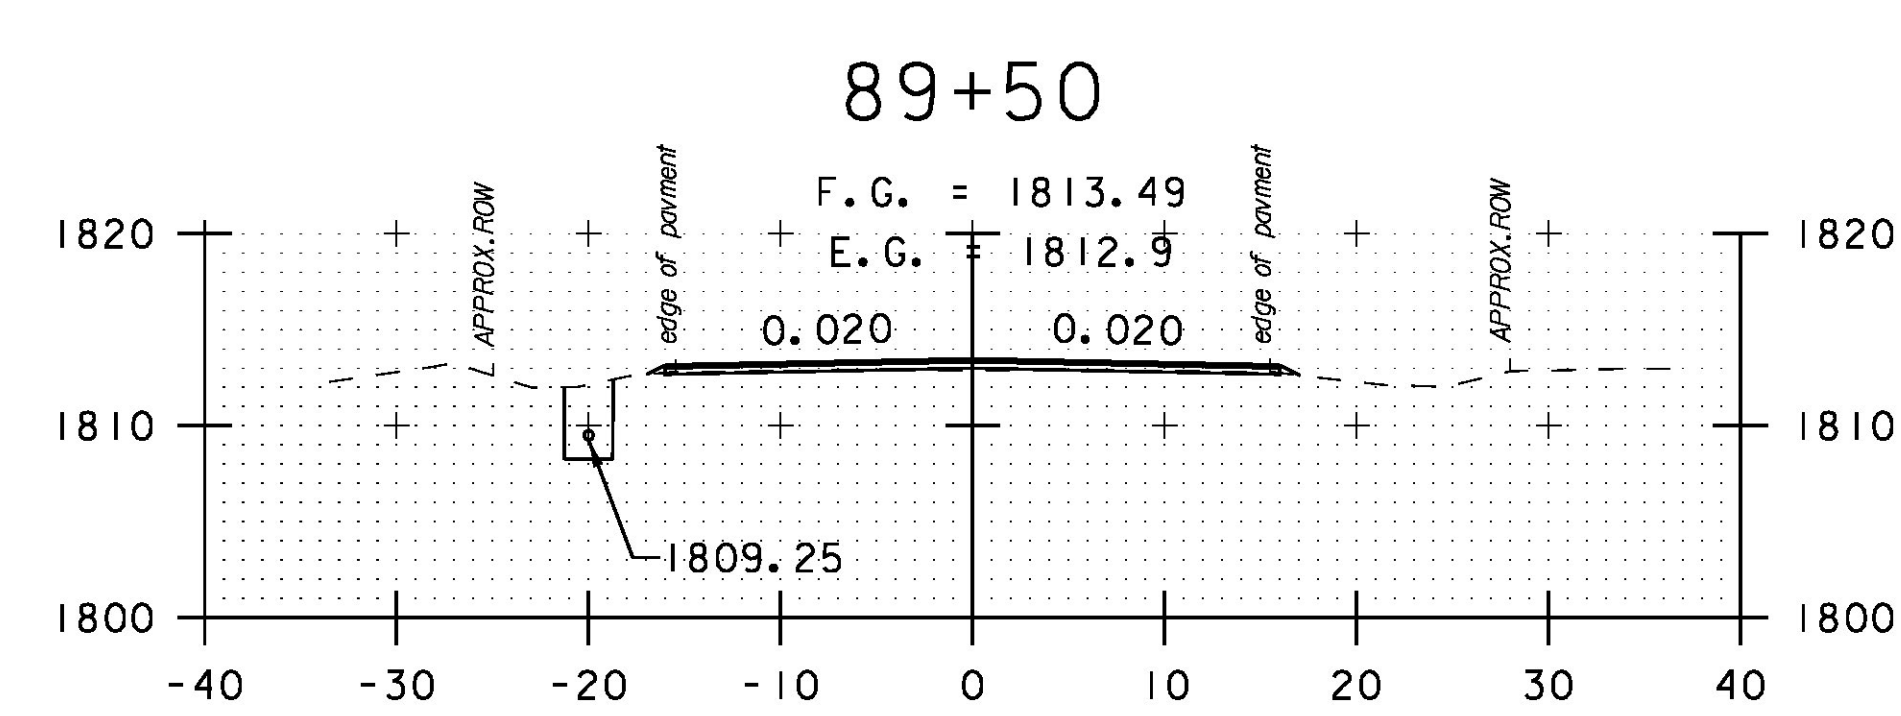


89+00

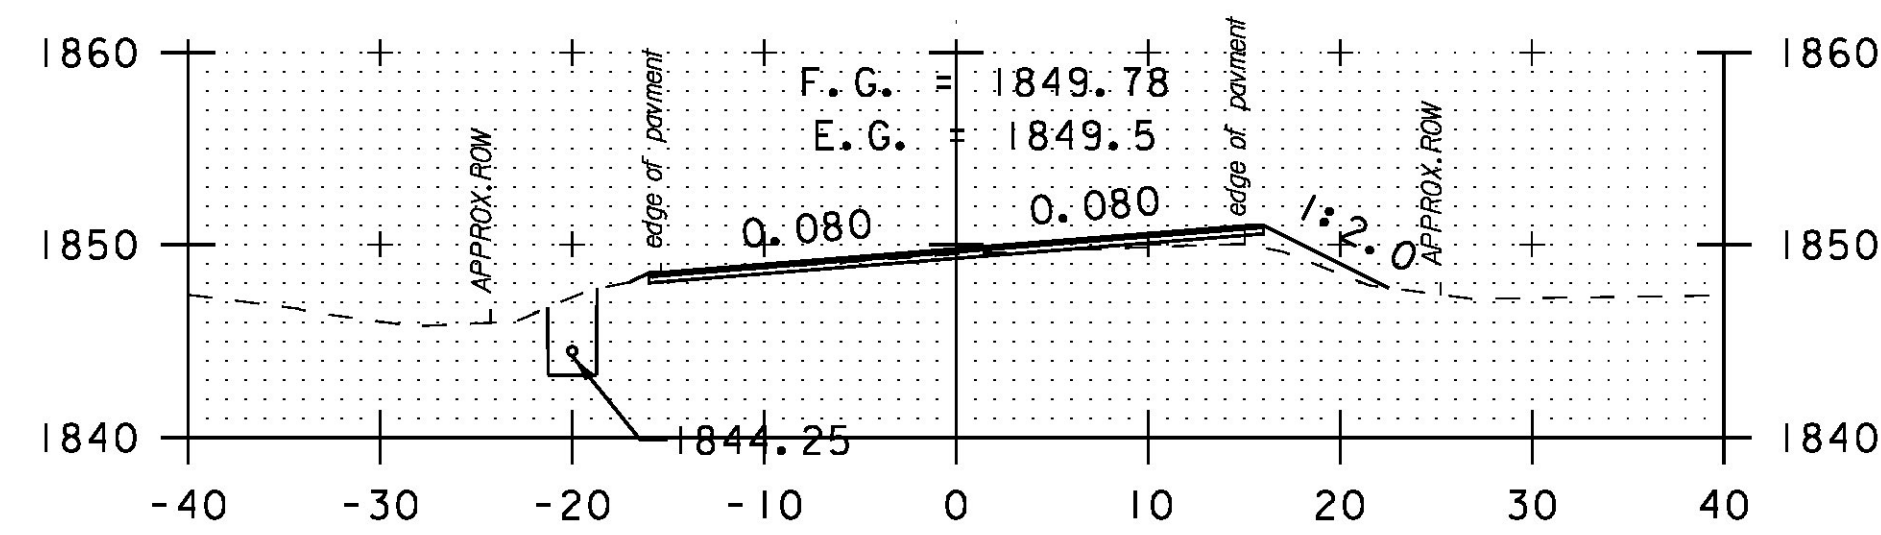


84+50

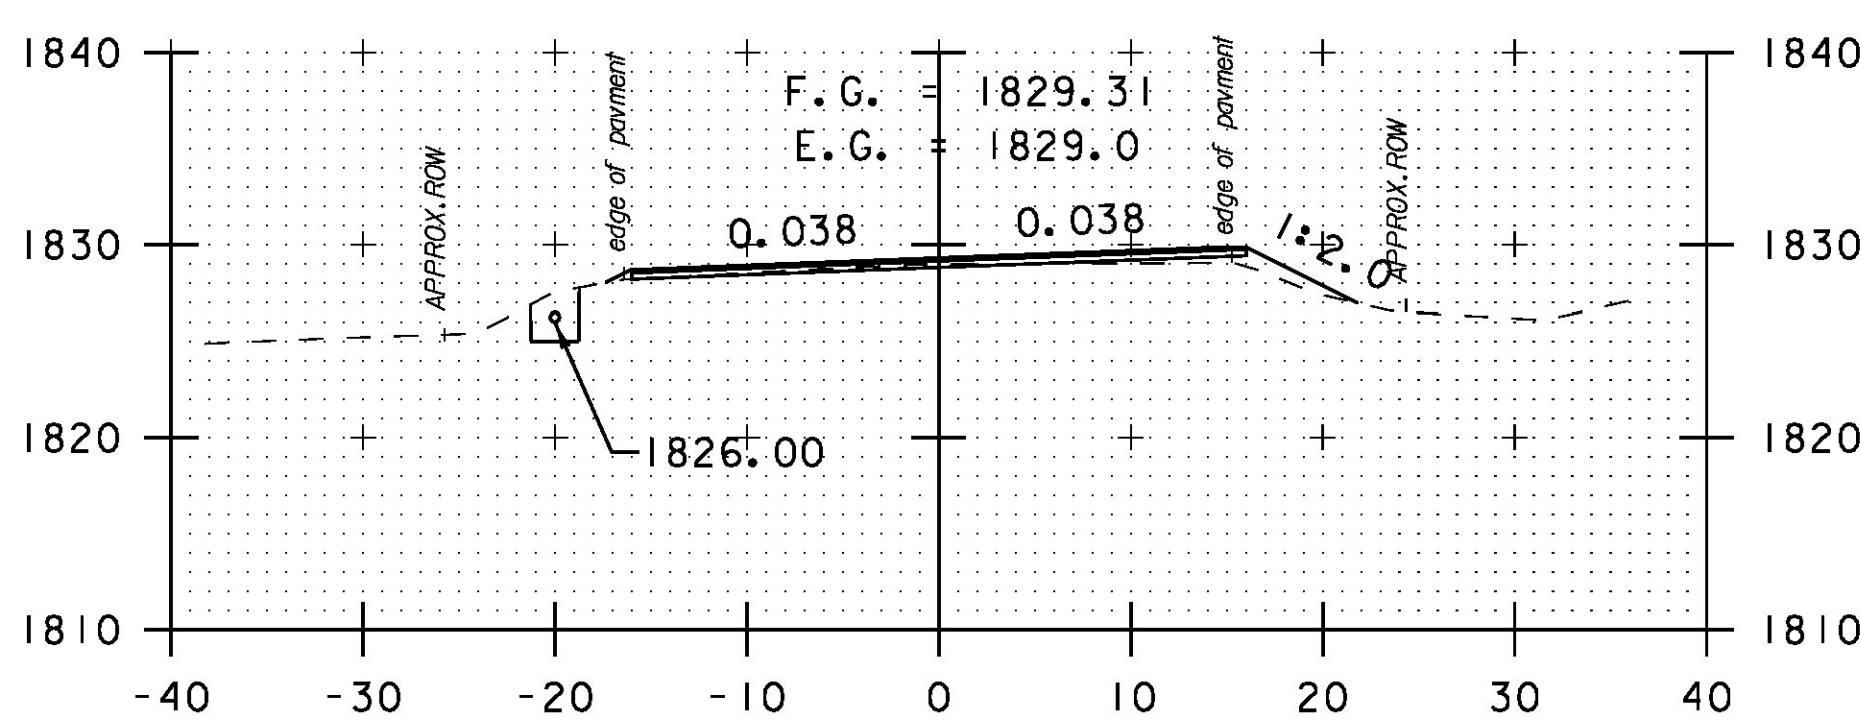


86+50

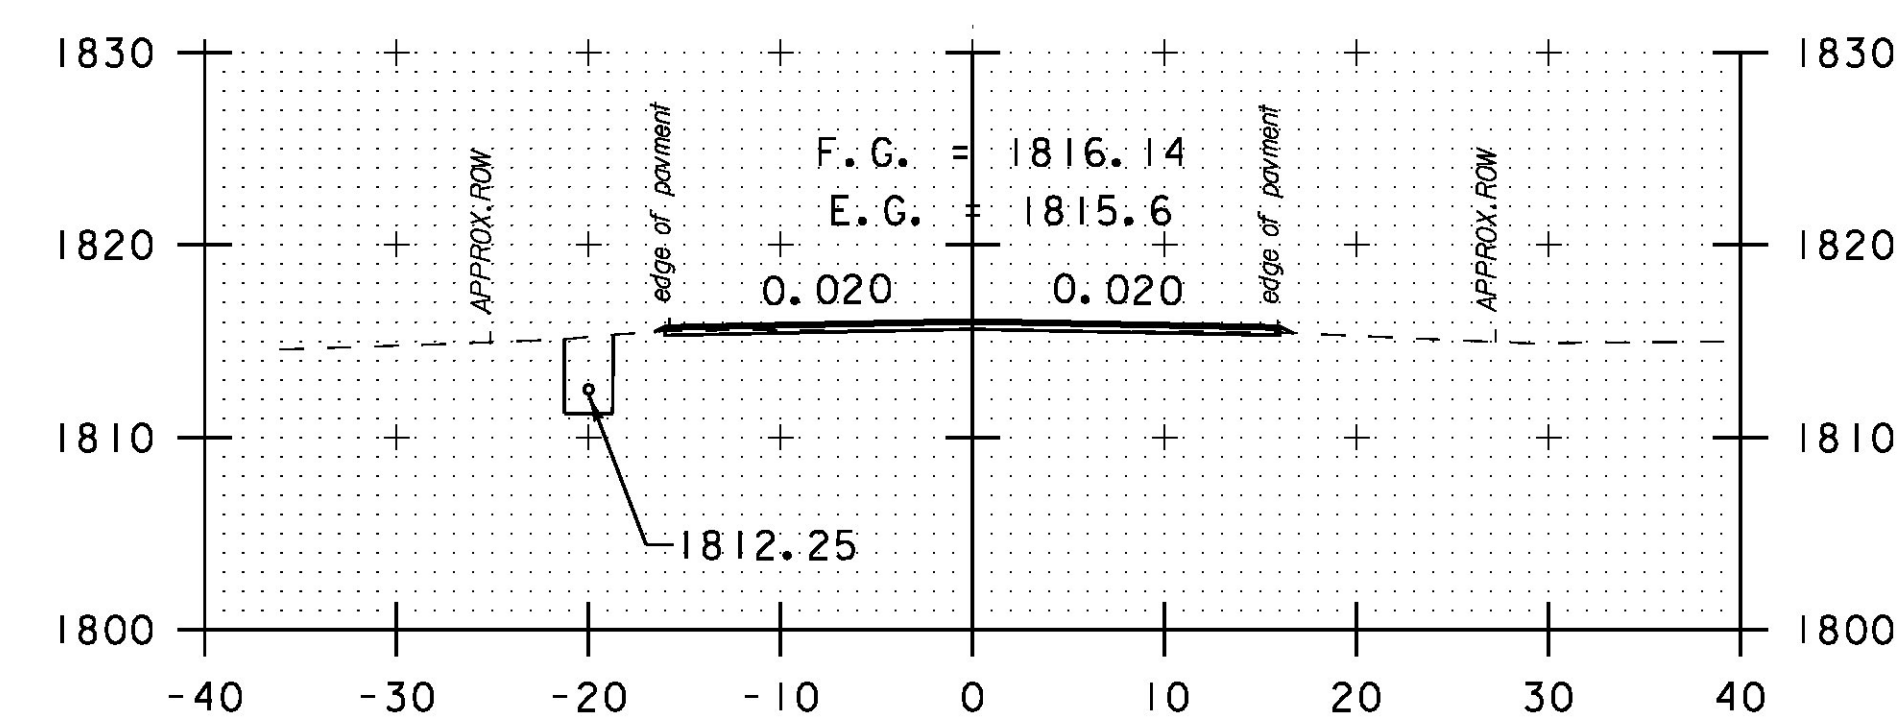


88+50

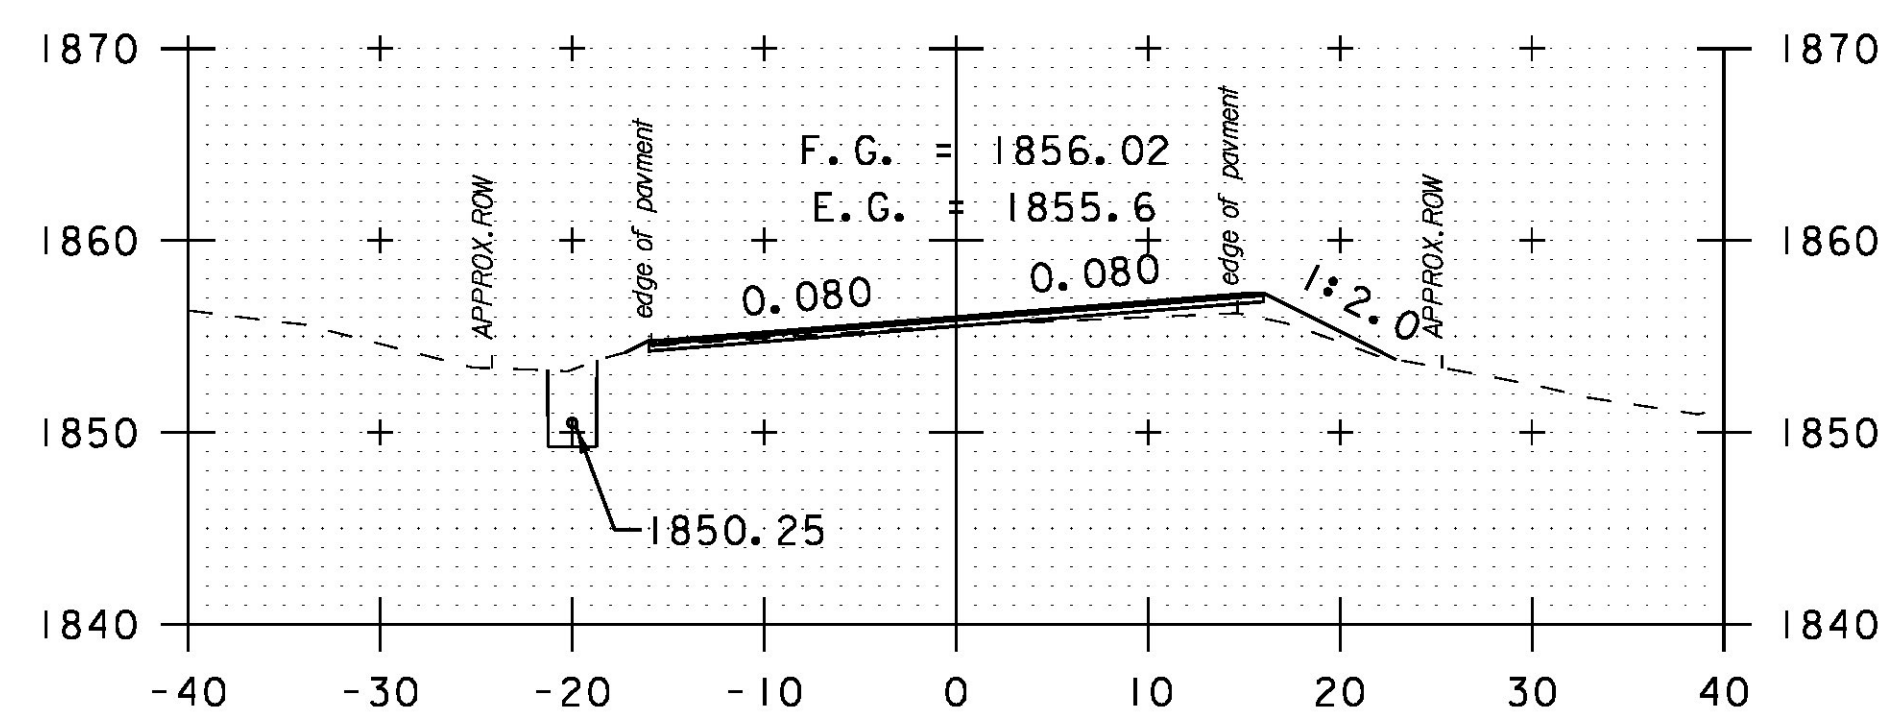

84+00

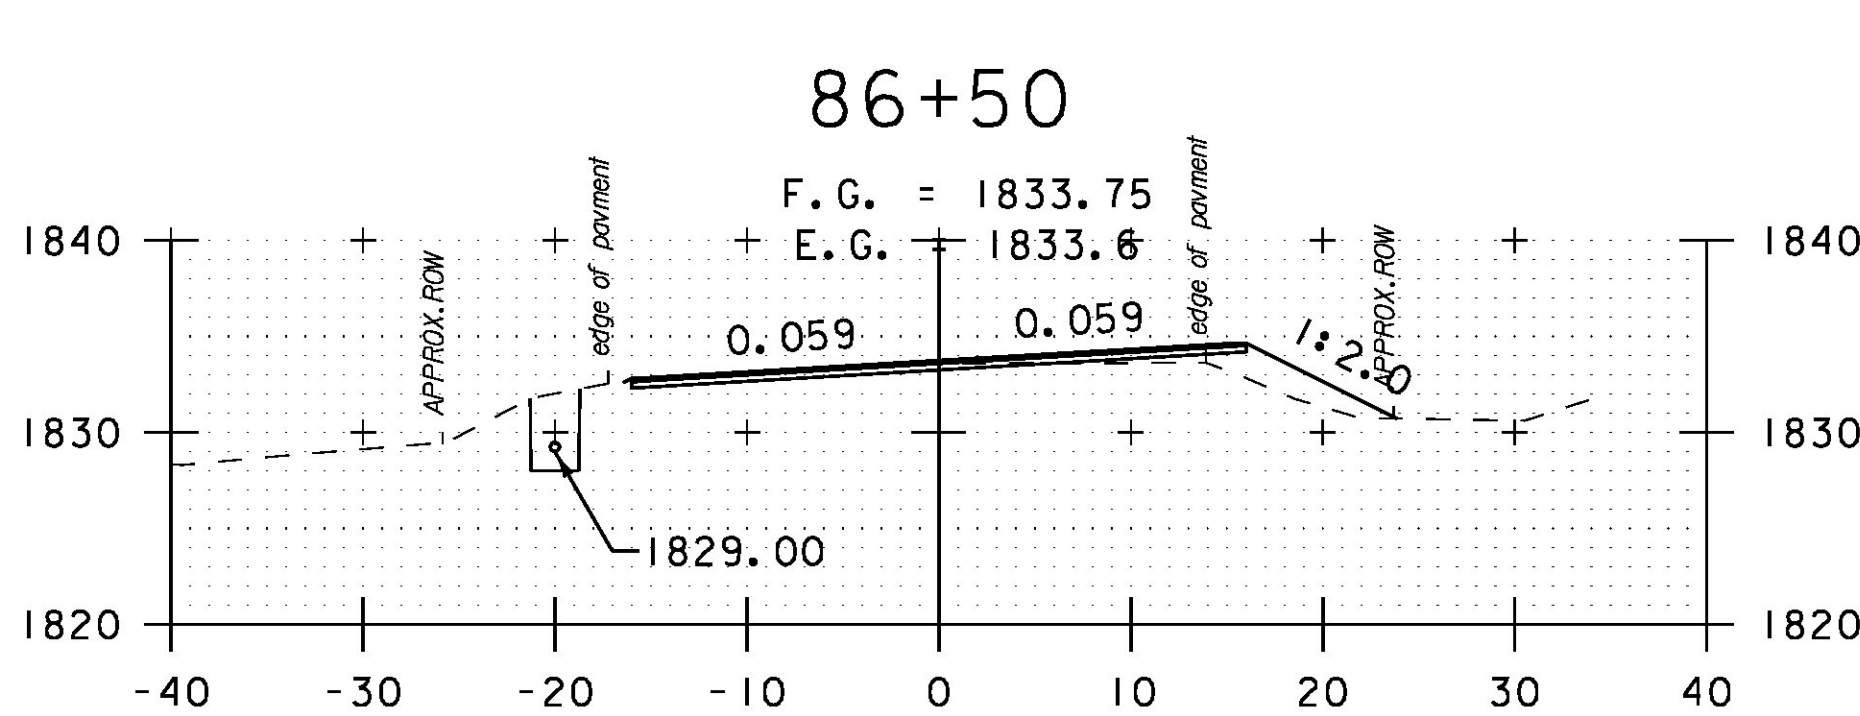

86+00

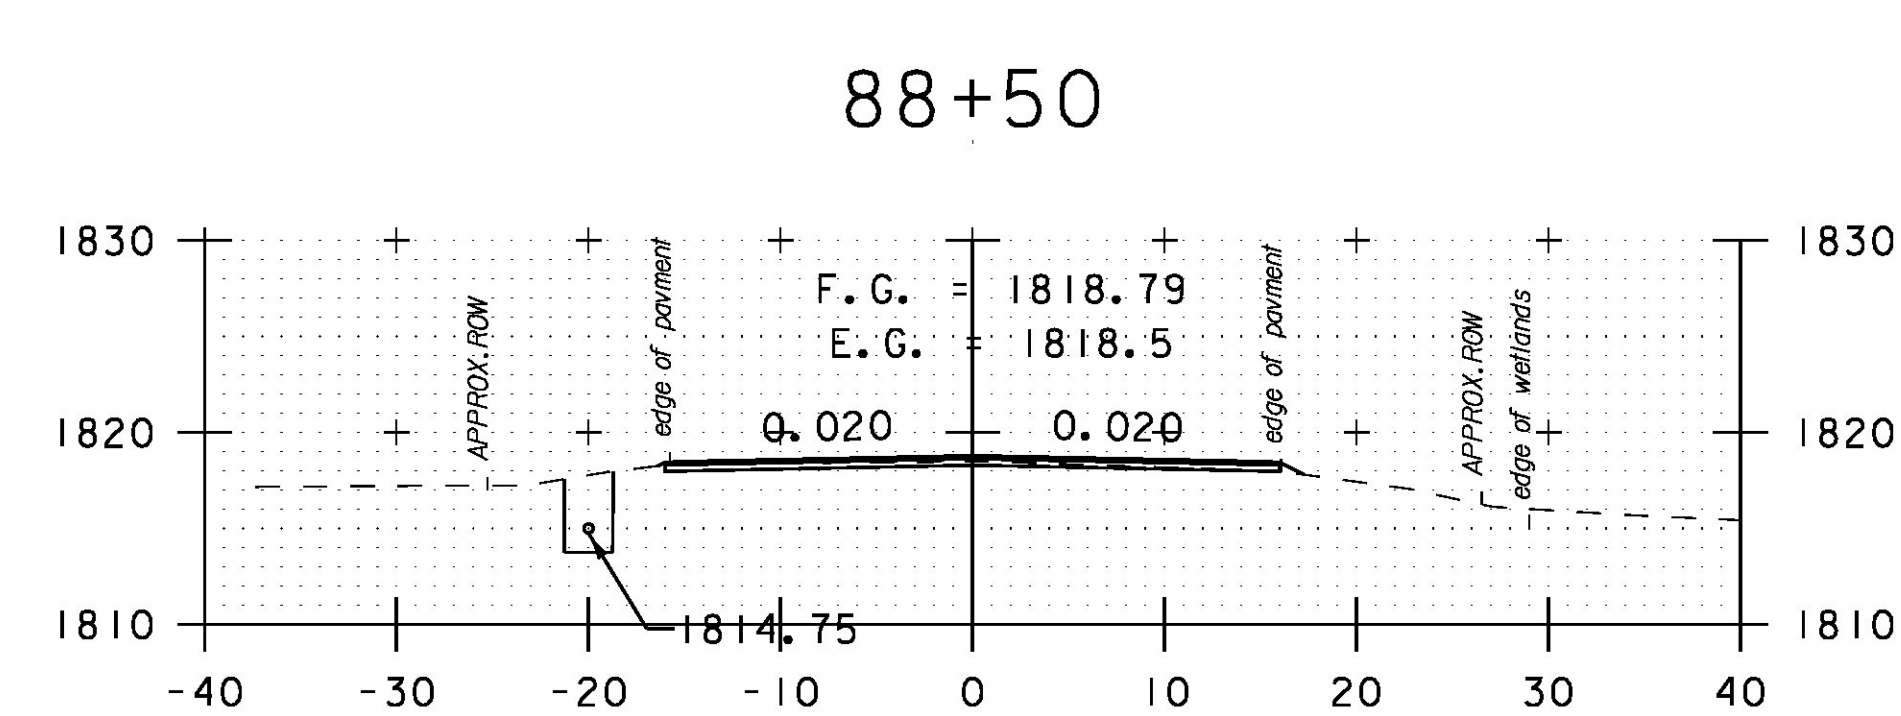

88+00



PROJECT NAME: HANCOCK	
PROJECT NUMBER: STP 2923 (1)	
FILE NAME: z10c252xs.dgn	PLOT DATE: 3/18/2015
PROJECT LEADER: C. LATHROP	DRAWN BY: B. MARTIN
DESIGNED BY: B. MARTIN	CHECKED BY: C. LATHROP
CROSS SECTION SHEET 10	SHEET 137 OF 207