




91+00

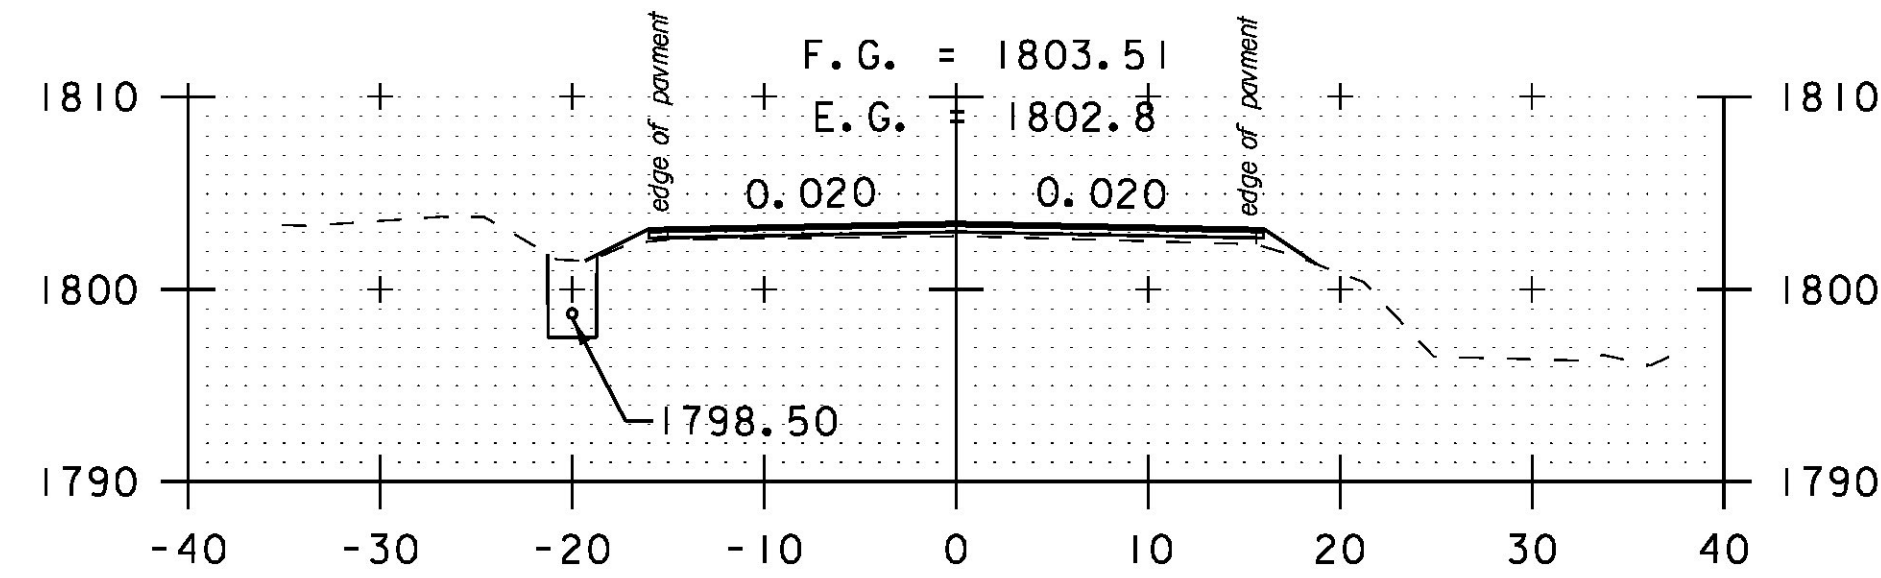


90+50

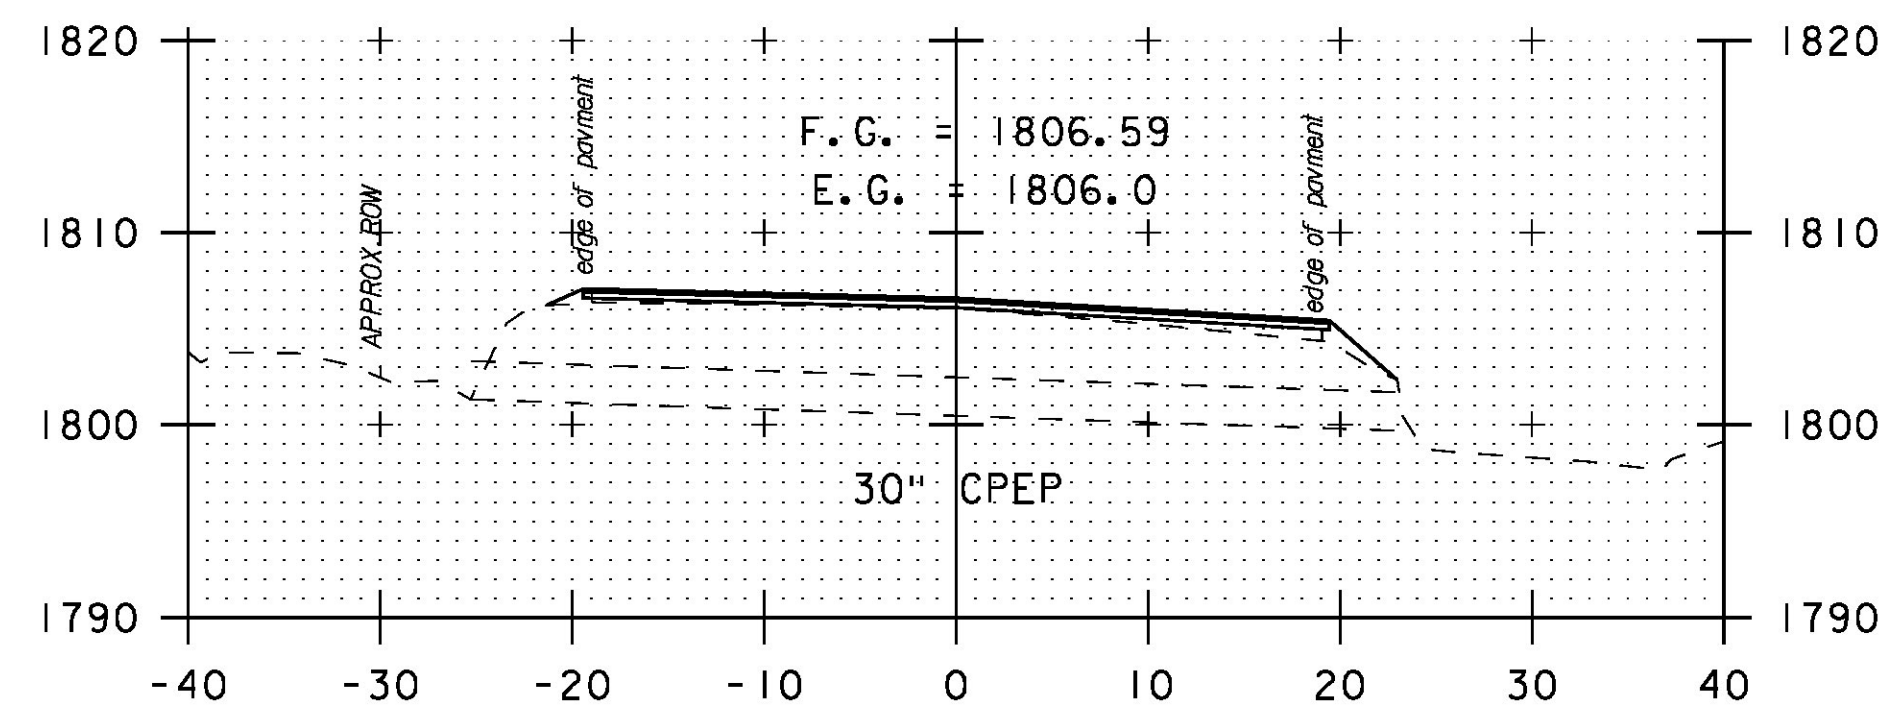


90+11

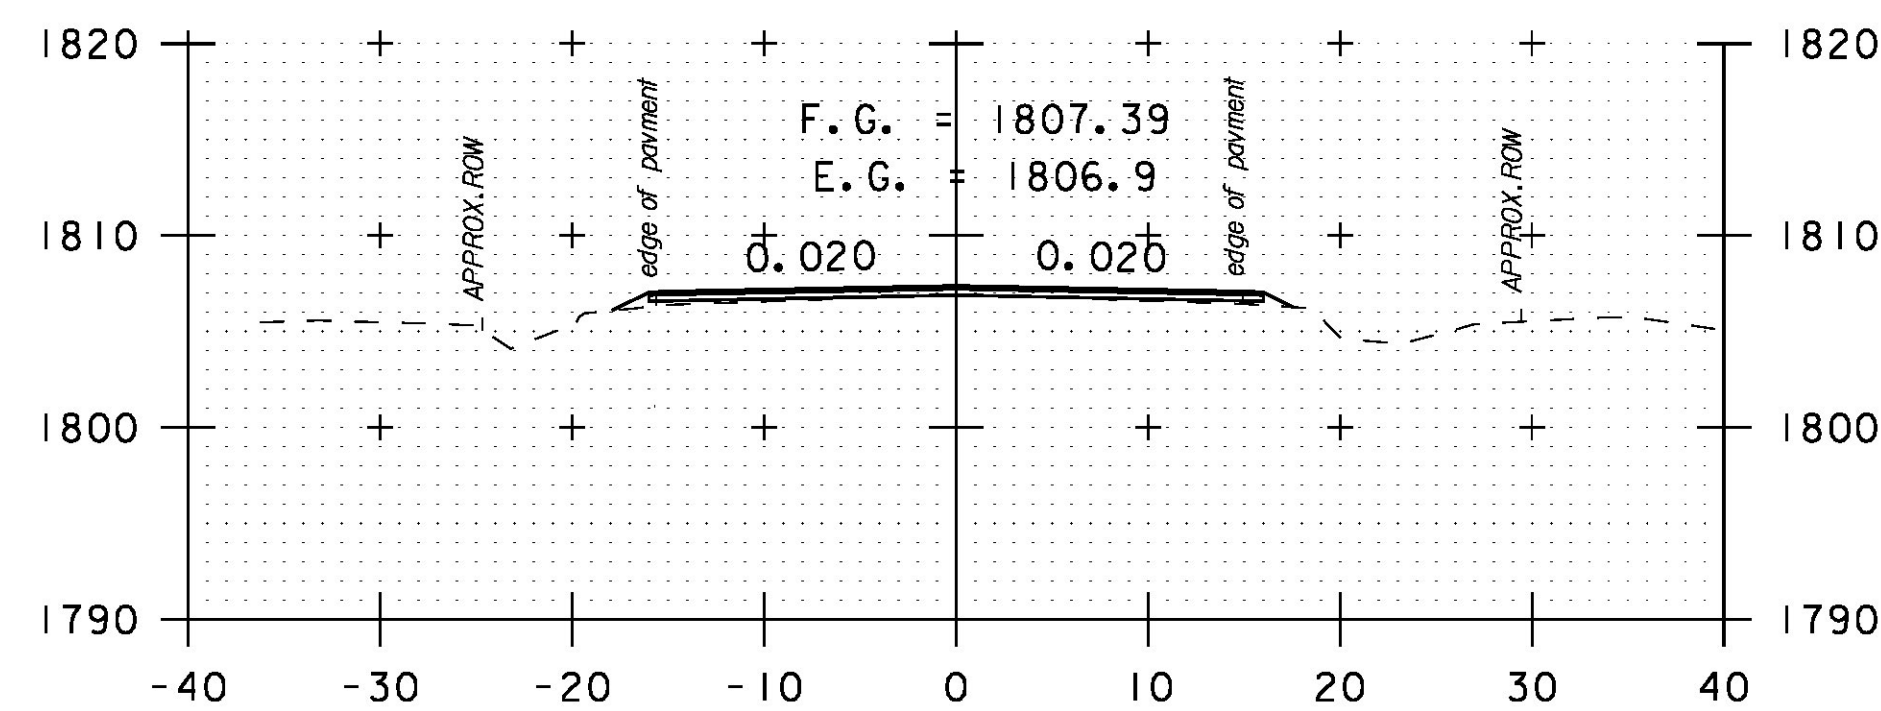


90+00

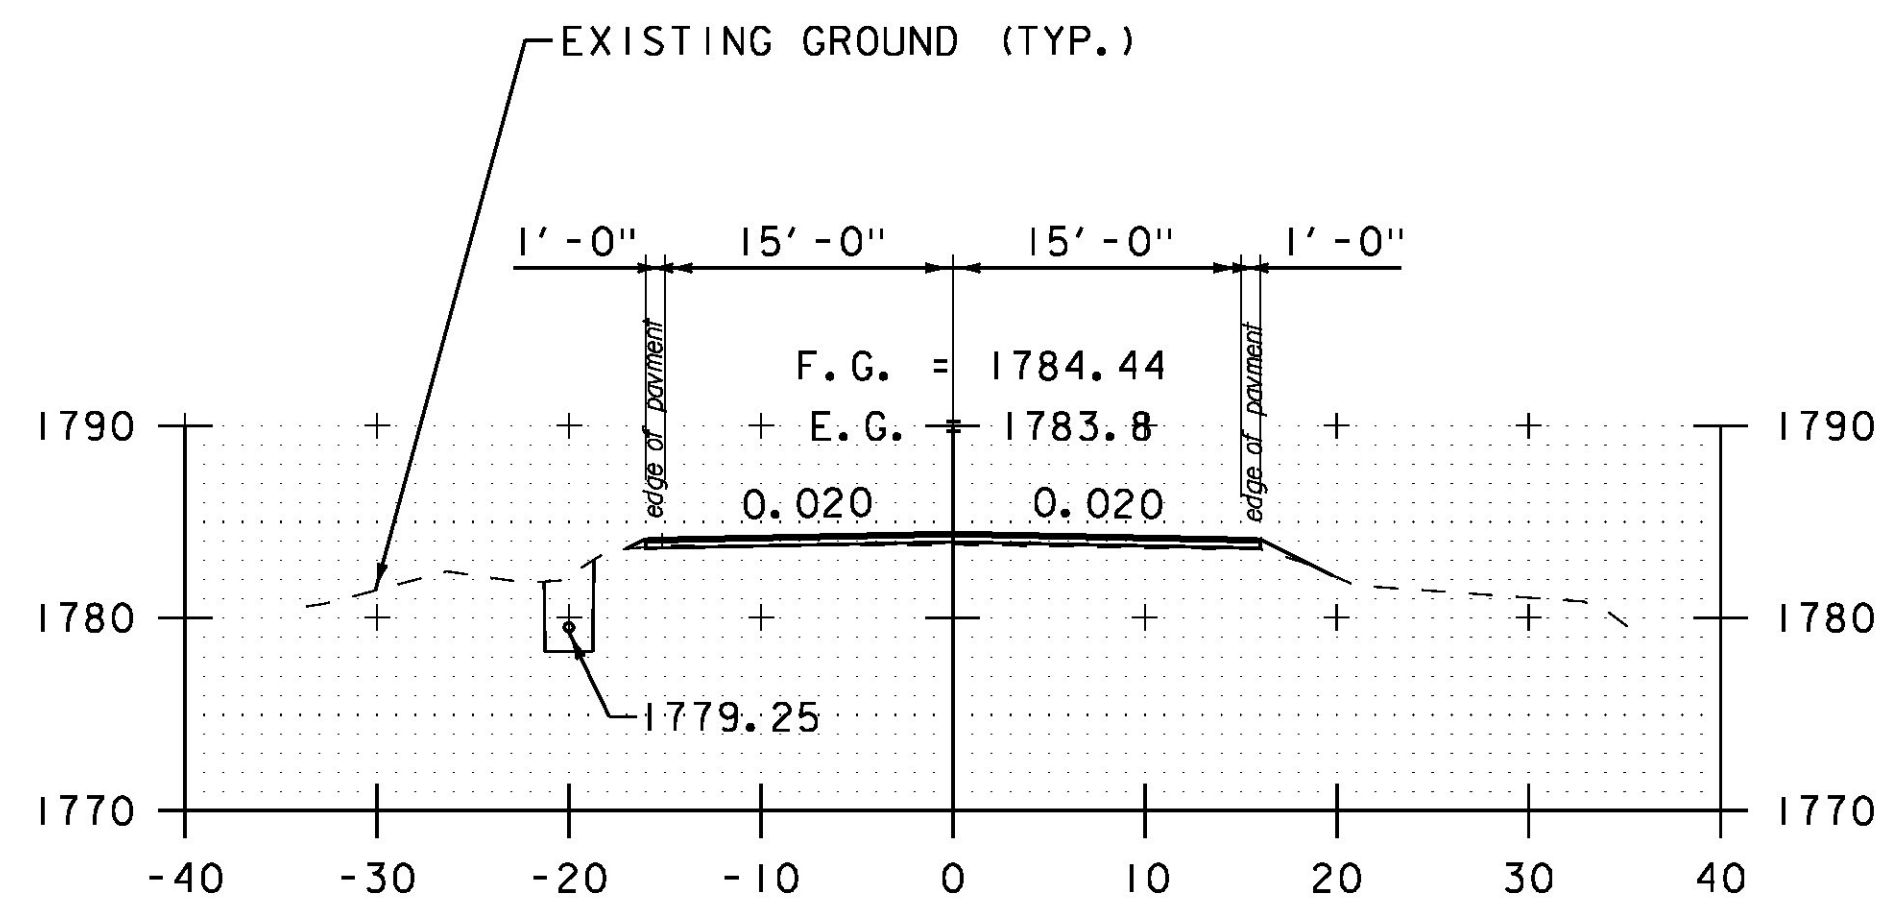


92+50

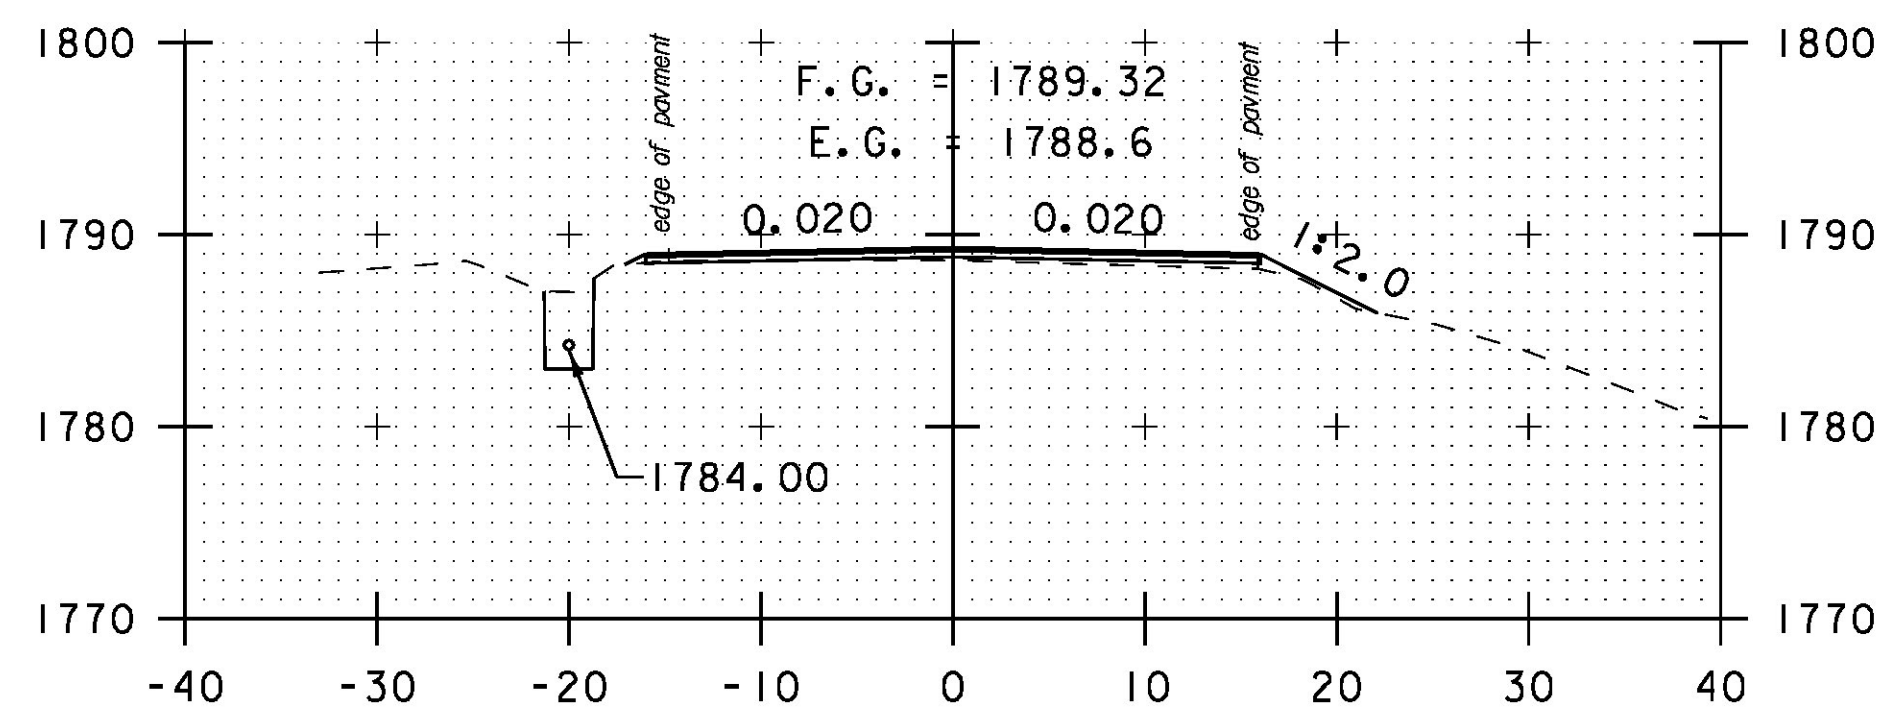


92+00

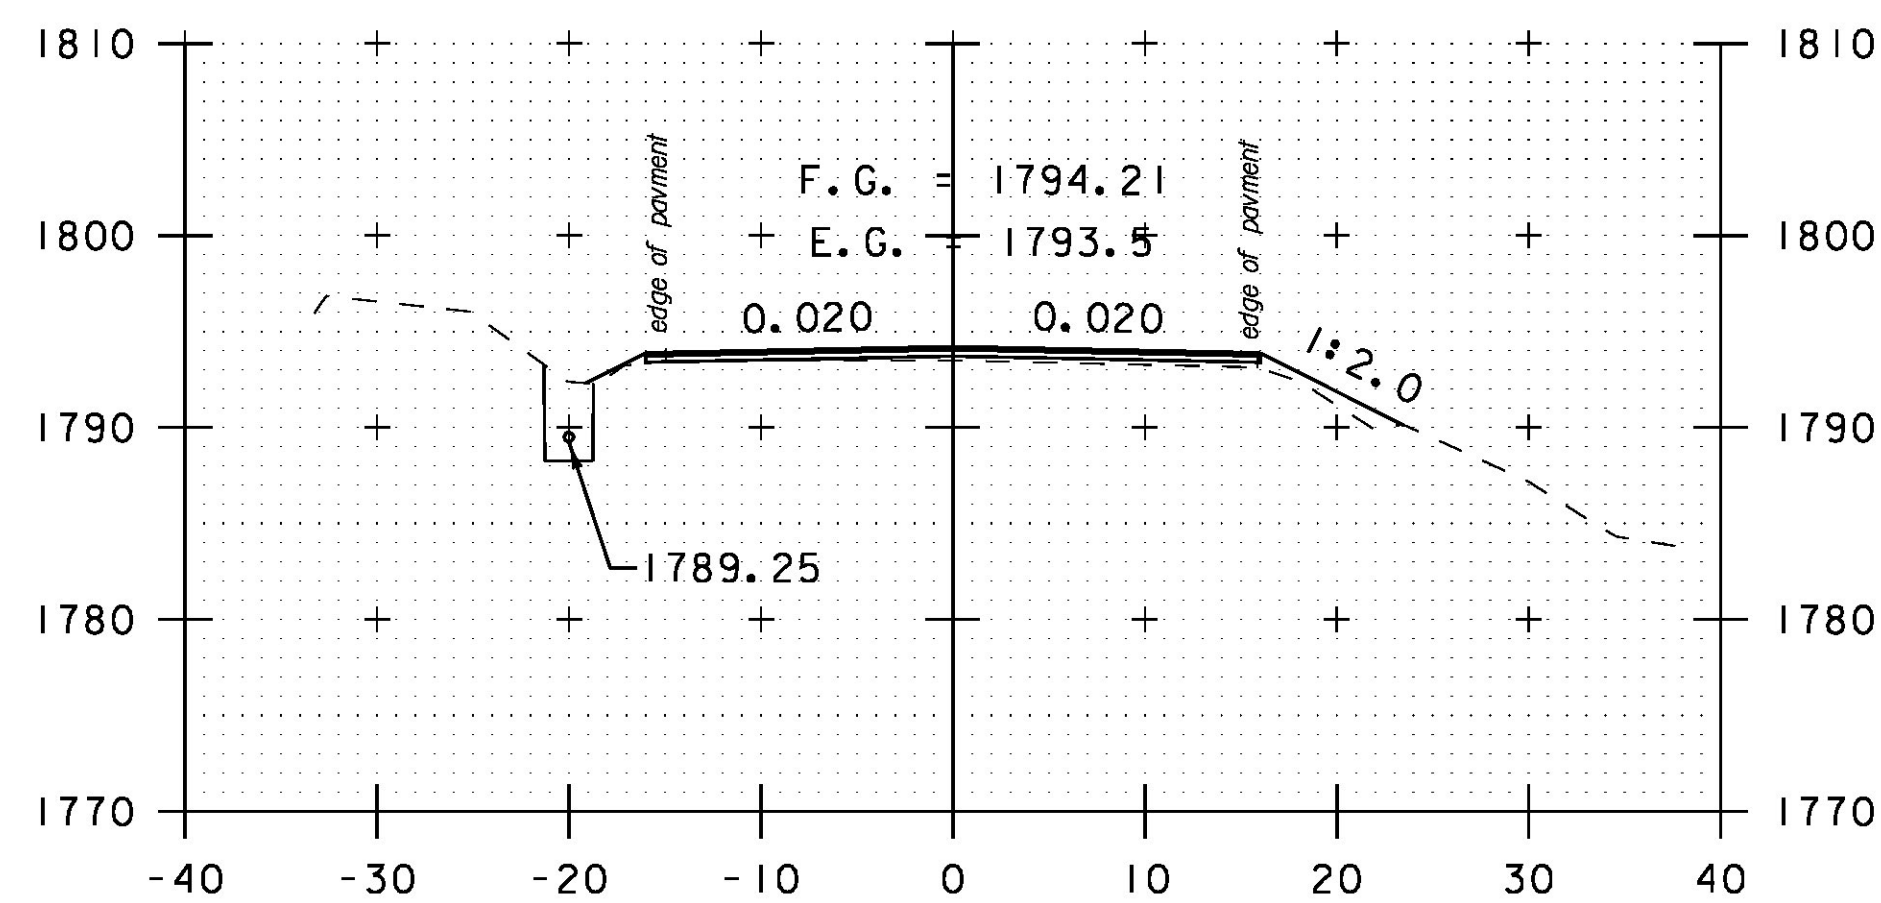


91+50

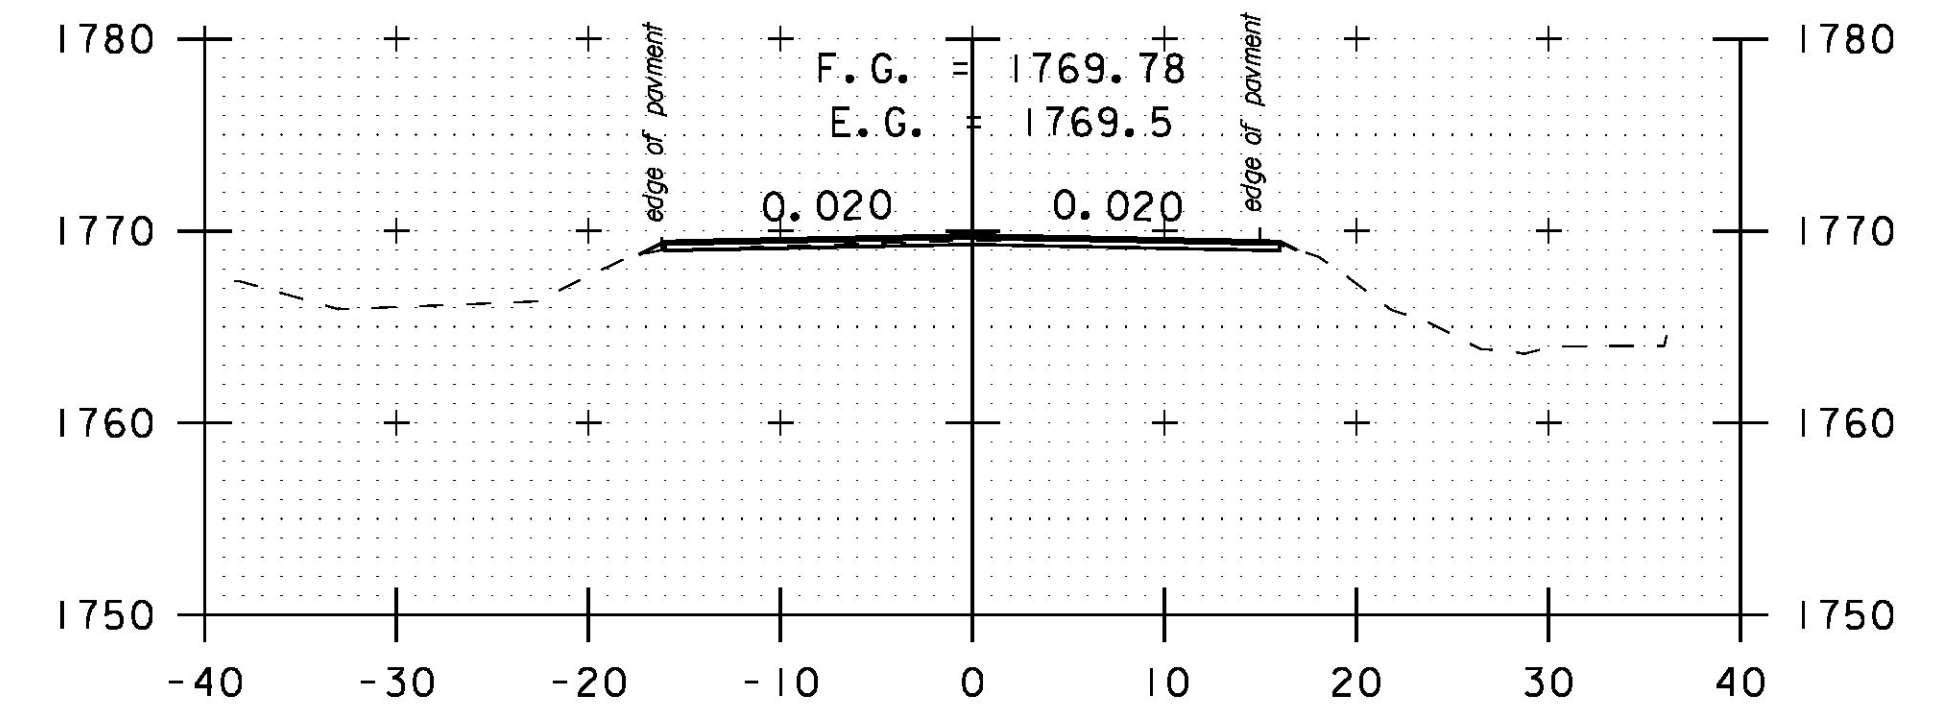


94+00

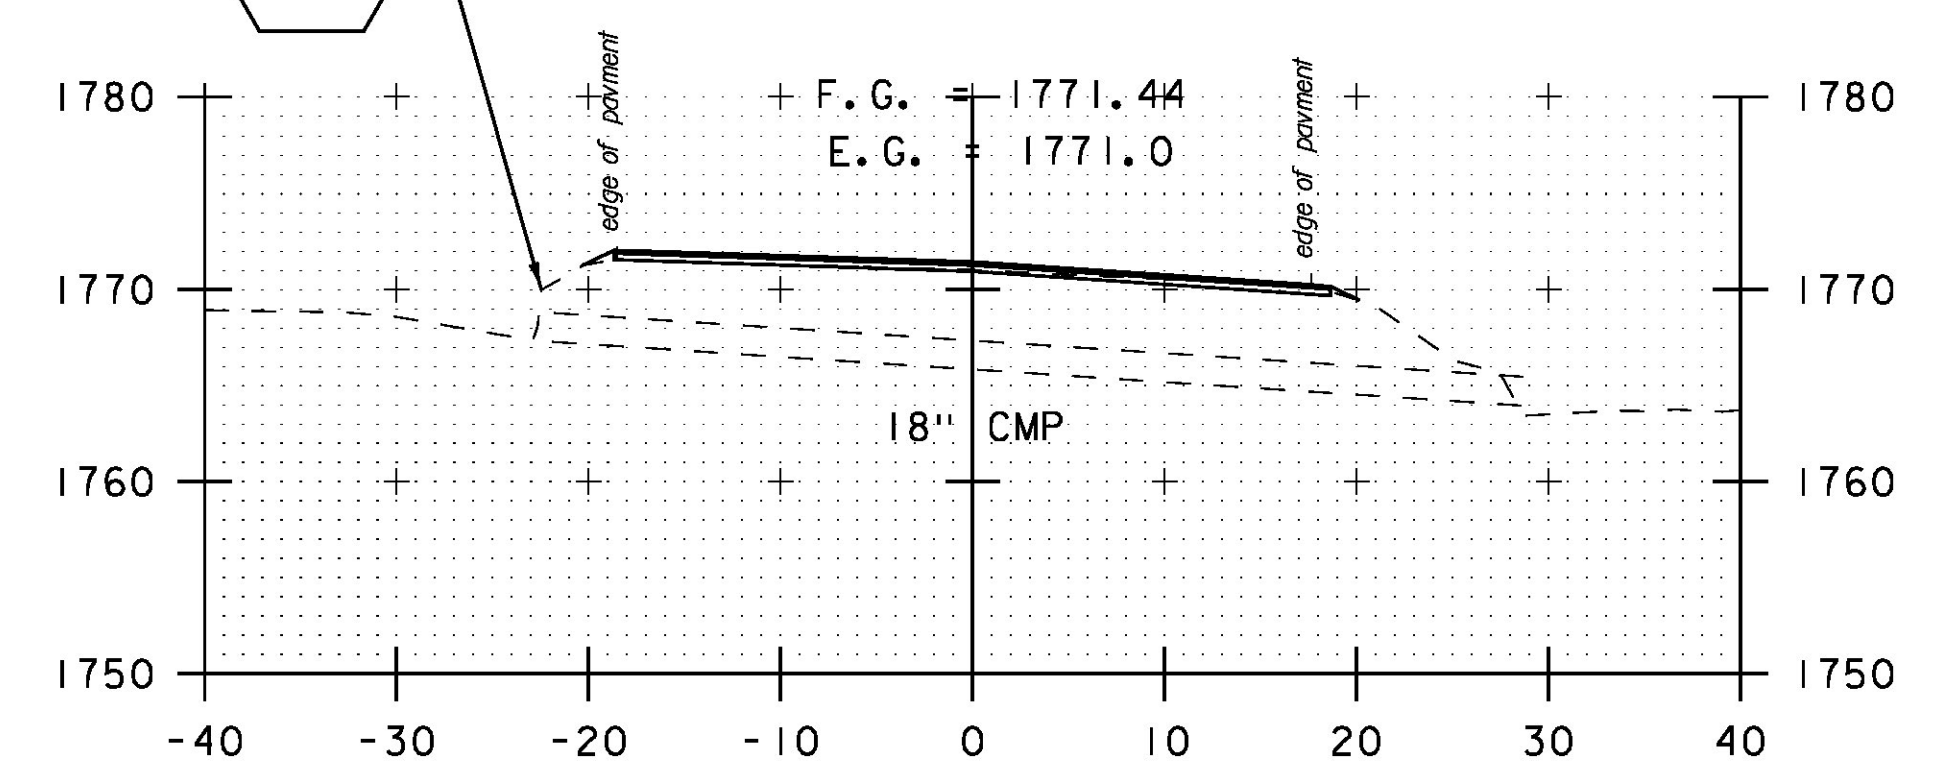


93+83

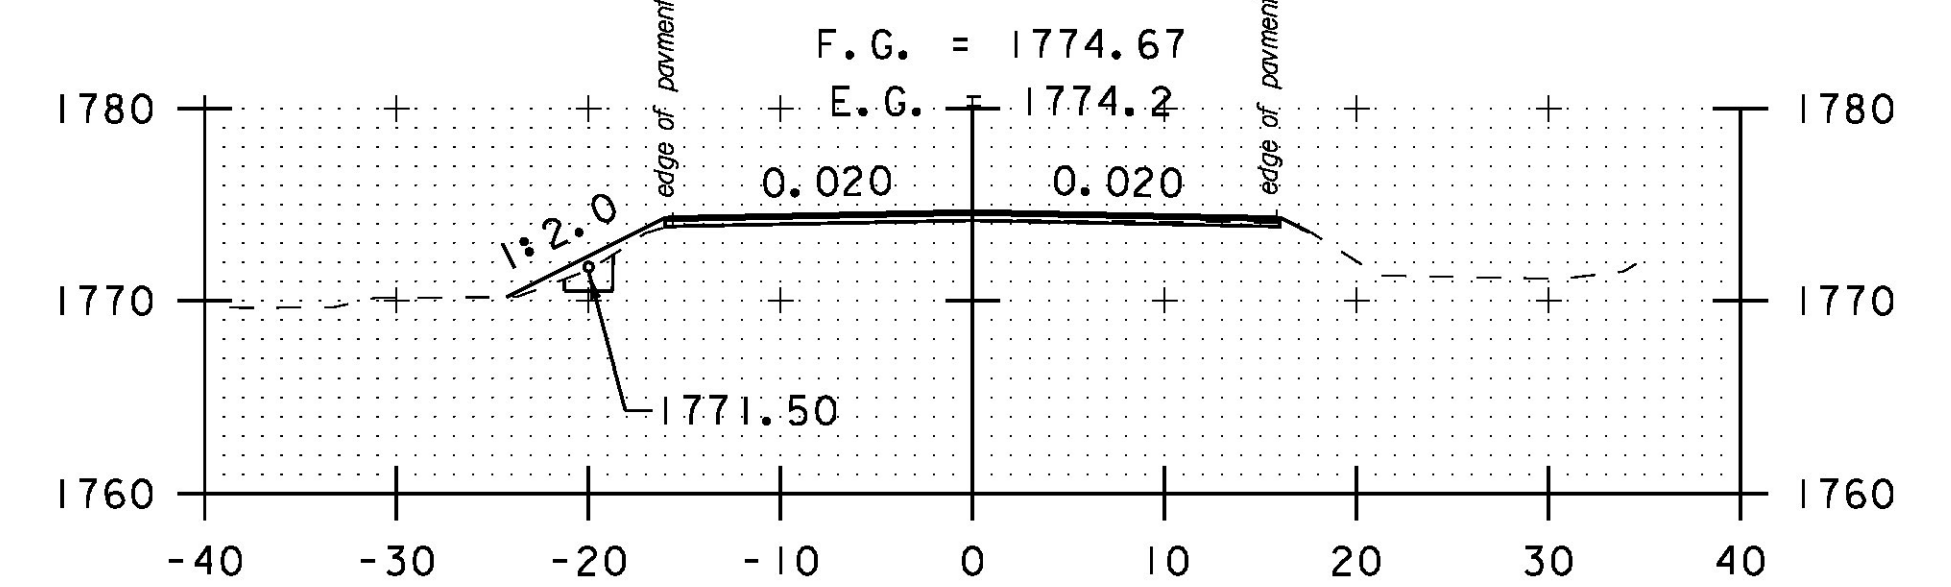


93+50

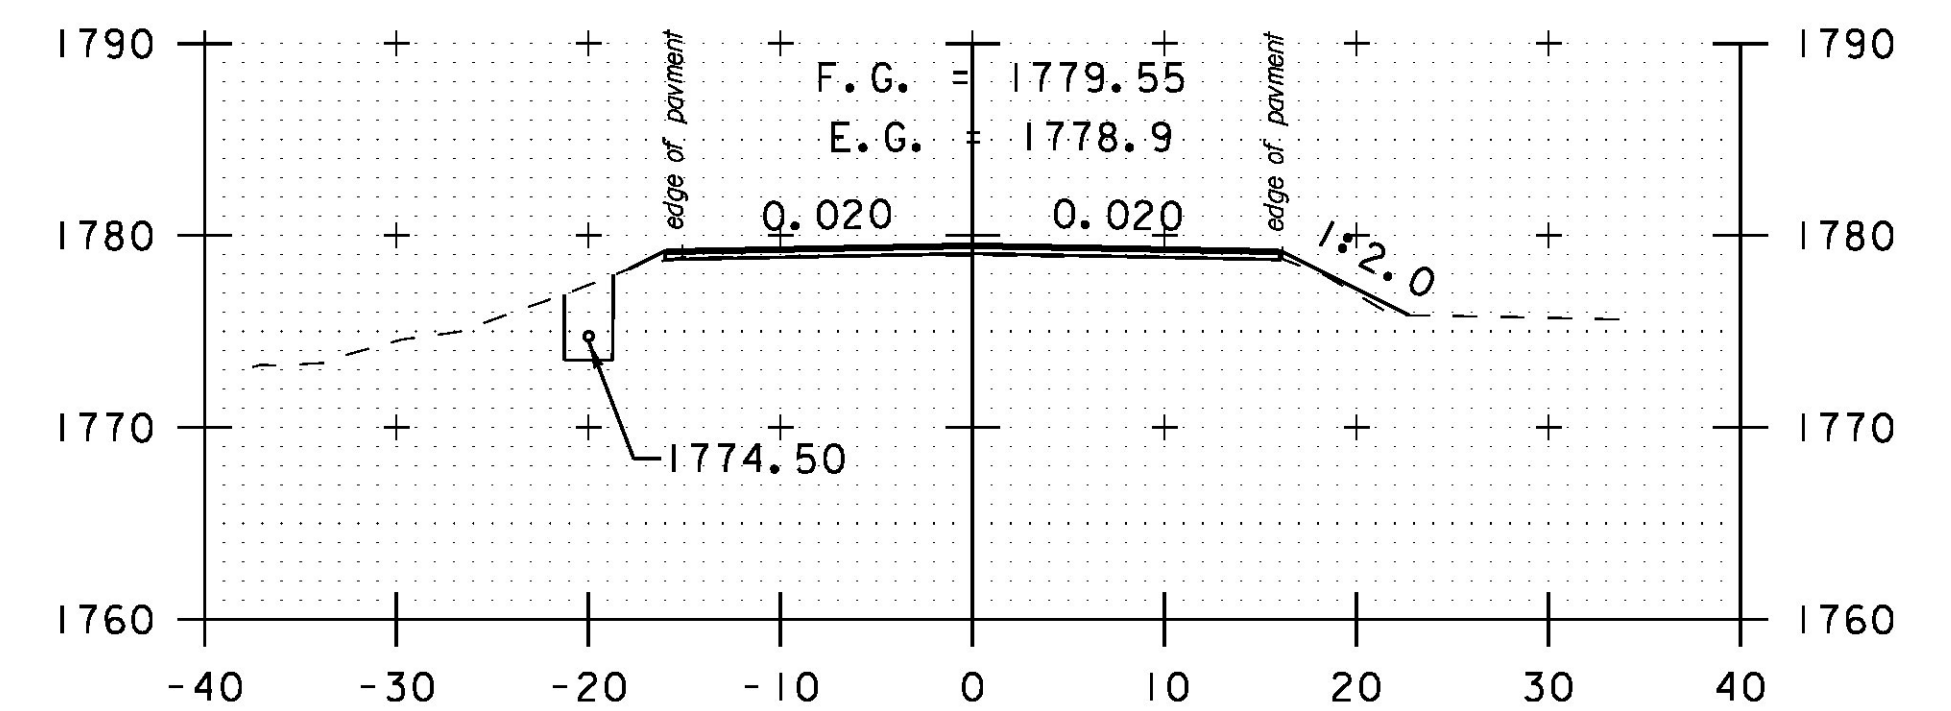

93+00

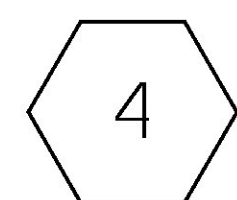

STA. 93+71.27 19.53' LT
REPAIR HEADWALL

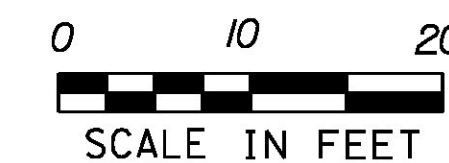

SCALE IN FEET

PROJECT NAME: HANCOCK
PROJECT NUMBER: STP 2923 (1)

FILE NAME: z10c252x.s.dgn
PROJECT LEADER: C. LATHROP
DESIGNED BY: B. MARTIN
CROSS SECTION SHEET 11

PLOT DATE: 3/18/2015
DRAWN BY: B. MARTIN
CHECKED BY: C. LATHROP
SHEET 138 OF 207