




100+00

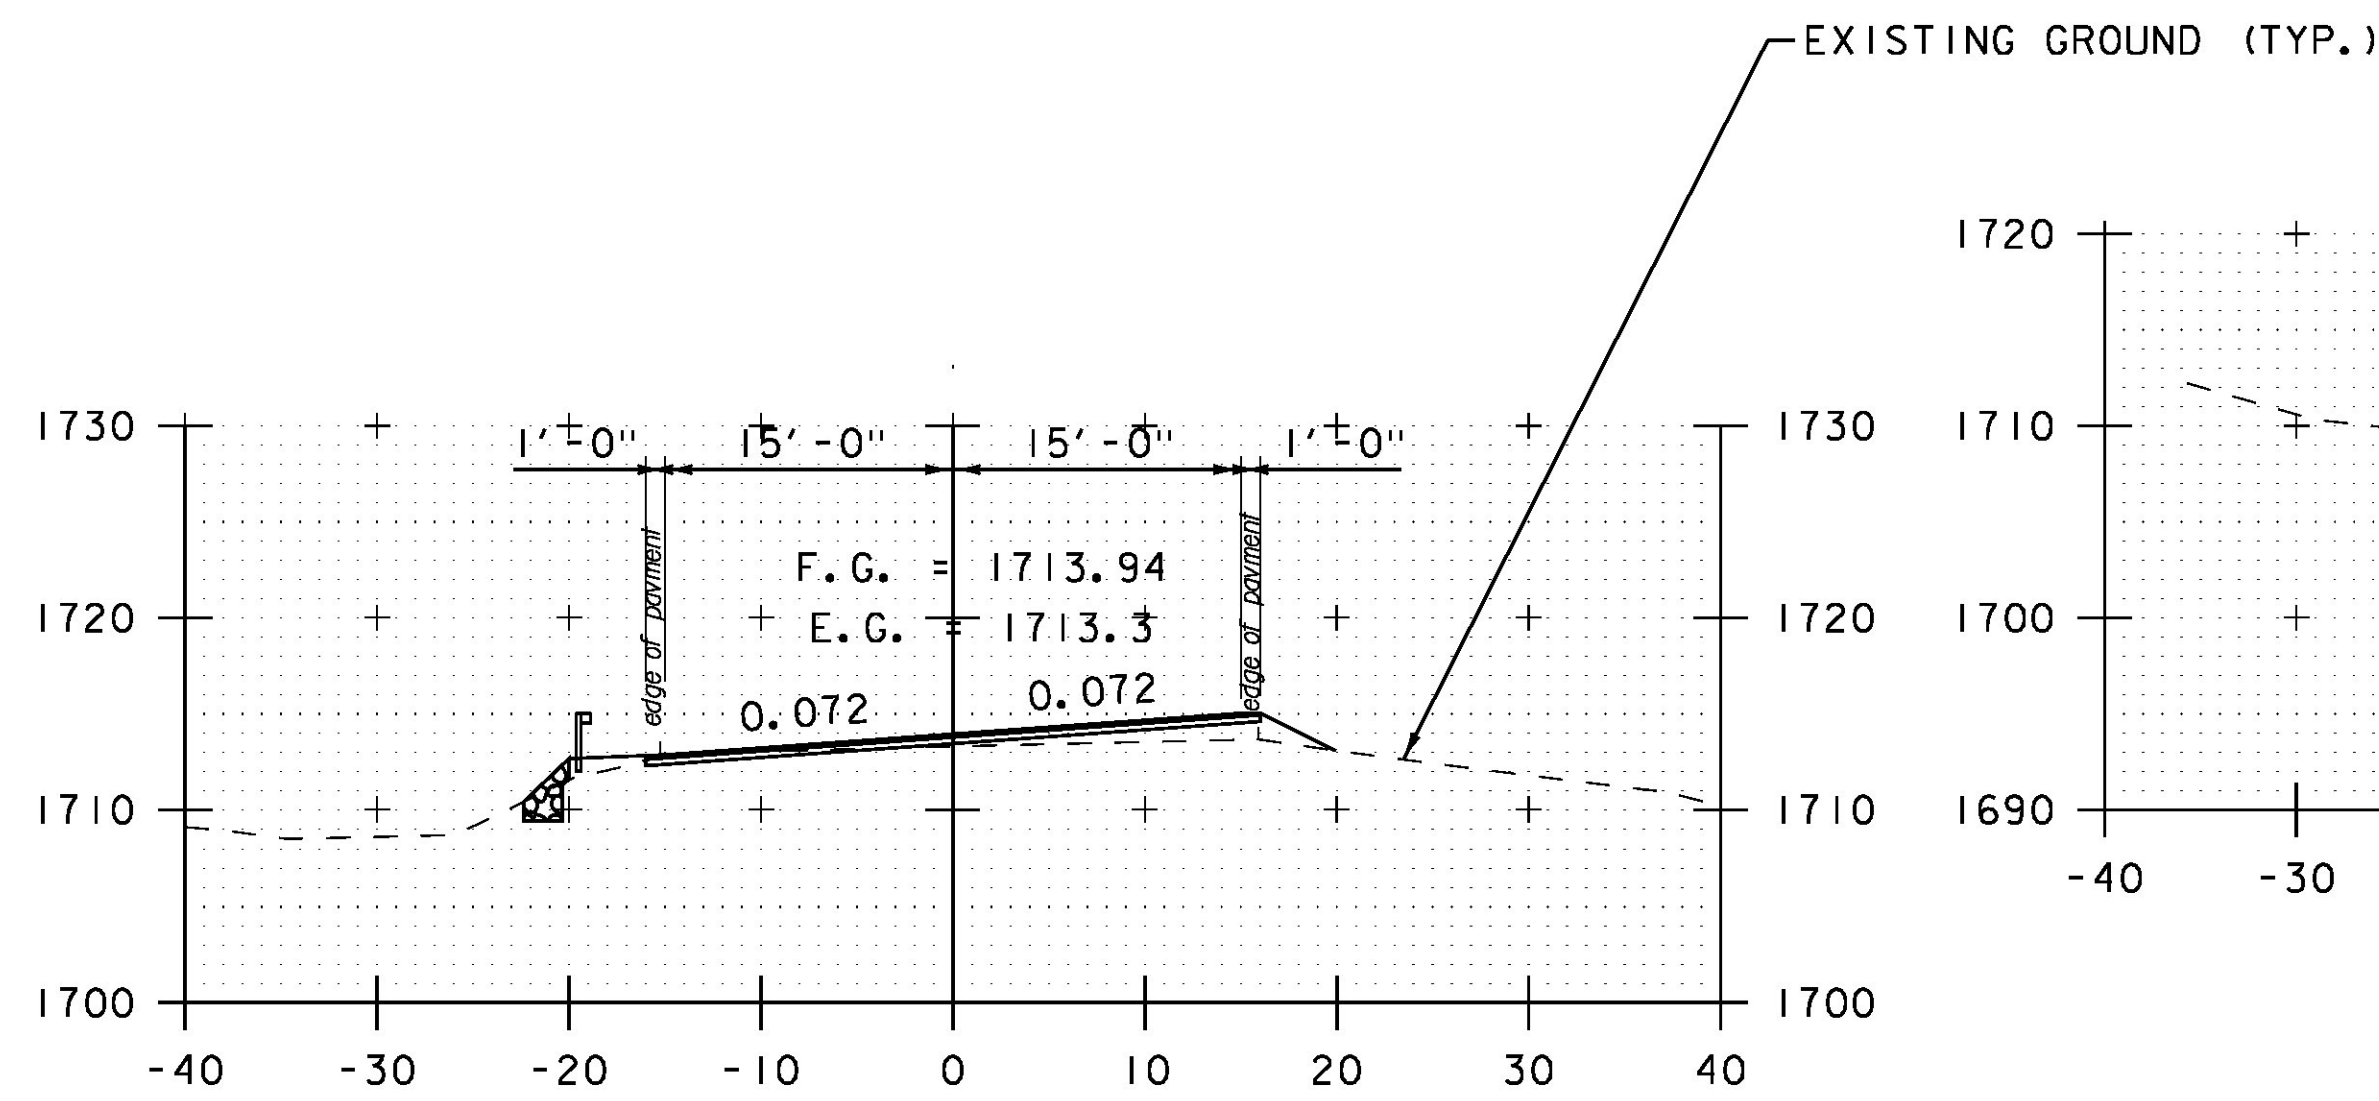


101+50

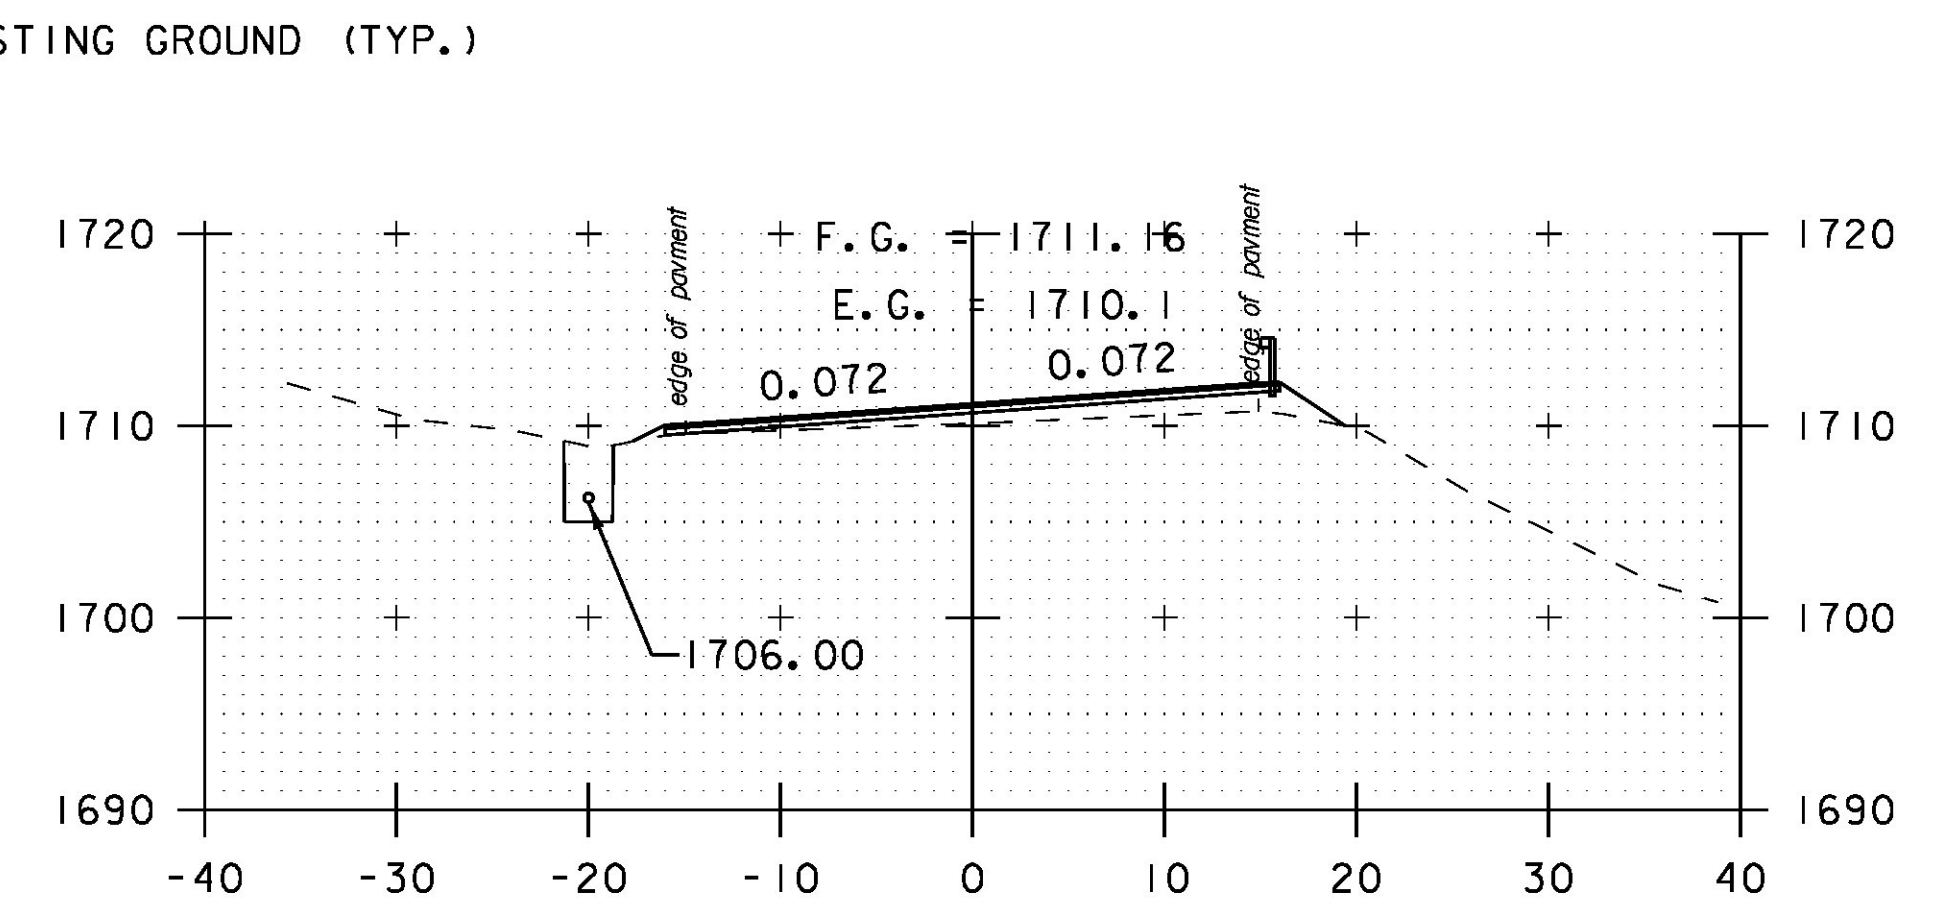


103+50

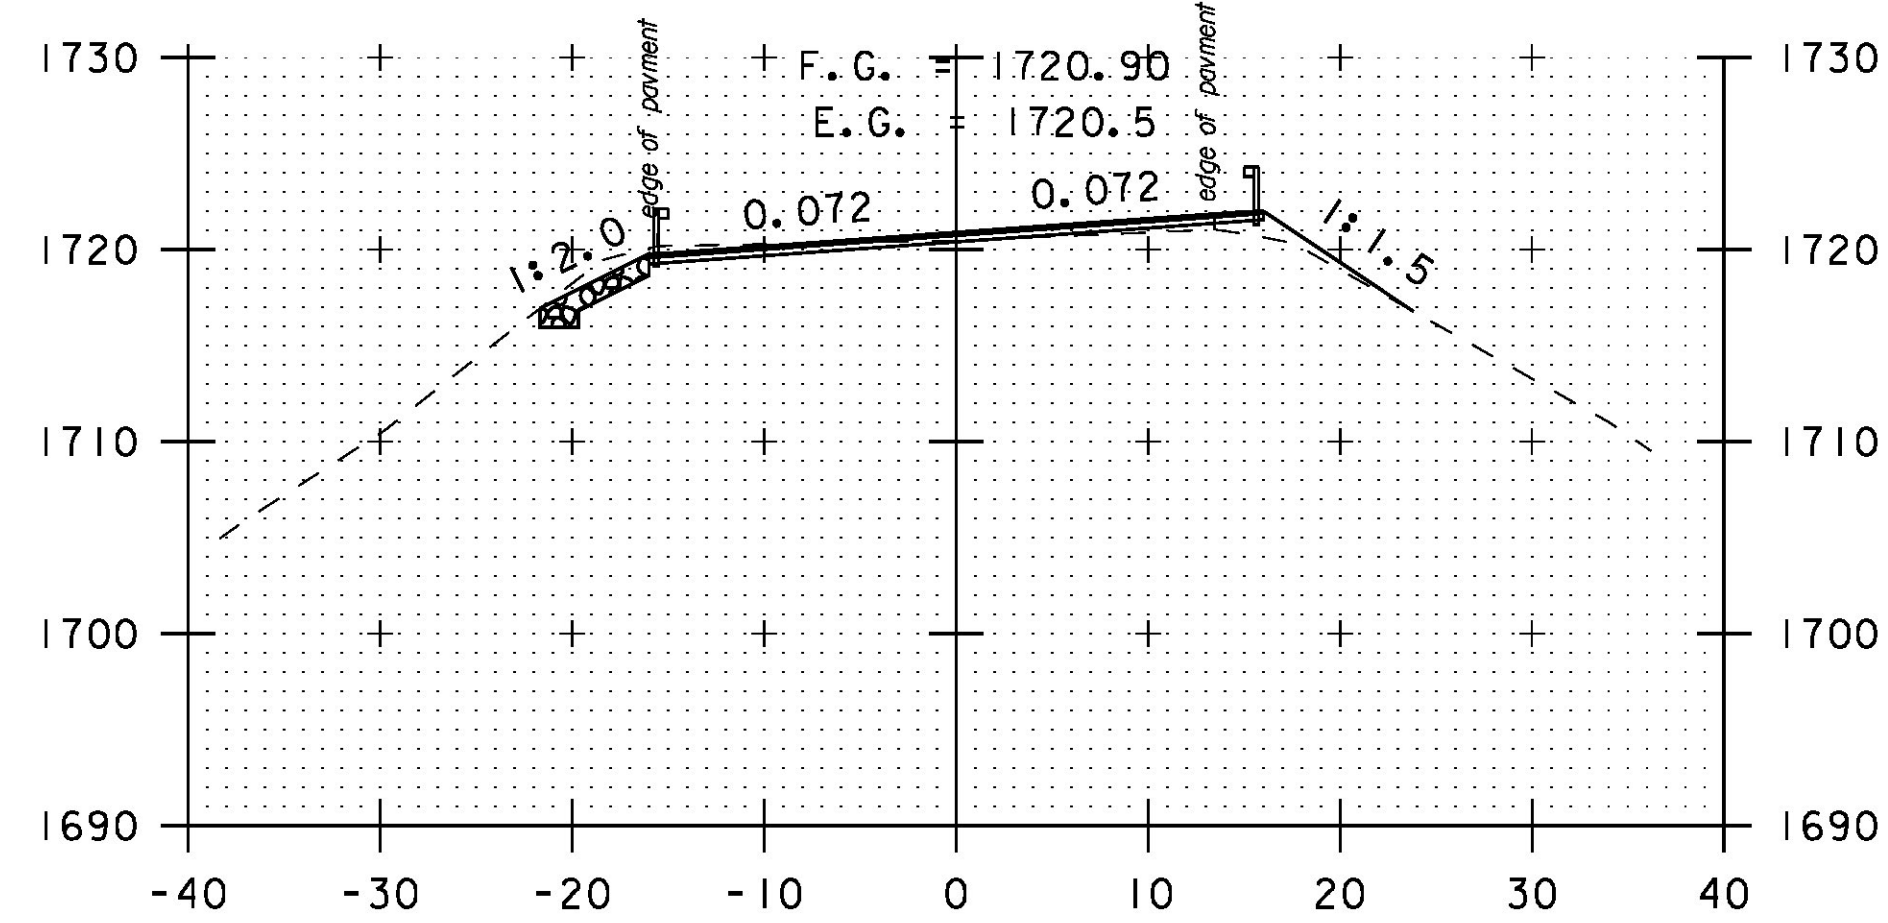


99+50

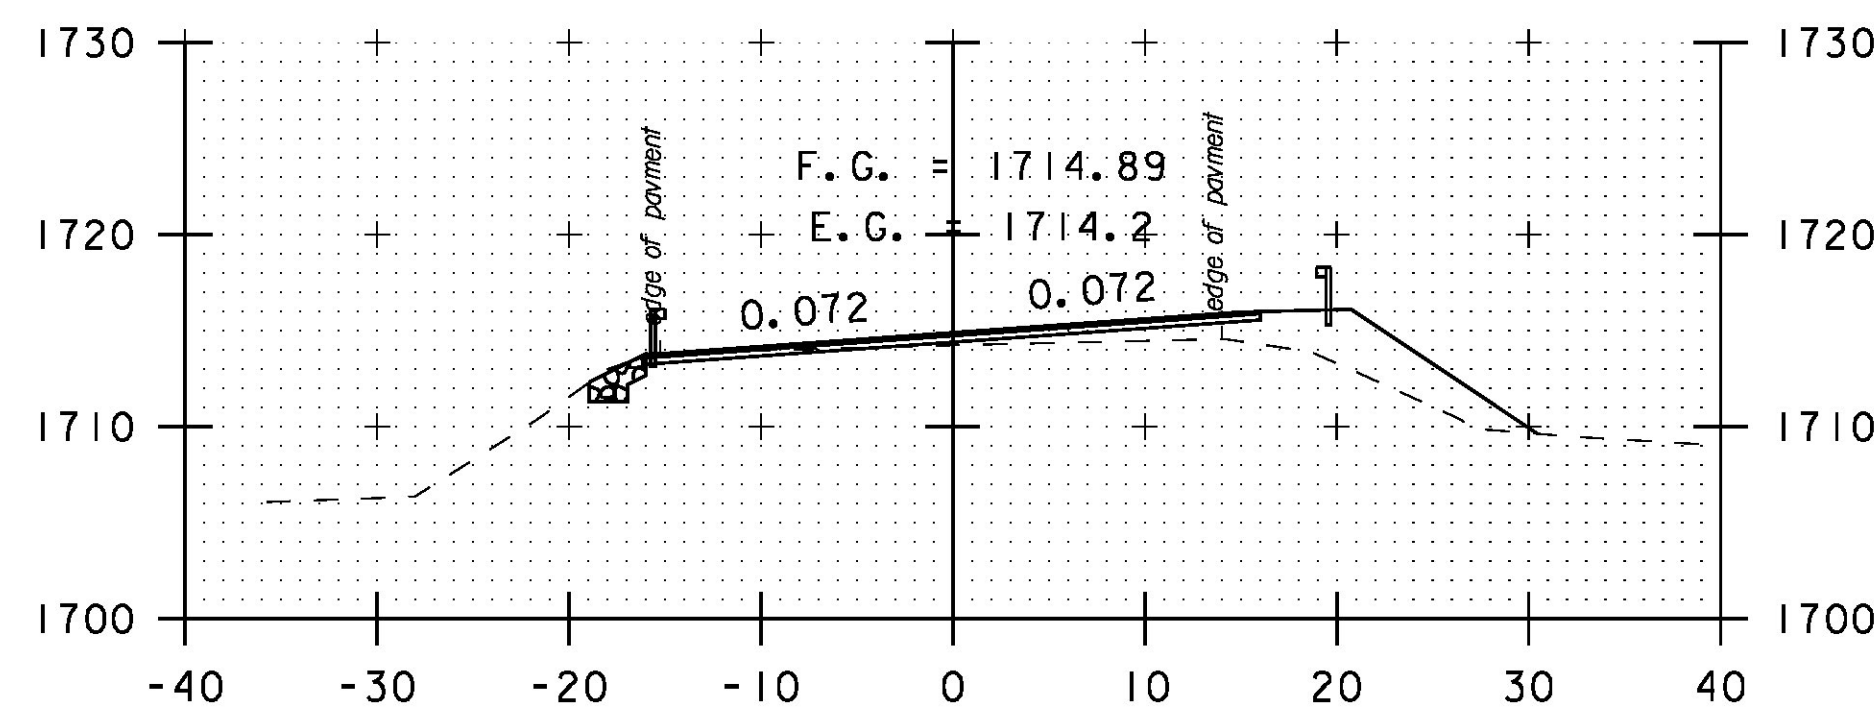


101+00

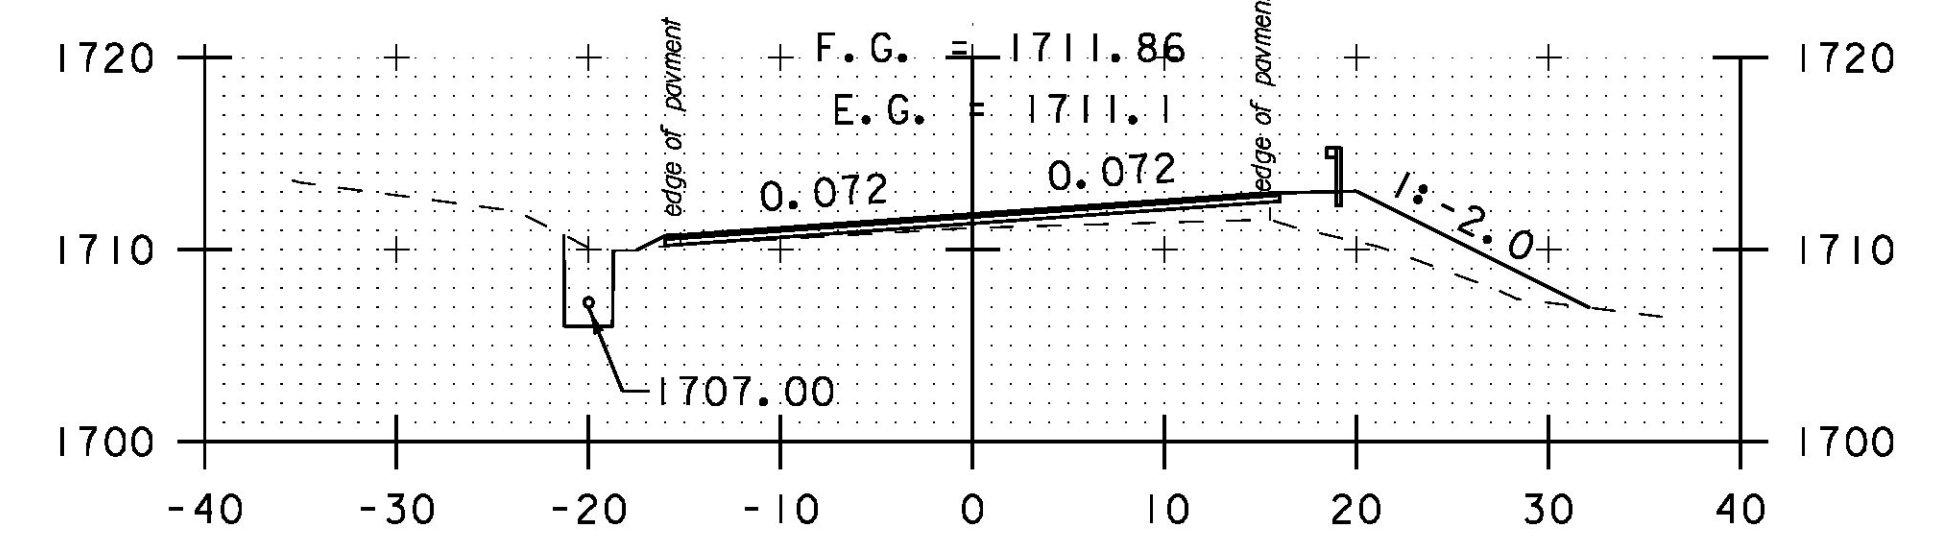


103+00

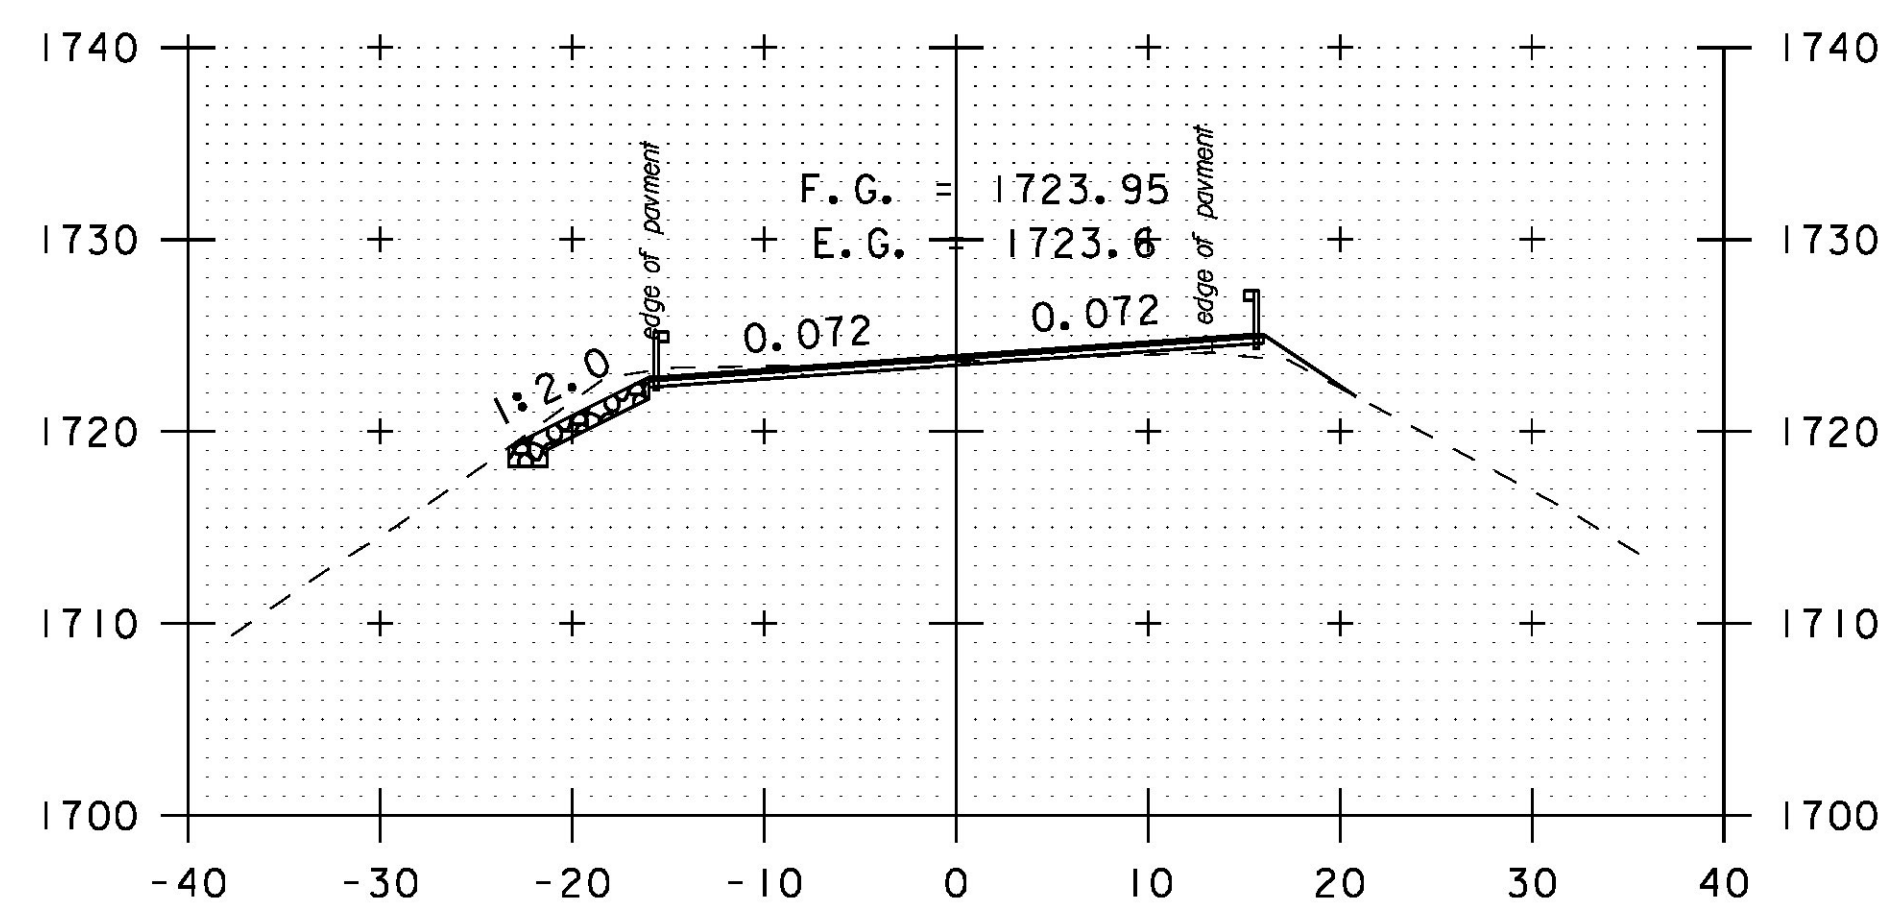


99+00

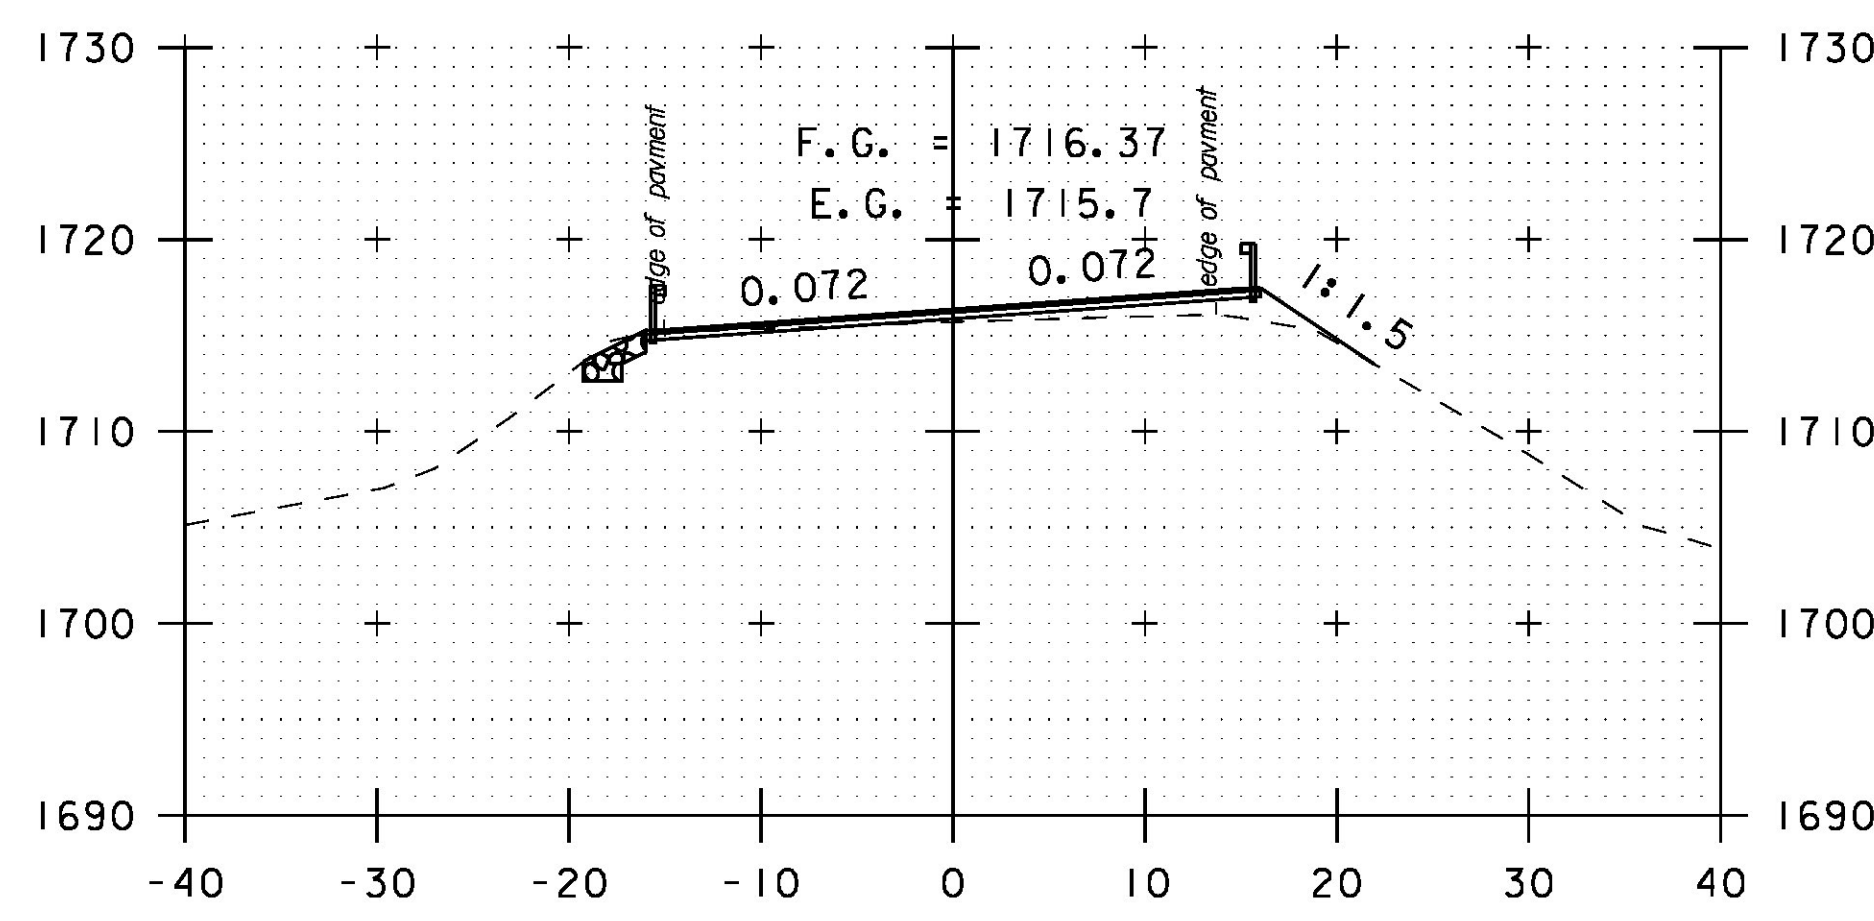

100+50

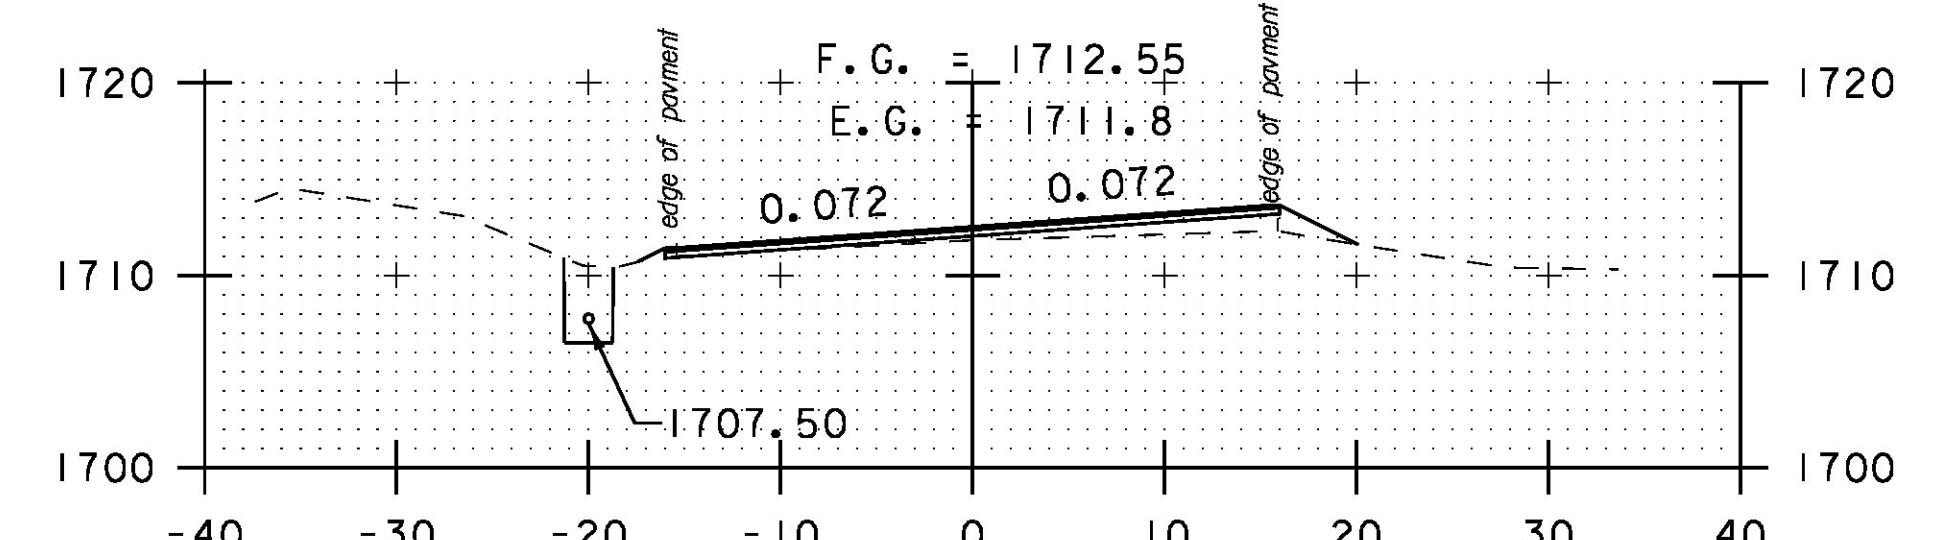

102+50

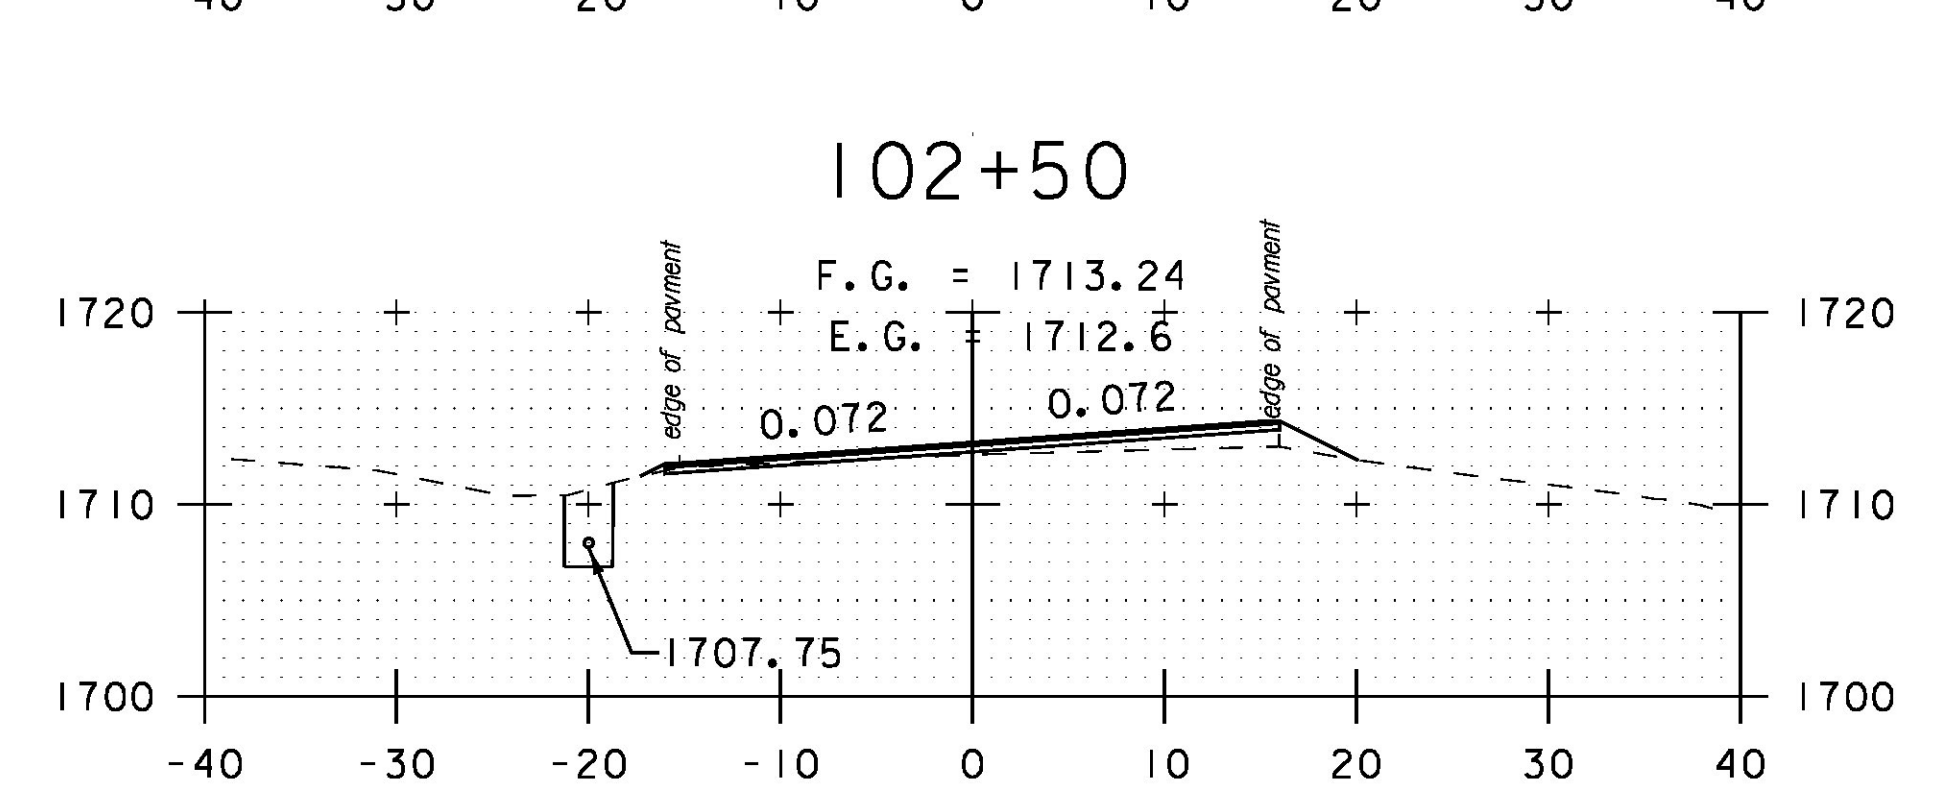

102+00



PROJECT NAME:	HANCOCK	PLOT DATE:	3/18/2015
PROJECT NUMBER:	STP 2923 (1)	DRAWN BY:	B. MARTIN
FILE NAME:	z10c252xs.dgn	DESIGNED BY:	B. MARTIN
PROJECT LEADER:	C. LATHROP	CHECKED BY:	C. LATHROP
CROSS SECTION SHEET:	13	SHEET:	140 OF 207