




109+00

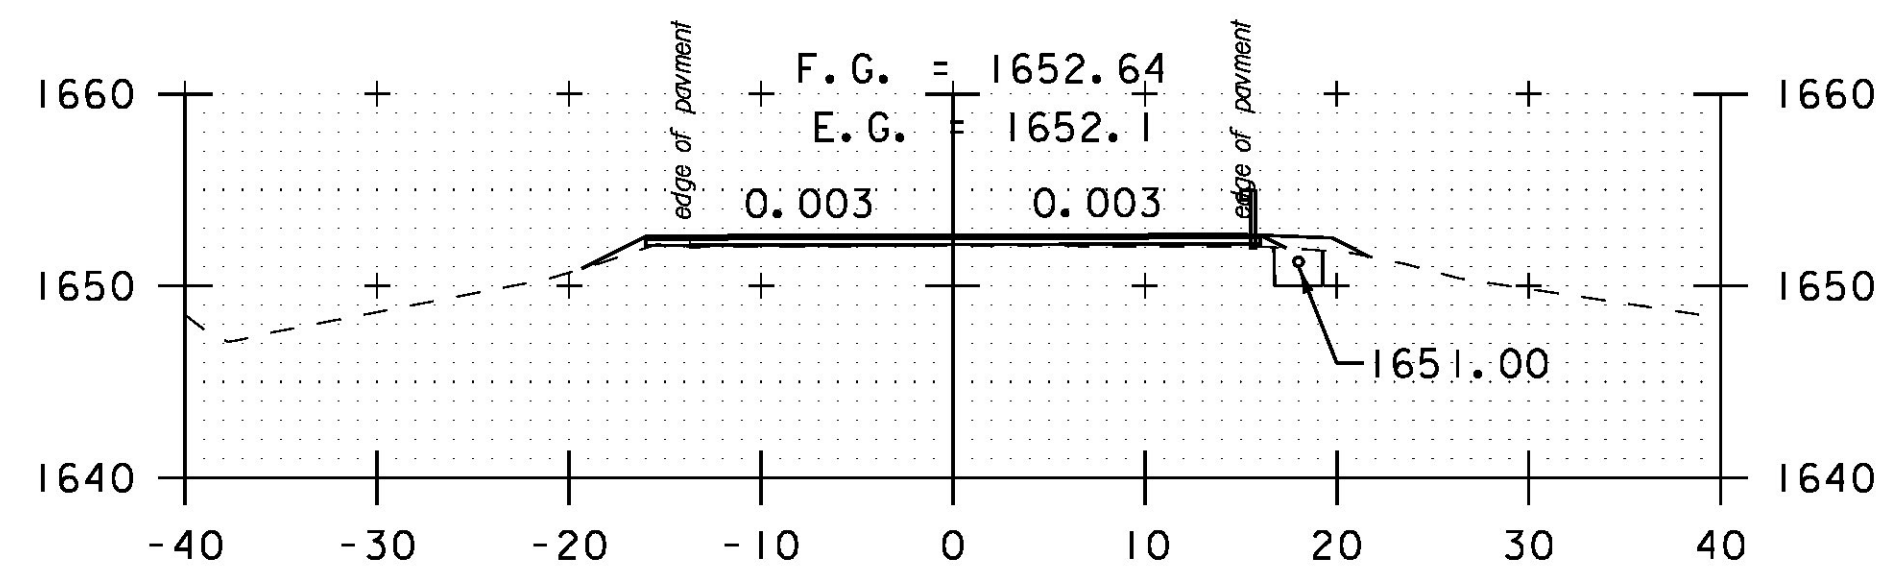


111+00

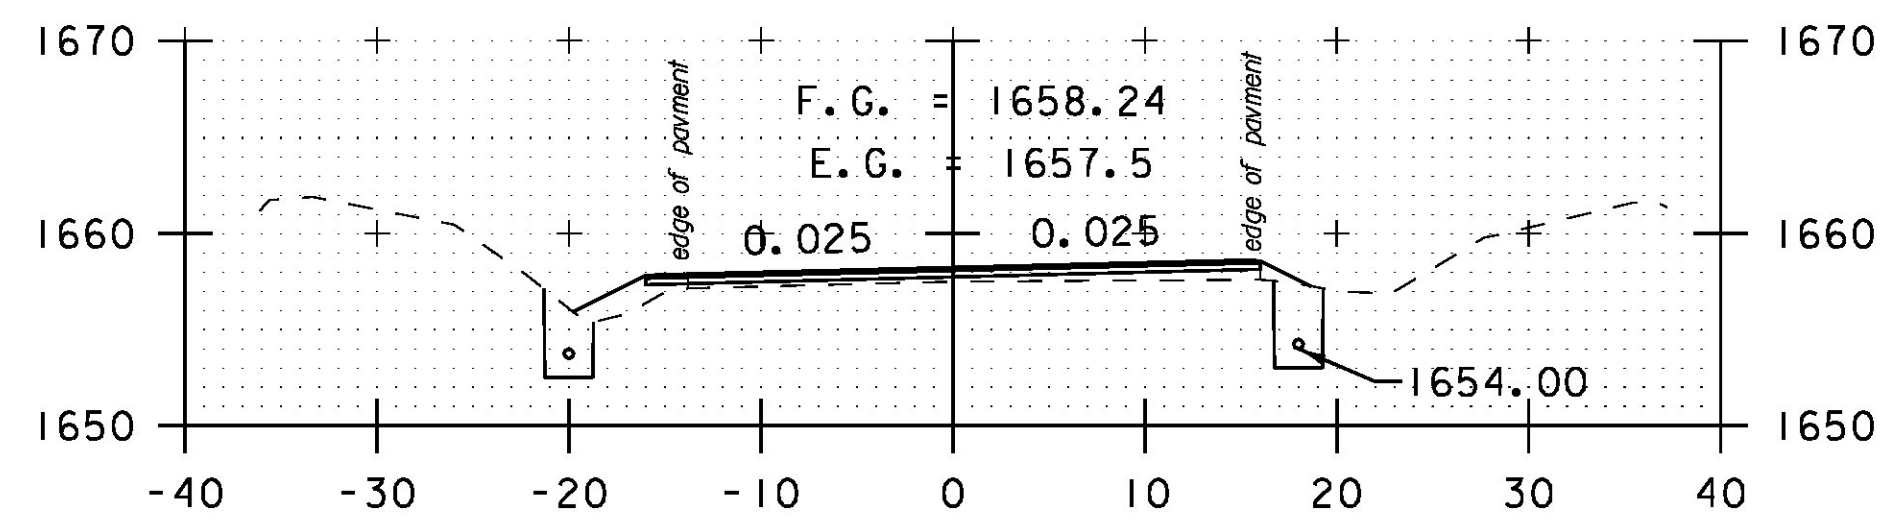


110+50

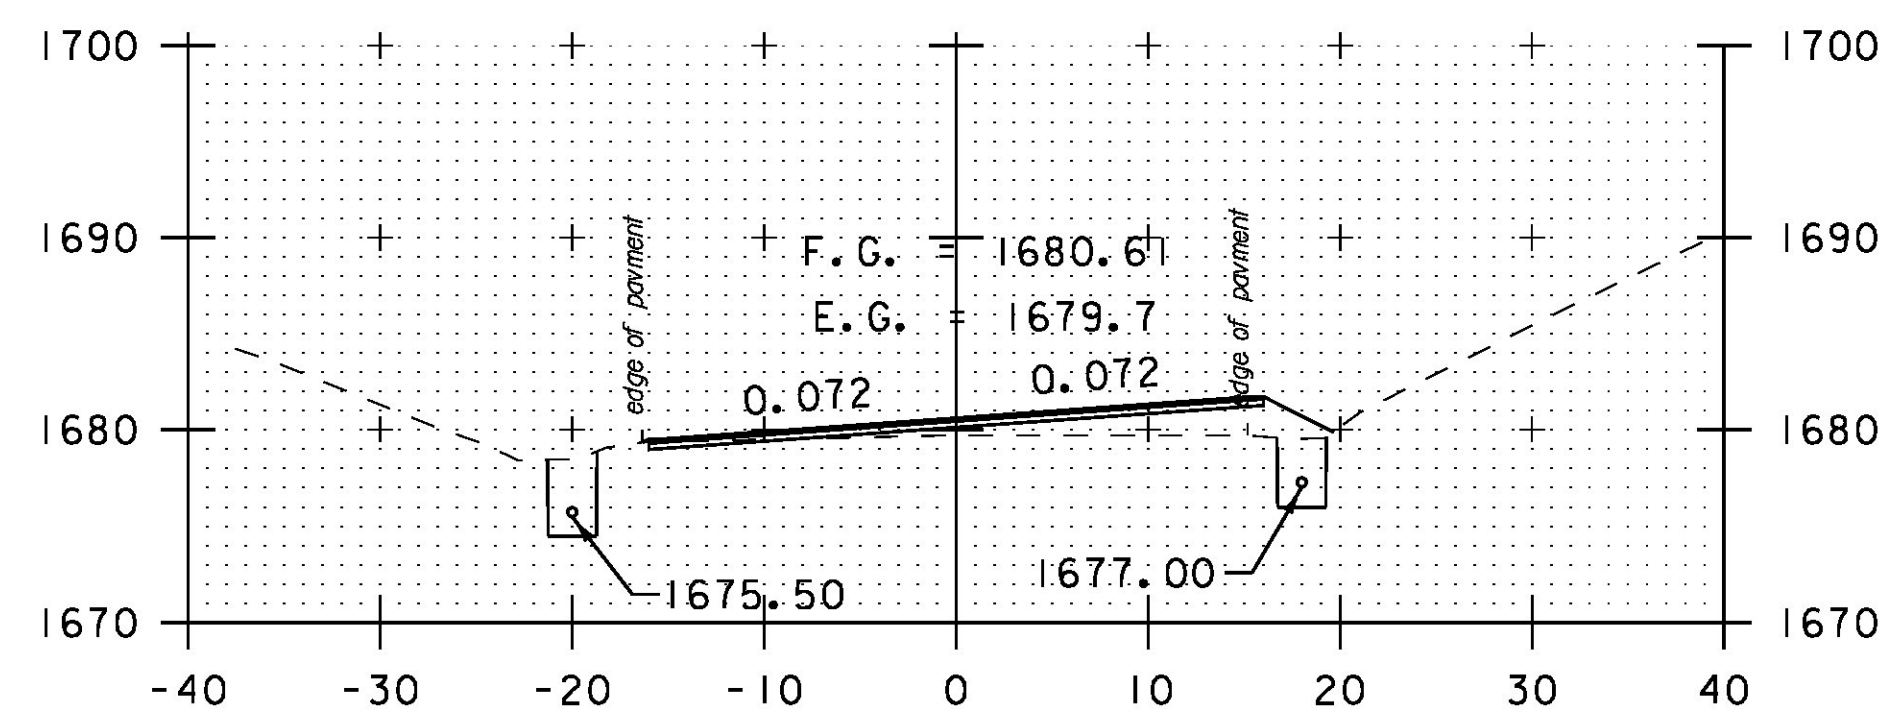


108+50

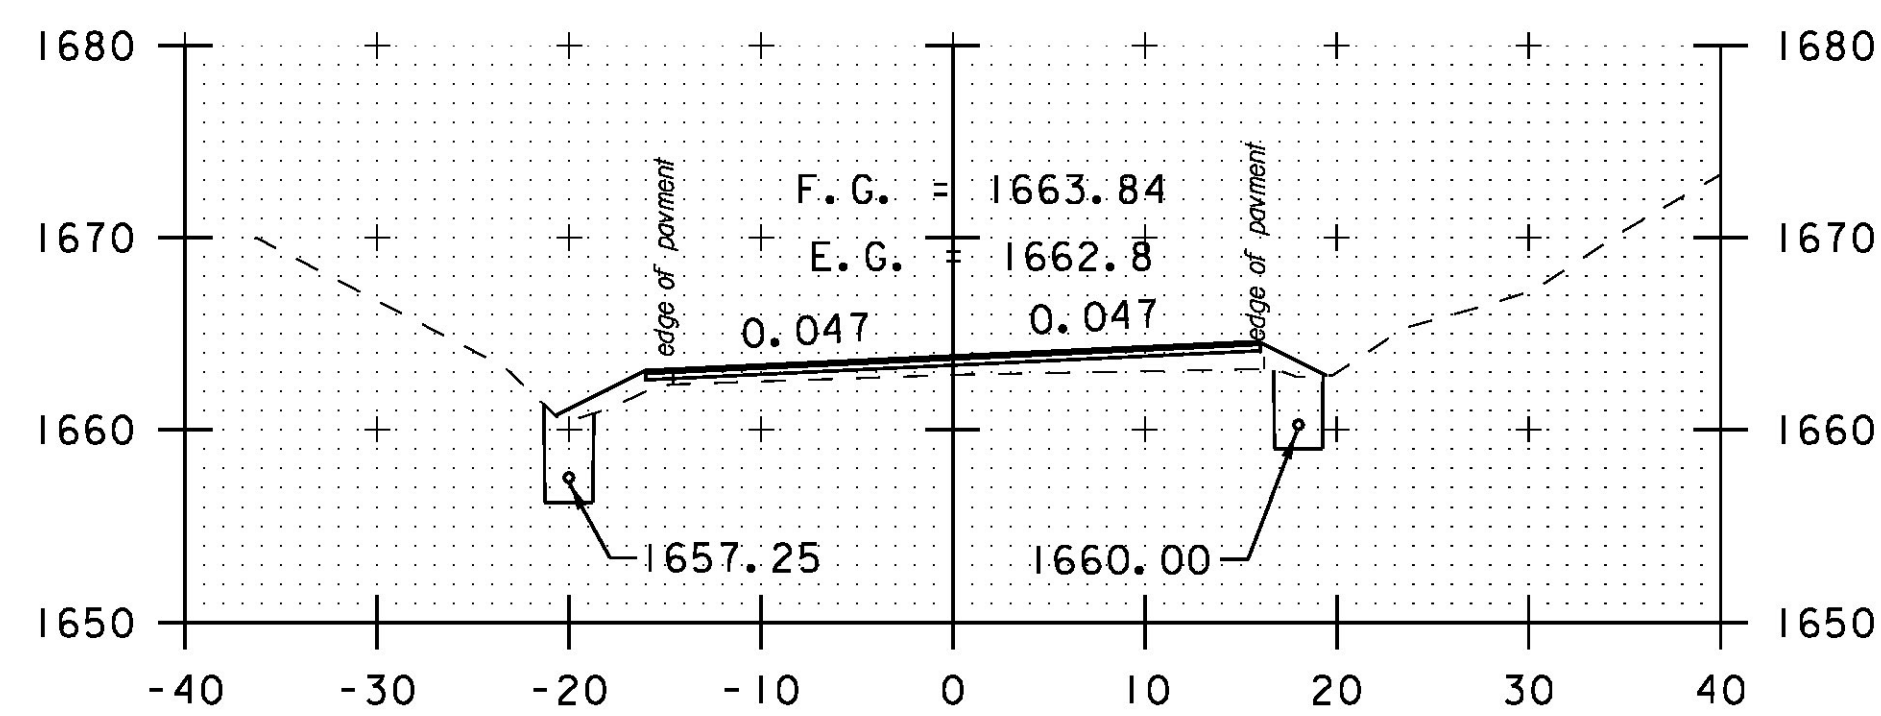


110+00

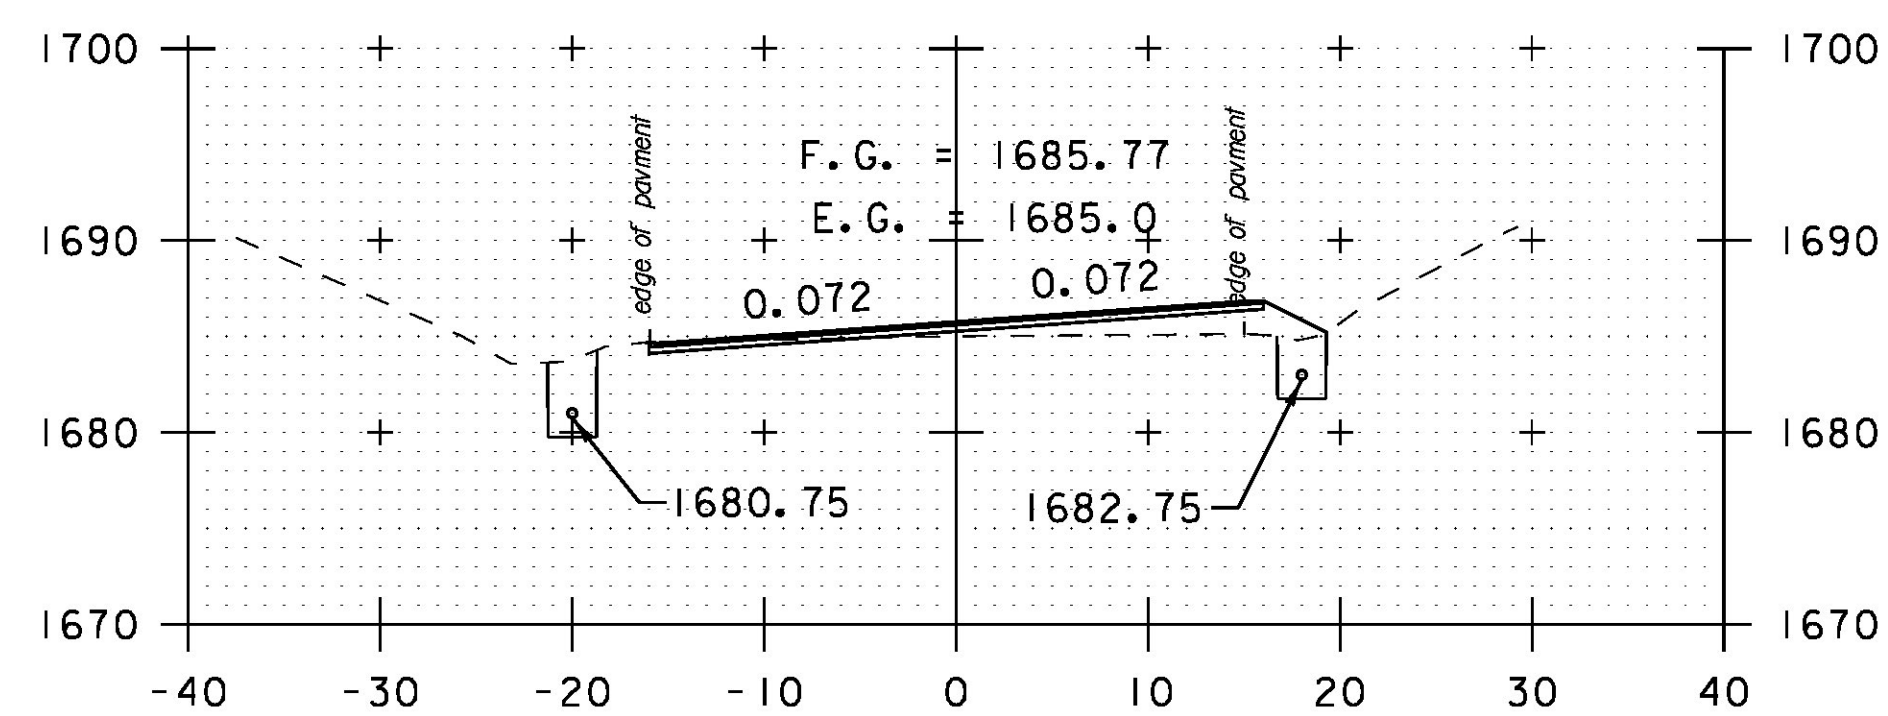

108+00

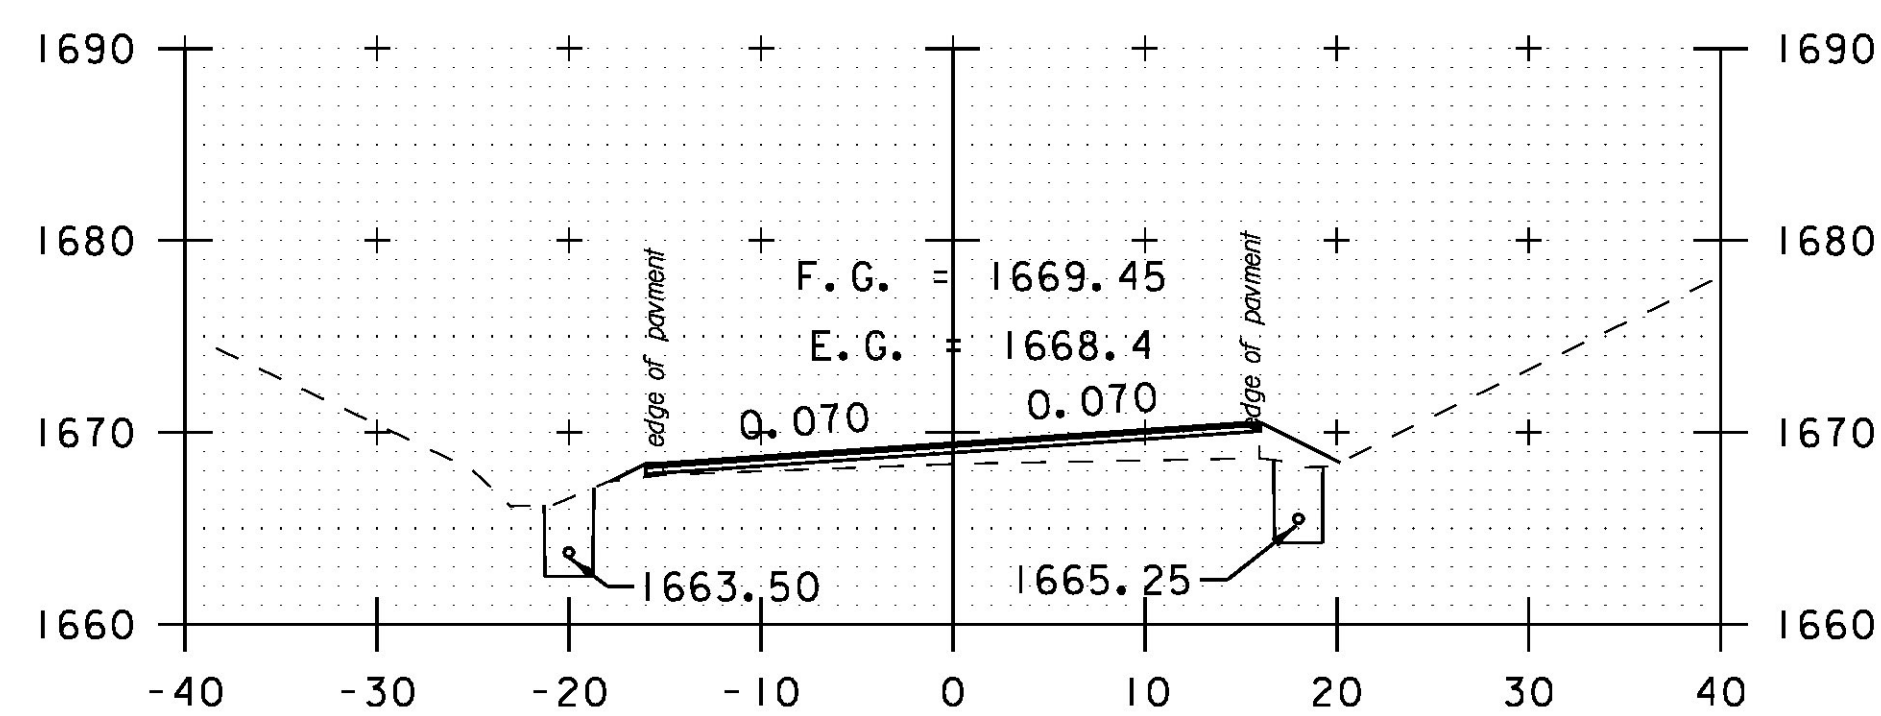

109+50

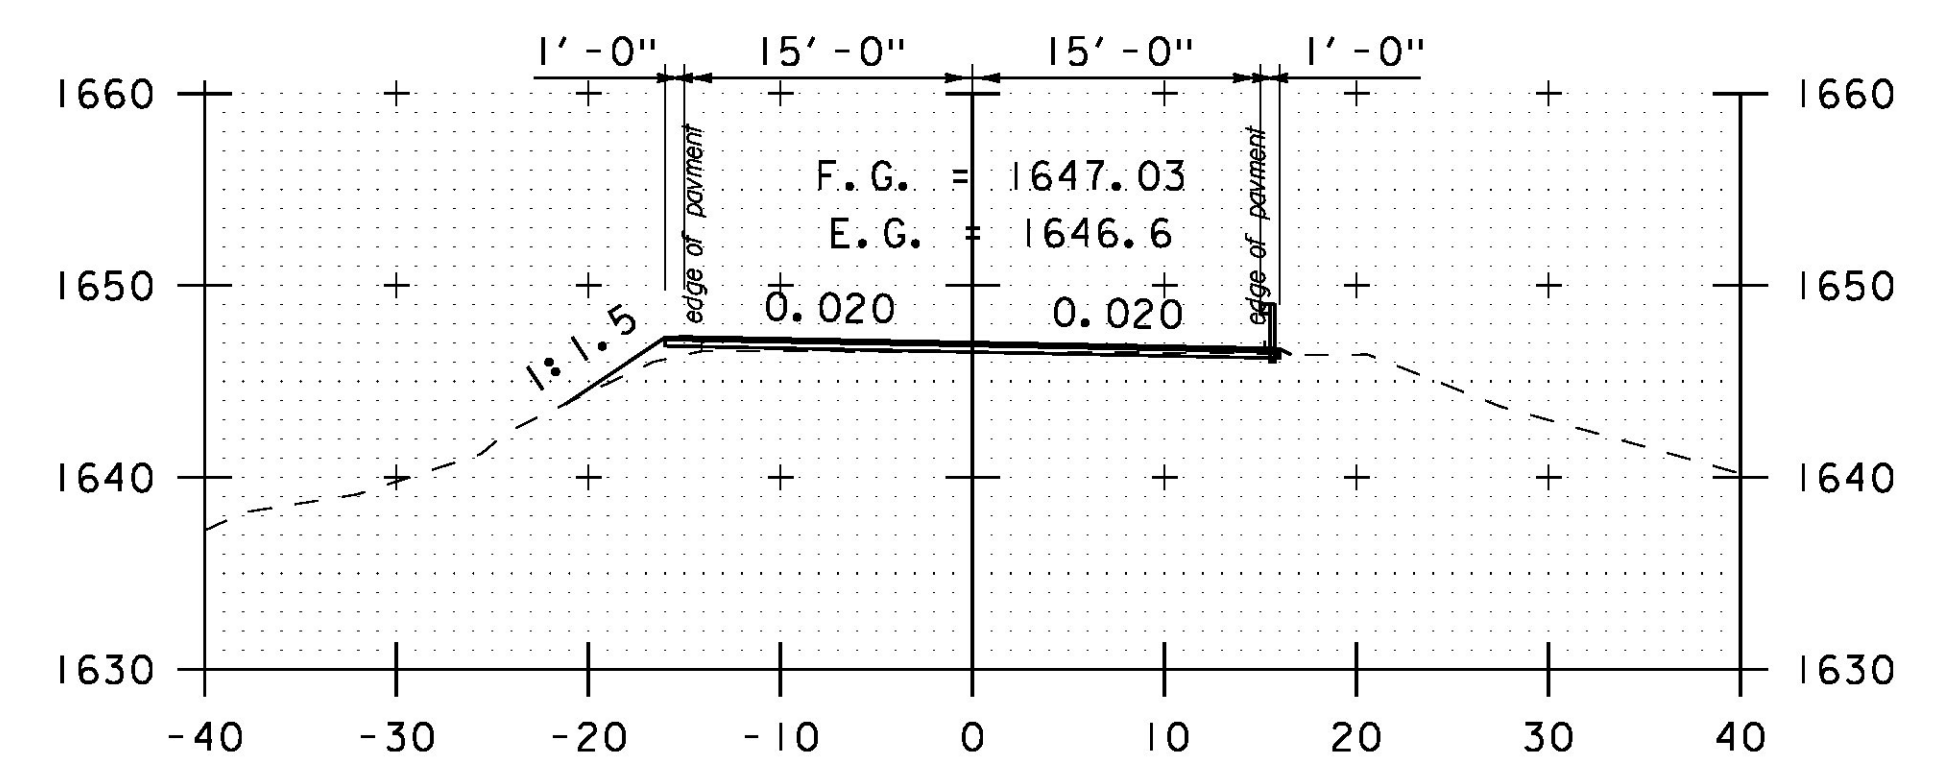

111+50



PROJECT NAME: HANCOCK	PLOT DATE: 3/18/2015
PROJECT NUMBER: STP 2923 (1)	DRAWN BY: B. MARTIN
FILE NAME: z10c252xs.dgn	CHECKED BY: C. LATHROP
PROJECT LEADER: C. LATHROP	SHEET 142 OF 207
DESIGNED BY: B. MARTIN	
CROSS SECTION SHEET 15	