




112+50

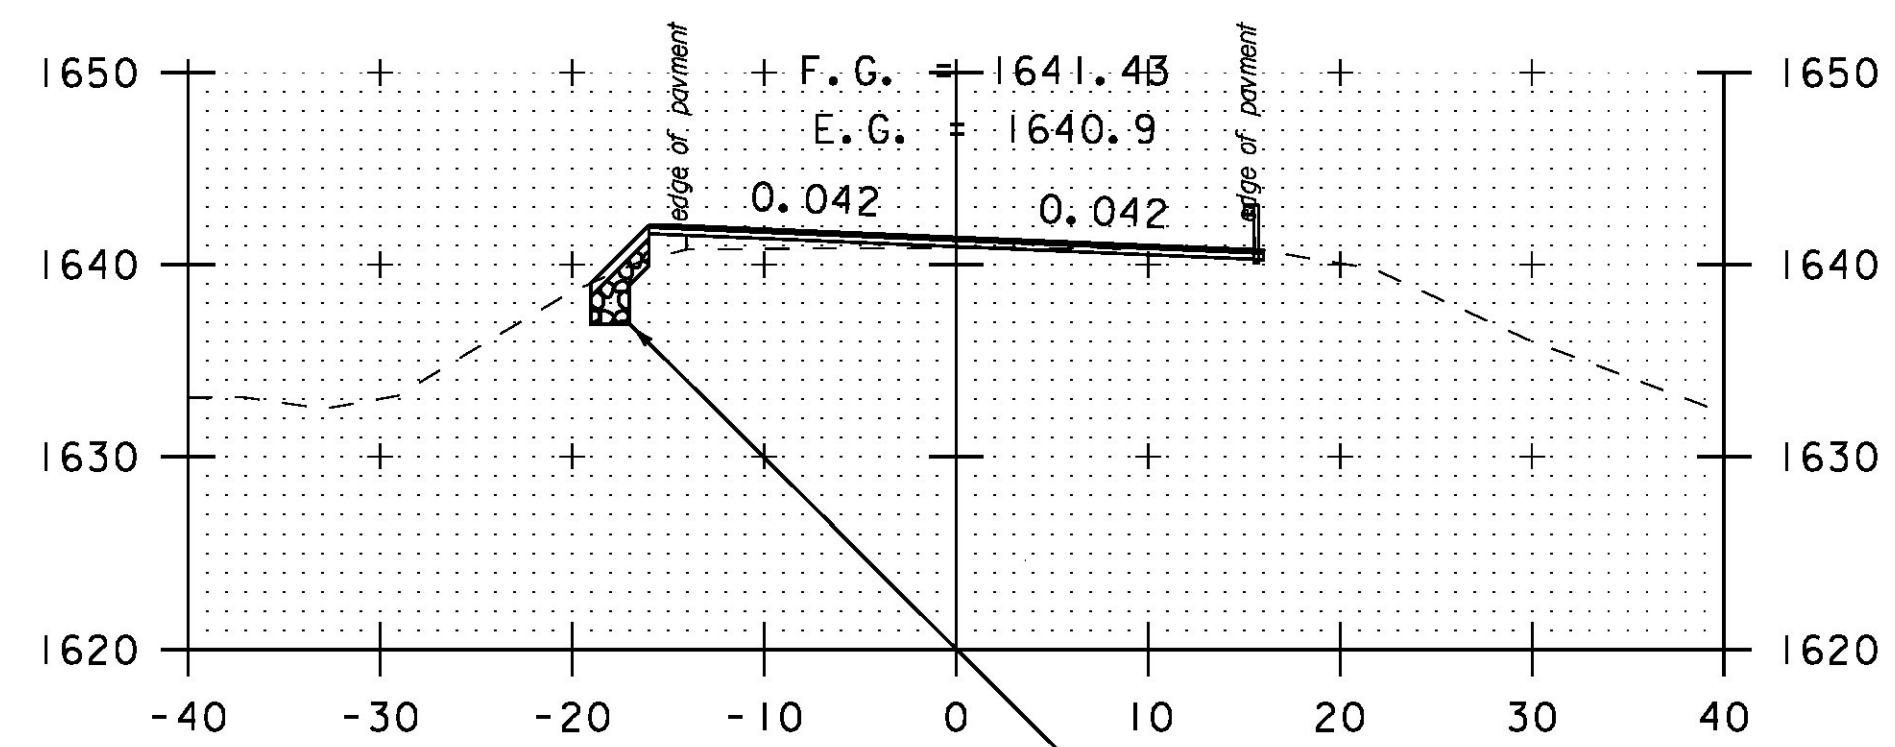


112+00

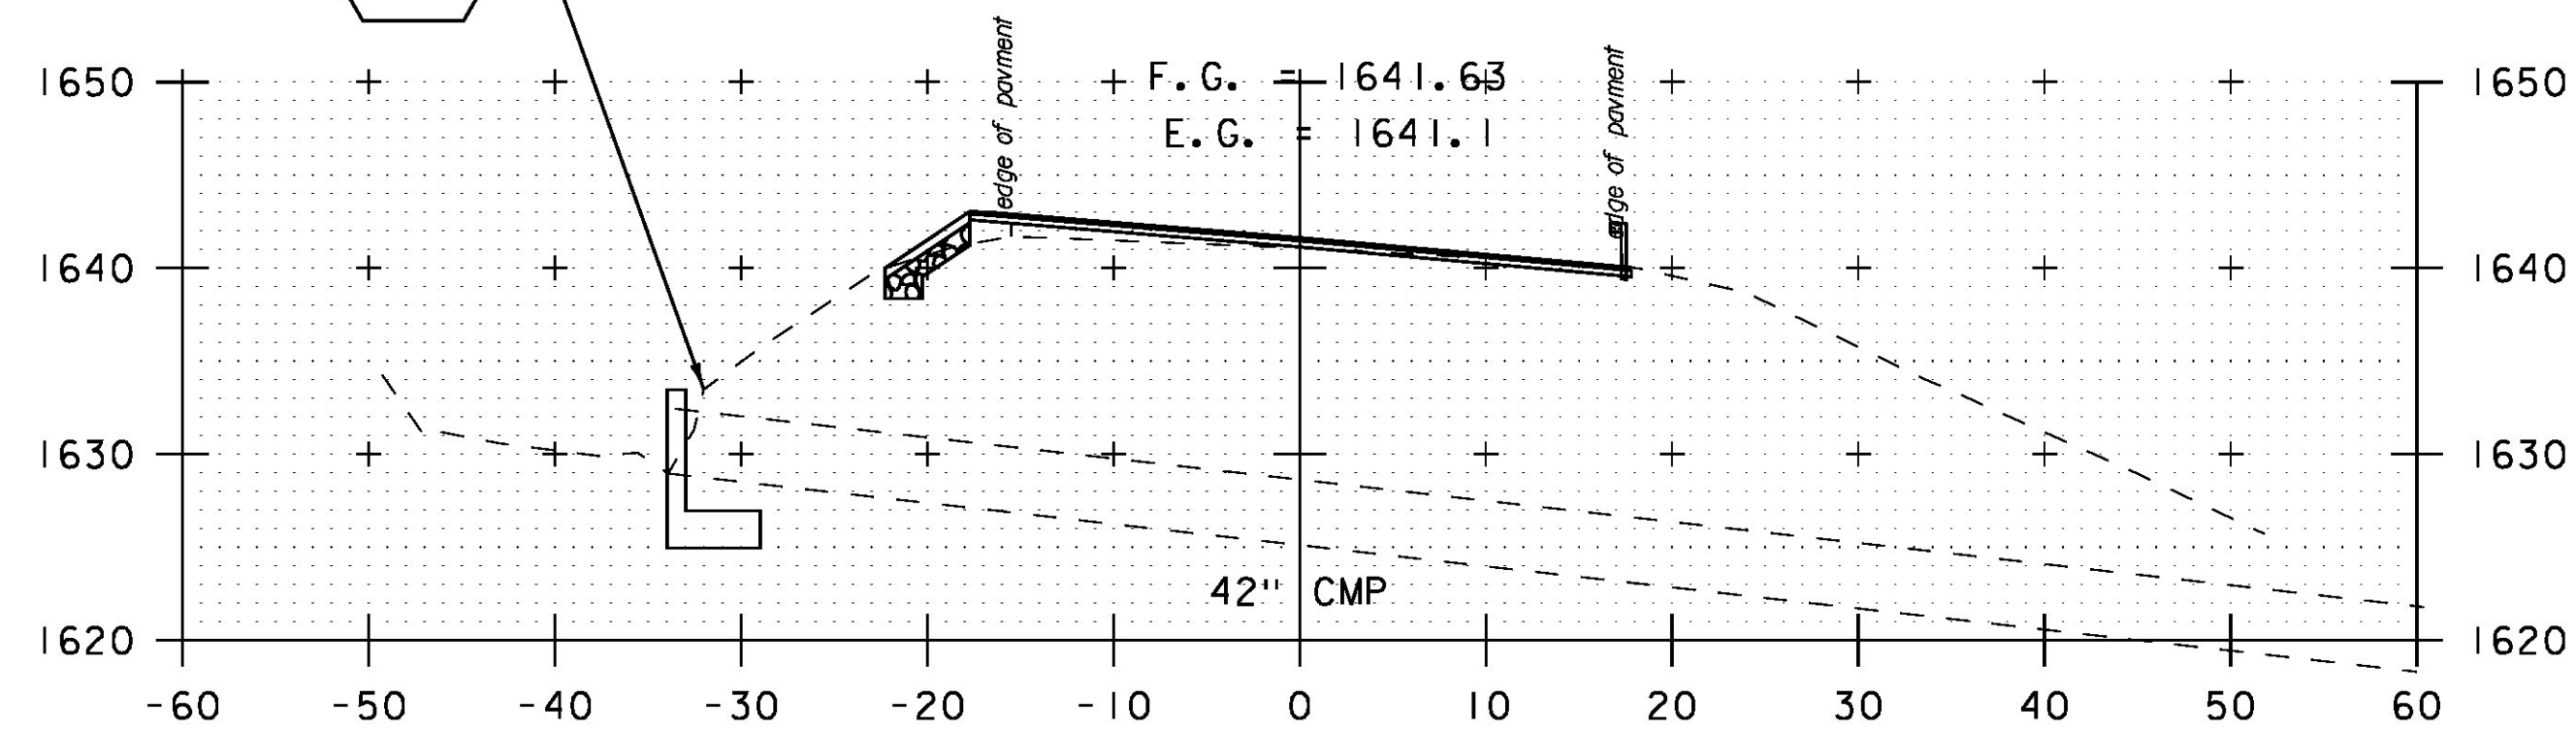


111+98

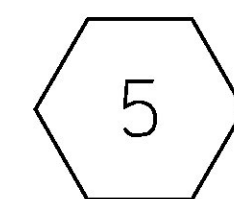


STA. 111+84.05 LT 30.75'
REMOVE EXISTING HEADWALL
CONSTRUCT CONCRETE REINFORCED
HEADWALL PER STD. D-33. USE
SCHEDULING AND DIMENSIONS FOR
48" PIPE RT
INV. IN = 1628.96
INV. OUT = 1618.21

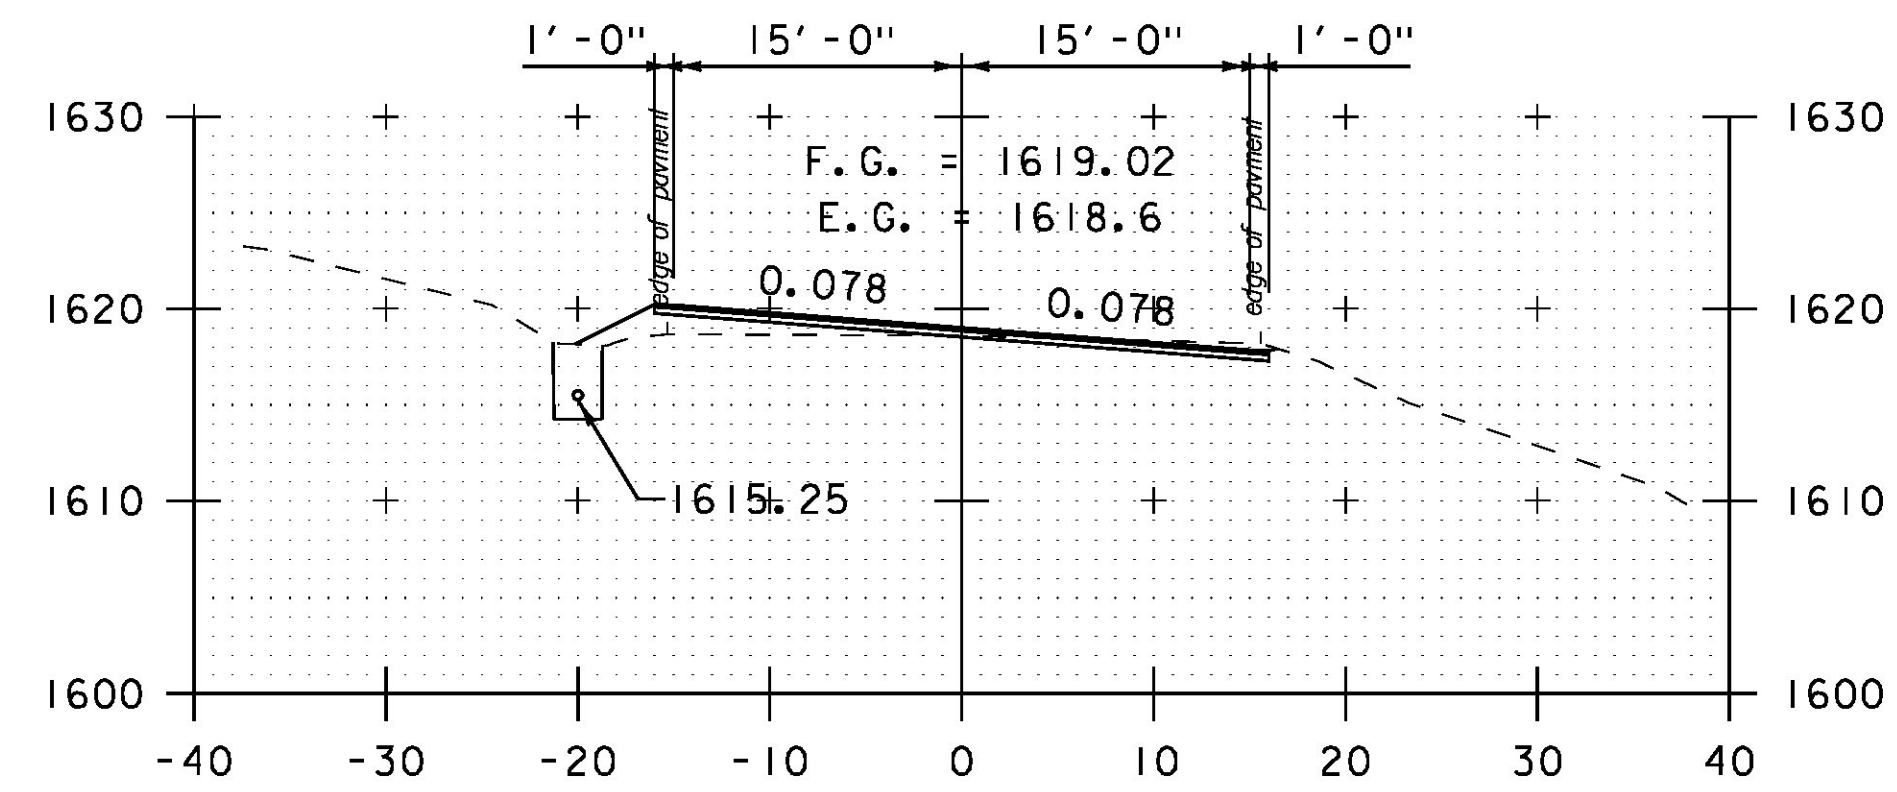

114+00

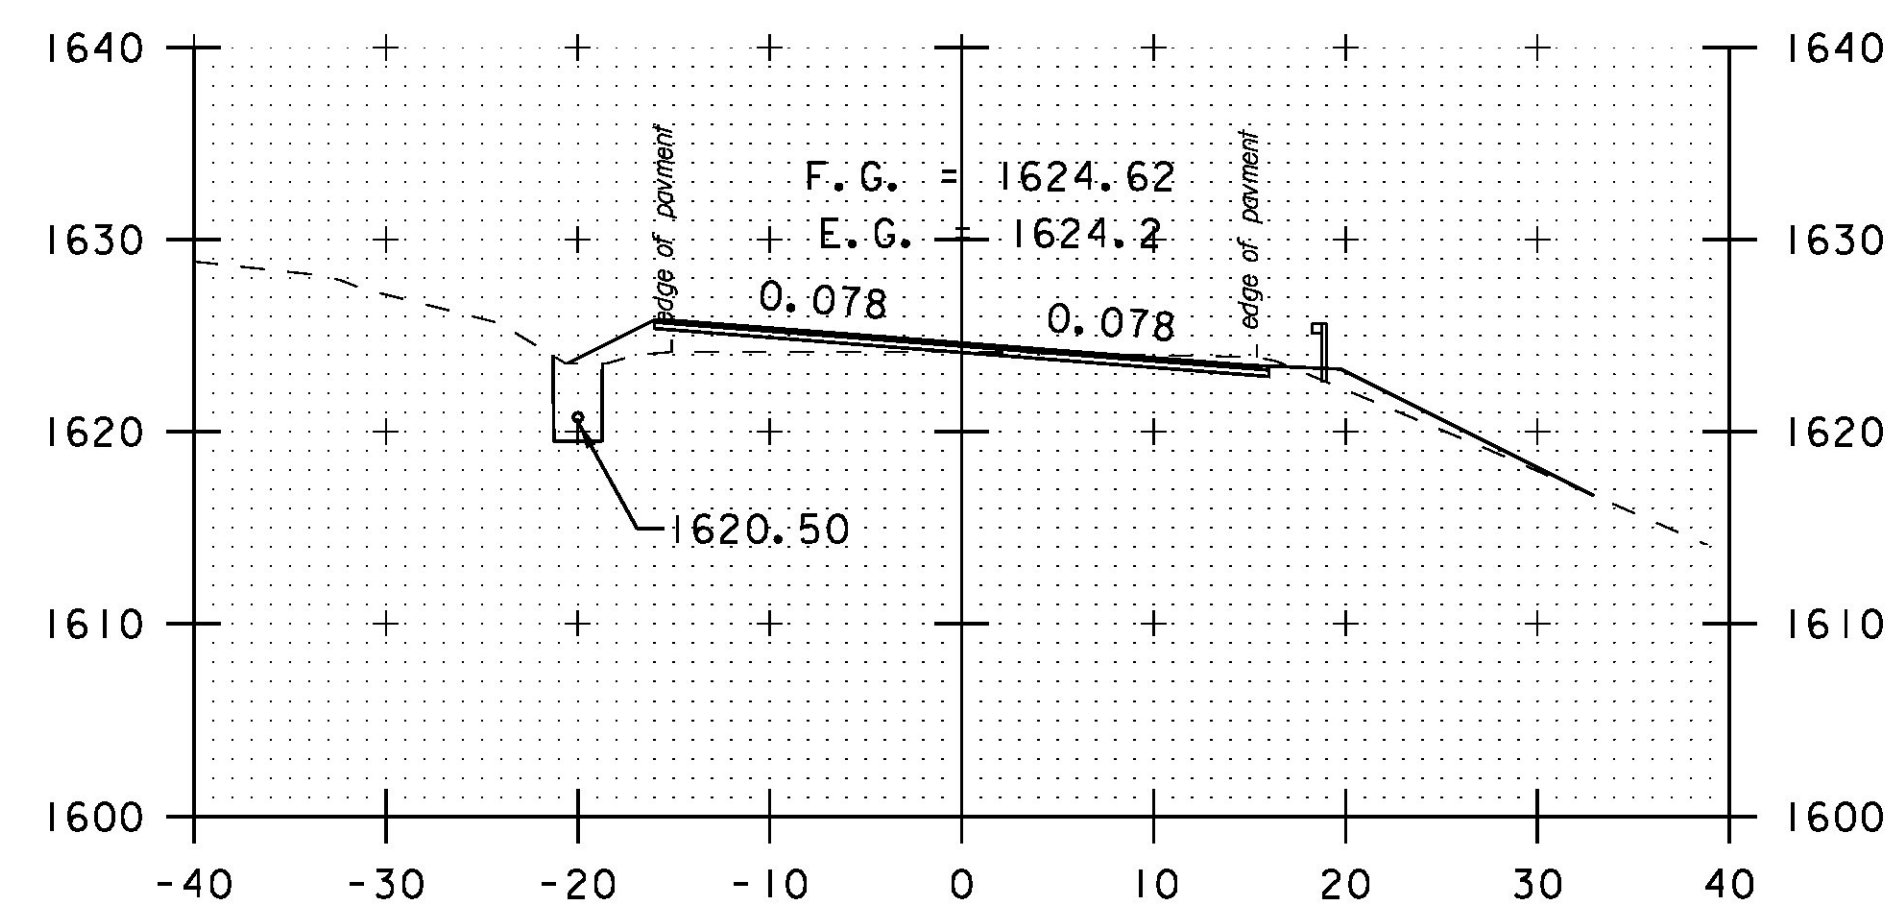

113+50

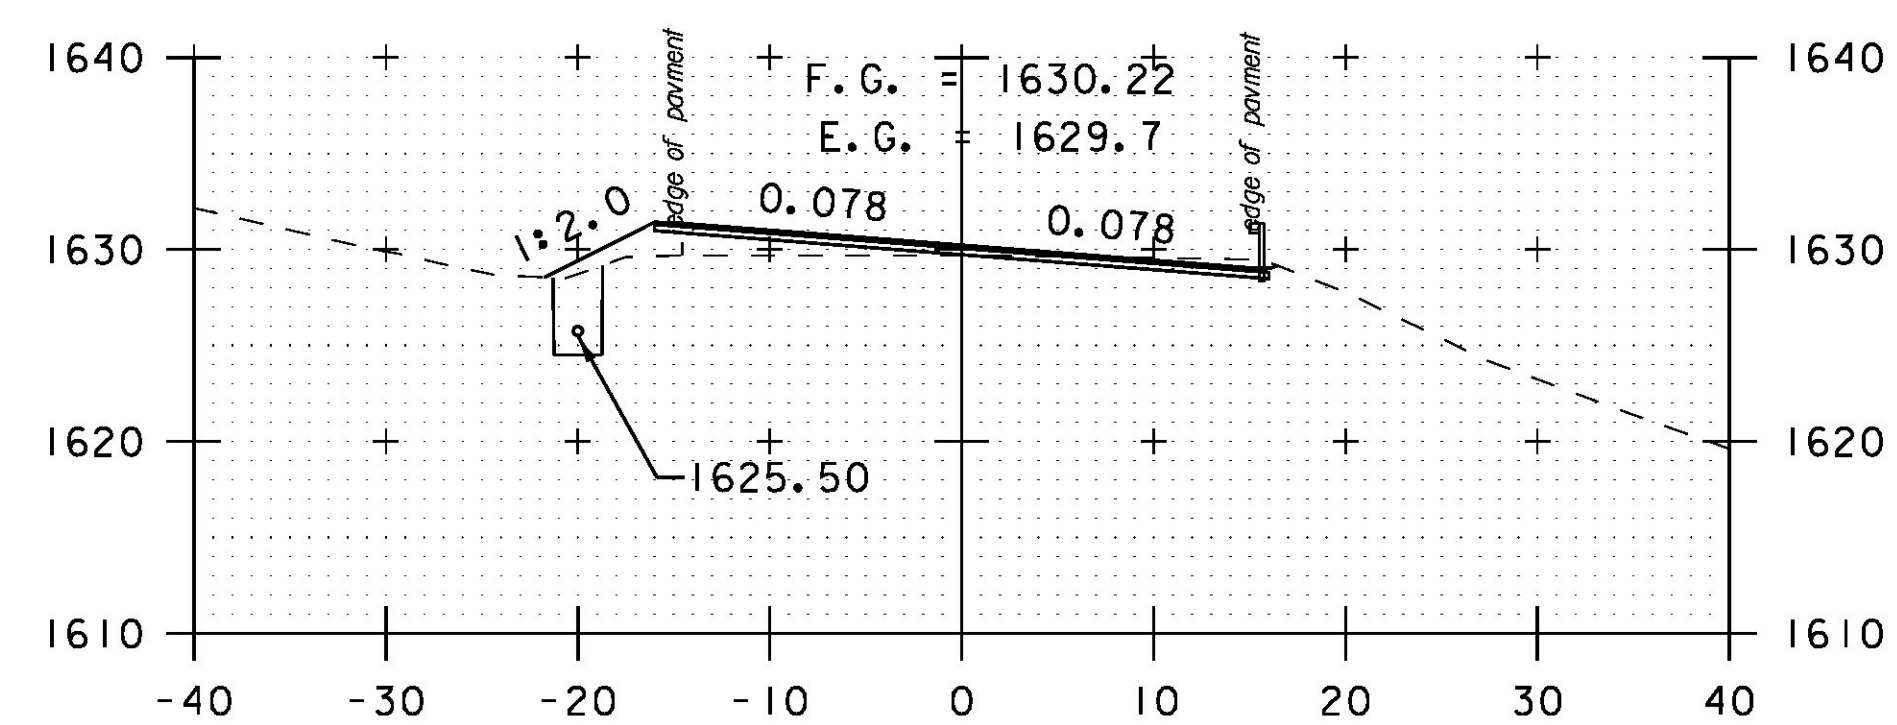

113+00



PROJECT NAME: HANCOCK
PROJECT NUMBER: STP 2923 (1)

FILE NAME: z10c252xs.dgn
PROJECT LEADER: C. LATHROP
DESIGNED BY: B. MARTIN
CROSS SECTION SHEET 16

PLOT DATE: 3/18/2015
DRAWN BY: B. MARTIN
CHECKED BY: C. LATHROP
SHEET 143 OF 207